



FED. ROAD DIST. NO.	STATE	FED-AID PROJ. NO.	FISCAL YEAR	SHEET NO.	TOTAL SHEETS
HAWAII	HAW.	NH-056-1(058)	2017	7	30

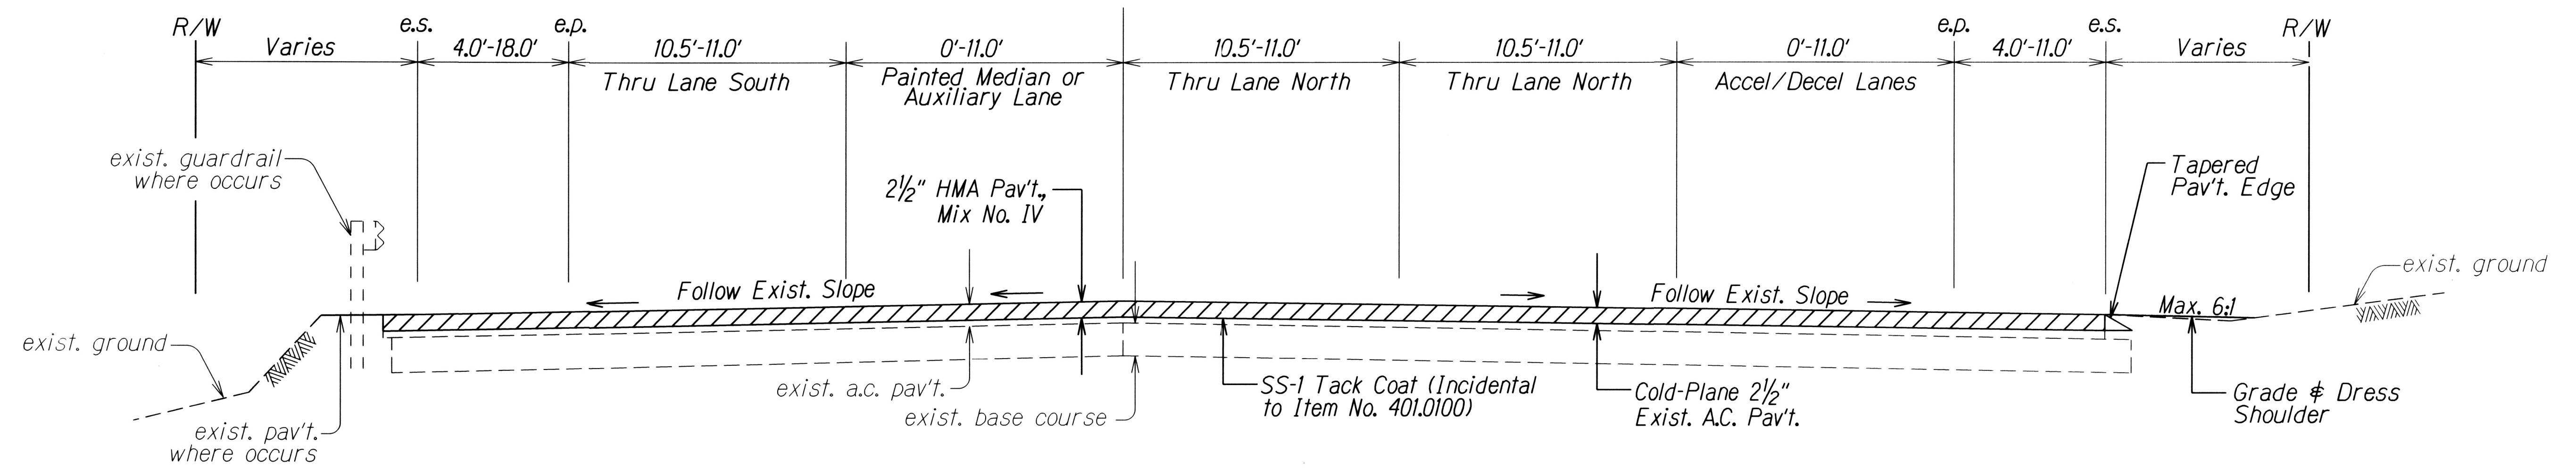

TYPICAL TANGENT SECTION
Not to scale

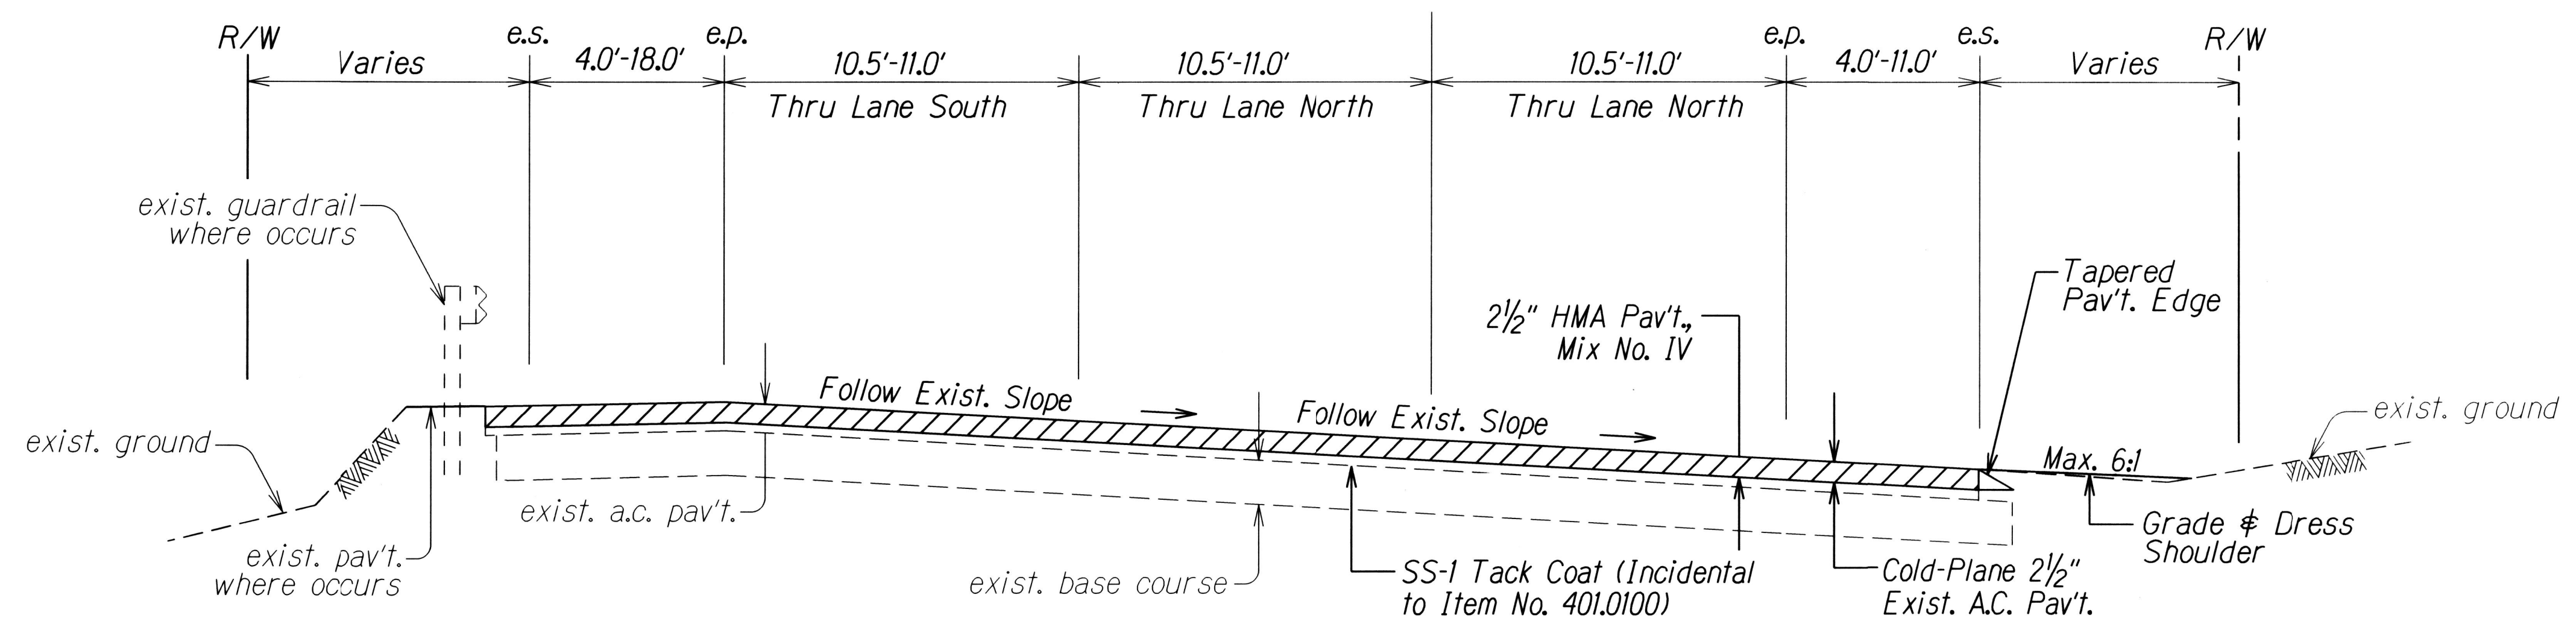

TYPICAL SECTION ON SUPERELAVATION
Not to scale

ORIGINAL PLAN	SURVEY PLOTTED BY	DATE
NOTE BOOK	DRAWN BY	
	TRACED BY	
	CHECKED BY	
	DATE	

STATE OF HAWAII
DEPARTMENT OF TRANSPORTATION
HIGHWAYS DIVISION


TYPICAL SECTIONS

KUHIO HIGHWAY RESURFACING
Kapule Highway to North Leho Drive
Federal-Aid Project No. NH-056-1(058)


Not to scale Date: Oct. 2016

SHEET No. 1 OF 3 SHEETS


FED. ROAD DIST. NO.	STATE	FED-AID PROJ. NO.	FISCAL YEAR	SHEET NO.	TOTAL SHEETS
HAWAII	HAW.	NH-056-1(058)	2017	8	30

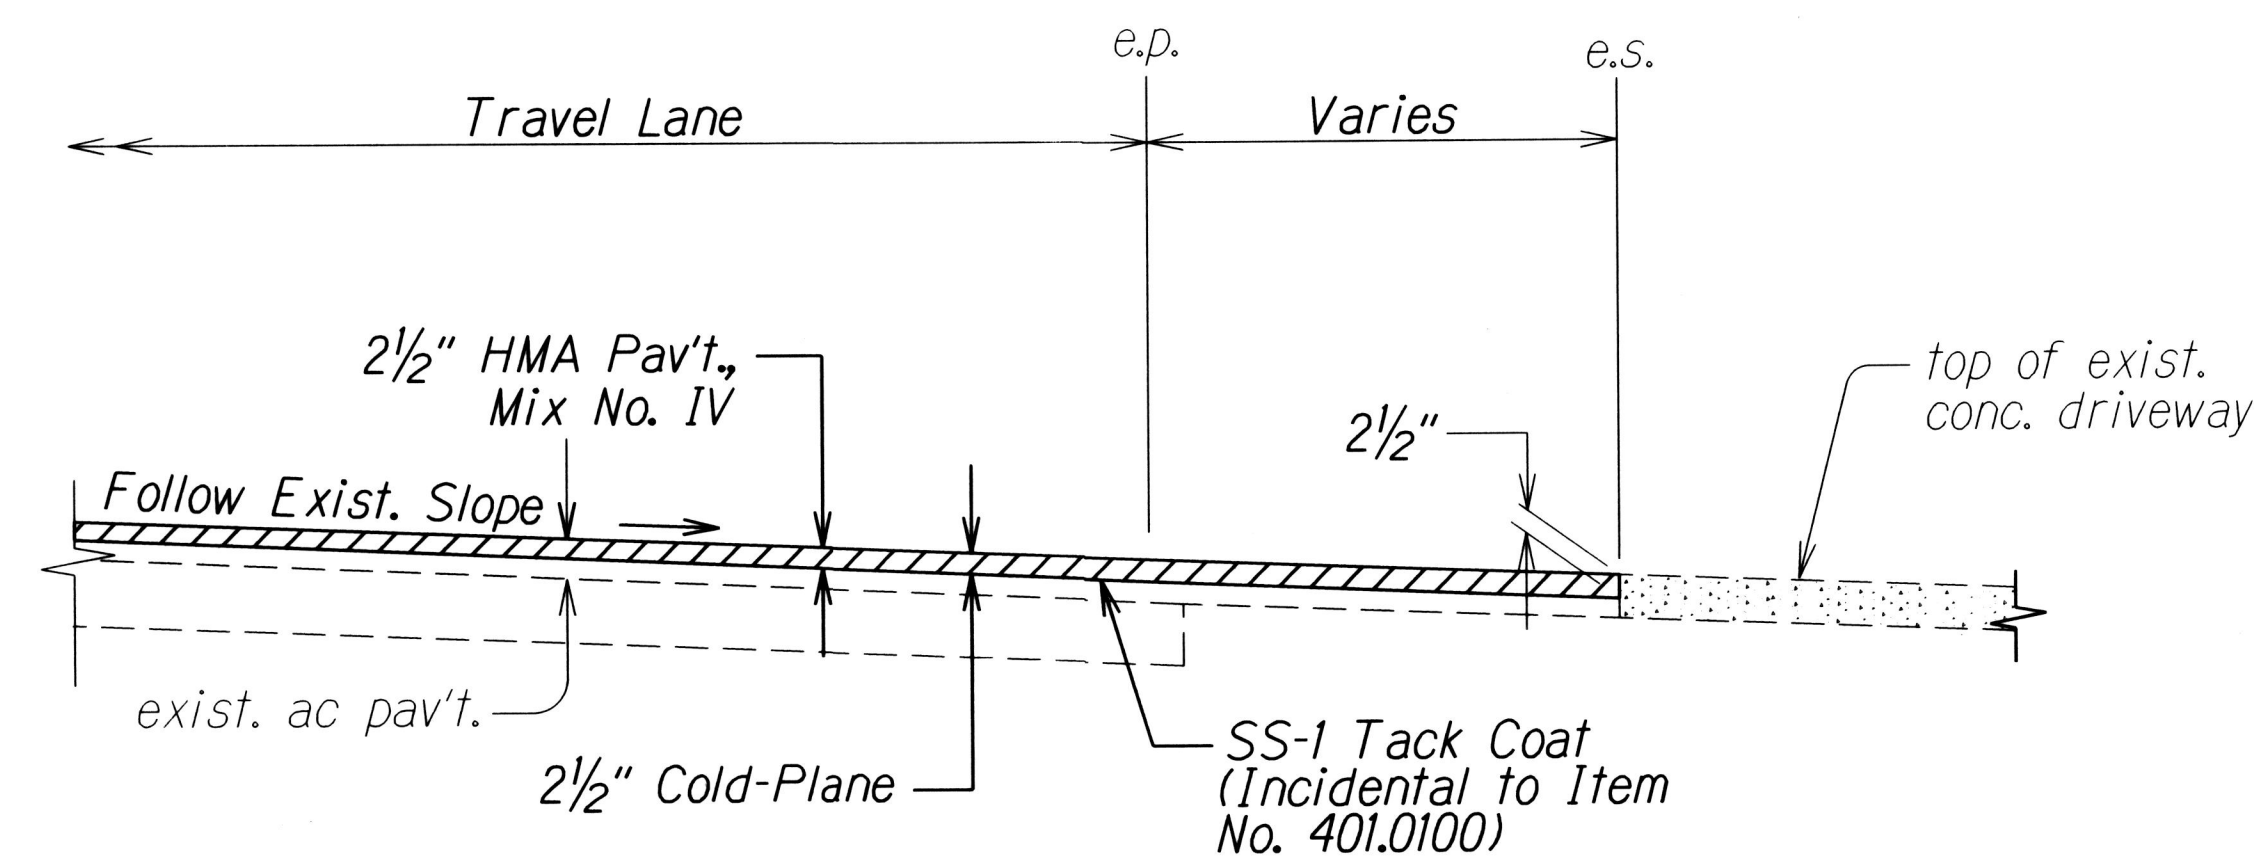


RESURFACING AT CONCRETE DRIVEWAYS
Not to Scale

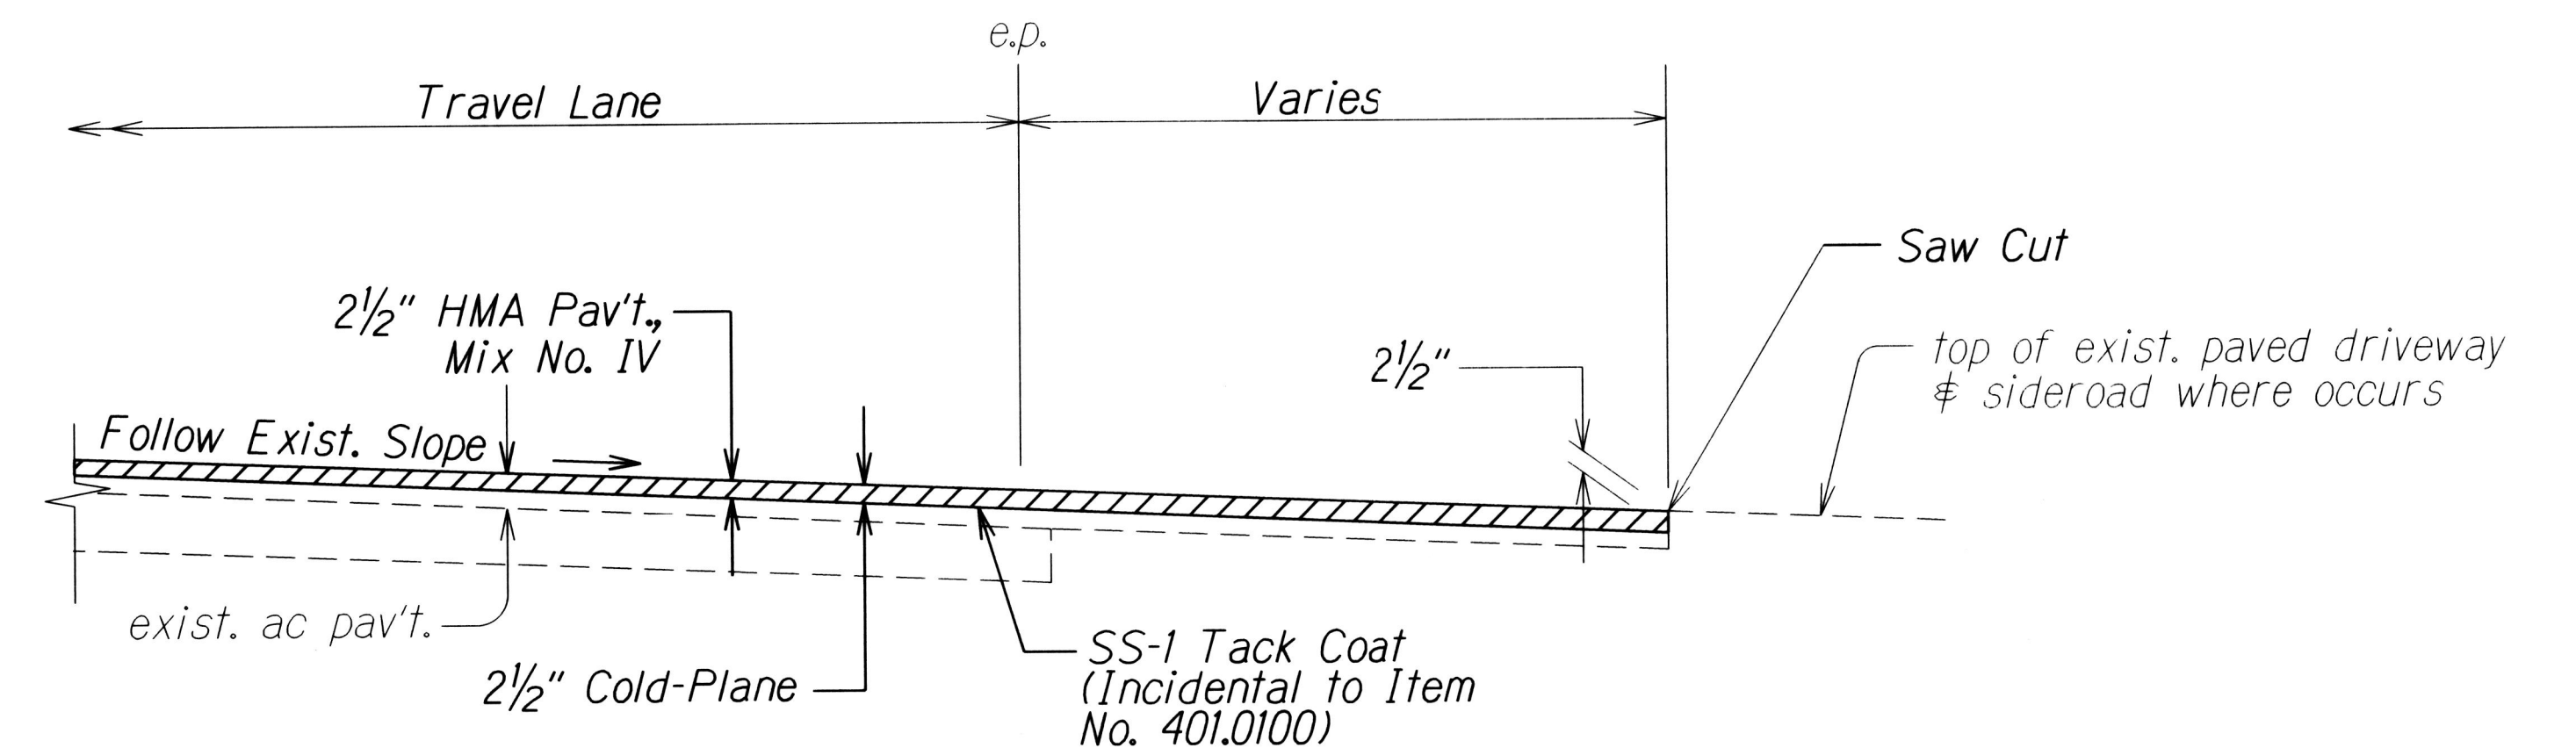


RESURFACING AT PAVED SIDEROADS/DRIVEWAYS
Not to Scale

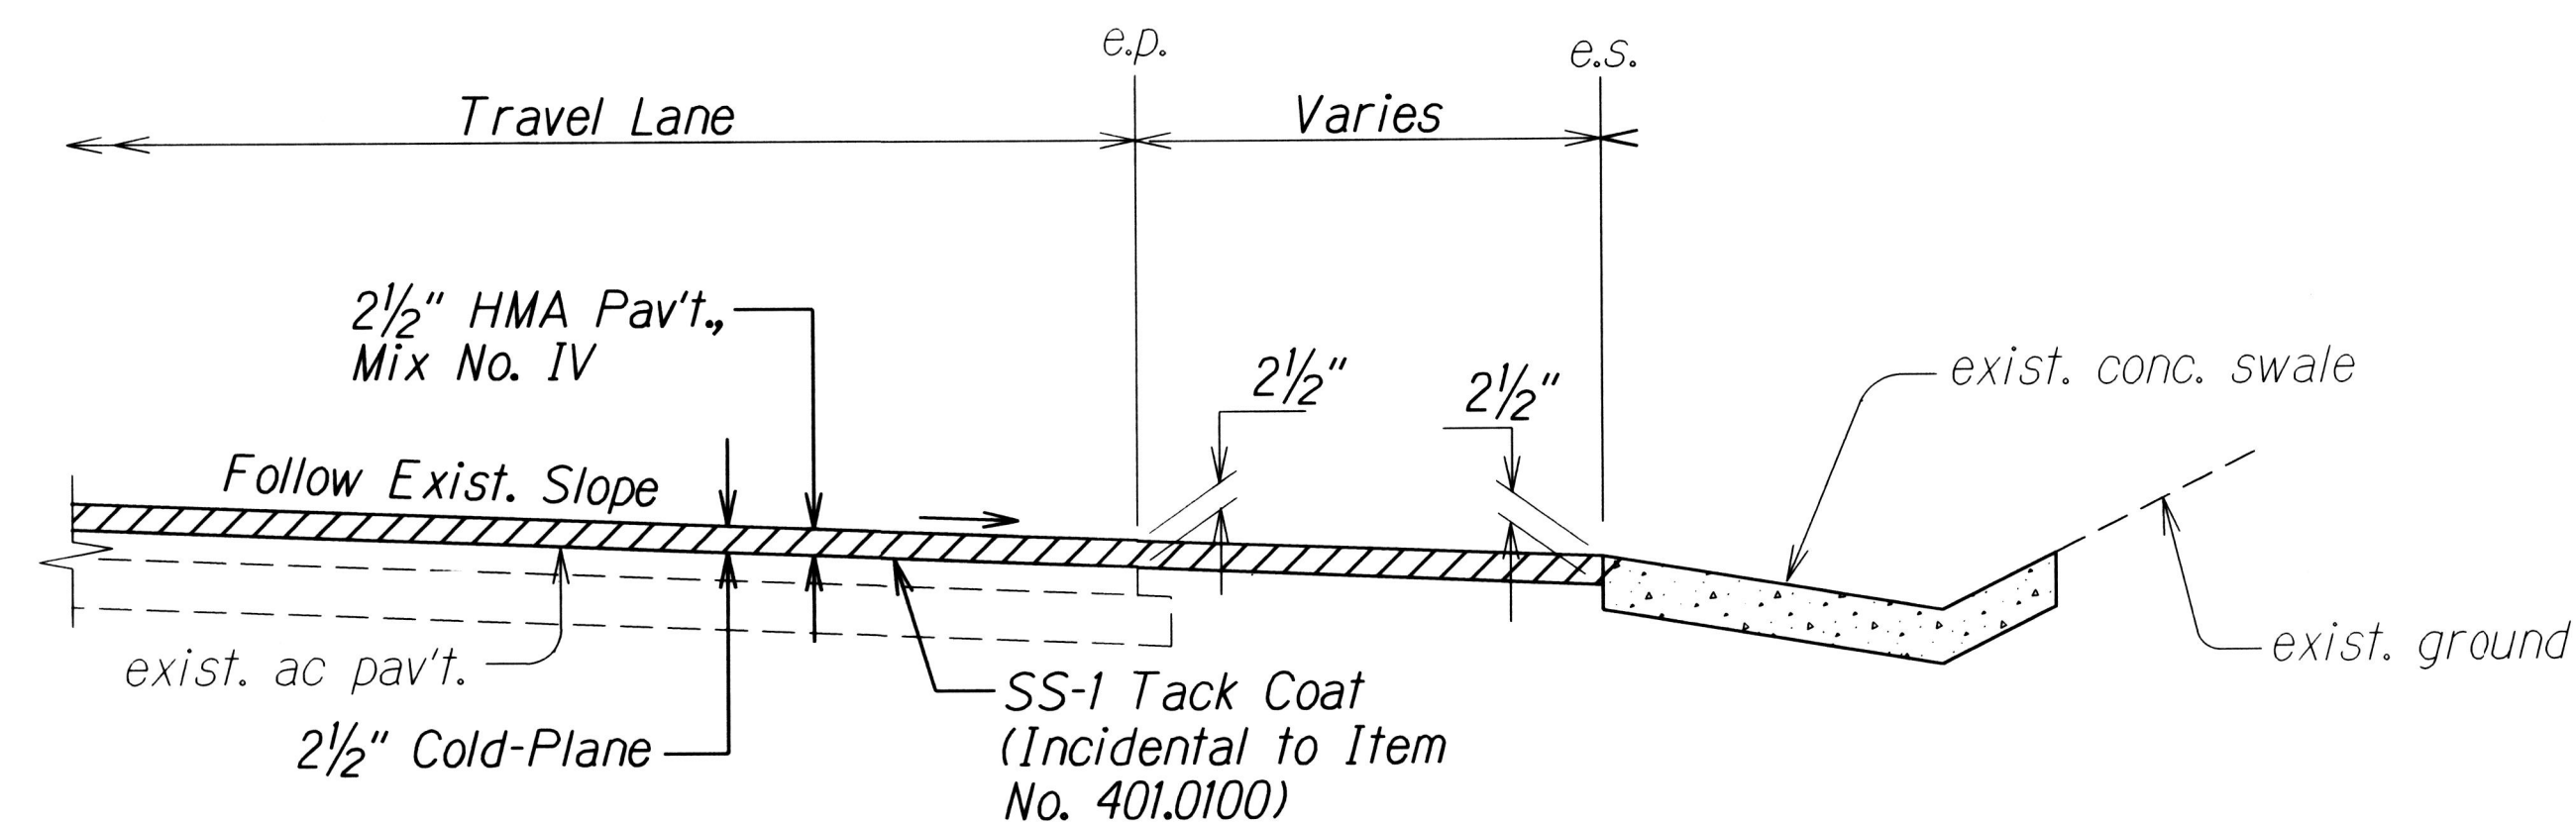

RESURFACING AT CONCRETE SWALE
Not to Scale

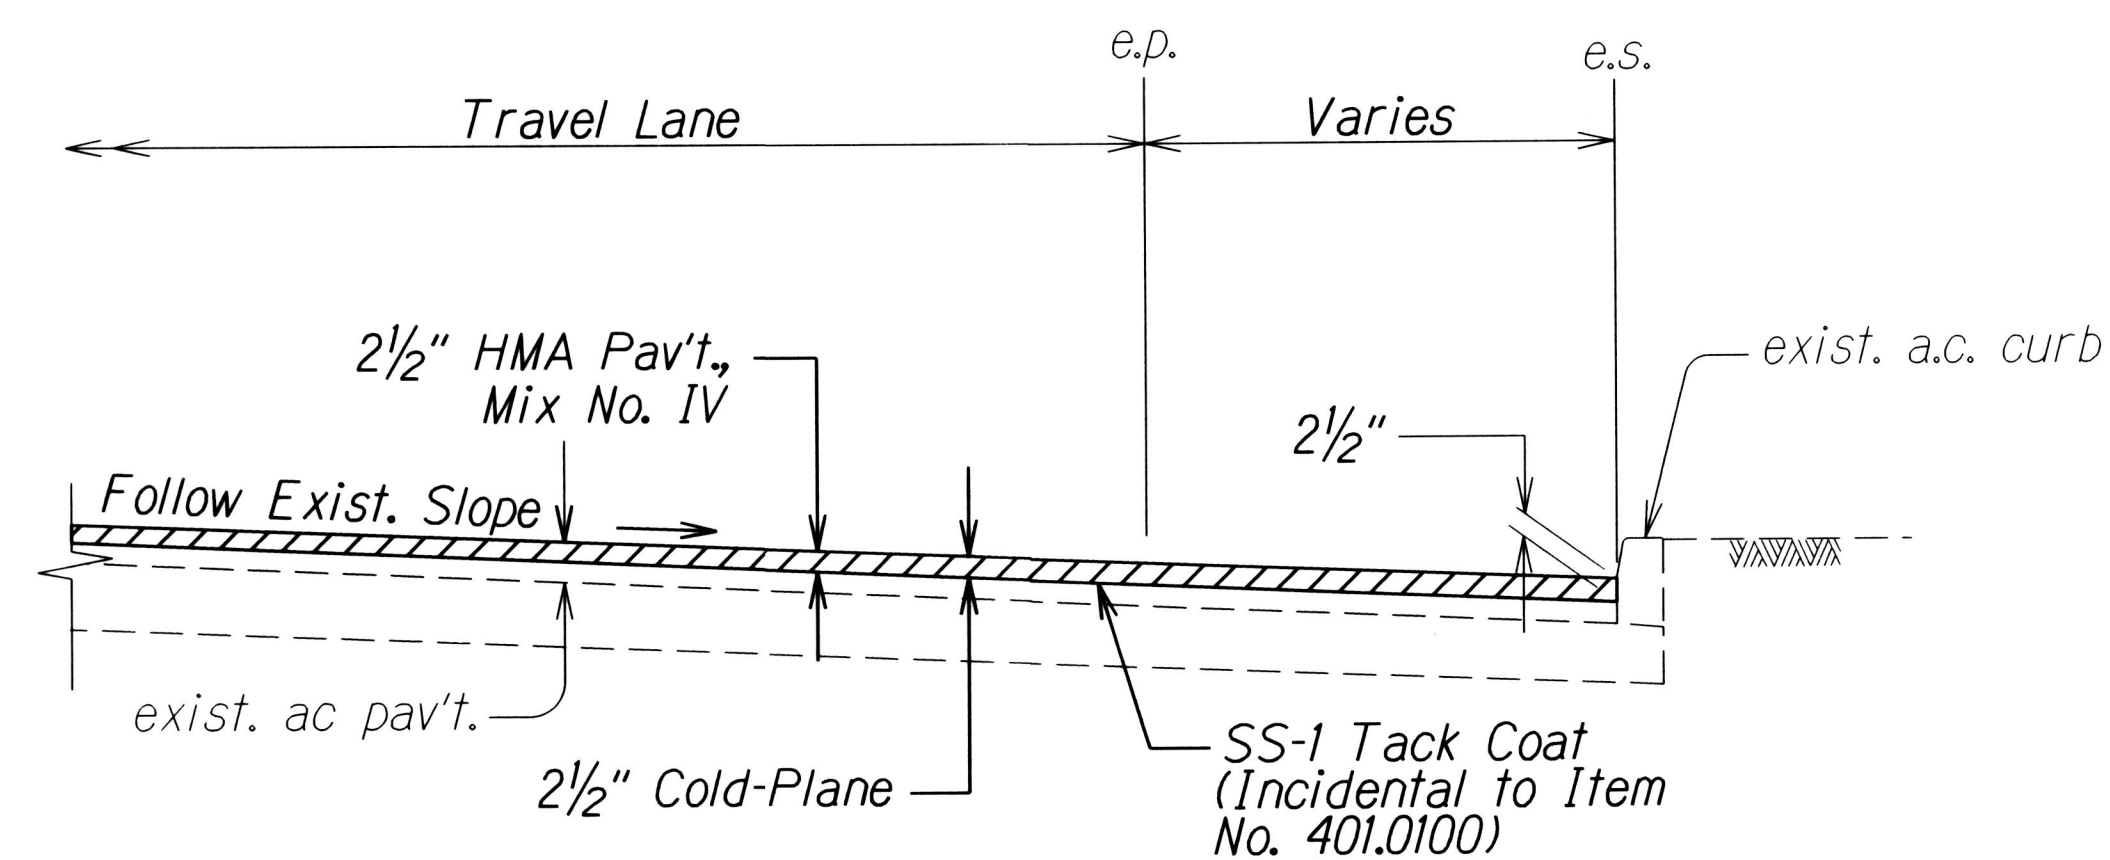

RESURFACING AT A.C. CURB
Not to Scale

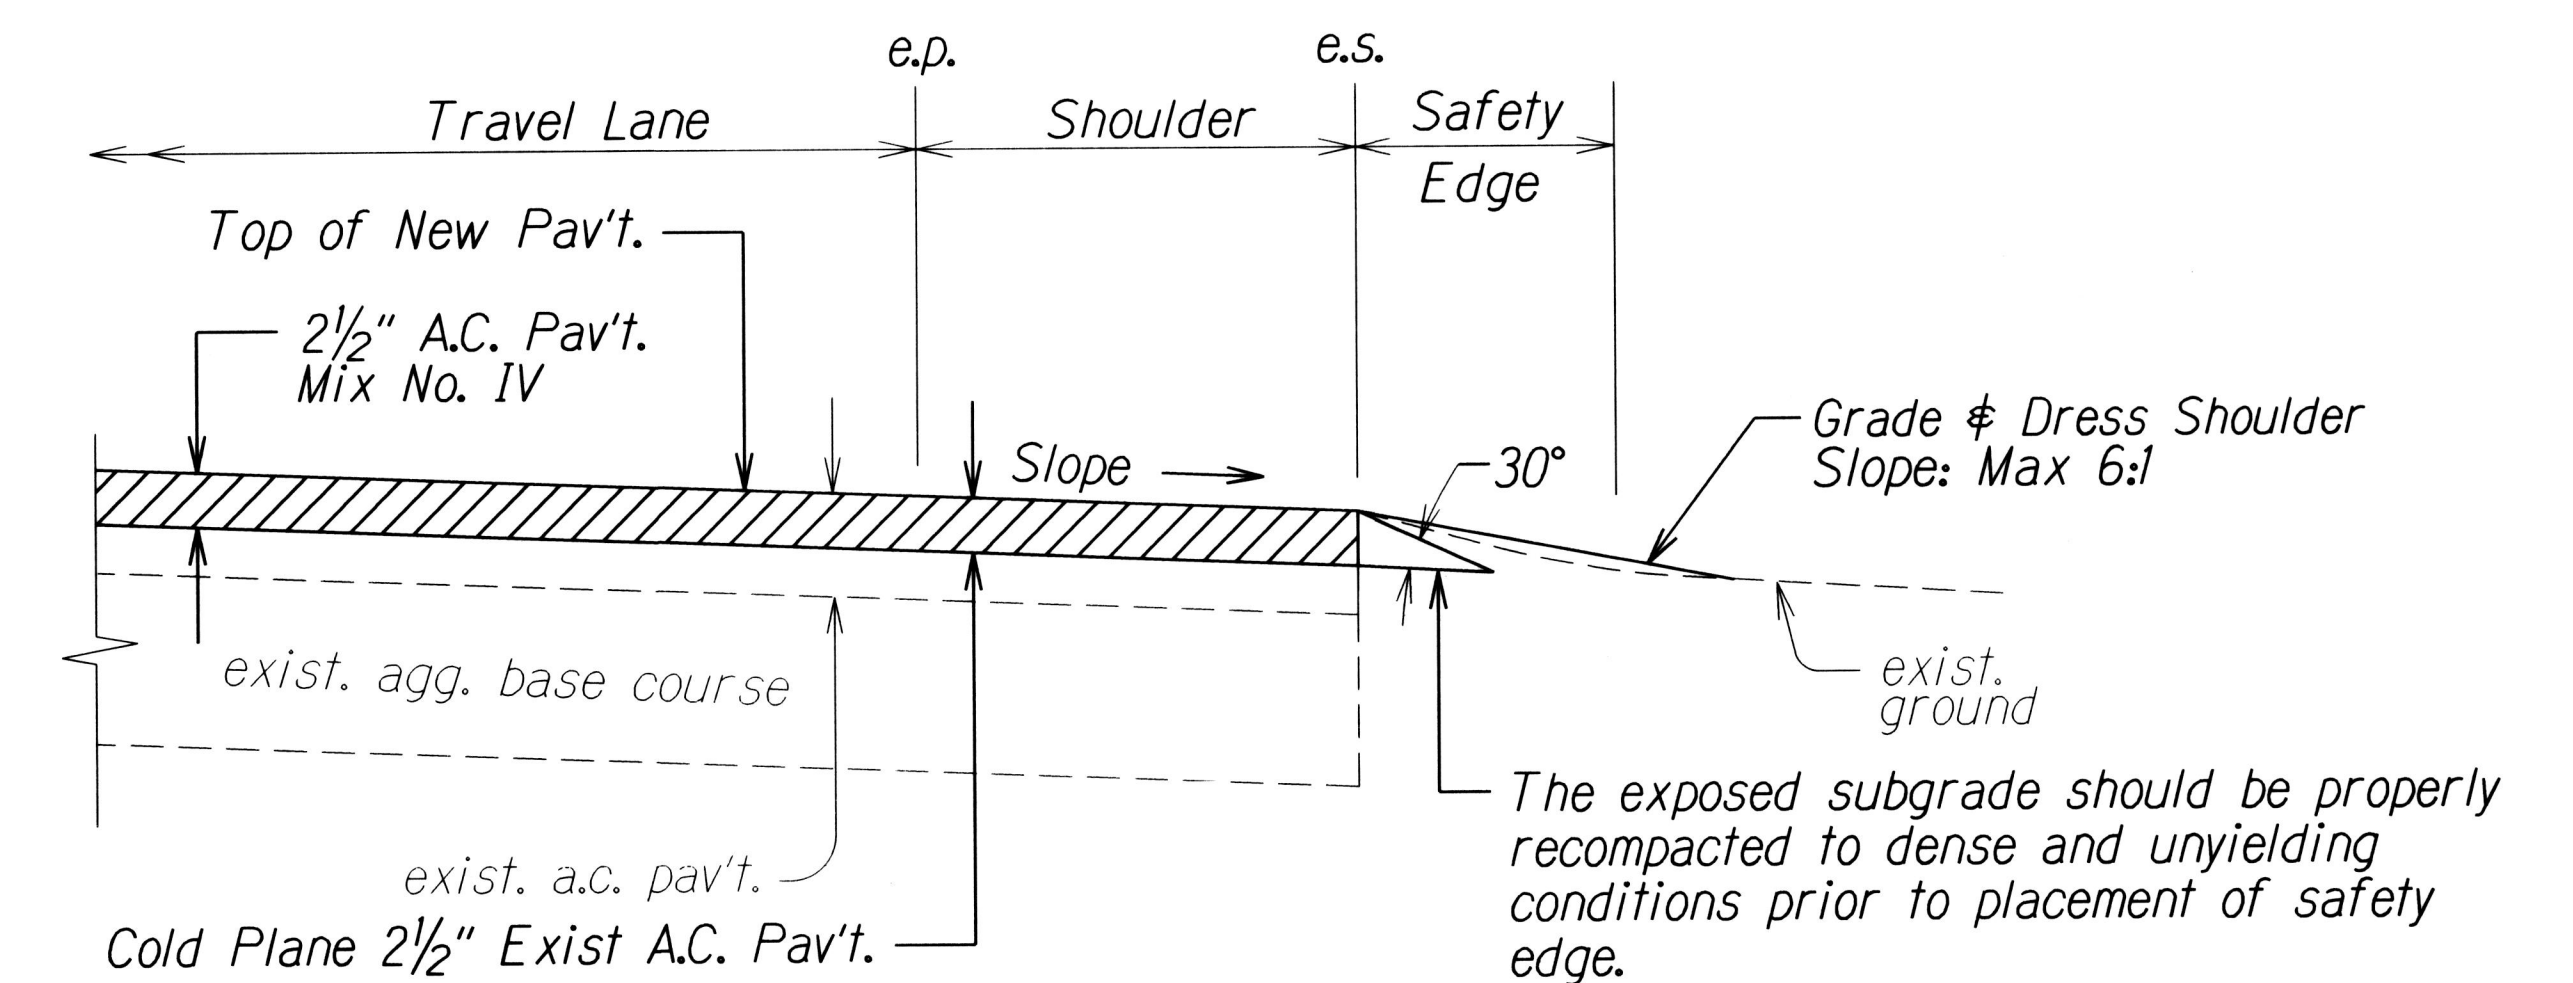

TYPICAL PAVEMENT EDGE DETAIL
Not to Scale

Note:

- Contractor shall mount a device directly on the paver screed extension to provide a 30° beveled shoulder edge.
- Construct safety edge at all edges of a.c. pavement. This work shall be considered incidental to Item No. 401.0400 - HMA Pavement Mix No. IV.

STATE OF HAWAII
DEPARTMENT OF TRANSPORTATION
HIGHWAYS DIVISION




TYPICAL SECTIONS

KUHIO HIGHWAY RESURFACING
Kapule Highway to North Leho Drive
Federal-Aid Project No. NH-056-1(058)

Not to Scale Date: Oct. 2016

SHEET No. 2 OF 3 SHEETS

FED. ROAD DIST. NO.	STATE	FED-AID PROJ. NO.	FISCAL YEAR	SHEET NO.	TOTAL SHEETS
HAWAII	HAW.	NH-056-1(058)	2017	9	30

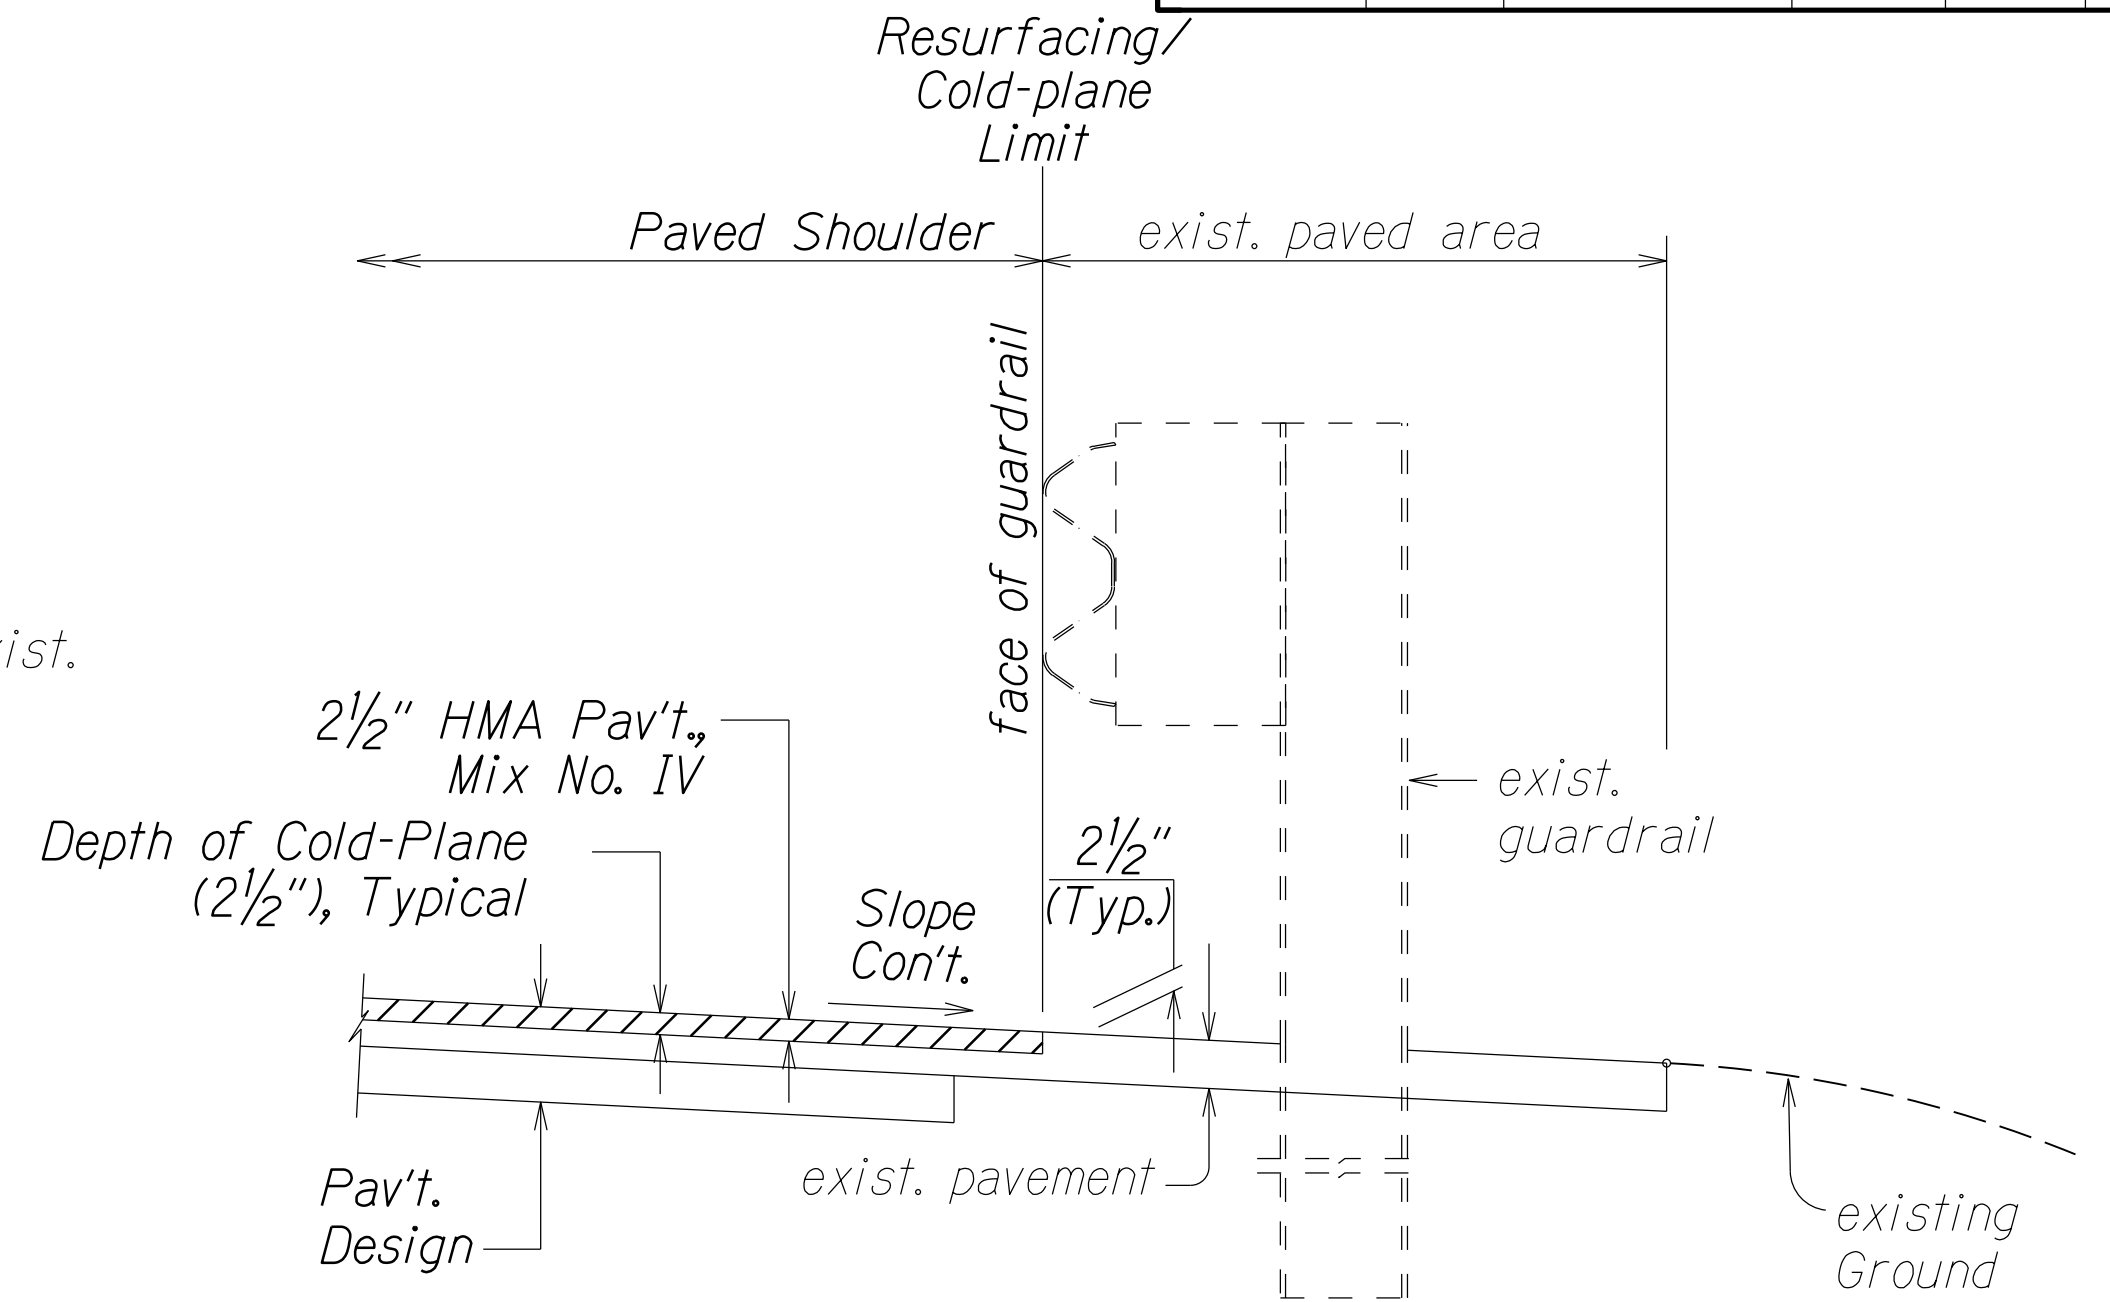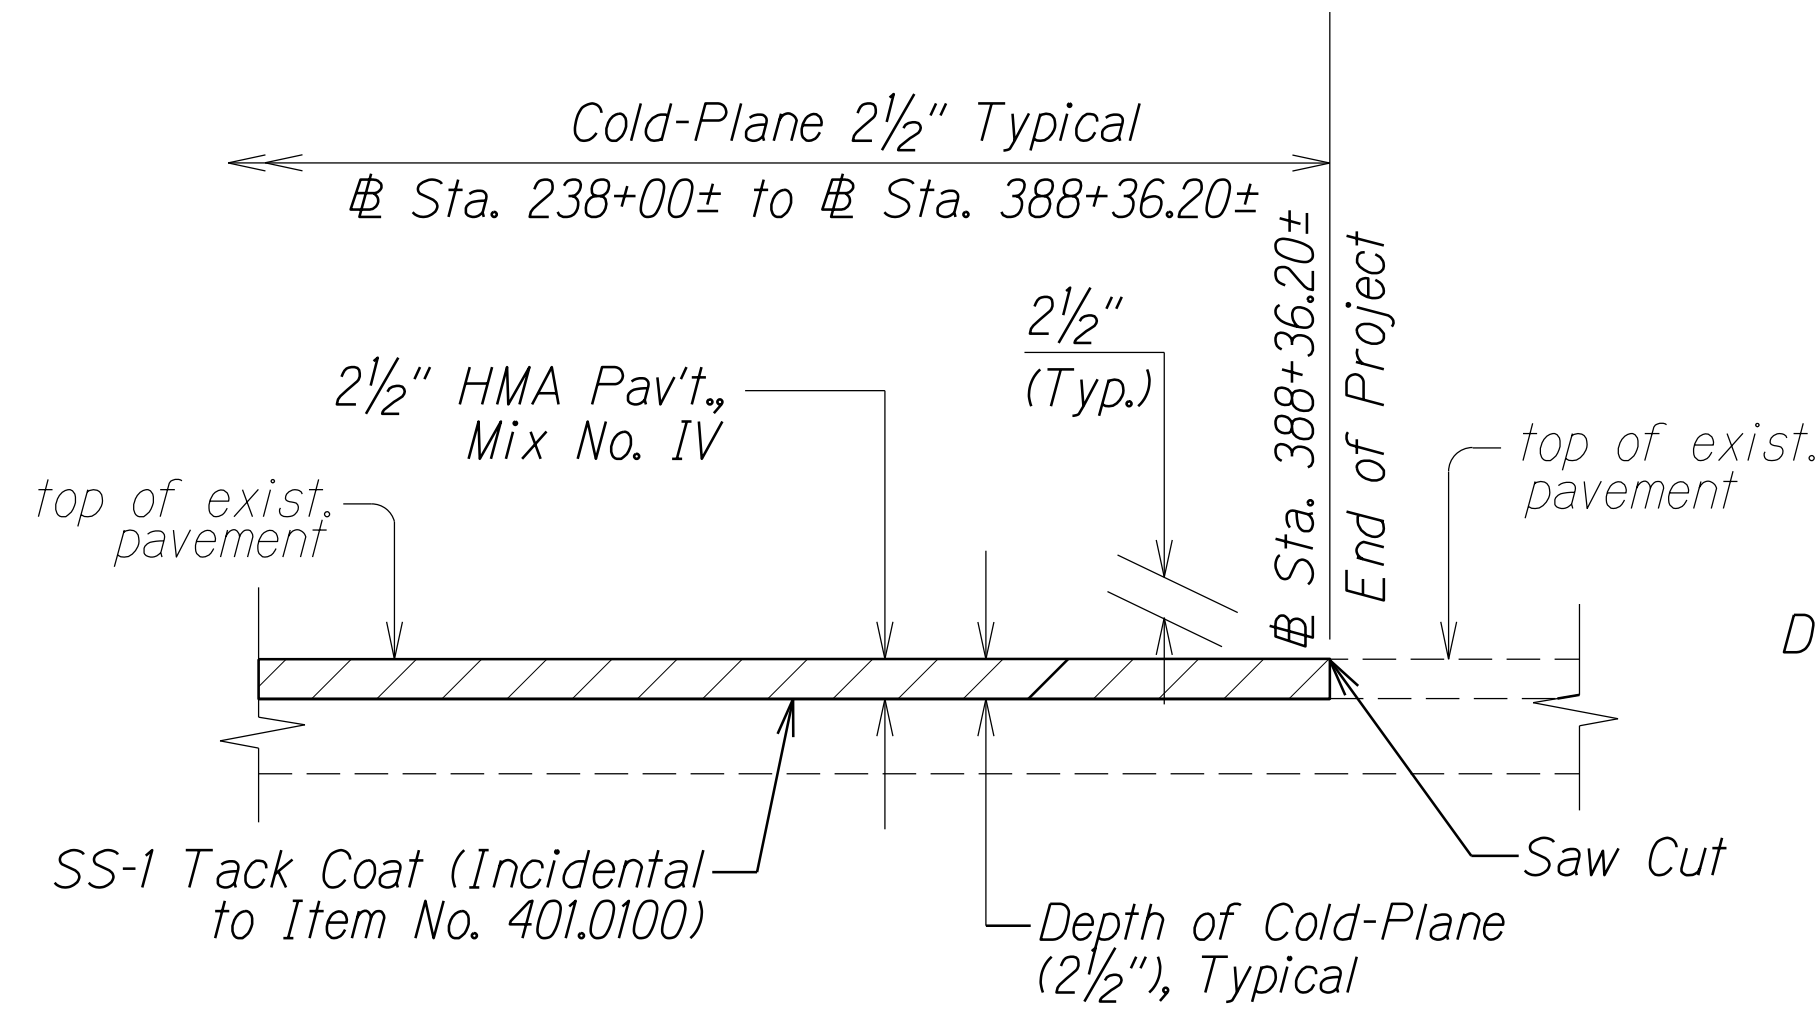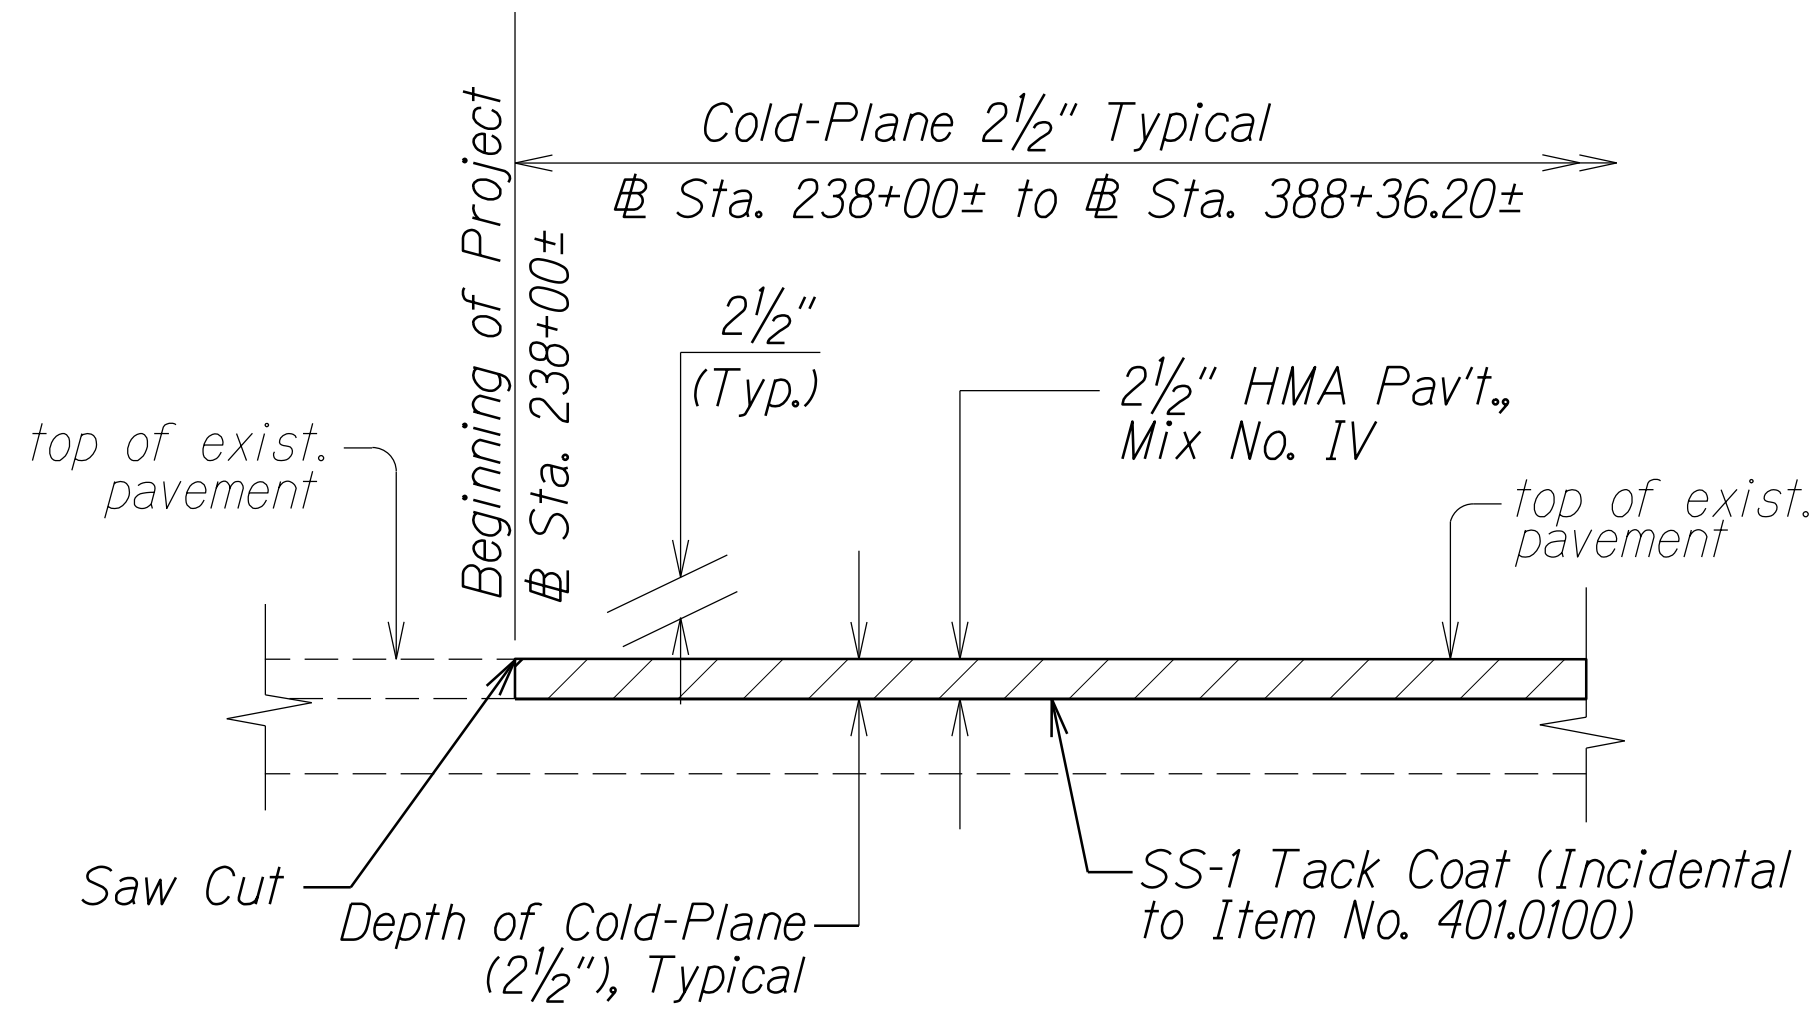


COLD PLANED TRANSITION TO EXISTING A.C. PAVEMENT AT THE BEGINNING AND END OF PROJECT

Not to Scale

RESURFACING AT GUARDRAIL

Not to Scale

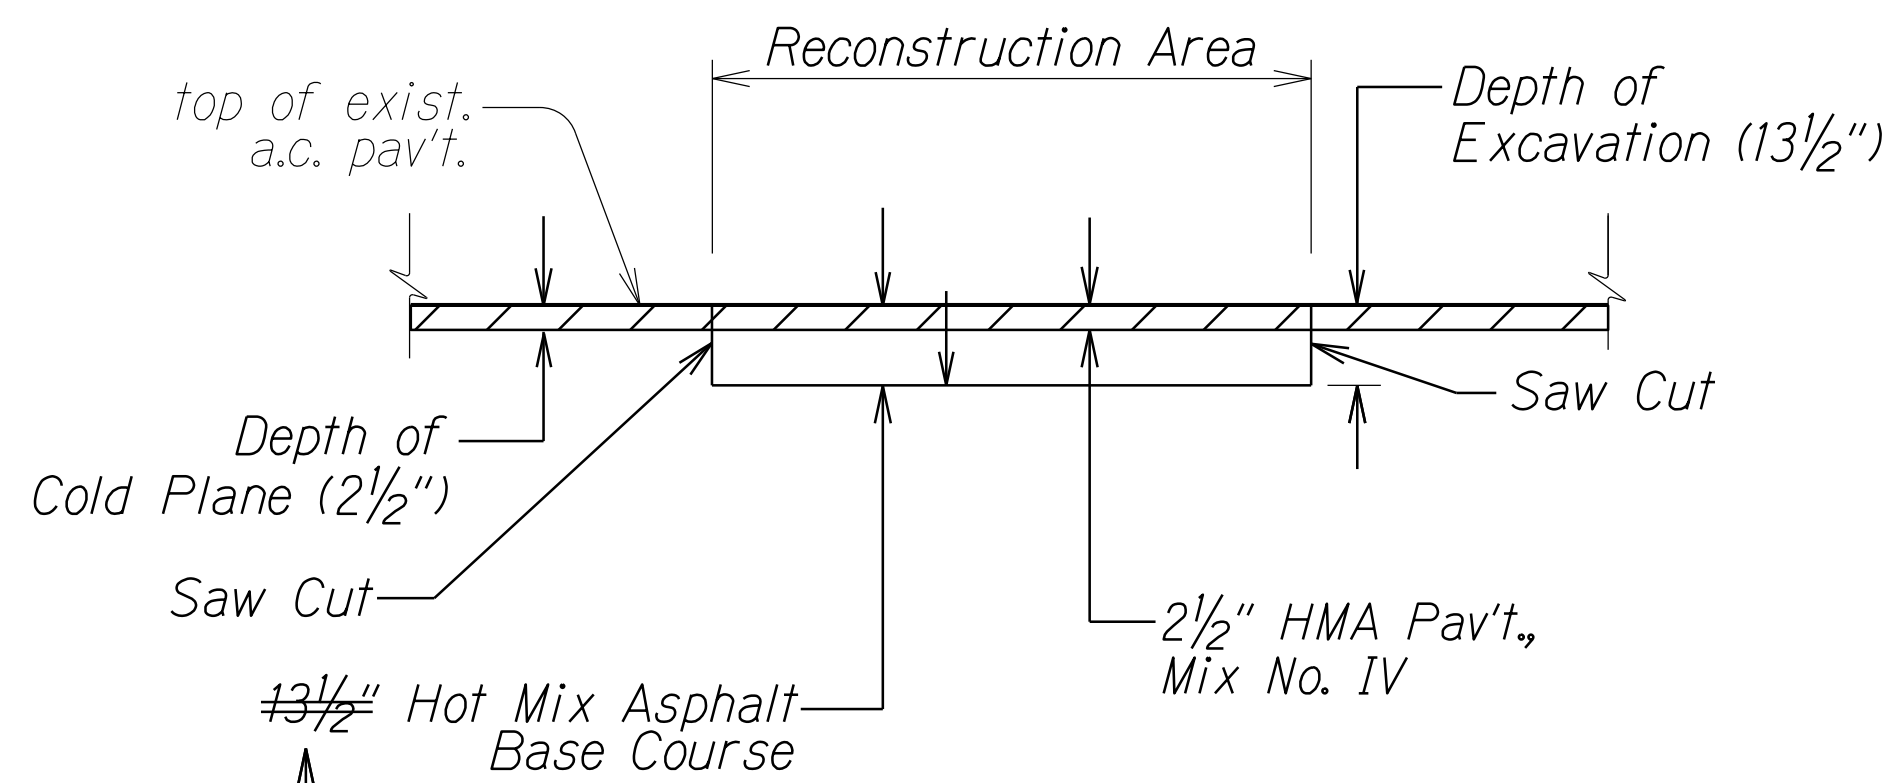


See Reconstruction Location Table for depths

A.C. PAVEMENT RECONSTRUCTION DETAIL

Not to Scale

Note:

Reconstruct weakened pavement areas prior to cold plane. The exposed remaining base course or subbase materials should be properly recompact to dense and unyielding conditions prior to placement of the asphalt concrete base layer.

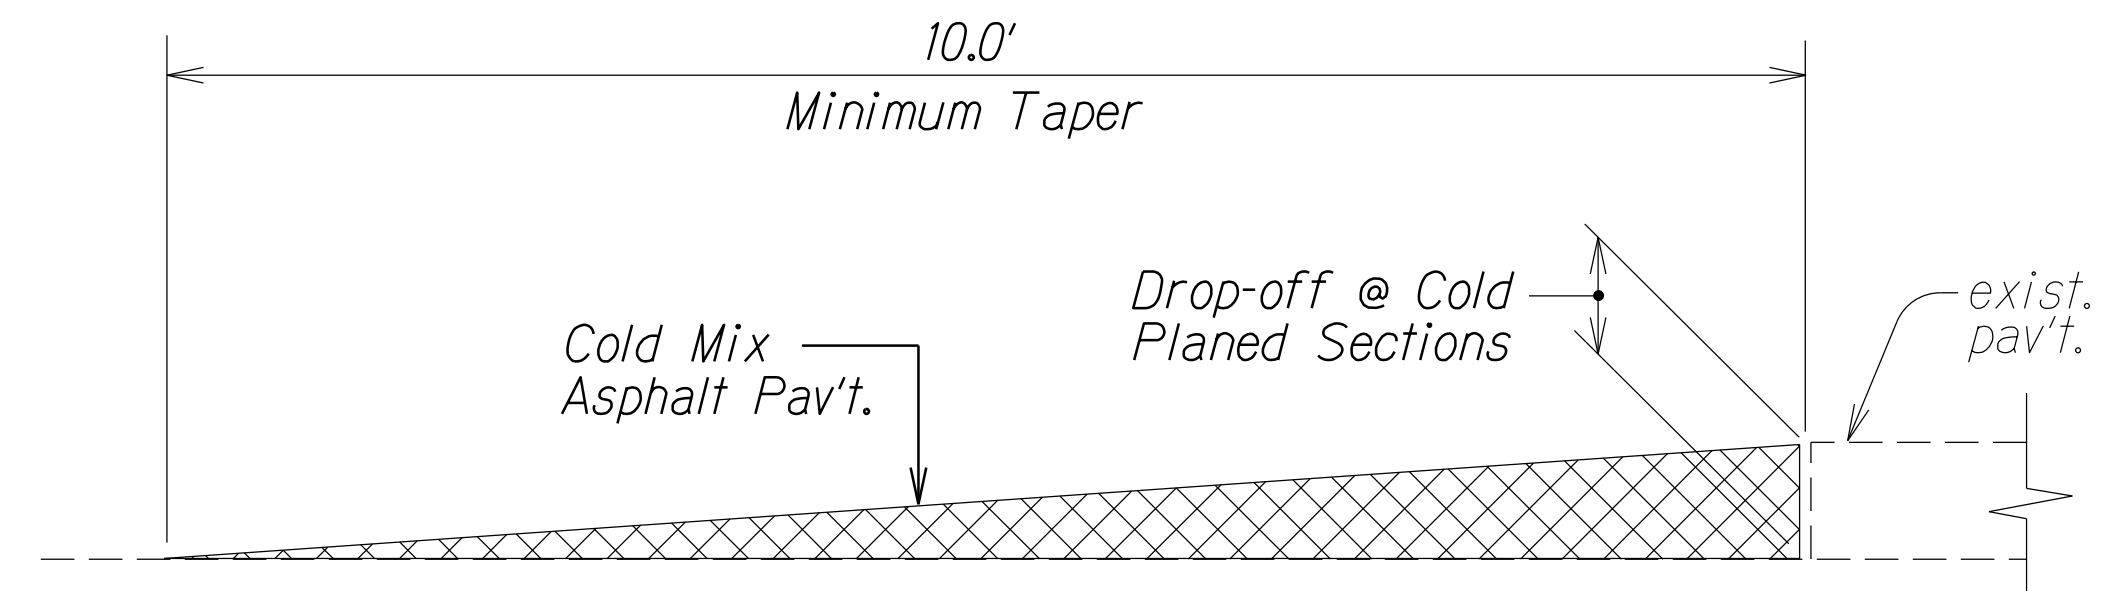

TEMPORARY TRANSITION AT COLD PLANED AREAS

Not to Scale

Note: Contractor shall construct temporary pavement taper to prevent sharp pavement drop-offs at all cold planed sections. Prior to final Hot Mix Asphalt Pavement, Mix No. IV placement, temporary pavement taper shall be removed.

LEGEND FOR AS-BUILT POSTINGS	
	Squiggly line for as-built deletion
	Double line for as-built deletion
Roadway	Text for as-built posting

STATE OF HAWAII DEPARTMENT OF TRANSPORTATION HIGHWAYS DIVISION	
TYPICAL SECTIONS	
KUHIO HIGHWAY RESURFACING Kapule Highway to North Leho Drive Federal-Aid Project No. NH-056-1(058)	
Not to Scale	Date: Oct. 2016
SHEET No. 3 OF 3 SHEETS	

"AS-BUILT"