



FED. ROAD DIST. NO.	STATE	FED. AID PROJ. NO.	FISCAL YEAR	SHEET NO.	TOTAL SHEETS
HAWAII	HAW.	STP-056-1(34)	1995	4	9

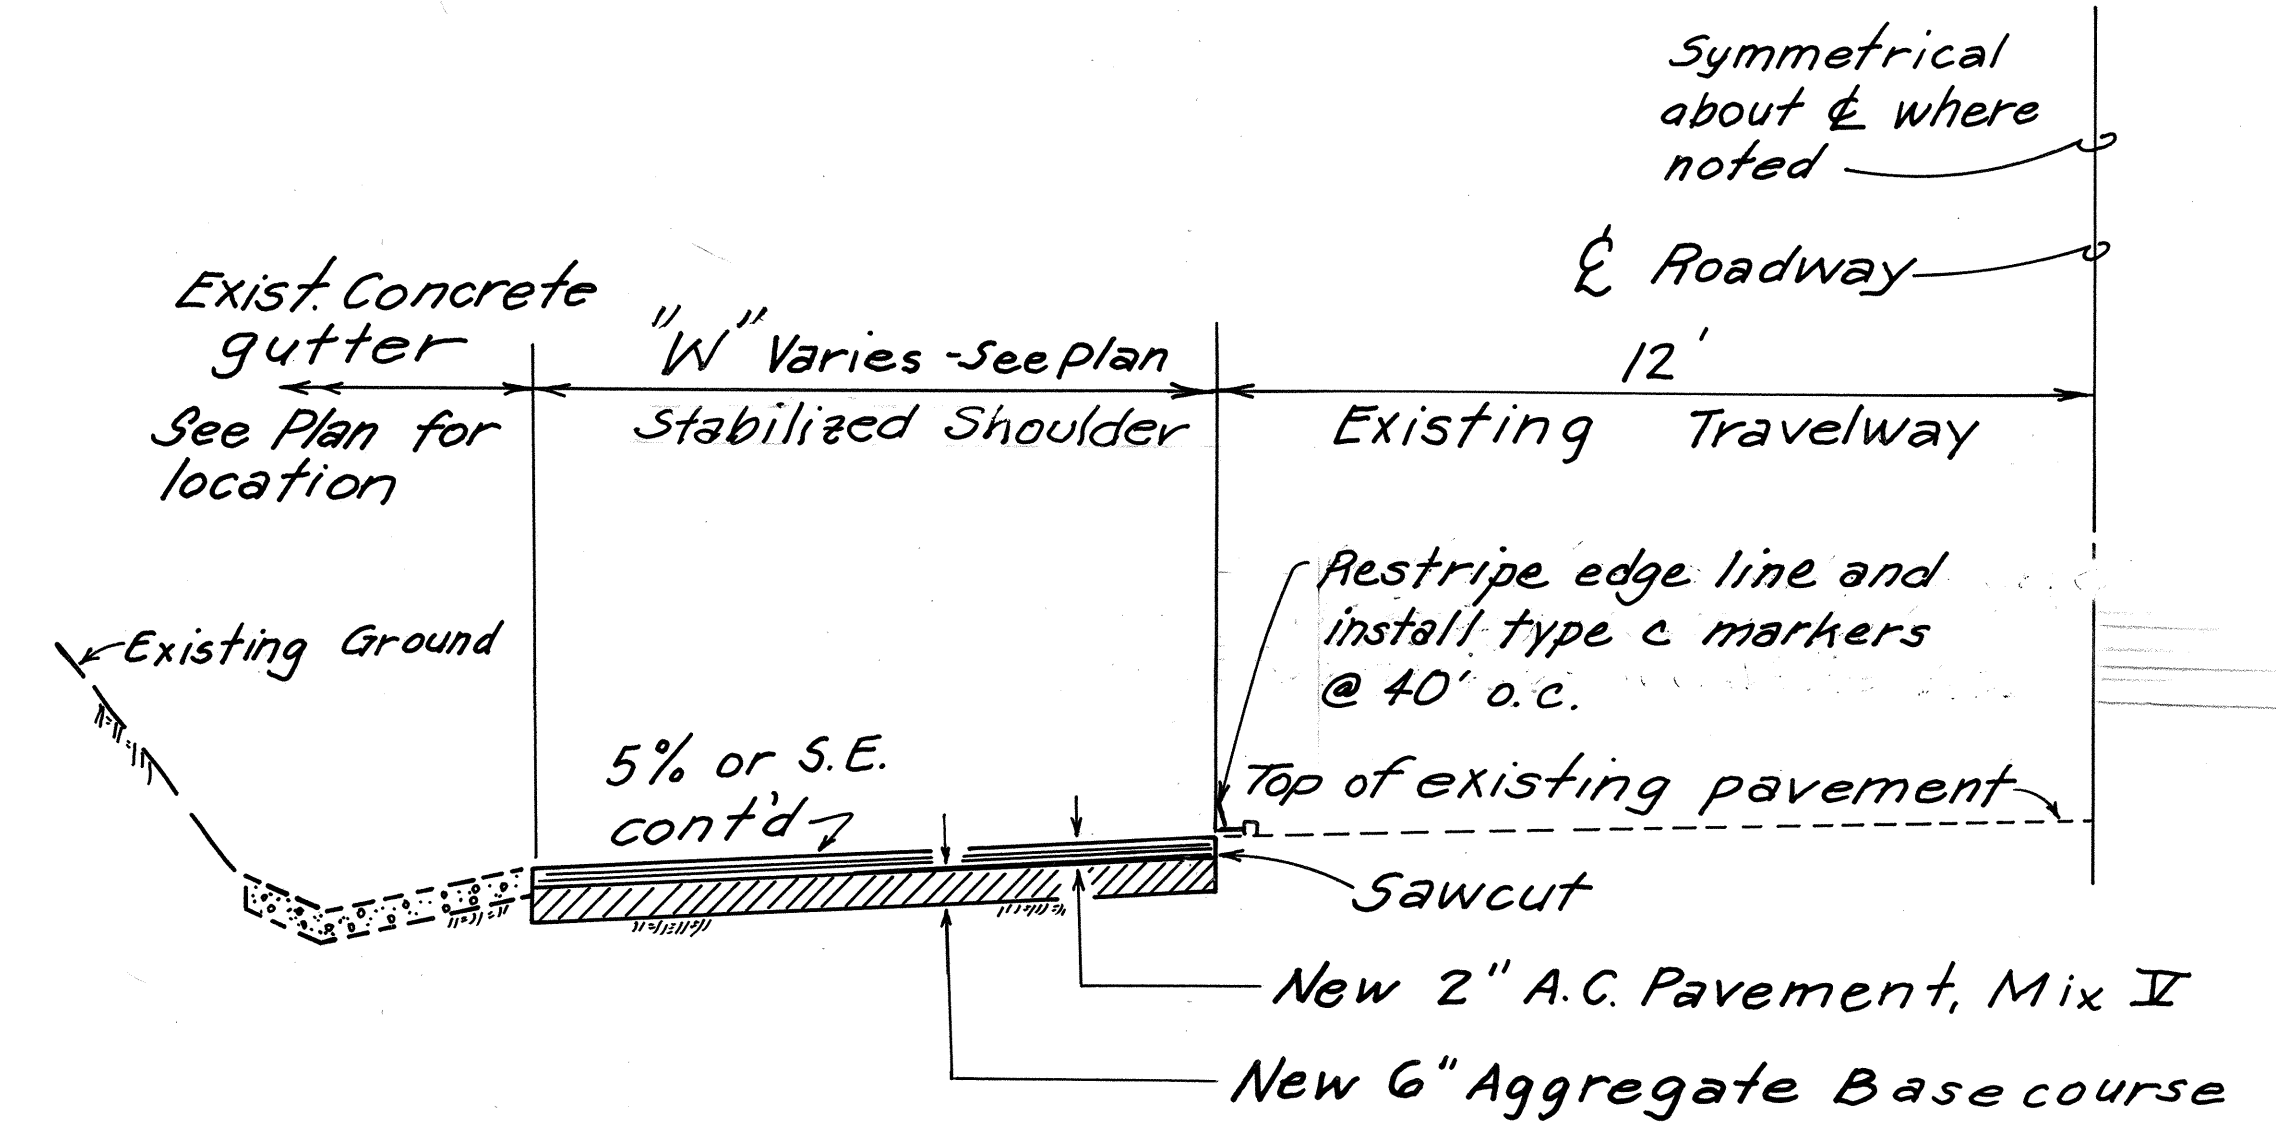

TYPICAL ROADWAY SECTION
AT GUTTERS
Scale: $\frac{3}{8}" = 1'-0"$

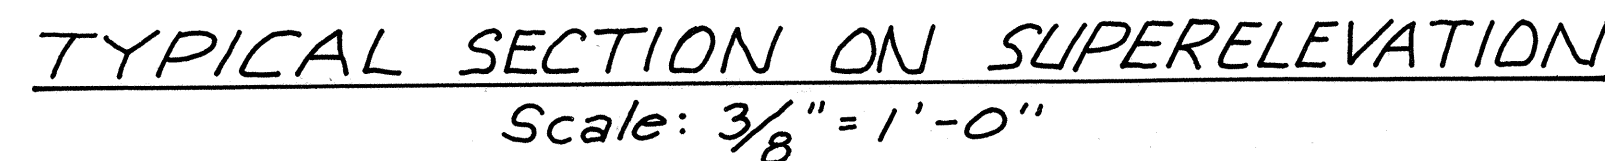

ORIGINAL PLAN	SURVEY PLOTTED BY _____ DATE _____
NOTE BOOK	DRAWN BY _____ *
	TRACED BY _____ *
	DESIGNED BY _____ *
	QUANTITIES BY _____ *
No. _____	CHECKED BY _____

STATE OF HAWAII
DEPARTMENT OF TRANSPORTATION
HIGHWAYS DIVISION

TYPICAL SECTIONS

ROUTE 56, KUHIO HIGHWAY

GUARDRAIL & SHOULDER IMPROVEMENTS

AT VARIOUS LOCATIONS

F.A. Proj. No. STP-056-1(34)

Scale: As Shown June, 1994

SHEET No. 4 OF 9 SHEETS