


FED. ROAD DIST. NO.	STATE	FED. AID PROJ. NO.	FISCAL YEAR	SHEET NO.	TOTAL SHEETS
HAWAII	HAW.	ER-19 (009)	2018	7	29




BIOSOCK COMPOST FILTER SOCK NOTES:

1. Remove accumulated sediment when the depth reaches $\frac{1}{3}$ of the barrier height.
2. Biosock material and compost shall be removed at the completion of construction (or a phase of construction) and shall be disposed of properly.
3. No staking is required for slopes $< 4:1$.
4. Compost shall not contain biosolids and should be consistent with United States Environmental Protection Agency guidelines

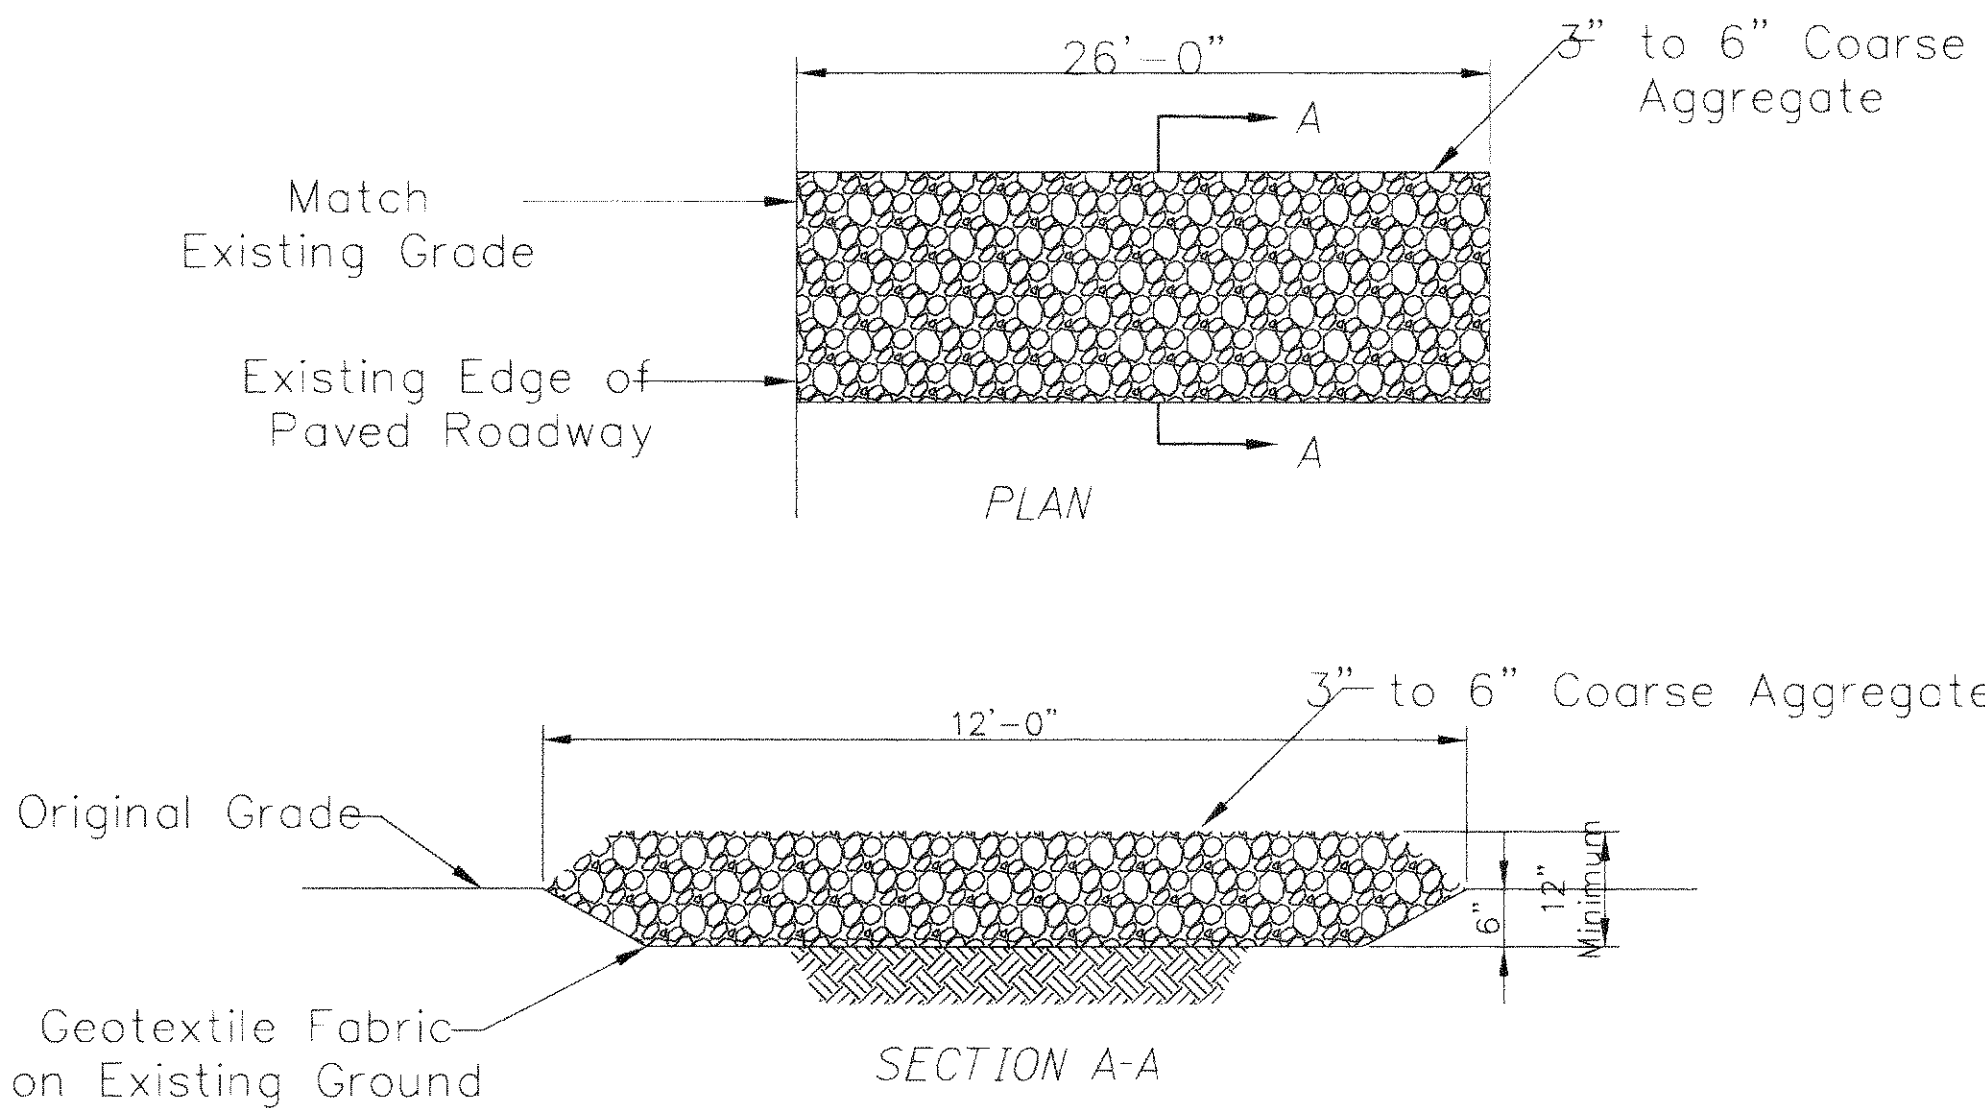

**TEMPORARY CONSTRUCTION
STABILIZATION**
Not to Scale

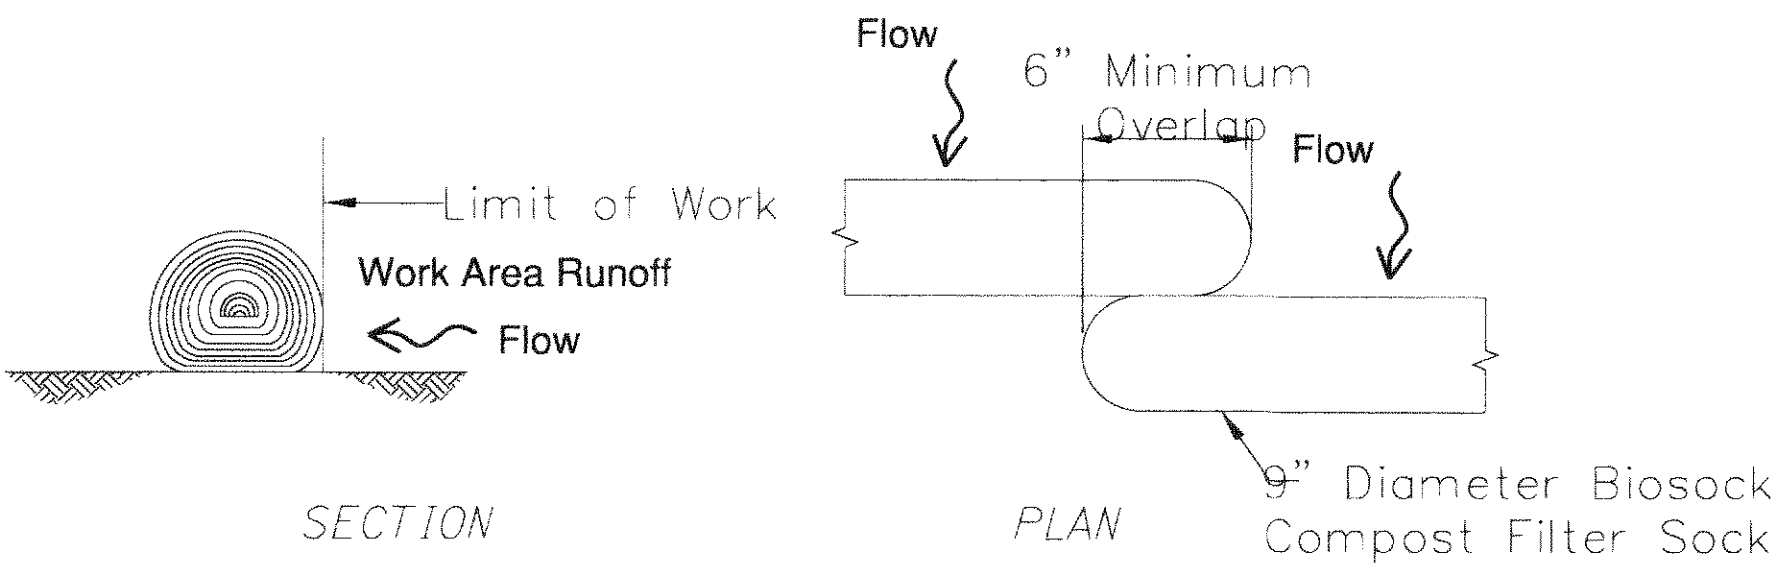

**BIOSOCK COMPOST FILTER SOCK
PERIMETER CONTROL DETAIL**
Not to Scale

GENERAL NOTES

1. Contractor shall extend biosock limits to cover full length of storage/staging areas at no additional cost to the State. Biosocks shown on plans are minimum.
2. No vehicles, equipment or material shall be stored or parked on either of the Wailua River Bridges.

AS-BUILT

	STATE OF HAWAII DEPARTMENT OF TRANSPORTATION HIGHWAYS DIVISION BMP - BIOSOCK & CONSTRUCTION STABILIZATION DETAILS WAILUA RIVER SCOUR COUNTERMEASURES Proj. No. ER-19(009) Scale: None Date: Oct. 26, 2018
	SHEET No. 7 OF 29 SHEETS