



FED. ROAD DIST. NO.	STATE	FED. AID PROJ. NO.	FISCAL YEAR	SHEET NO.	TOTAL SHEETS
HAWAII	HAW.	ER-19 (009)	2018	12	29



AS-BUILT

 <small>THIS WORK WAS PREPARED BY ME OR UNDER MY SUPERVISION.</small> <i>James I. Kincaid</i> <small>SIGNATURE</small> <small>EXPIRATION DATE OF THE LICENSE</small>	STATE OF HAWAII DEPARTMENT OF TRANSPORTATION HIGHWAYS DIVISION WAILUA RIVER KUHIO HWY BRIDGE GROUT BAG PLACEMENT - LIFT 2 WAILUA RIVER SCOUR COUNTERMEASURES Proj. No. ER-19(009) Scale: None Date: Oct. 26, 2018
	SHEET No. H-4 OF 29 SHEETS

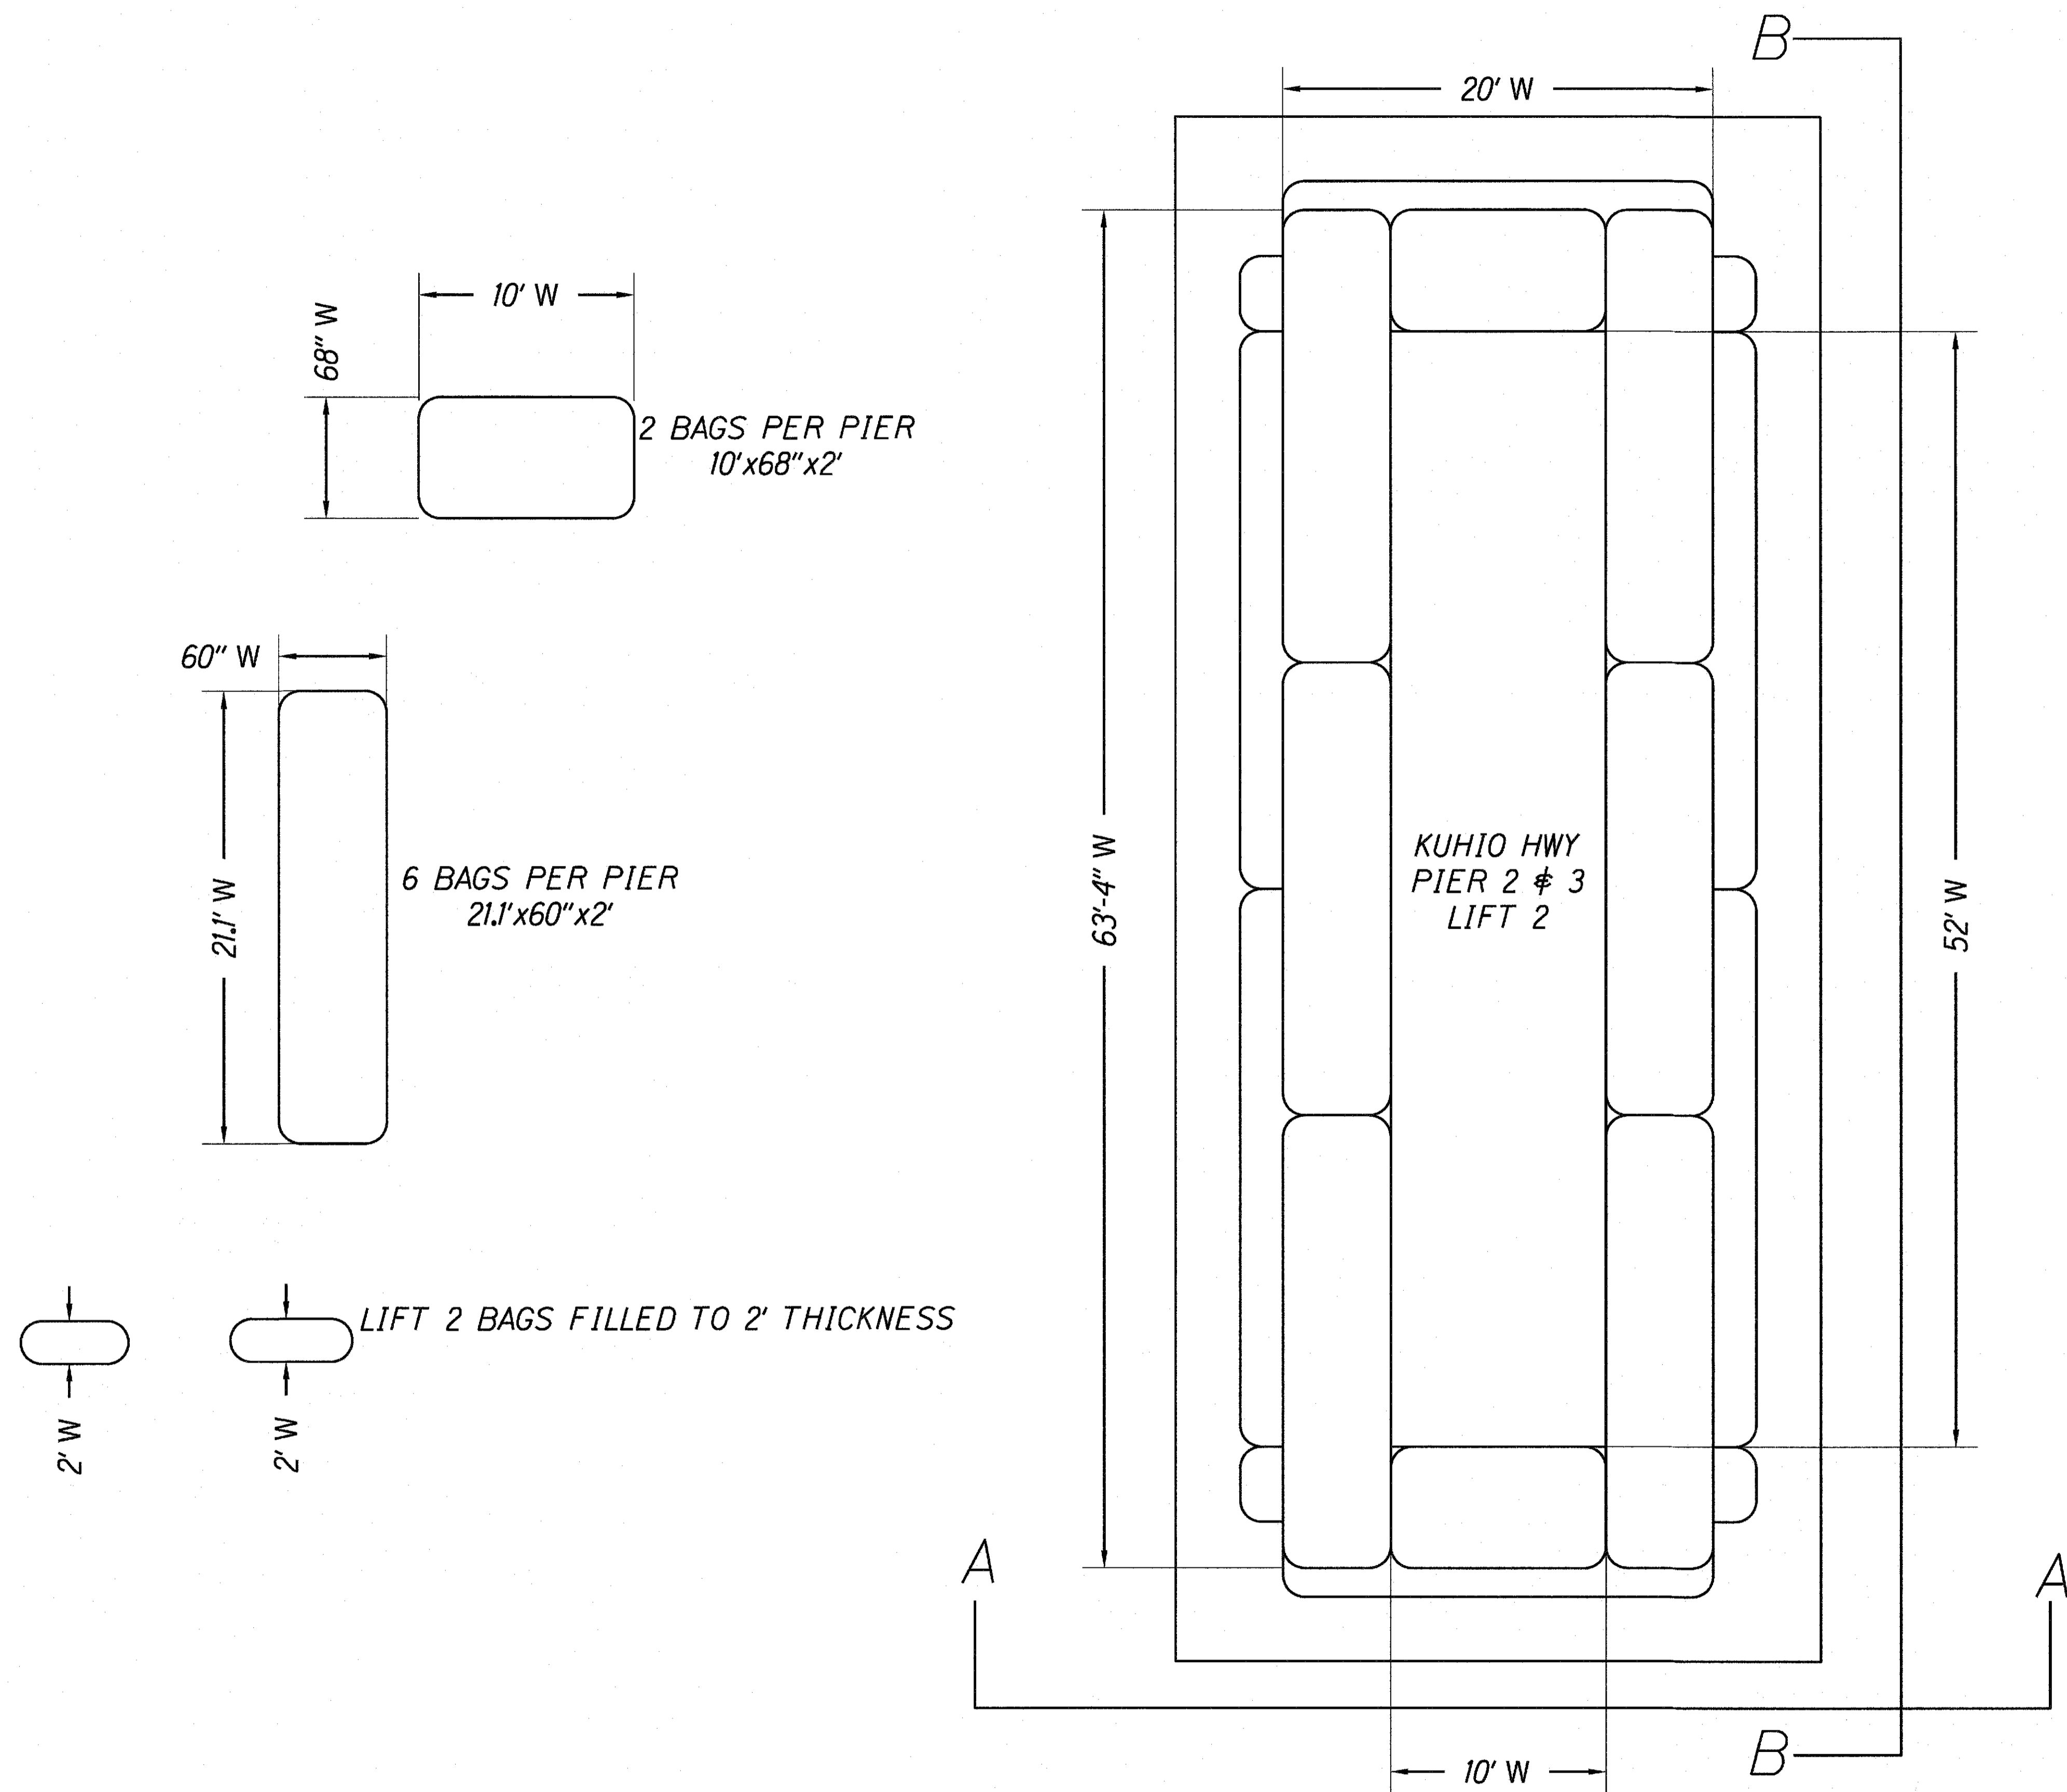