



FED. ROAD DIST. NO.	STATE	FED. AID PROJ. NO.	FISCAL YEAR	SHEET NO.	TOTAL SHEETS
HAWAII	HAW.	ER-19 (009)	2018	14	29

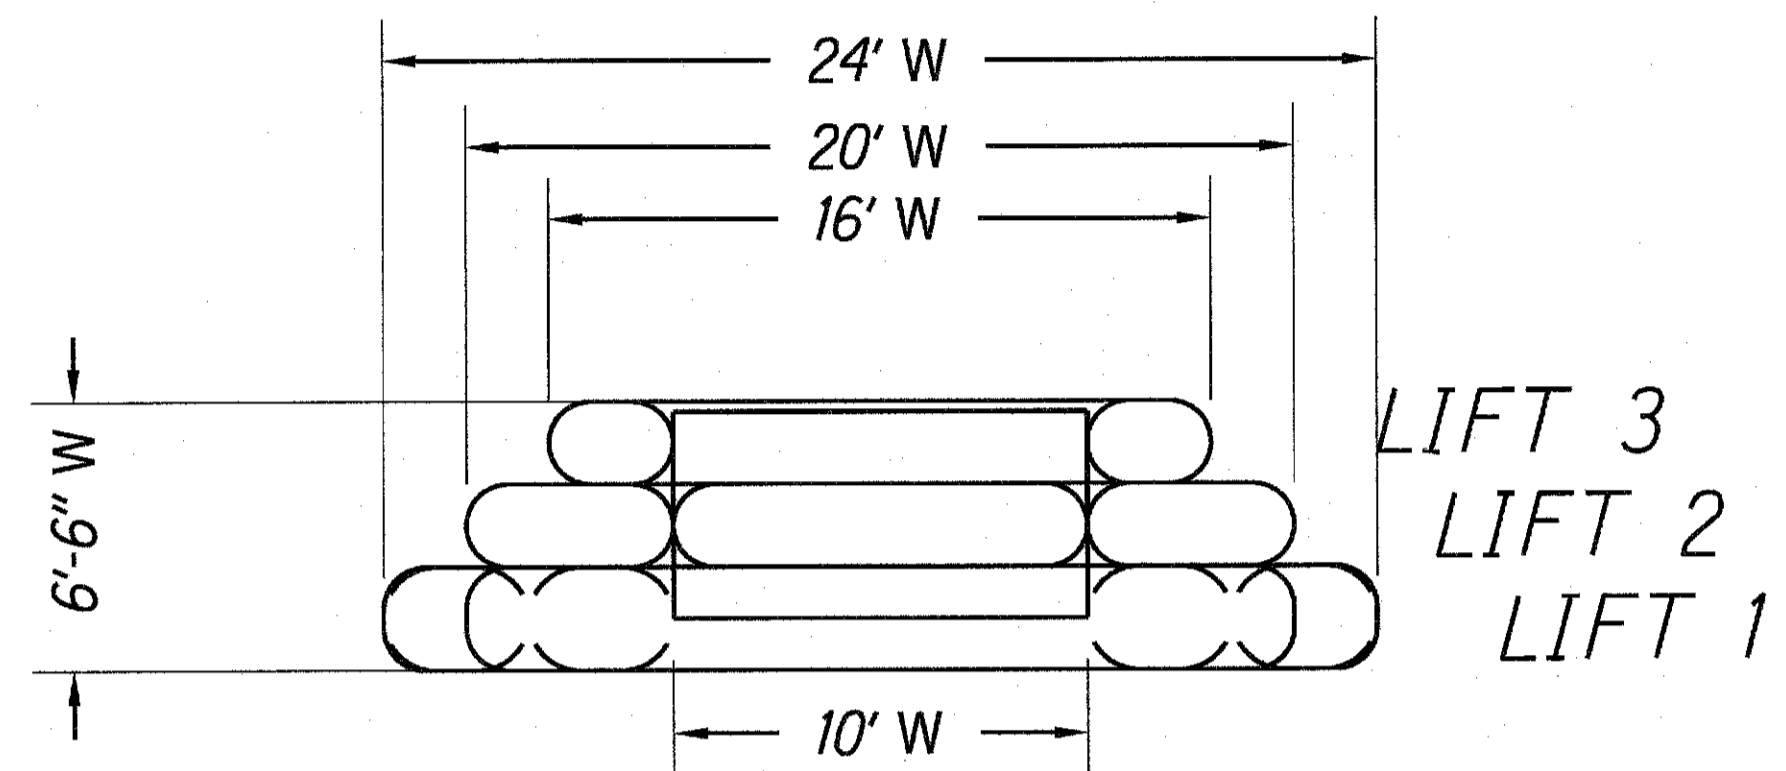

A-A

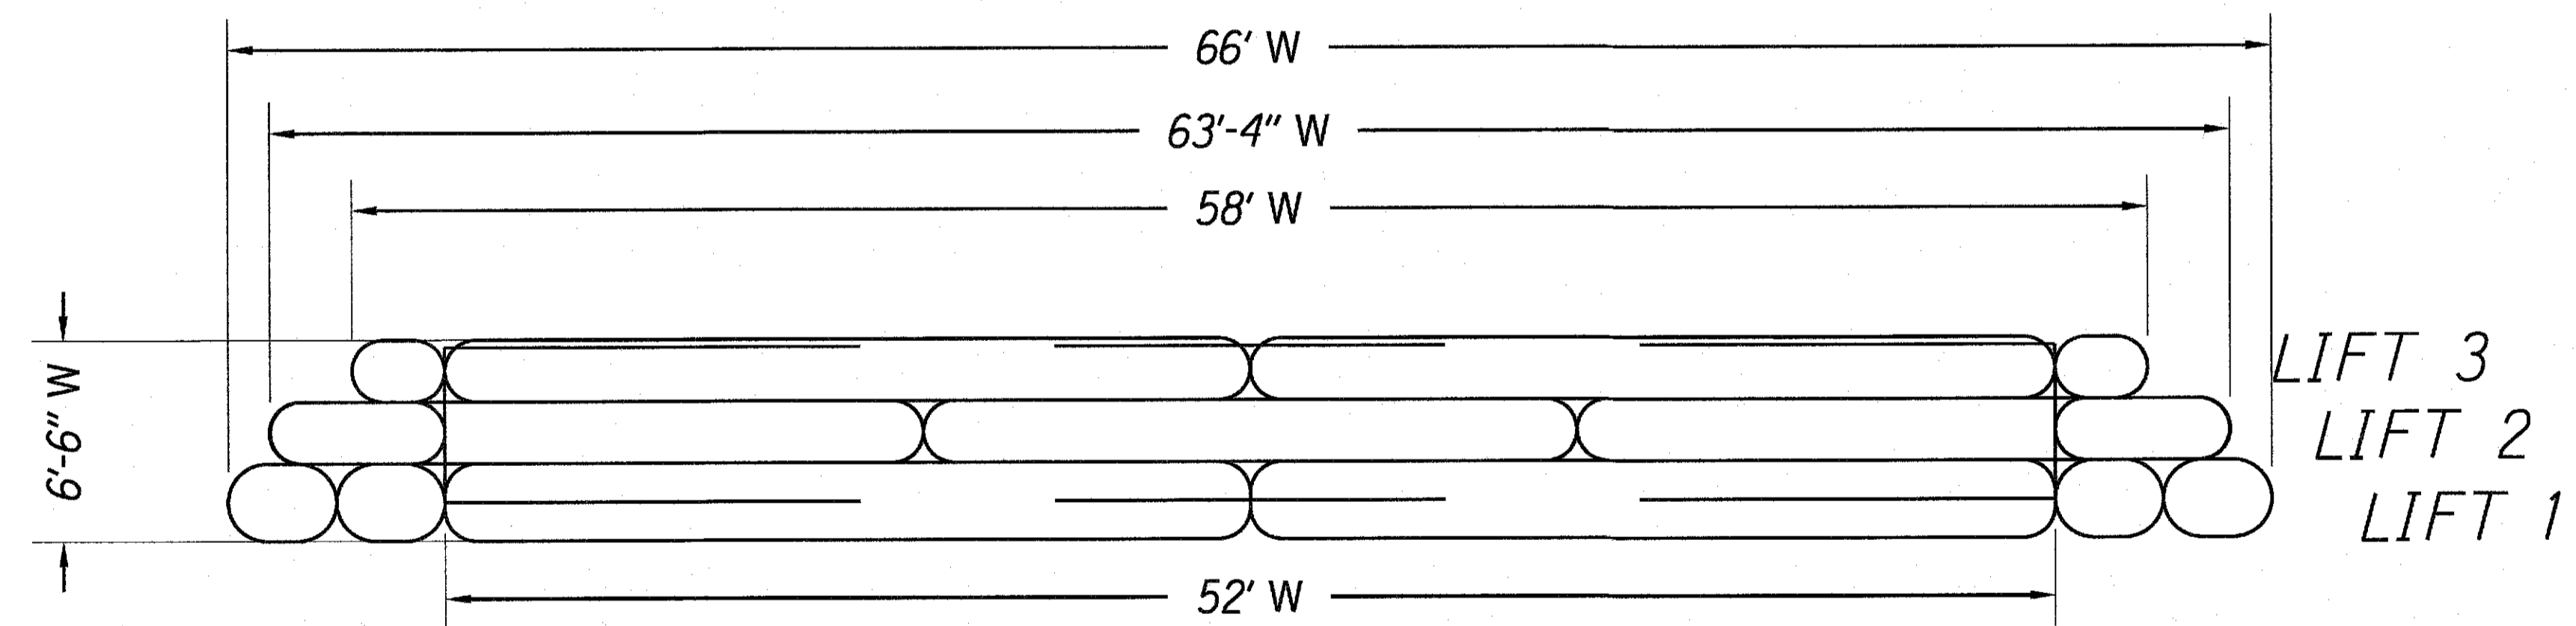

B-B

AS-BUILT

ORIGINAL PLAN	SURVEY PLOTTED BY	DATE
NOTE BOOK	DRAWN BY	
	DESIGNED BY	
	CHECKED BY	

THIS WORK WAS PREPARED BY ME  
OR UNDER MY SUPERVISION.

SIGNATURE: *James I. Kincaid* EXPIRATION DATE: *Oct. 26, 2018*  
OF THE LICENSE

STATE OF HAWAII  
DEPARTMENT OF TRANSPORTATION  
HIGHWAYS DIVISION

**WAILUA RIVER KUHIO HWY BRIDGE**  
**GROUT BAG PLACEMENT - SECTION VIEW**

WAILUA RIVER  
SCOUR COUNTERMEASURES  
Proj. No. ER-19(009)  
Scale: None Date: Oct. 26, 2018

SHEET No. H-6 OF 29 SHEETS