
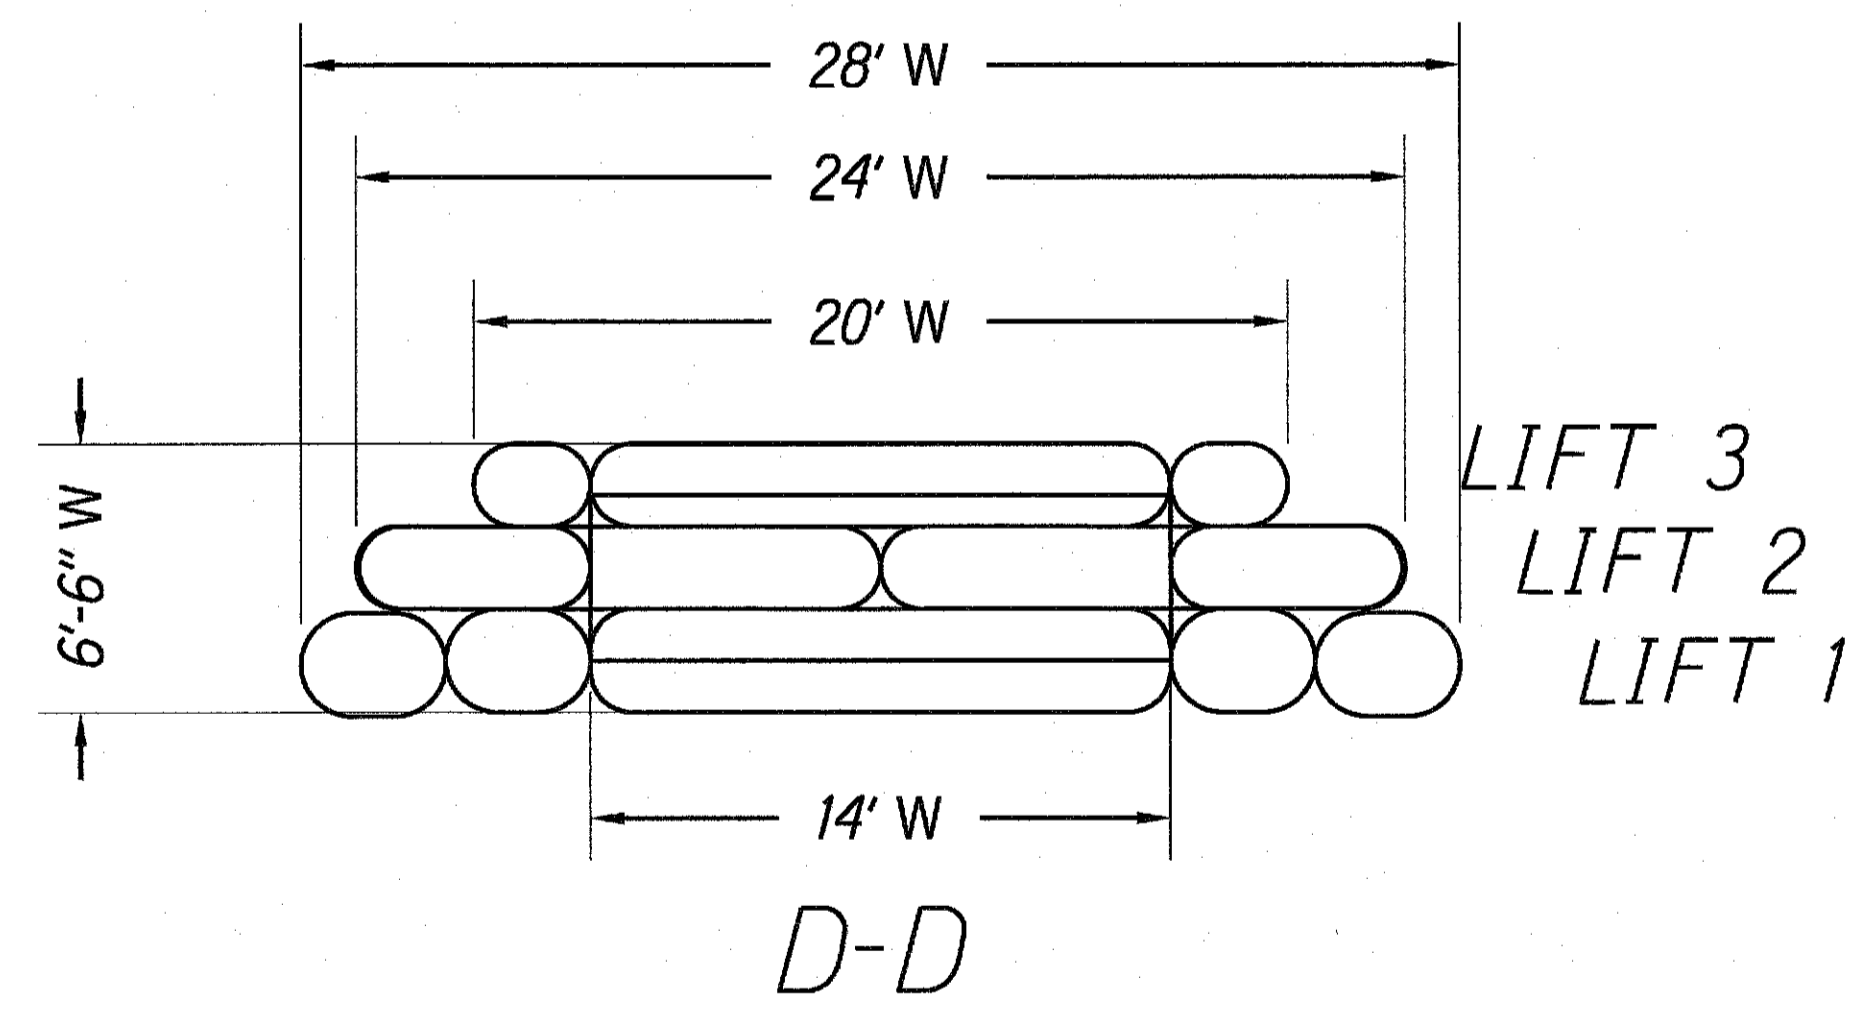



FED. ROAD DIST. NO.	STATE	FED. AID PROJ. NO.	FISCAL YEAR	SHEET NO.	TOTAL SHEETS
HAWAII	HAW.	ER-19 (009)	2018	18	29

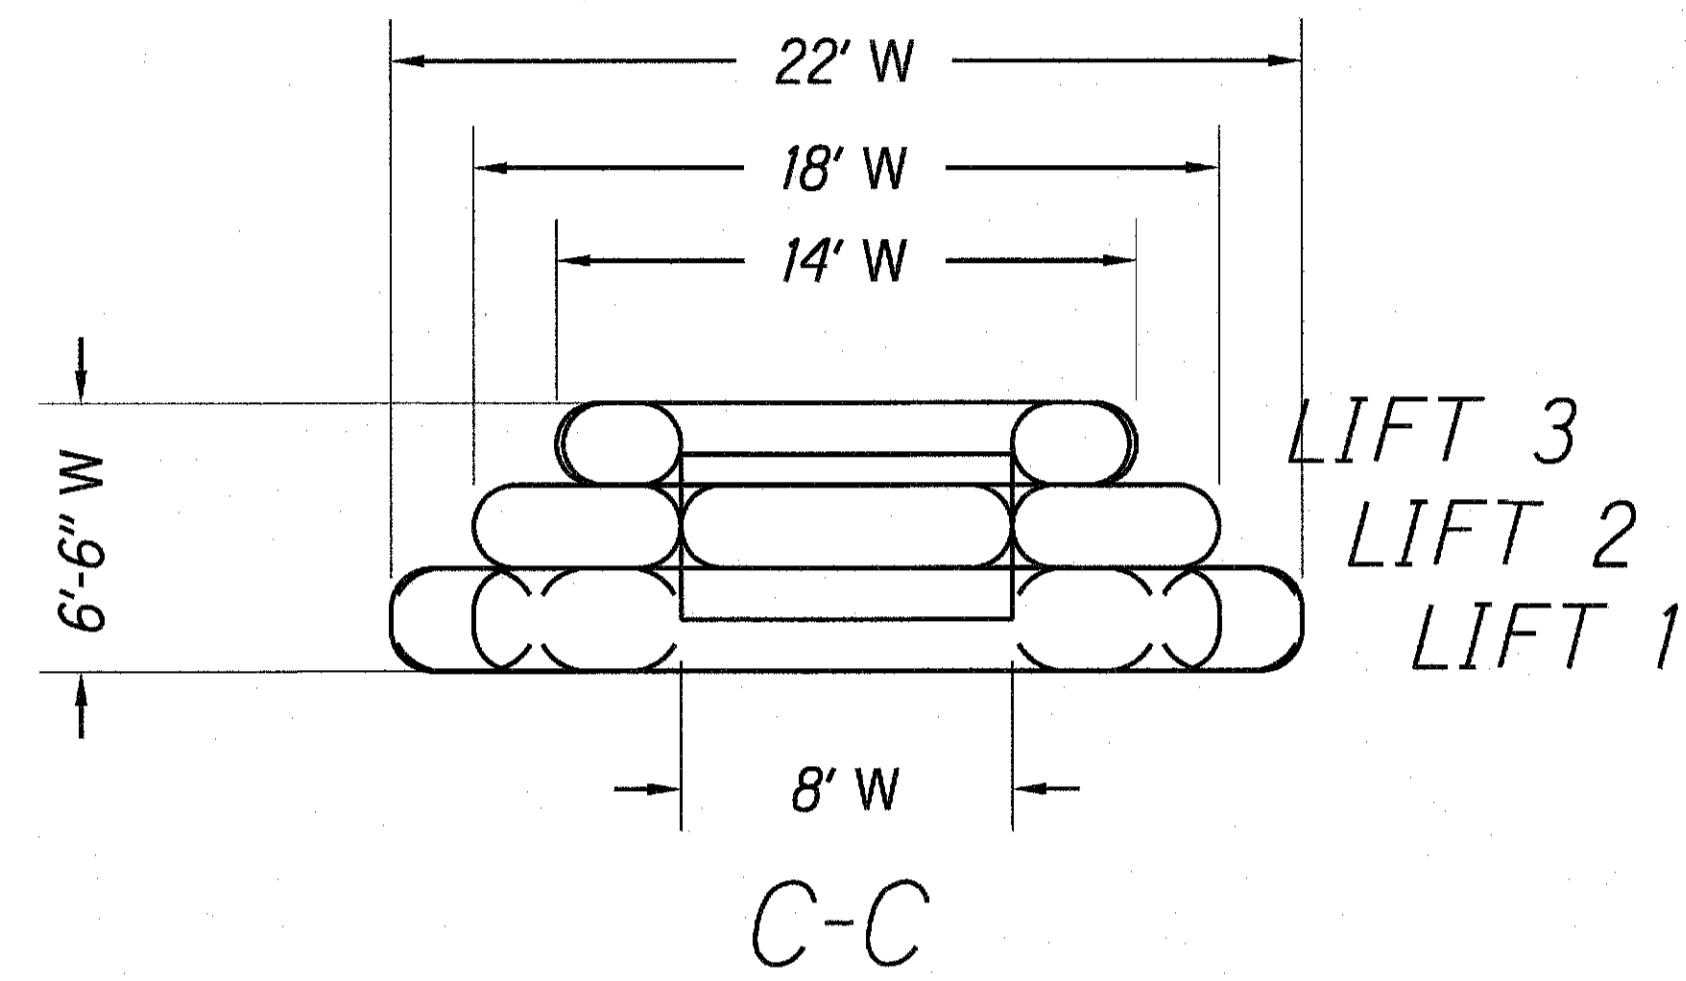

ORIGINAL PLAN	DATE
SURVEY PLOTTED BY	
DRAWN BY	
TRACED BY	
DESIGNED BY	
QUANTIFIED BY	
CHECKED BY	
NO.	

AS-BUILT

 <p>THIS WORK WAS PREPARED BY ME OR UNDER MY SUPERVISION.</p> <p><i>James L. Kincaid</i> SIGNATURE</p> <p>EXPIRATION DATE OF THE LICENSE</p>	<p>STATE OF HAWAII DEPARTMENT OF TRANSPORTATION HIGHWAYS DIVISION</p> <p>WAILUA RIVER PLANTATION BRIDGE GROUT BAG PLACEMENT - SECTION VIEW</p> <p>WAILUA RIVER SCOUR COUNTERMEASURES Proj. No. ER-19(009)</p> <p>Scale: None Date: Oct. 26, 2018</p>
	<p>SHEET No. H-10 OF 29 SHEETS</p>