		INDEX TO DRAWINGS
STRUCTURE ENGINEERS DESIGNED BY P. S. & E. BY PHONE DATE DATE	SHEET NO.	DESCRIPTION
	1	TITLE SHEET
	2	GENERAL NOTES
	3	GENERAL NOTES
	4	GENERAL NOTES
	5	GENERAL NOTES
	6	GENERAL NOTES
	7	BIO SOCK DETAILS
	8	SILT CURTAIN
	H_1	KUHIO HWY BRIDGE
	H-2	PLANTATION BRIDGE
	H–3	PLAN VIEW BAG PLACEMENT LIFT 1 – KUHIO HWY
	H–4	PLAN VIEW BAG PLACEMENT LIFT 2 – KUHIO HWY
	H–5	PLAN VIEW BAG PLACEMENT LIFT 3 – KUHIO HWY
	H–6	SECTION VIEW BAG PLACEMENT - KUHIO HWY
	H-7	PLAN VIEW BAG PLACEMENT LIFT 1 – PLANTATION
	H–8	PLAN VIEW BAG PLACEMENT LIFT 2 – PLANTATION
	H–9	PLAN VIEW BAG PLACEMENT LIFT 3 – PLANTATION
	H–10	SECTION VIEW BAG PLACEMENT - PLANTATION
	H–11	EXAMPLE GROUT BAG DETAIL
	H–12	GROUT BAG DETAILS LIFT 1 - KUHIO HWY
	H–13	GROUT BAG DETAILS LIFTS 2 & 3 - KUHIO HWY
	H–14	GROUT BAG DETAILS LIFT 1 - PLANTATION
	H–15	GROUT BAG DETAILS LIFTS 2 & 3 - PLANTATION
	TC-1	TRAFFIC CONTROL NOTES AND LEGEND
	TC-2	LOW SPEED UNDIVIDED HIGHWAY WORK ZONE SIGNING PLAN, NOTES & DETAILS
	TC-3	TRAFFIC CONROL PLAN WAILUA PHASE 1
	TC-4	TRAFFIC CONTROL PLAN WAILUA PHASE 2
	TC-5	TRAFFIC CONTROL PLAN WAILUA PHASE 3
	TC-6	TRAFFIC CONTROL PLAN WAILUA PHASE 4

STATE OF HAWAII

DEPARTMENT OF TRANSPORTATION

HIGHWAYS DIVISION HONOLULU, HAWAII


"AS-BUHT"

PLANS FOR

WAILUA RIVER SCOUR COUNTERMEASURES AT

WAILUA RIVER KUHIO HWY BRIDGE ID #007000560400572 WAILUA RIVER PLANTATION BRIDGE ID #007000560400573 FEDERAL-AID PROJECT NO. ER-19(009)

STATE OF HAWAII ISLAND OF KAUAI

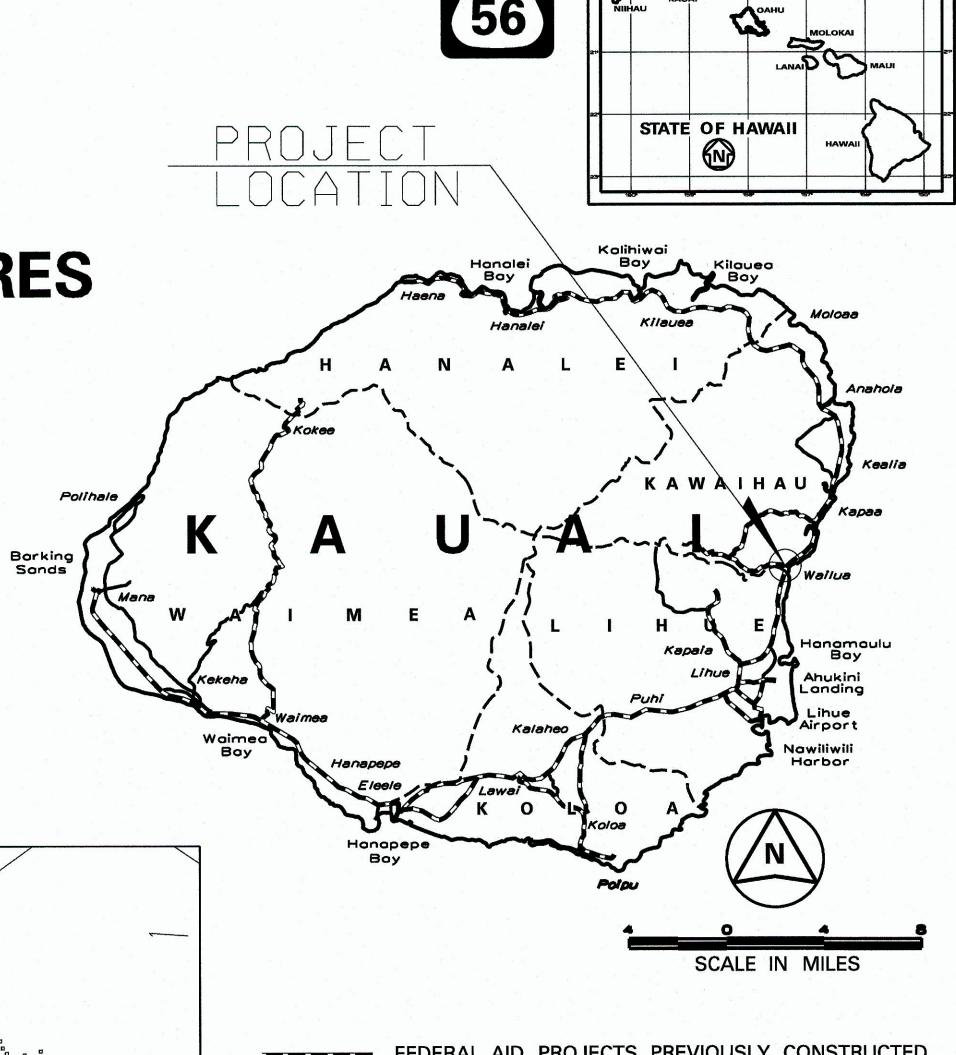

FEDERAL AID PROJECTS PREVIOUSLY CONSTRUCTED OR UNDER CONSTRUCTION

FED. AID PROJ. NO.

ER-19(009)

MILE POST 5.6 TO MILE POST 5.8

CHANGES MADE DURING CONSTRUCTION HAVE BEEN INCORPORATED ON THESE PLANS EXCEPT CHANGES IN THE ORIGINAL THEORETICAL QUANTITIES. FOR ACTUAL QUANTITIES, REFER TO PROJECT LEDGER AND/OR COMPUTATION BOOK.

O5/20/21

RESIDENT ENGINEER

DATE

AS-BUILT

DEPARTMENT OF TRANSPORTATION
STATE OF HAWAII

APPROVED:

DIR. OF TRANSPORTATION DATE

LAYOUT PLAN