


FED. ROAD DIST. NO.	STATE	FEDERAL AID PROJ. NO.	FISCAL YEAR	SHEET NO.	TOTAL SHEETS
HAWAII	HAW.	ER-19(009)	2018	26	29

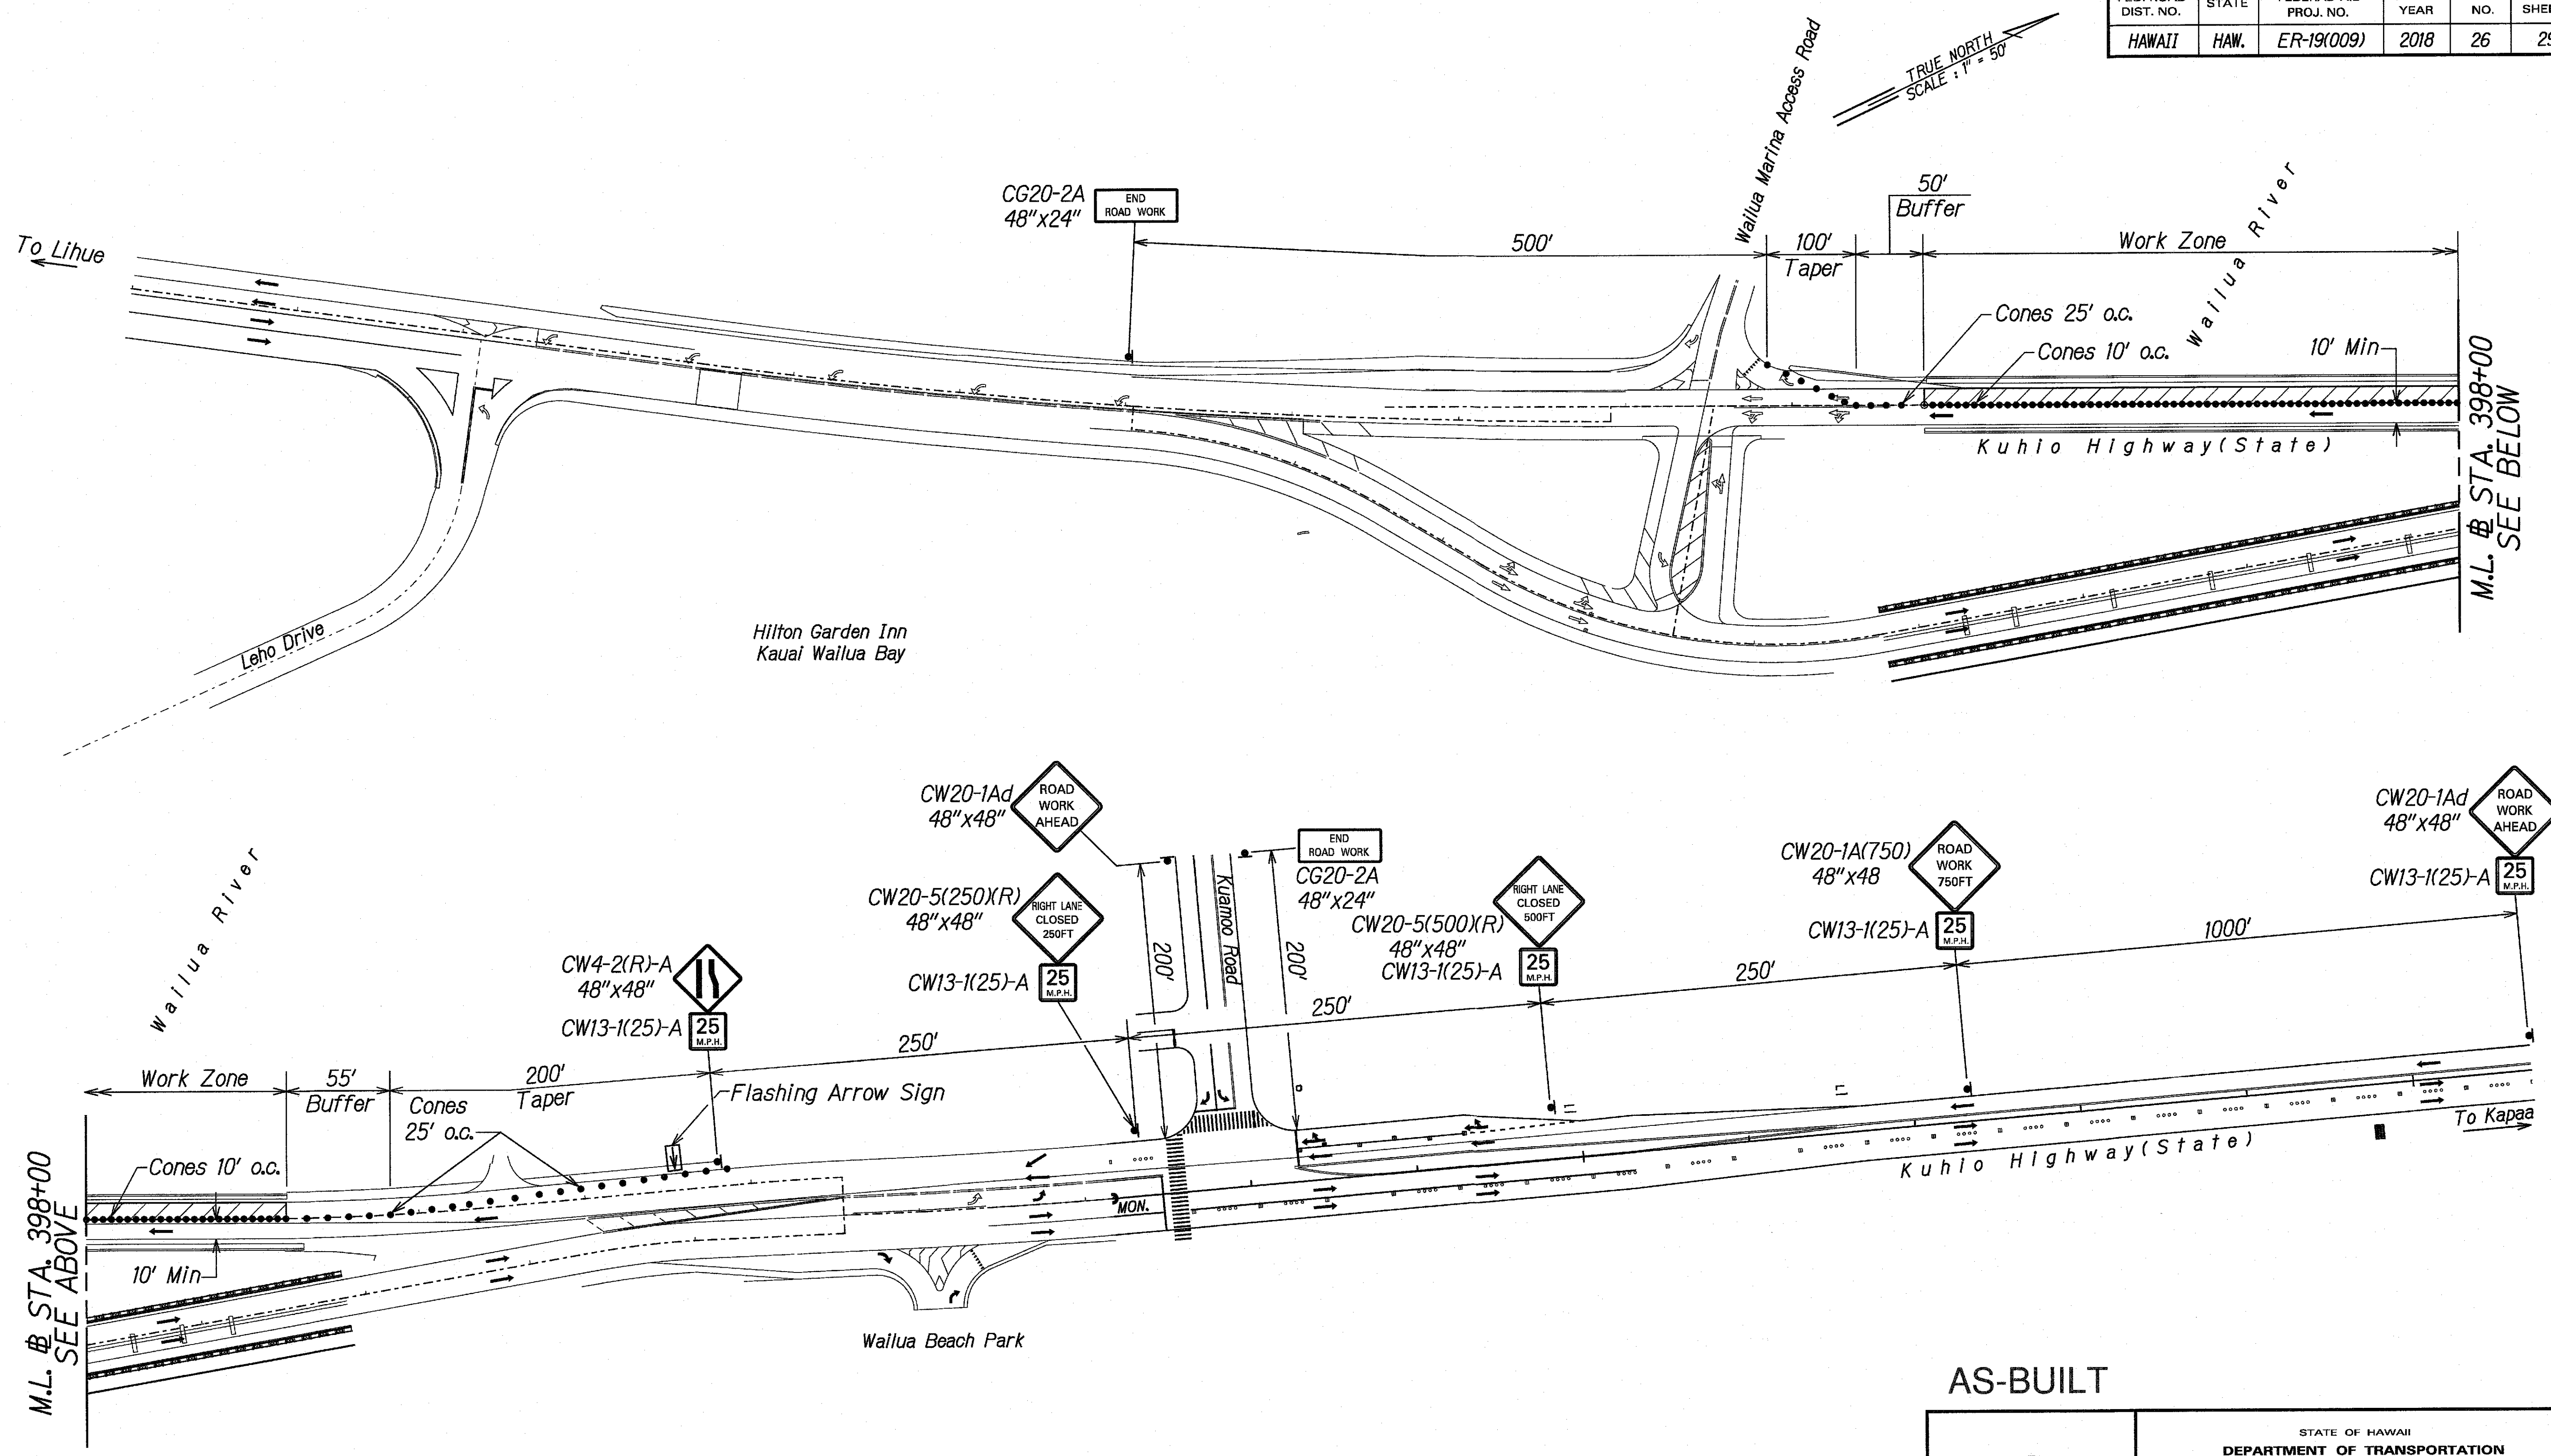

DATE	_____
SURVEY PLOTTED BY	_____
DRAWN BY	_____
CHECKED BY	_____
ORIGINAL PLAN	_____
NOTE BOOK	_____
NO.	_____

NOTE:
Lane Closure only allowed from 11:00 a.m. to 3:30 p.m. (after morning Contraflow cones removed.)

AS-BUILT

THIS WORK WAS PREPARED BY ME OR UNDER MY SUPERVISION.

R. Urakawa
SIGNATURE

EXPIRATION DATE OF THE LICENSE


STATE OF HAWAII
DEPARTMENT OF TRANSPORTATION
HIGHWAYS DIVISION

TRAFFIC CONTROL PLAN
WAILUA PHASE 1

WAILUA RIVER
SCOUR COUNTERMEASURES
Proj. No. ER-19(009)

Scale: 1"=50' Date: Oct. 26, 2018

FED. ROAD DIST. NO.	STATE	FEDERAL AID PROJ. NO.	FISCAL YEAR	SHEET NO.	TOTAL SHEETS
HAWAII	HAW.	ER-19(009)	2018	27	29

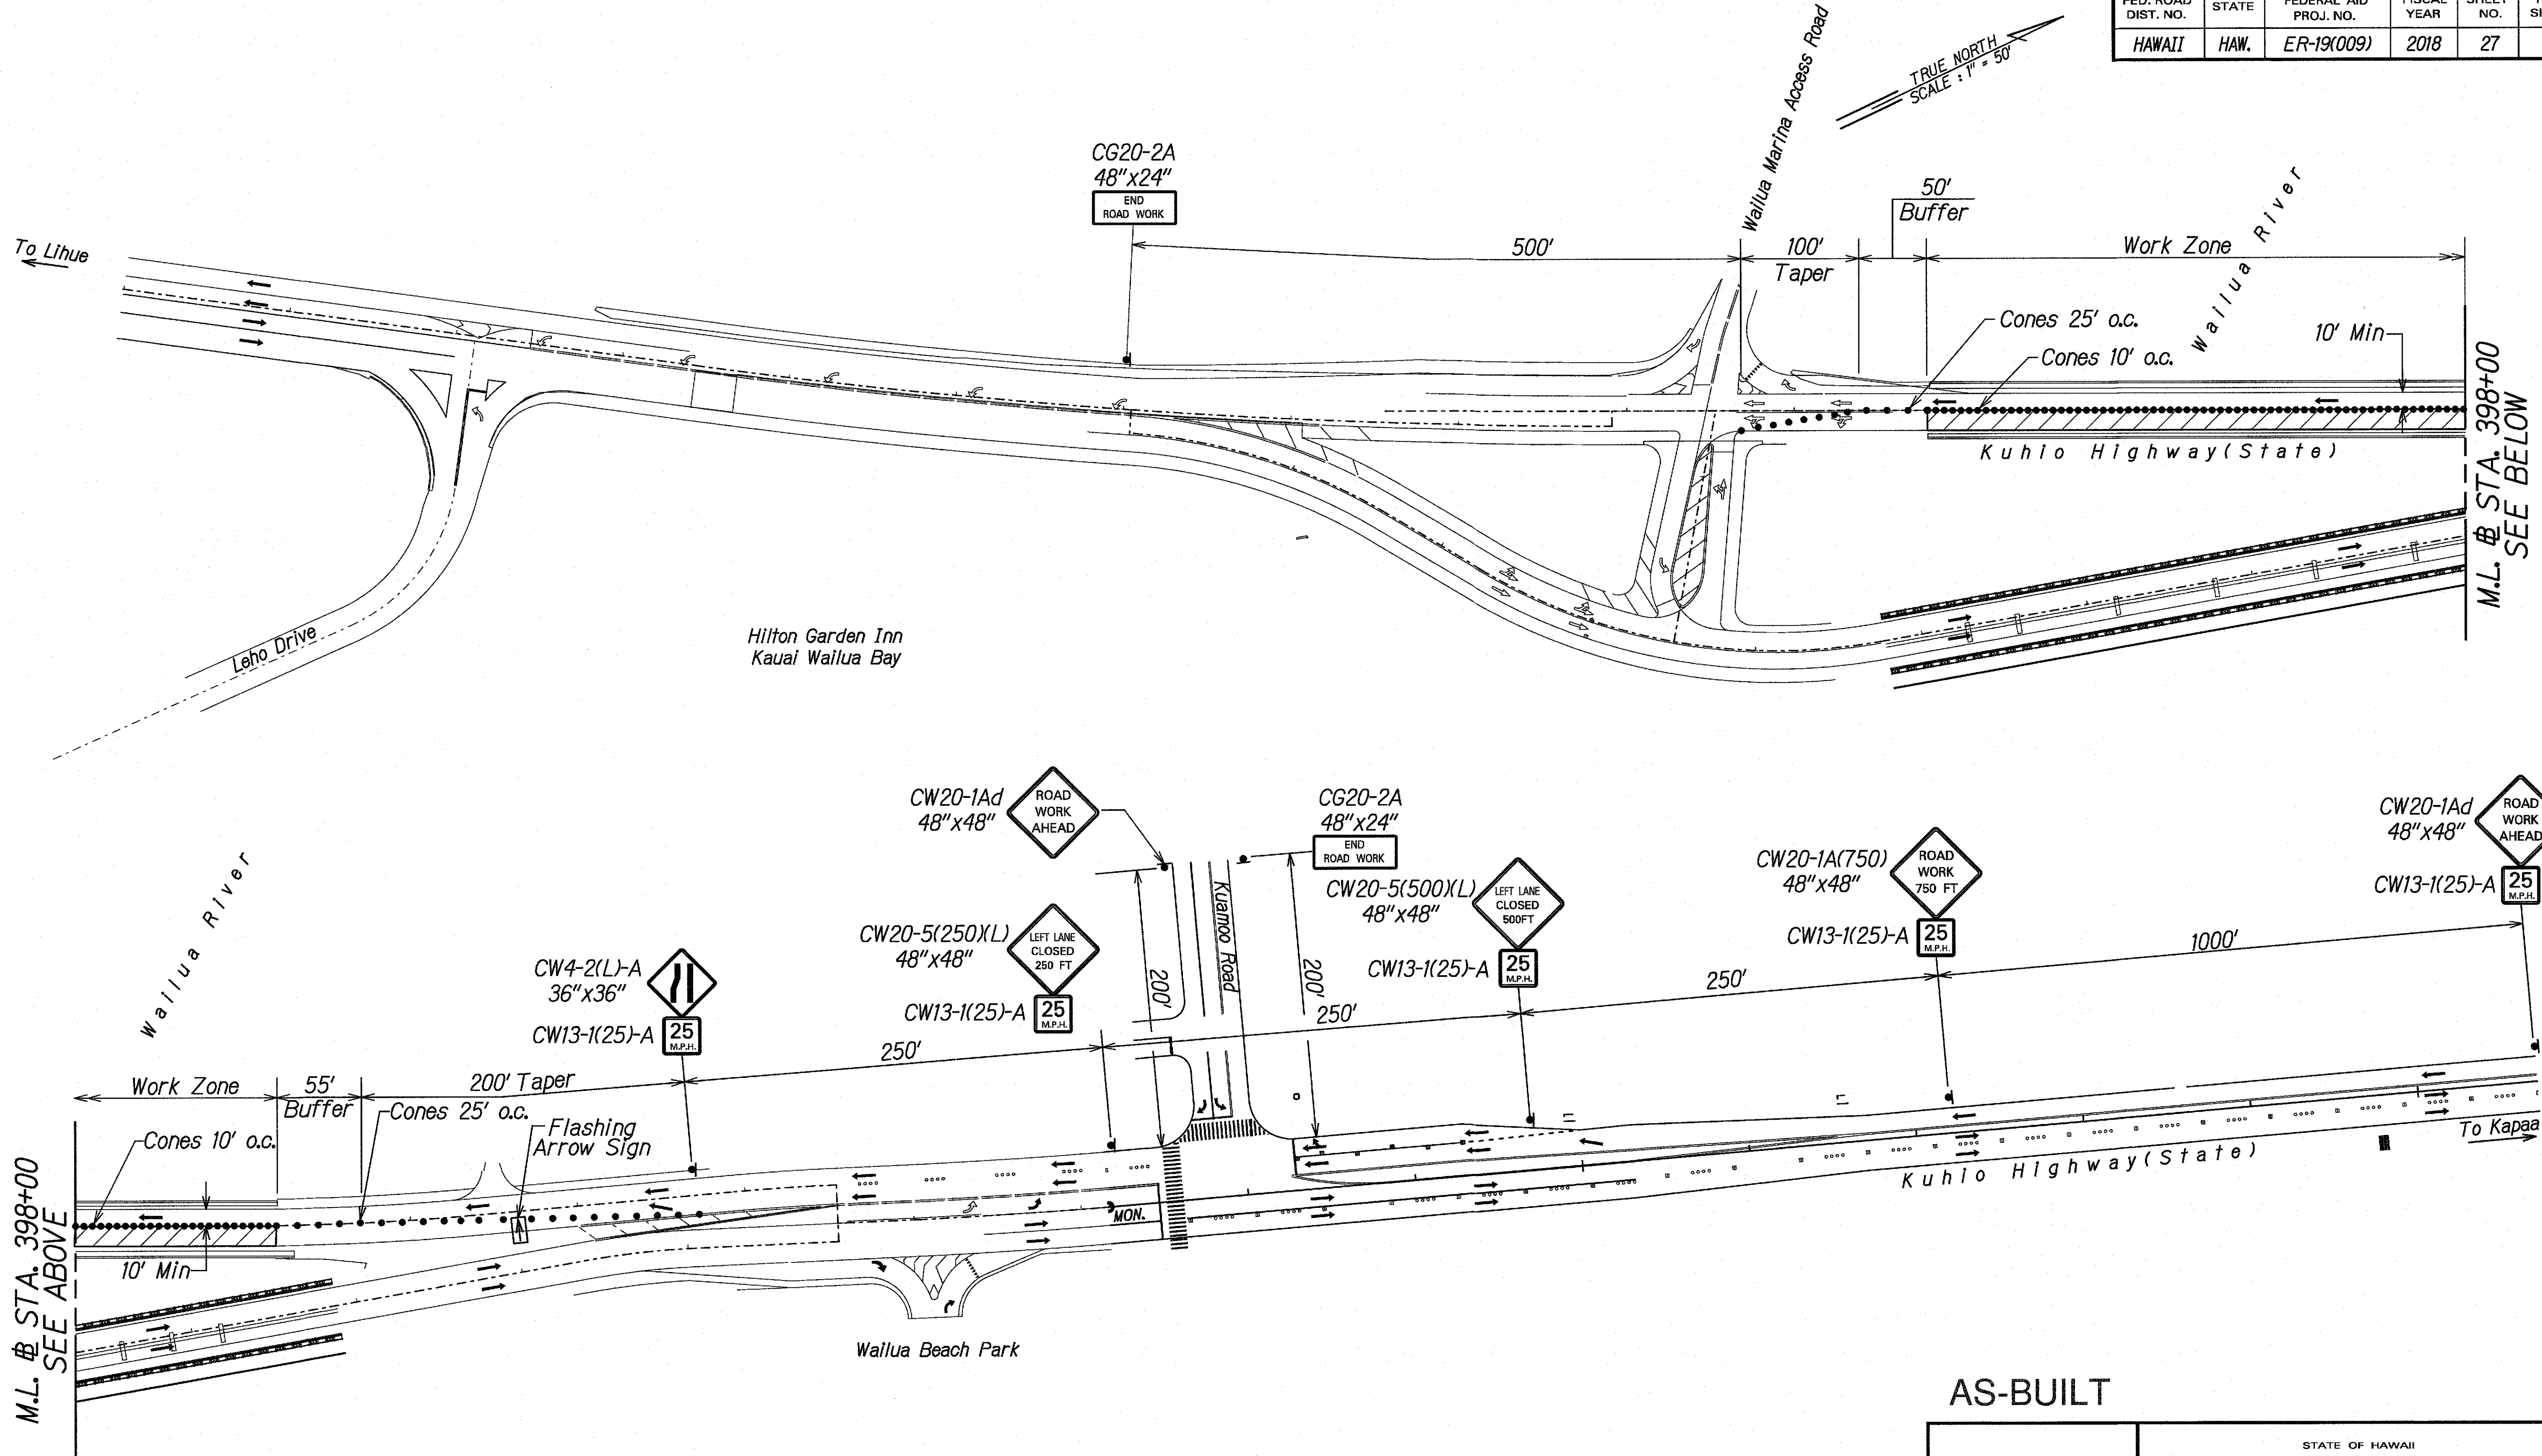

DATE	_____
SURVEY PLOTTED BY	_____
DRAWN BY	_____
TRACED BY	_____
NOTED BY	_____
CHECKED BY	_____
ORIGINAL PLAN	_____
NOTE BOOK	_____
IN.	_____

NOTE:
Lane Closure only allowed from 11:00 a.m. to 3:30 p.m. (after morning Contraflow cones removed.)

AS-BUILT

THIS WORK WAS PREPARED BY ME OR UNDER MY SUPERVISION.

R. Urashki

SIGNATURE

EXPIRATION DATE OF THE LICENSE

STATE OF HAWAII
DEPARTMENT OF TRANSPORTATION
HIGHWAYS DIVISION

TRAFFIC CONTROL PLAN
WAILUA PHASE 2

WAILUA RIVER
SCOUR COUNTERMEASURES
Proj. No. ER-19(009)

Scale: 1"=50' Date: Oct. 26, 2018

SHEET No. TC-4 OF 29 SHEETS

