


FED. ROAD DIST. NO.	STATE	PROJ. NO.	FISCAL YEAR	SHEET NO.	TOTAL SHEETS
HAWAII	HAW.	56C-01-15M	2017	10	21

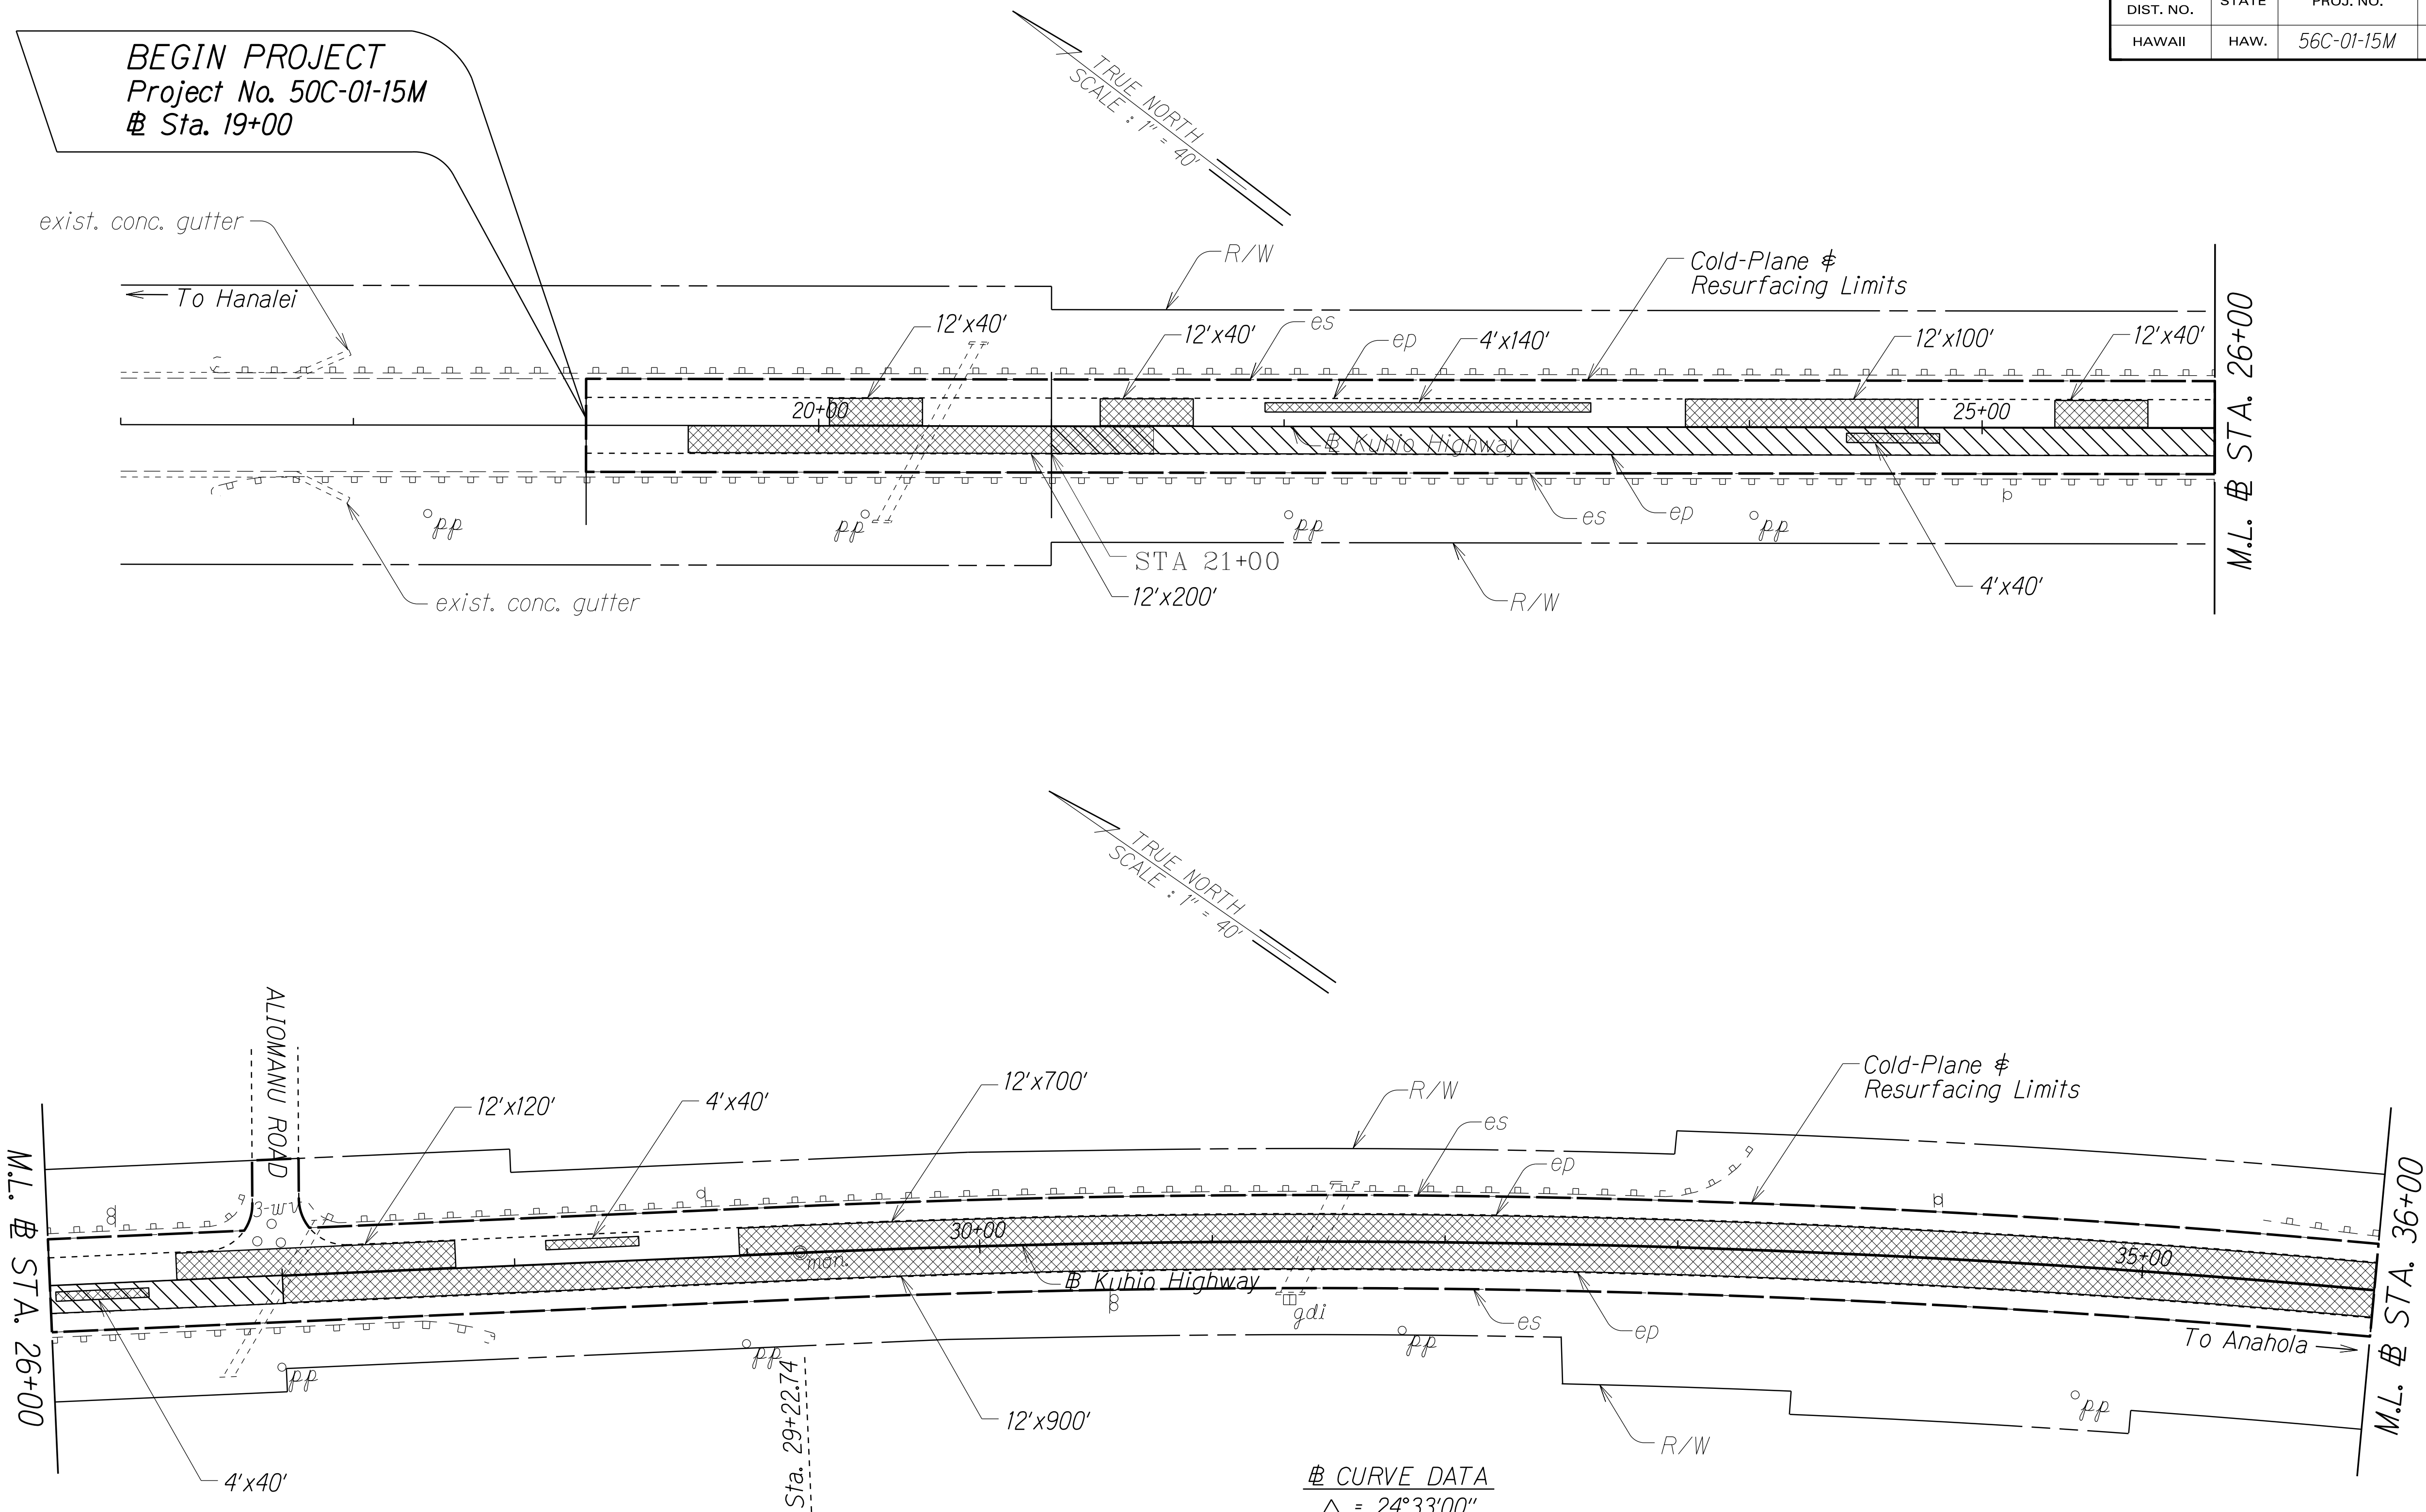

ORIGINAL PLAN	SURVEY PLOTTED BY	DATE
NOTE BOOK	DRAWN BY	
DESIGNED BY	TRACED BY	
CHECKED BY	DESIGNED BY	
	CHECKED BY	

LEGEND FOR AS-BUILT POSTINGS	
	Squiggly line for as-built deletion
	Double line for as-built deletion
Roadway	Text for as-built posting

STATE OF HAWAII
DEPARTMENT OF TRANSPORTATION
HIGHWAYS DIVISION

ROADWAY PLAN

KUHIO HIGHWAY RESURFACING

Papaa Road to Aliomanu Road (South)


Project No. 56C-01-15M

Scale: 1" = 40' Date: August 2016

SHEET No. 1 OF 4 SHEETS

"AS-BUILT"



FED. ROAD DIST. NO.	STATE	PROJ. NO.	FISCAL YEAR	SHEET NO.	TOTAL SHEETS
HAWAII	HAW.	56C-01-15M	2017	ADD. 11	21

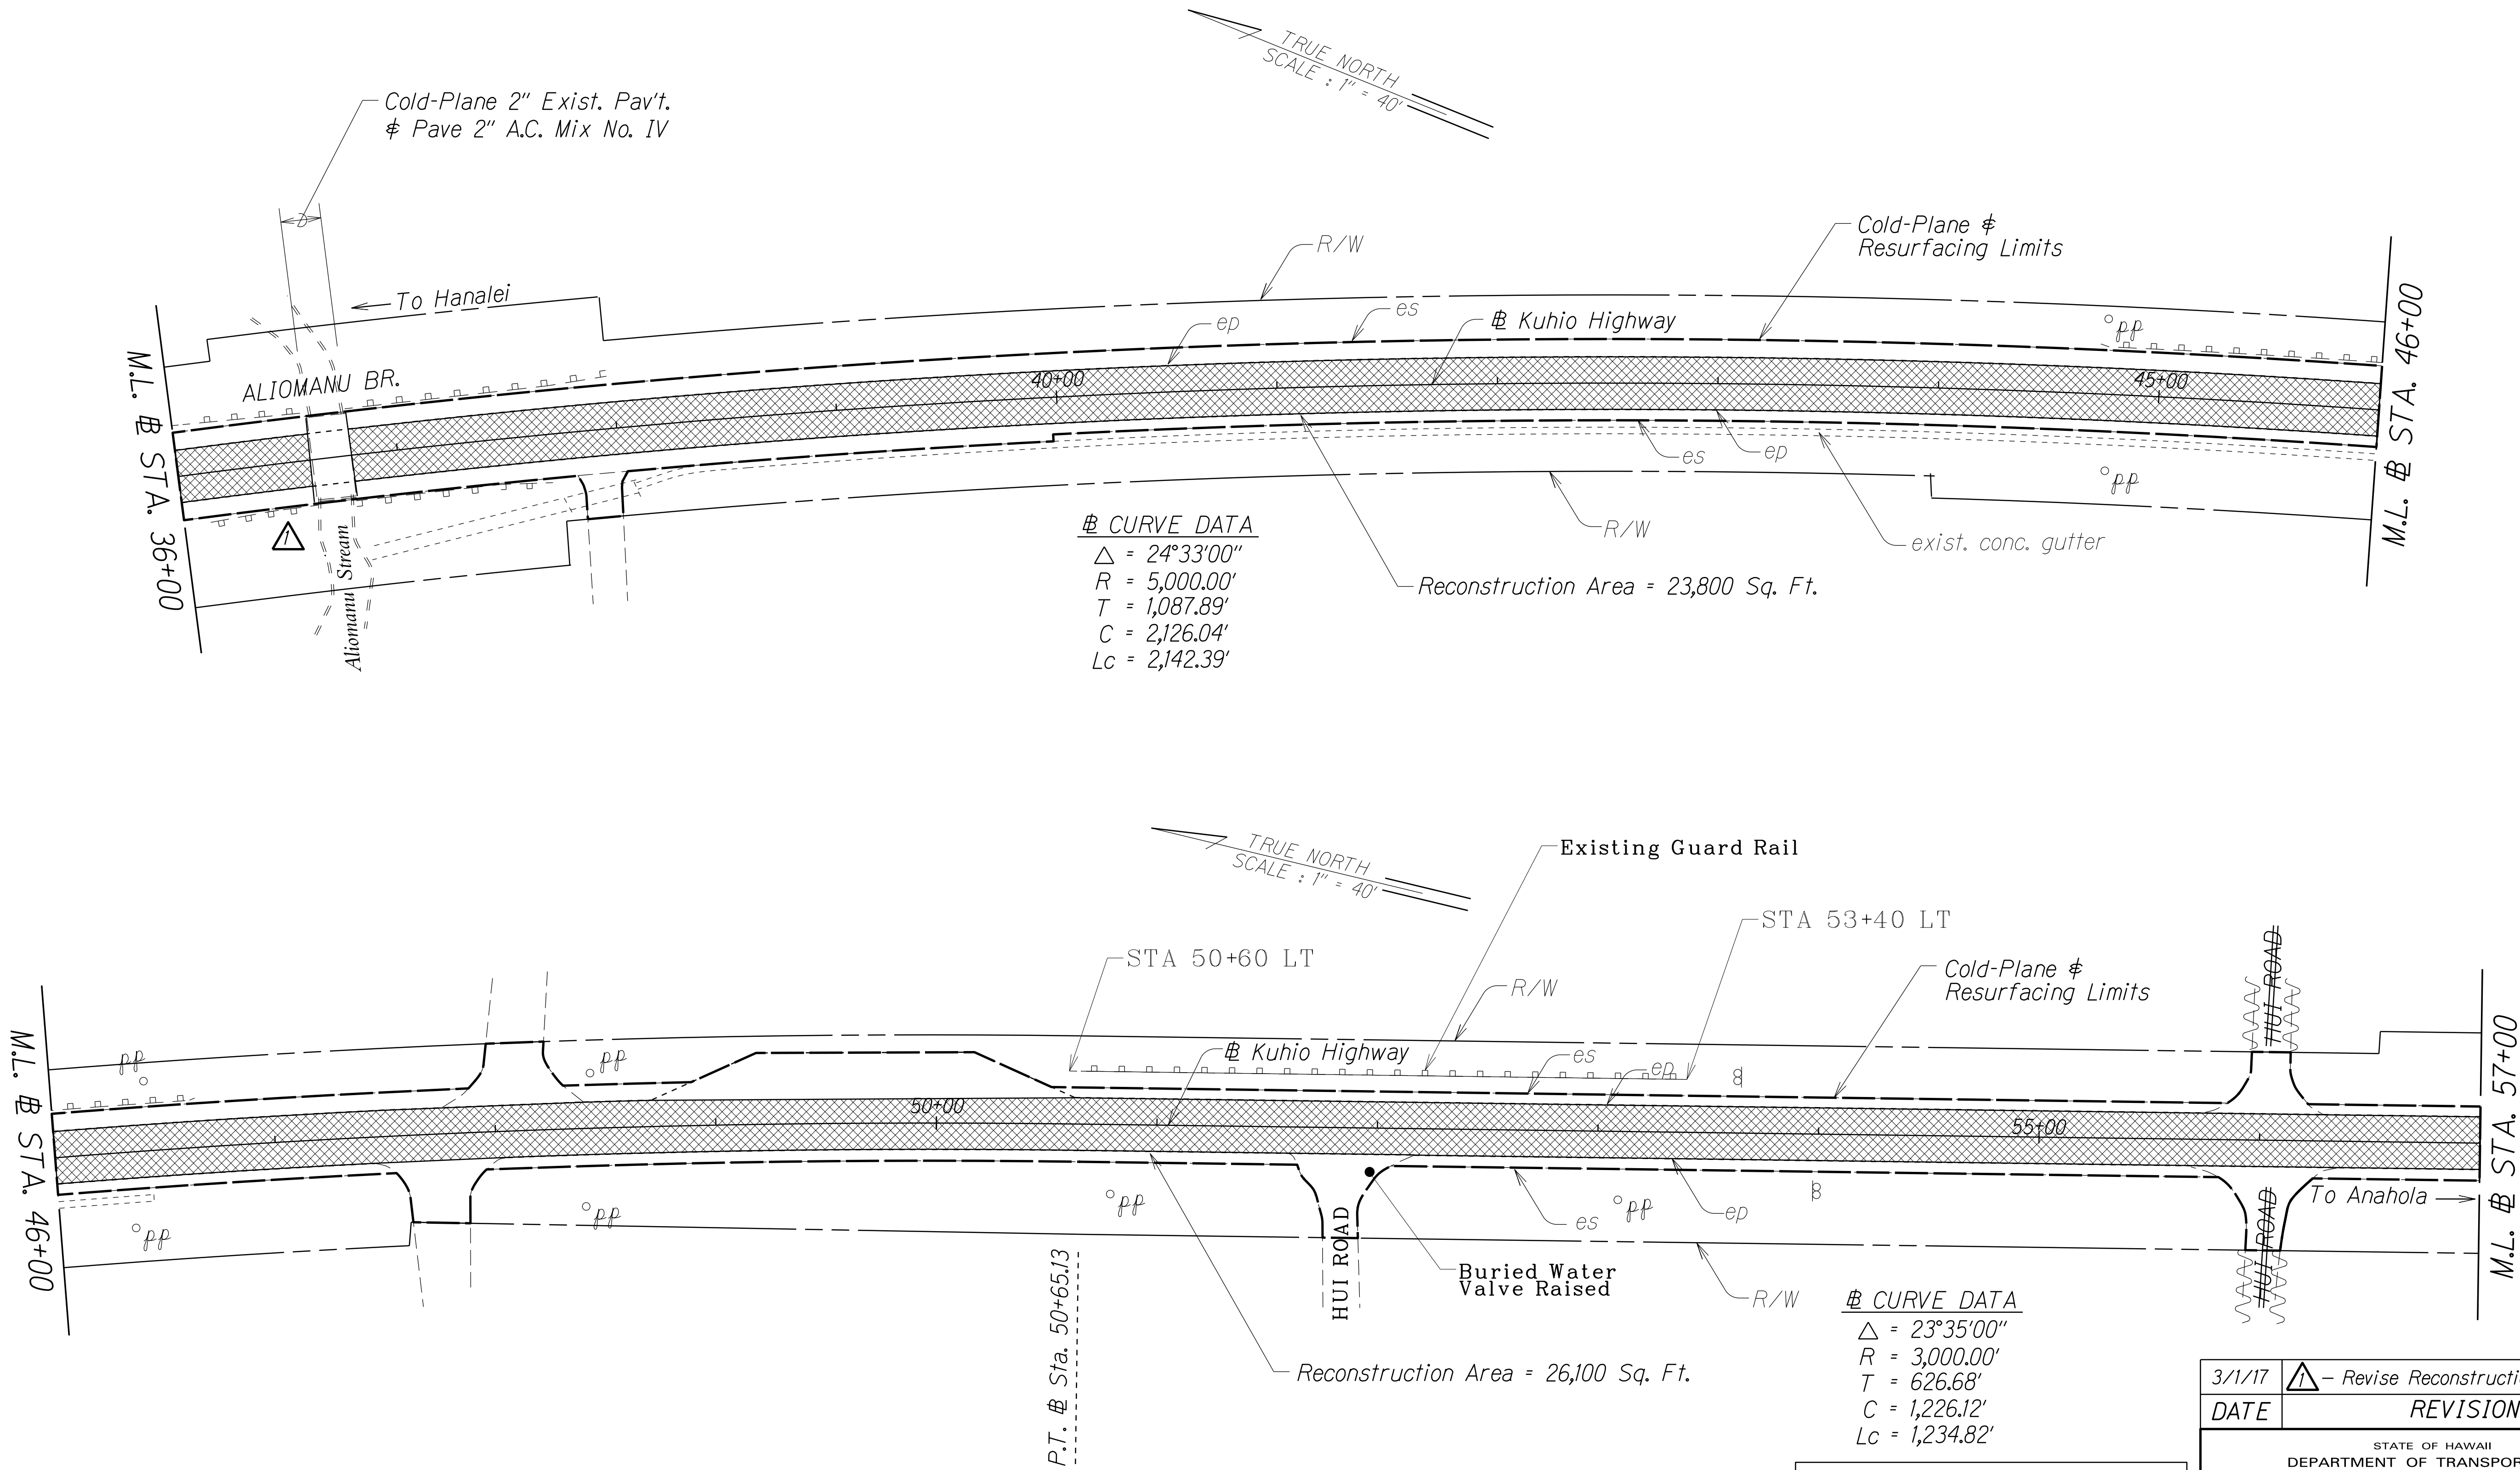

ORIGINAL PLAN	SURVEY PLOTTED BY	DATE
NOTE BOOK	DRAWN BY	
DESIGNED BY	TRACED BY	
CHECKED BY	DESIGNED BY	
NO. ADD. SIGN	CHECKED BY	

3/1/17	- Revise Reconstruction Area
DATE	REVISION
STATE OF HAWAII DEPARTMENT OF TRANSPORTATION HIGHWAYS DIVISION	
ROADWAY PLAN	
KUHIO HIGHWAY RESURFACING	
Papaa Road to Aliomanu Road (South)	
Project No. 56C-01-15M	
Scale: 1" = 40'	Date: March 2017
SHEET No. 2 OF 4 SHEETS	

FED. ROAD DIST. NO.	STATE	PROJ. NO.	FISCAL YEAR	SHEET NO.	TOTAL SHEETS
HAWAII	HAW.	56C-01-15M	2017	12	21

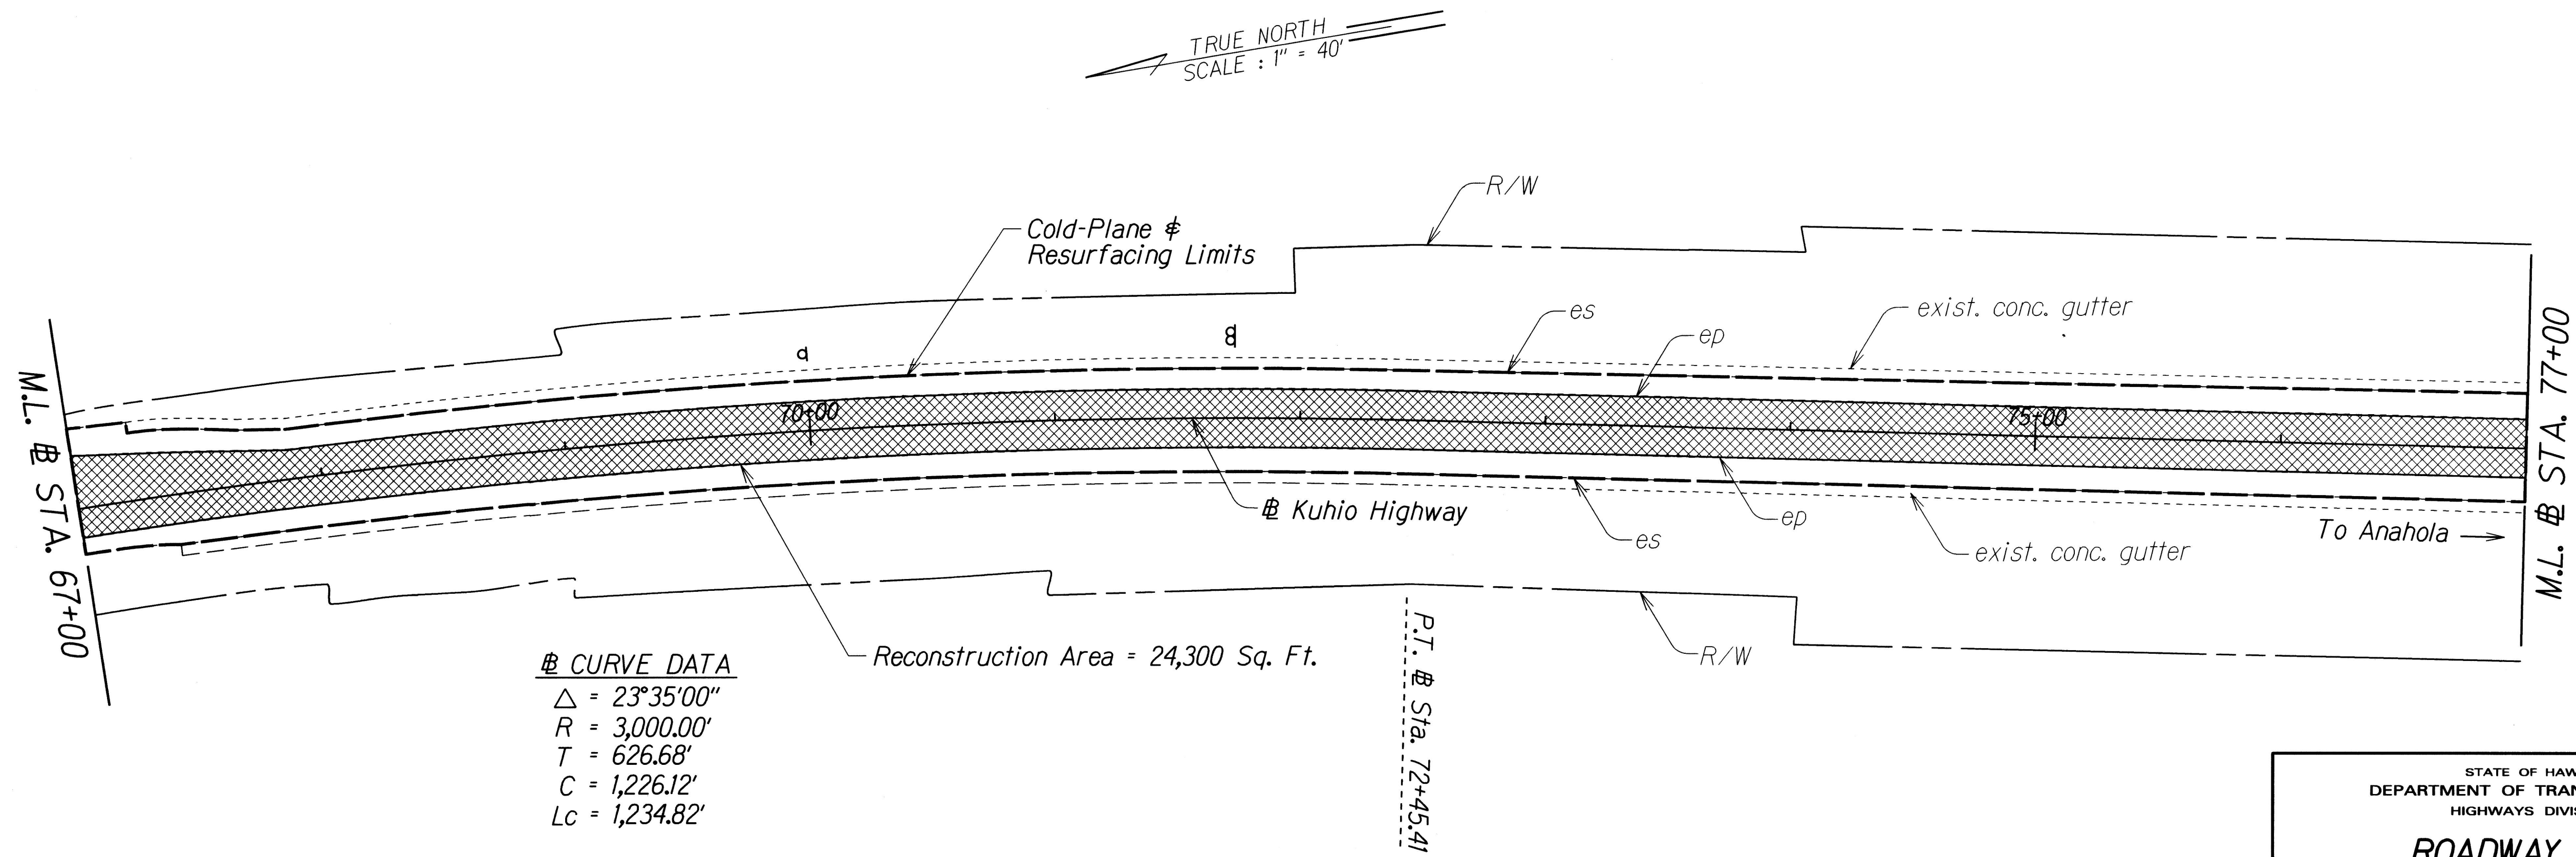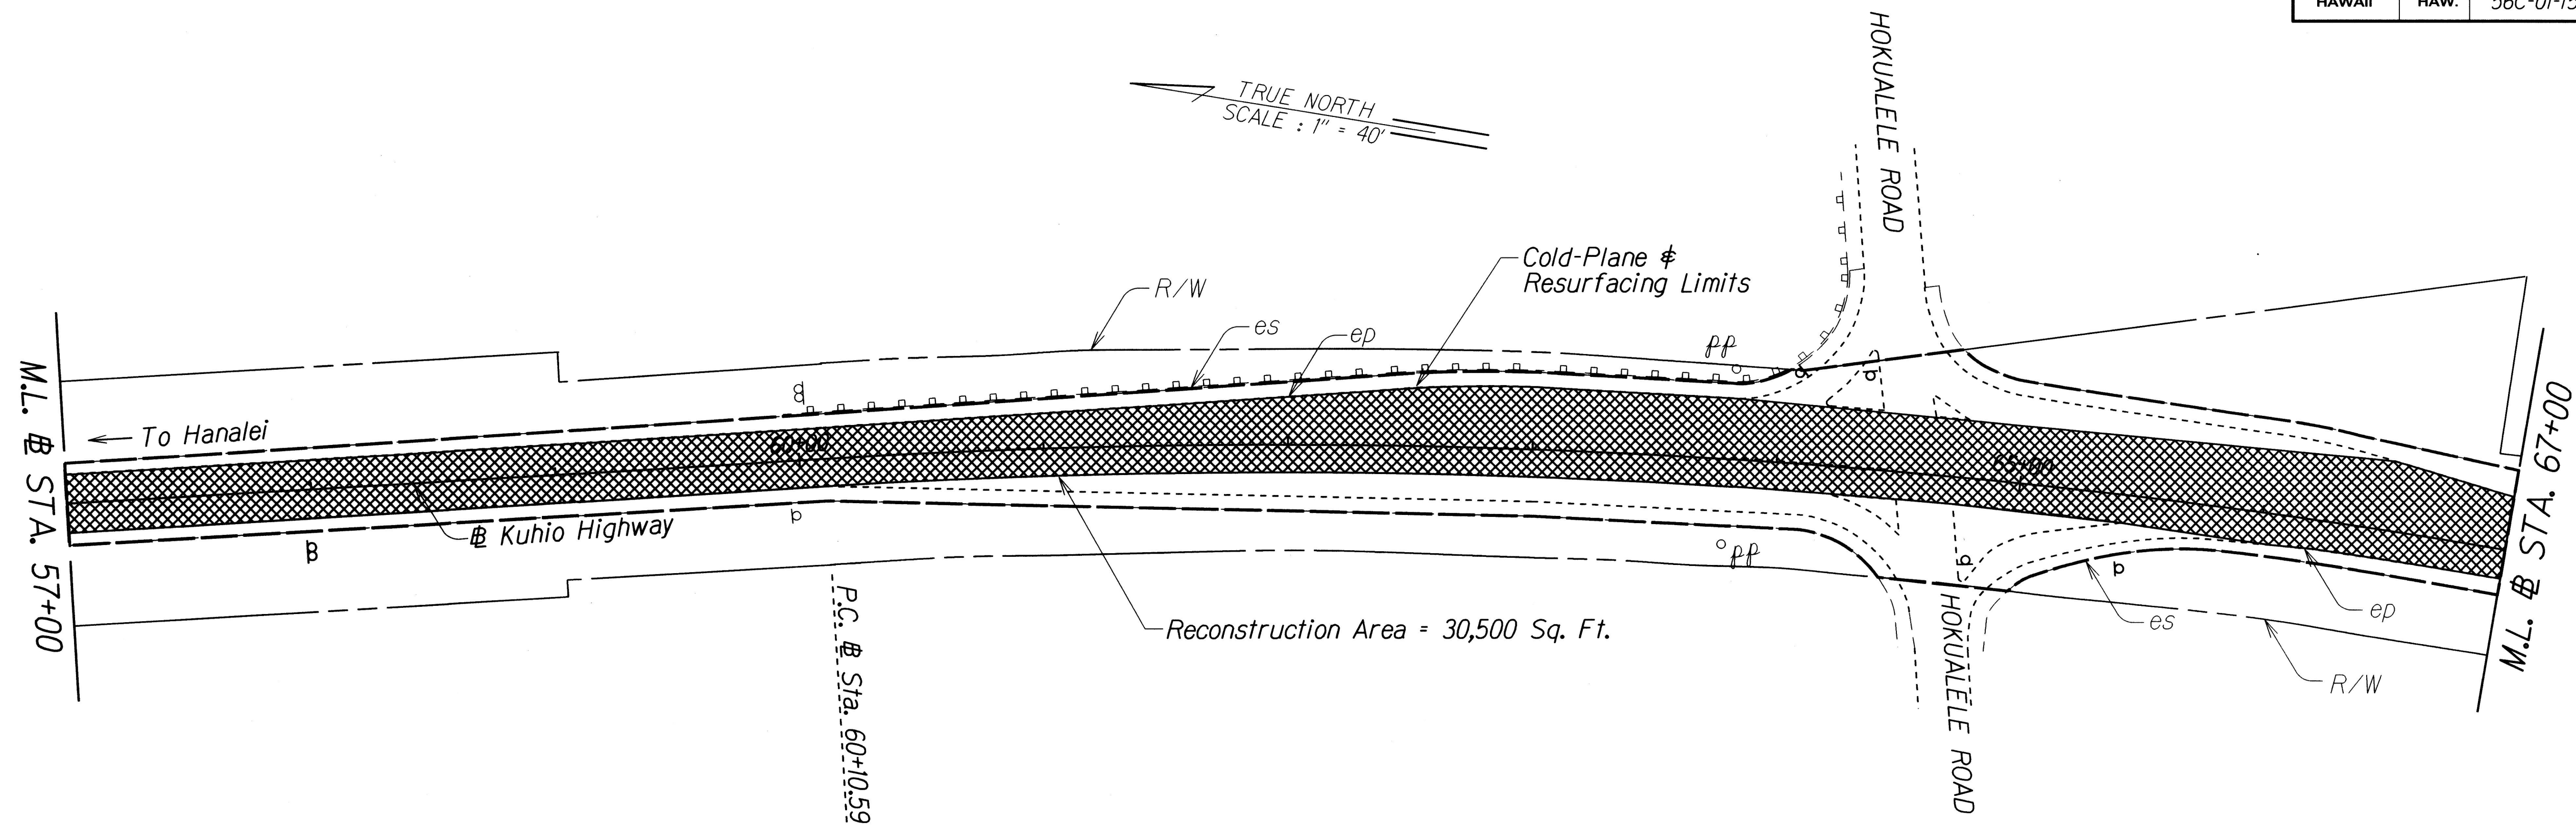


@ CURVE DATA
 $\Delta = 23^{\circ}35'00''$
 $R = 3,000.00'$
 $T = 626.68'$
 $C = 1,226.12'$
 $Lc = 1,234.82'$

ORIGINAL PLAN	SURVEY PLOTTED BY	DATE
NOTE BOOK	DESIGNED BY	
	QUANTITIES BY	
	CHECKED BY	

STATE OF HAWAII
 DEPARTMENT OF TRANSPORTATION
 HIGHWAYS DIVISION
ROADWAY PLAN
KUHIO HIGHWAY RESURFACING
Papaa Road to Aliomanu Road (South)
Project No. 56C-01-15M
 Scale: 1" = 40' Date: August 2016
 SHEET No. 3 OF 4 SHEETS

FED. ROAD DIST. NO.	STATE	PROJ. NO.	FISCAL YEAR	SHEET NO.	TOTAL SHEETS
HAWAII	HAW.	56C-01-15M	2017	13	21

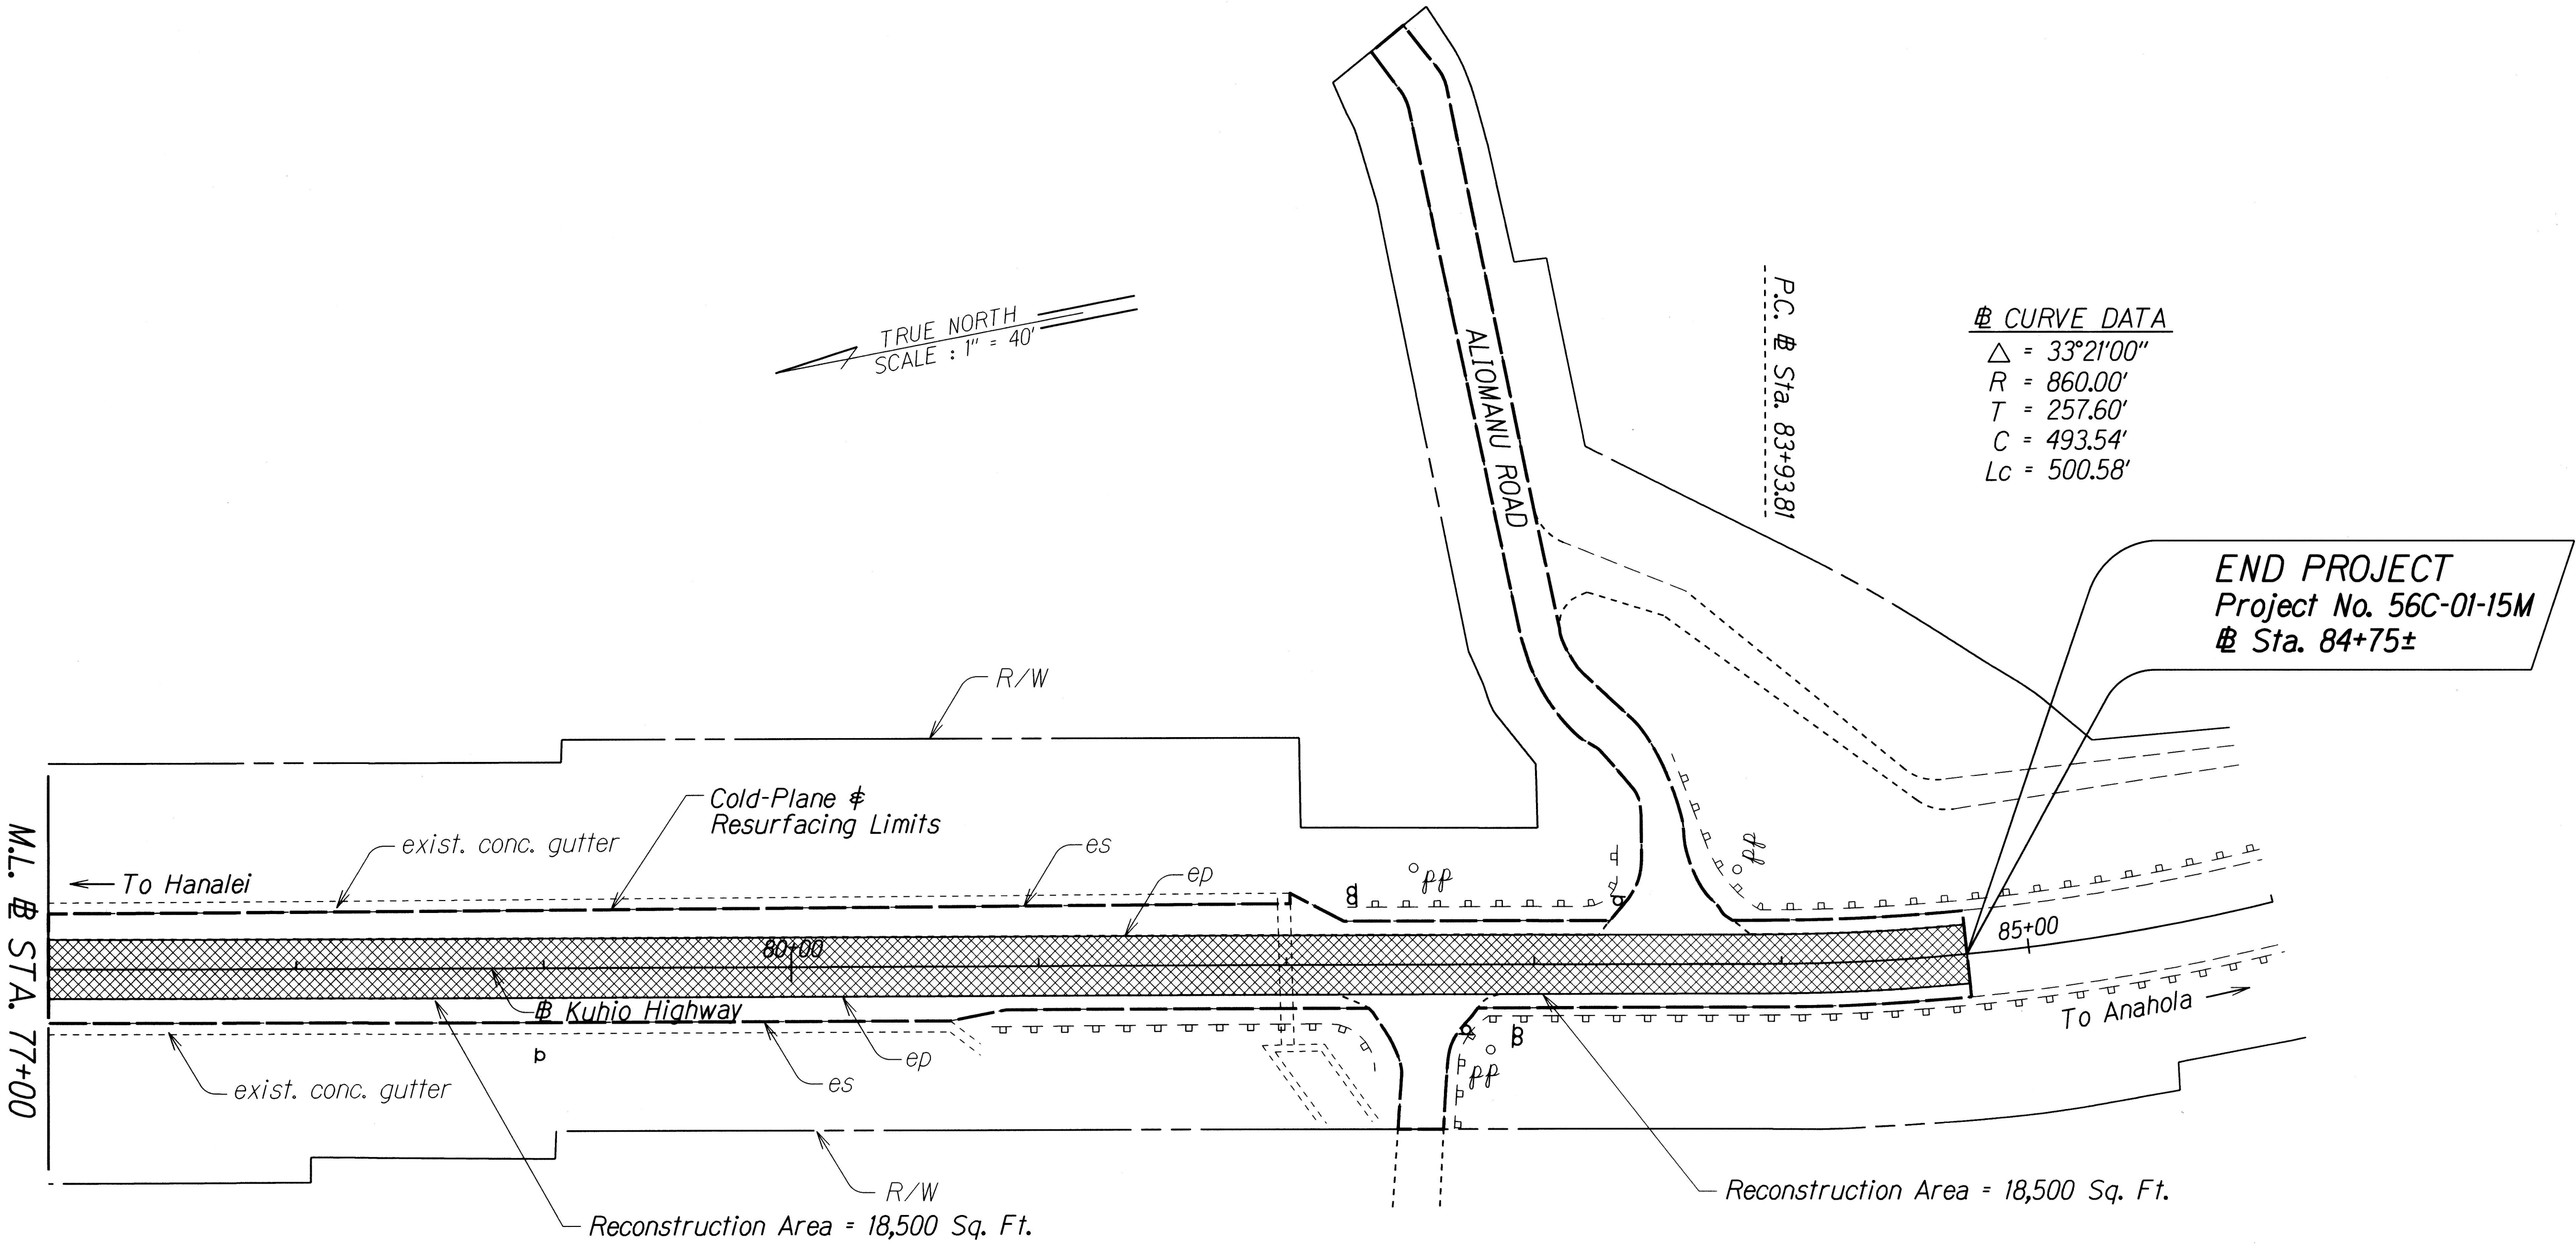

ORIGINAL PLAN	SURVEY PLOTTED BY	DATE
NOTE BOOK	DESIGNED BY	
QUANTITIES BY	CHECKED BY	
No.		

STATE OF HAWAII
DEPARTMENT OF TRANSPORTATION
HIGHWAYS DIVISION
ROADWAY PLAN
KUHIO HIGHWAY RESURFACING
Papaa Road to Aliomanu Road (South)
Project No. 56C-01-15M
Scale: 1" = 40' Date: August 2016
SHEET No. 4 OF 4 SHEETS