

| INDEX TO DRAWINGS |                                                                      |
|-------------------|----------------------------------------------------------------------|
| SHEET NO.         | DESCRIPTION                                                          |
| 1                 | TITLE SHEET                                                          |
| 2                 | STANDARD PLANS SUMMARY                                               |
| 3                 | GENERAL NOTES & LEGEND                                               |
| 4 - 6             | WATER POLLUTION AND EROSION CONTROL NOTES                            |
| 7 - 9             | TYPICAL SECTIONS                                                     |
| 10 - 13           | ROADWAY PLANS                                                        |
| 14                | PAVEMENT MARKING, NOTES, LEGEND, AND SIGN DETAILS                    |
| 15                | CENTERLINE MILLED RUMBLE STRIP DETAIL                                |
| 16 - 19           | PAVEMENT MARKING AND TRAFFIC SIGNING PLAN                            |
| 20                | SIGN DETAILS                                                         |
| 21                | HIGH SPEED UNDIVIDED HIGHWAY WORK ZONE SIGNING PLAN, NOTES & DETAILS |

STATE OF HAWAII

DEPARTMENT OF TRANSPORTATION

HIGHWAYS DIVISION

HONOLULU, HAWAII

"AS-BUILT"

PLANS FOR

KUHIO HIGHWAY RESURFACING



PAPAA ROAD TO ALIOMANU ROAD (SOUTH)

PROJECT NO. 56C-01-15M

DISTRICT OF KAWAIIHAW

ISLAND OF KAUAI

| FED. ROAD DIST. NO. | STATE | PROJ. NO.  | FISCAL YEAR | SHEET NO. | TOTAL SHEETS |
|---------------------|-------|------------|-------------|-----------|--------------|
| HAWAII              | HAW.  | 56C-01-15M | 2017        | 1         | 21           |

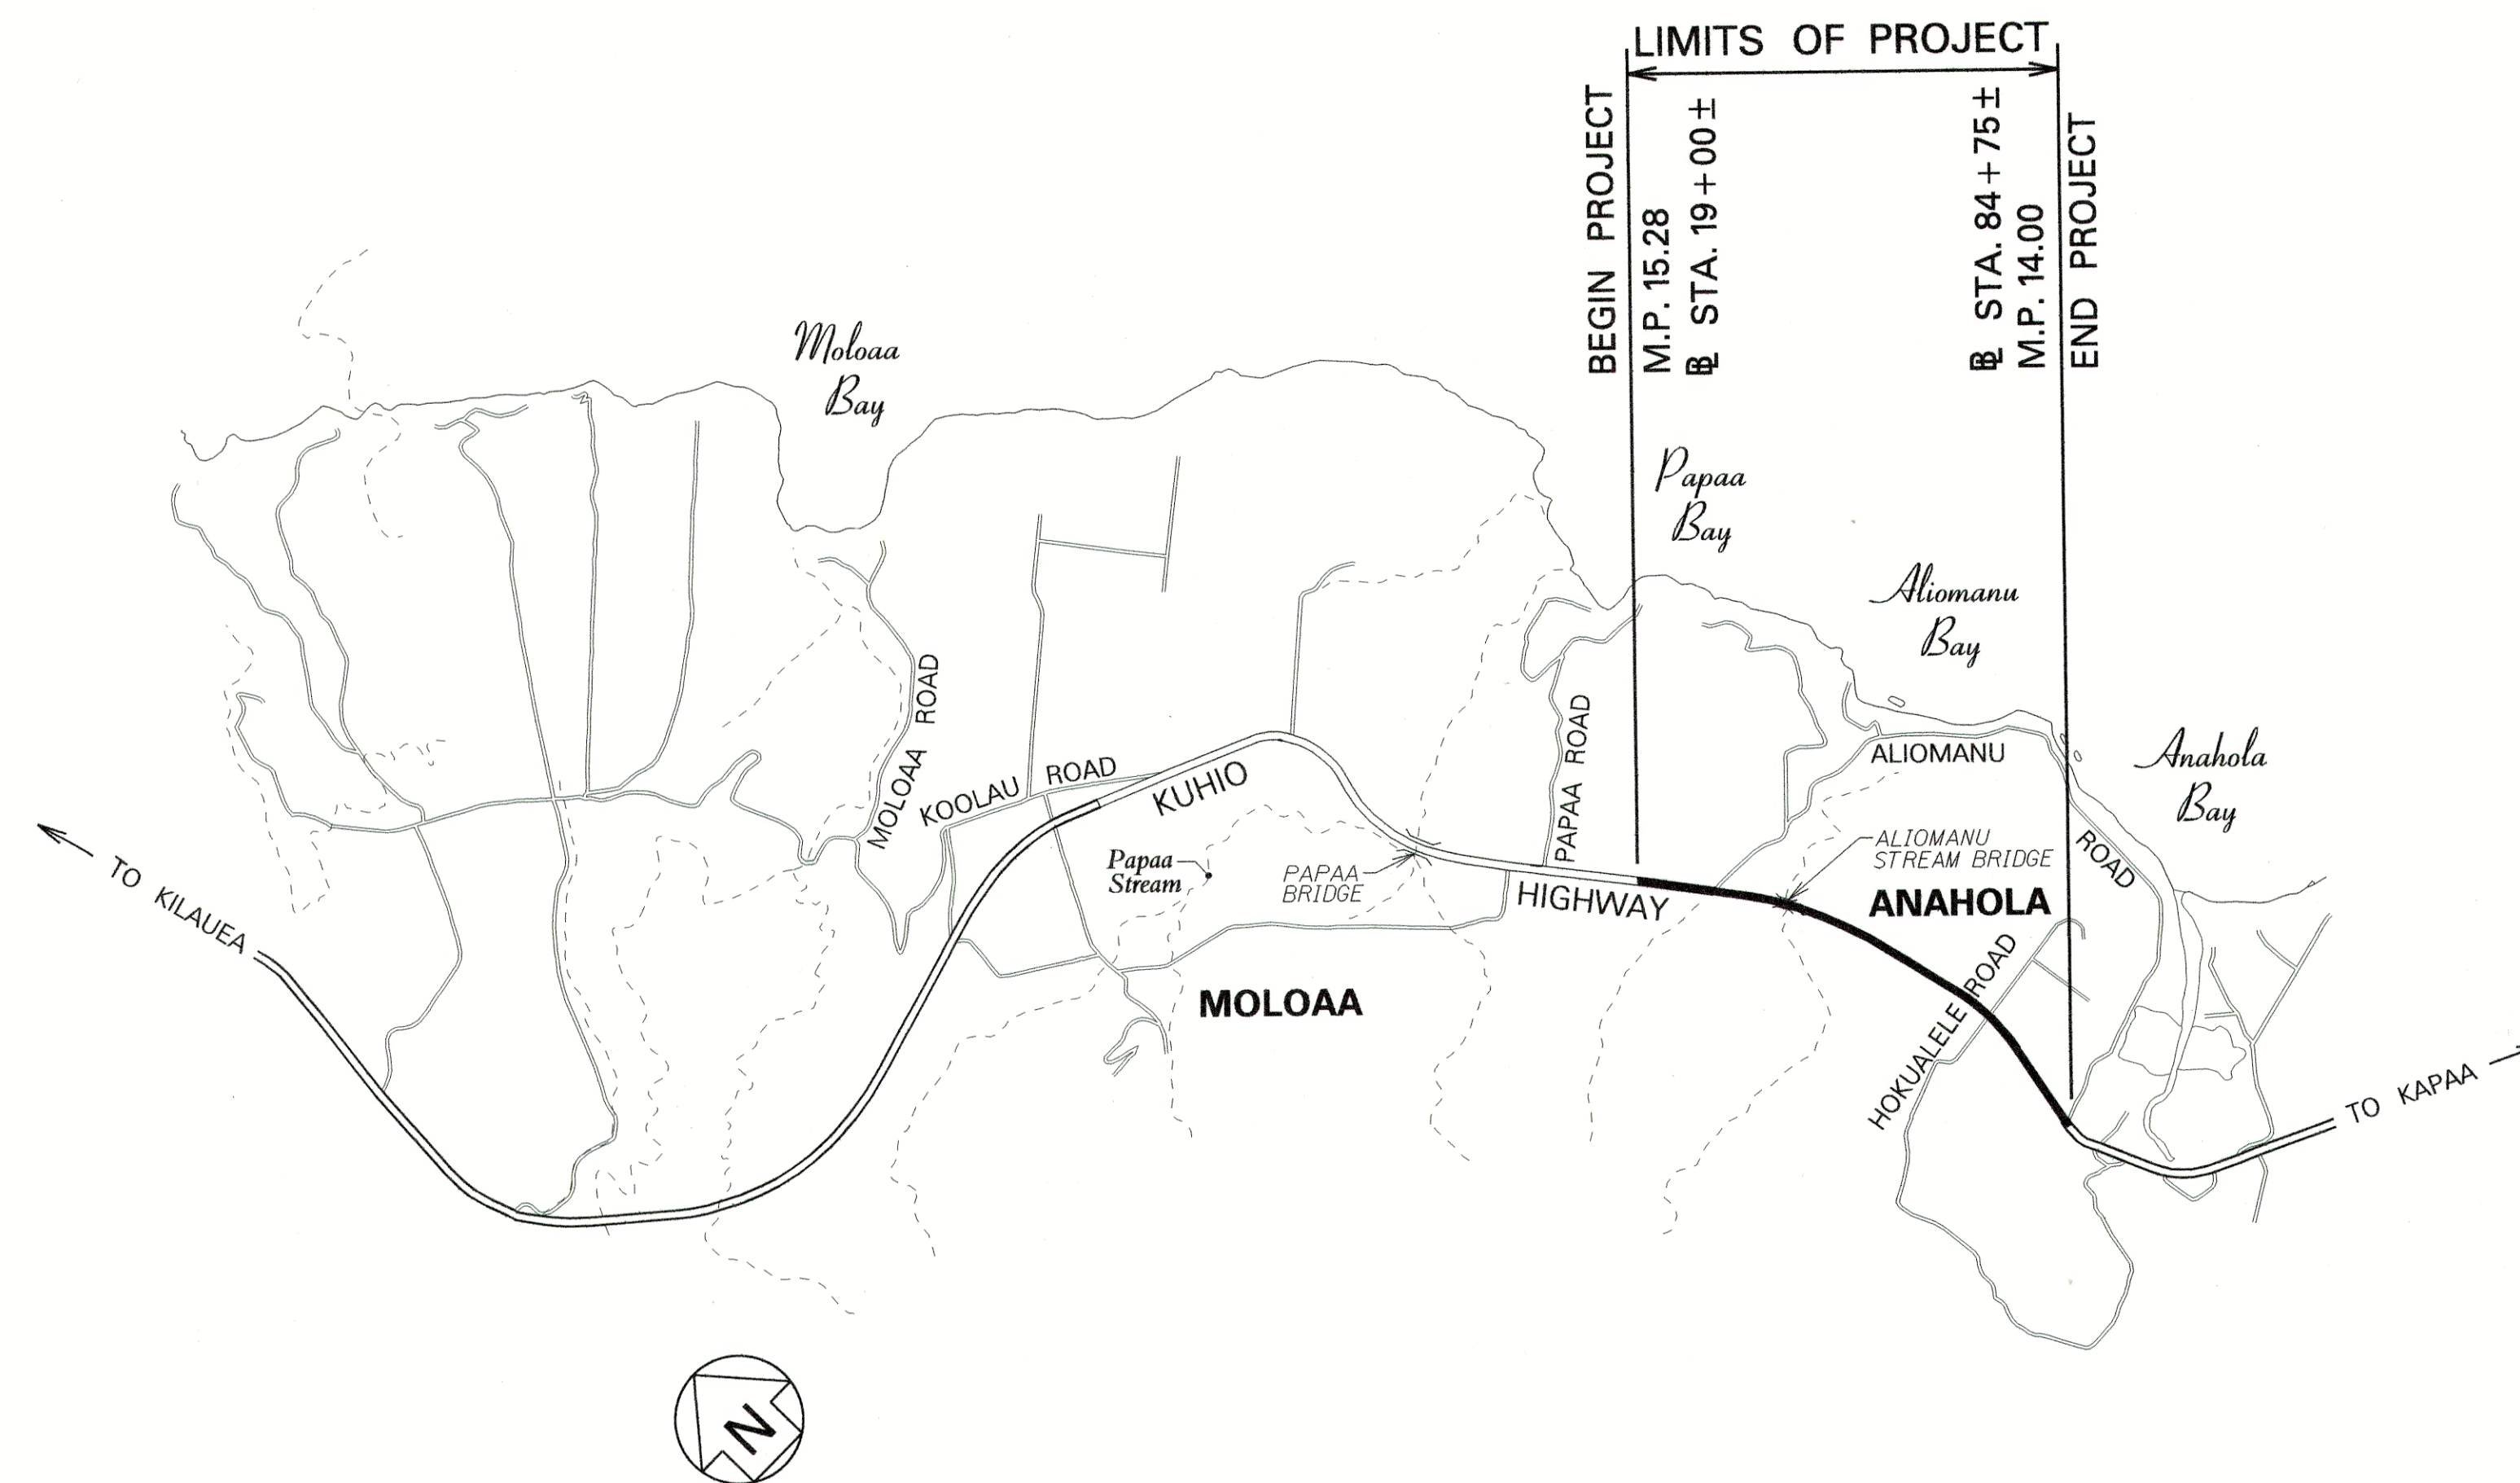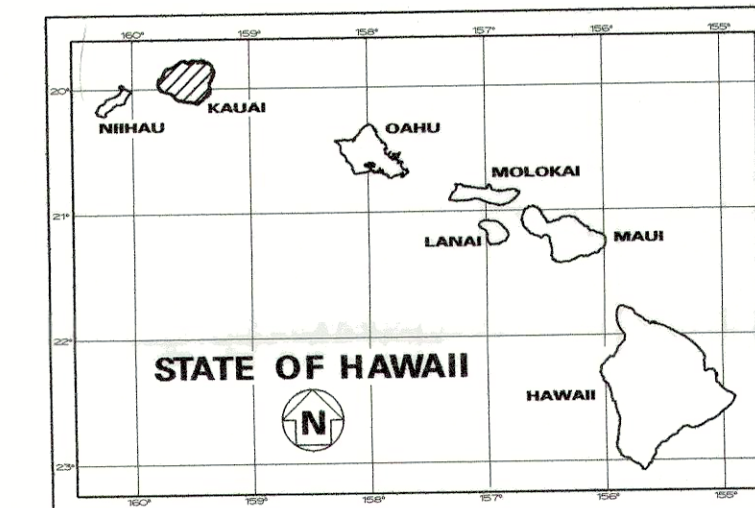

FEDERAL AID PROJECTS PREVIOUSLY CONSTRUCTED OR UNDER CONSTRUCTION

MILE POST 14.00 TO MILE POST 15.28

CHANGES MADE DURING CONSTRUCTION HAVE BEEN INCORPORATED ON THESE PLANS EXCEPT CHANGES IN THE ORIGINAL THEORETICAL QUANTITIES. FOR ACTUAL QUANTITIES, REFER TO PROJECT LEDGER AND/OR COMPUTATION BOOK.

RESIDENT ENGINEER 12/6/23 DATE

|                                                 |
|-------------------------------------------------|
| DEPARTMENT OF TRANSPORTATION<br>STATE OF HAWAII |
| APPROVED:                                       |
| DIR. OF TRANSPORTATION                          |
| DATE                                            |

DESIGNED BY  
HWY-K  
MANAGED BY  
HWY-KE  
PHONE 241-3000  
DATE DEC. 2016

LAYOUT PLAN

GROSS LENGTH OF PROJECT.....1.28 MILE  
NET LENGTH OF PROJECT.....1.28 MILE

