


TYPICAL SPEED HUMP DETAIL
Not to Scale


LEGEND FOR AS-BUILT POSTINGS

	Squiggly line for as-built deletion
	Double line for as-built deletion
Roadway	Text for as-built posting

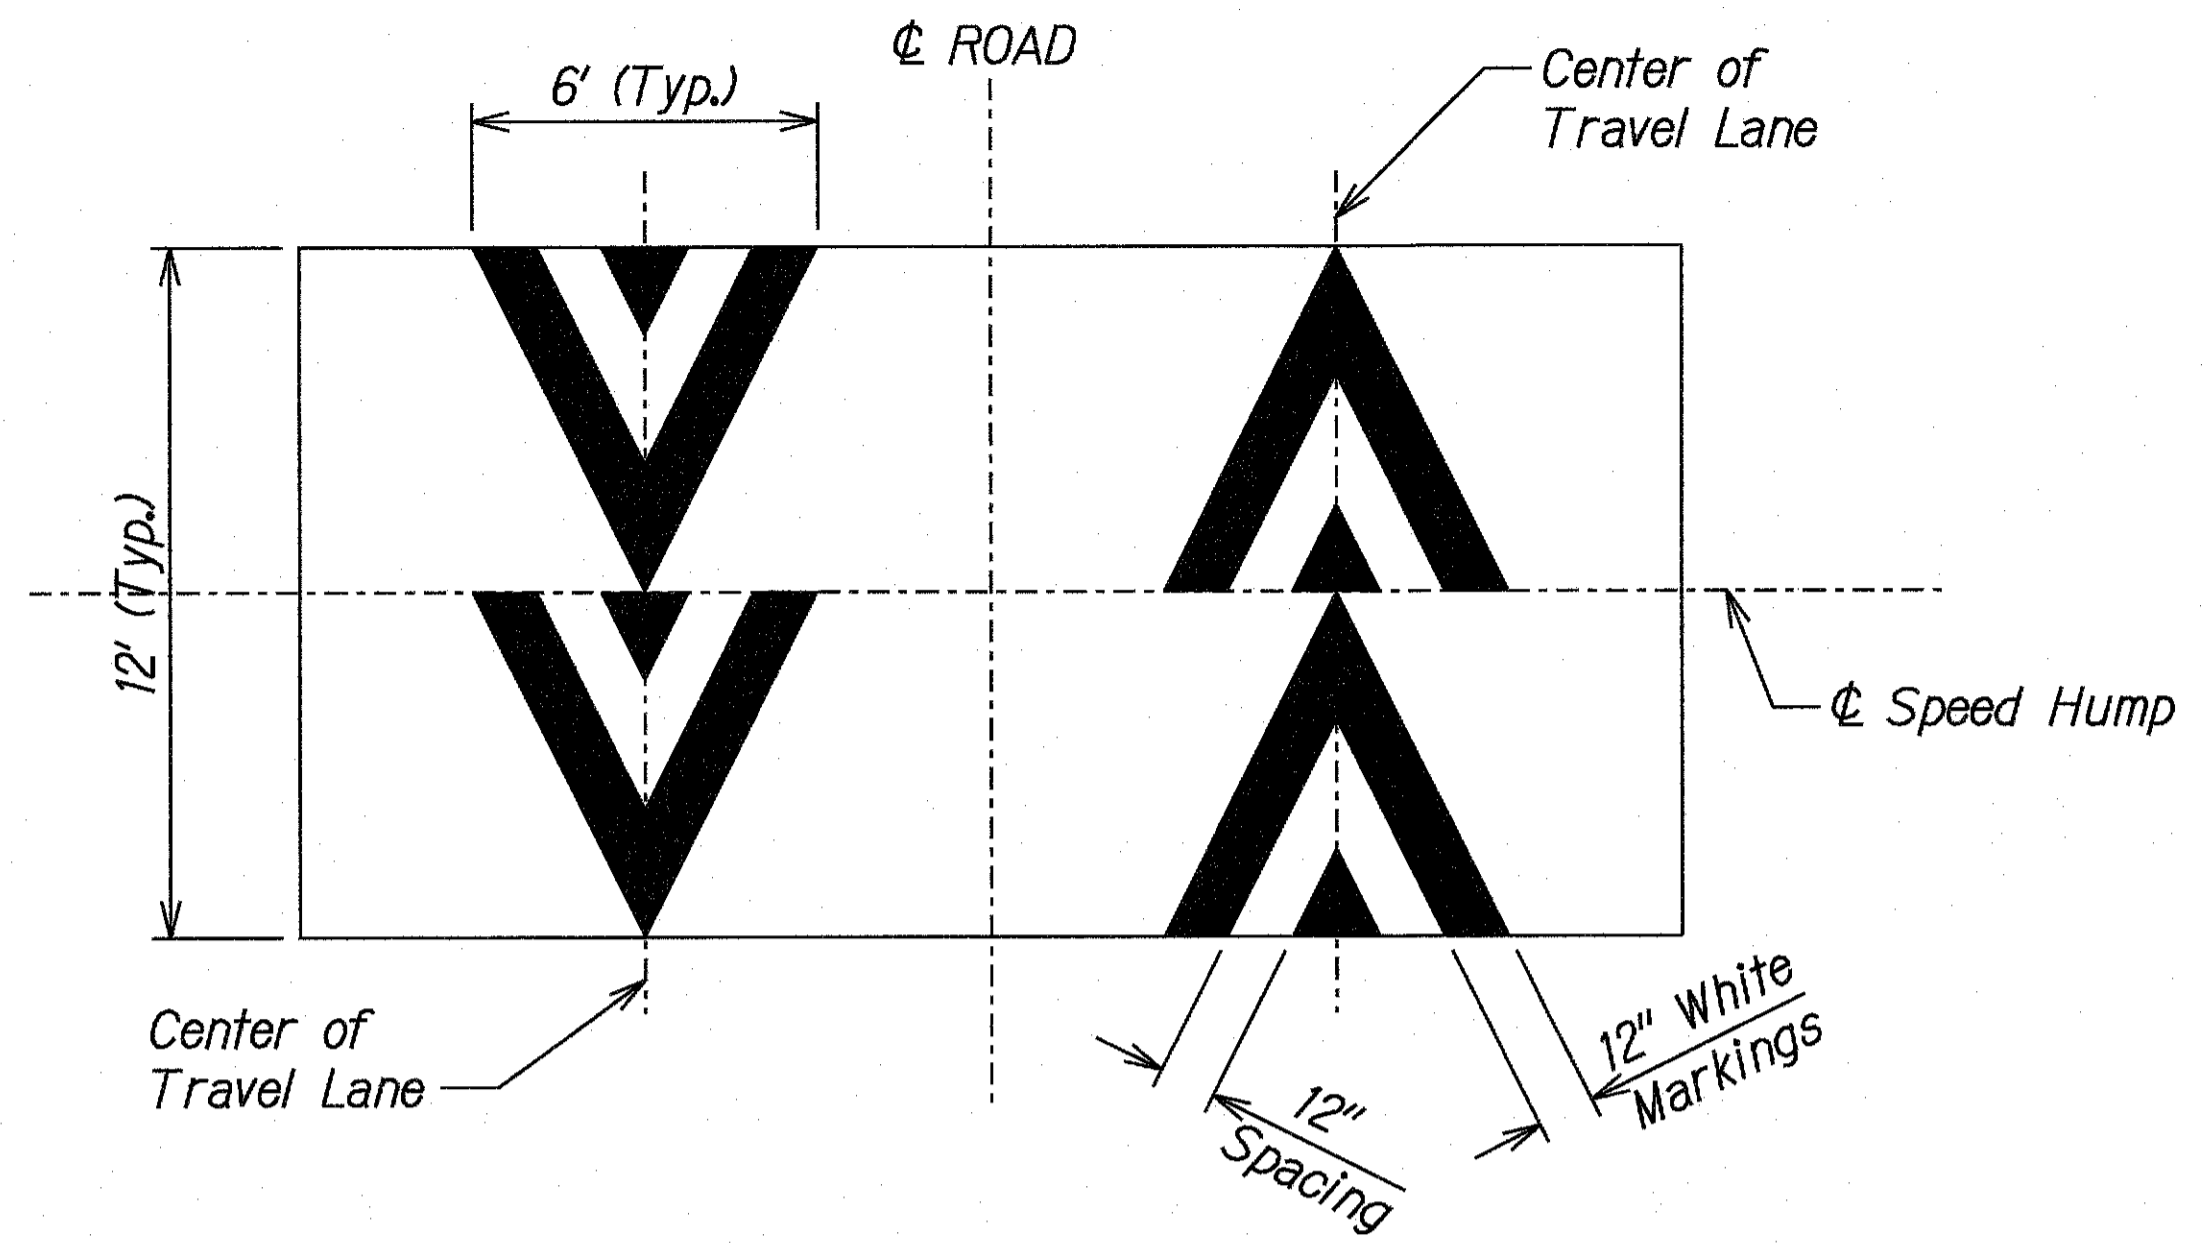

Typical Speed Hump Pavement Marking Detail

* See Bridge Pavement Marking Plans for Placement and Spacing Otherwise Use Dimensions as Shown in Typical Detail.

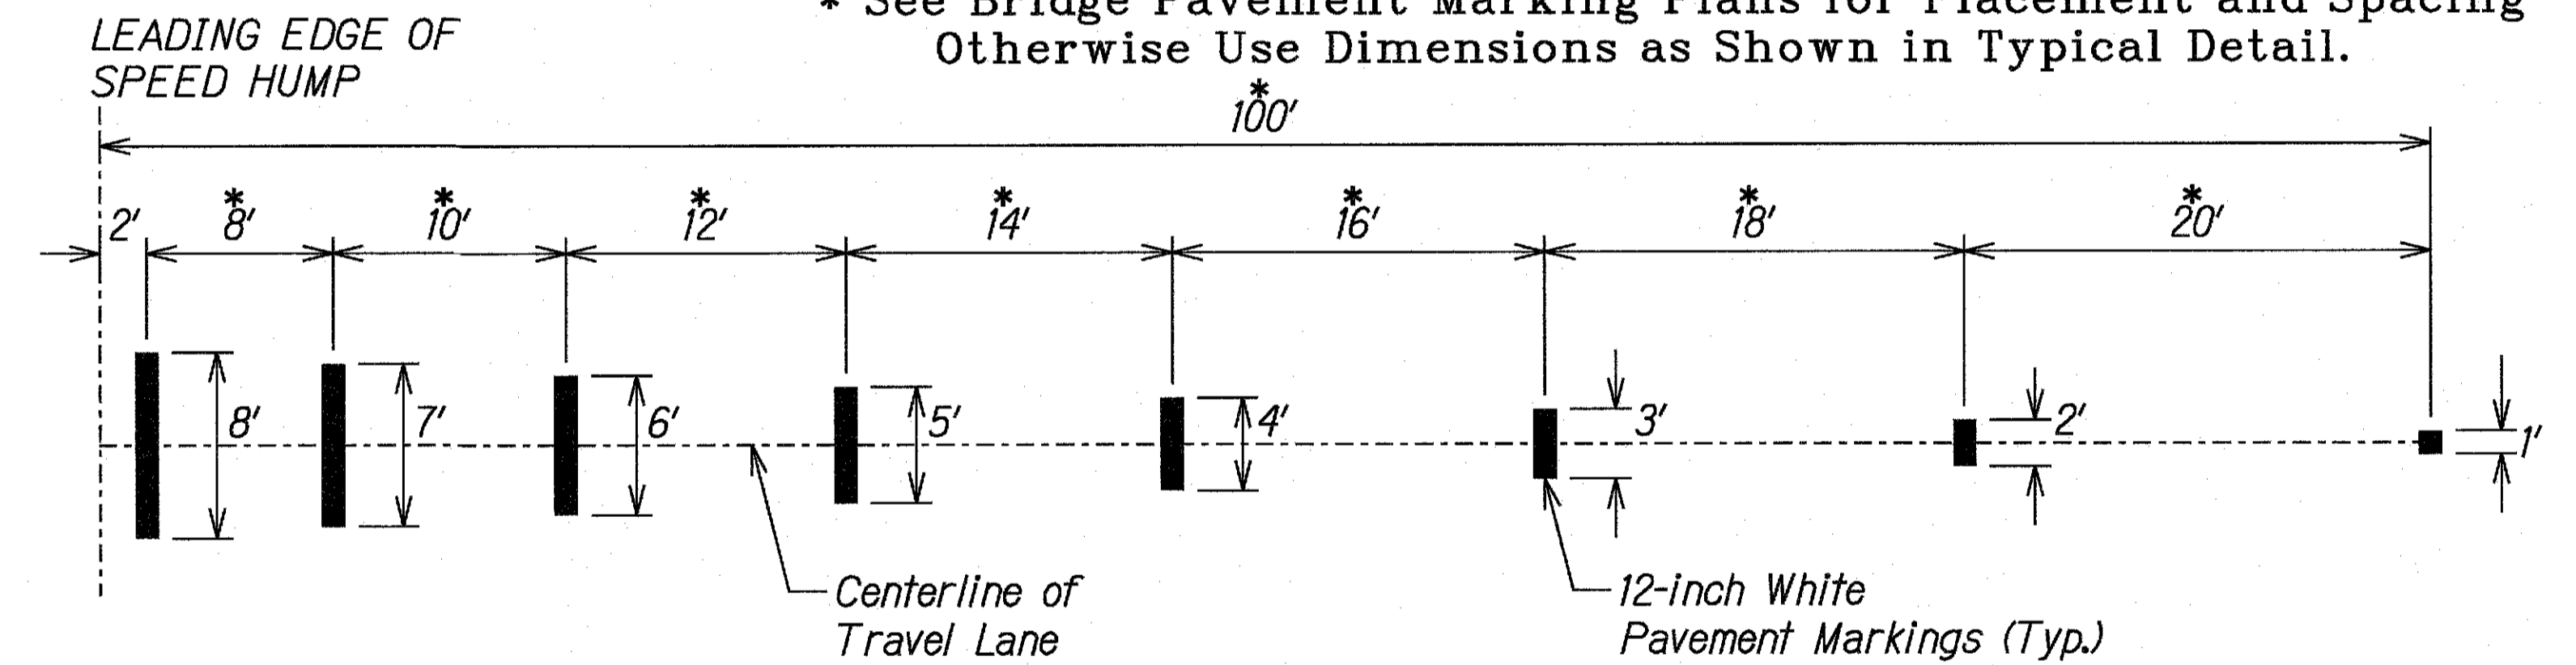

Typical Advance Speed Hump Pavement Marking Detail

(Where Shown on Pavement Marking Plan)

TYPICAL PAVEMENT MARKINGS FOR SPEED HUMPS
Not to Scale

DATE	
SURVEY PLOTTED BY	
DRAWN BY	
DESIGNED BY	
QUANTITIES BY	
CHECKED BY	
ORIGINAL PLAN	
NOTE BOOK	
No.	

T:\16533A-Emergency\FloodRepair\CADD\Sheets\SpeedHump.dgn

8/19/19	Speed Hump Revisions
Date	Revision

STATE OF HAWAII
DEPARTMENT OF TRANSPORTATION
HIGHWAYS DIVISION

SPEED HUMP DETAILS AND MARKINGS

KAUAI EMERGENCY FLOOD REPAIRS & CLEANUP
At Various Locations April 2018, Rte. 560
Fed. Aid Proj. No. ER-19(007)

Scale: Not to Scale Date: Oct. 2018

SHEET No. SS-2 OF 3 SHEETS

"AS-BUILT"