


**BRIDGE STRIPING SECTION**  
Scale: 1"=5'

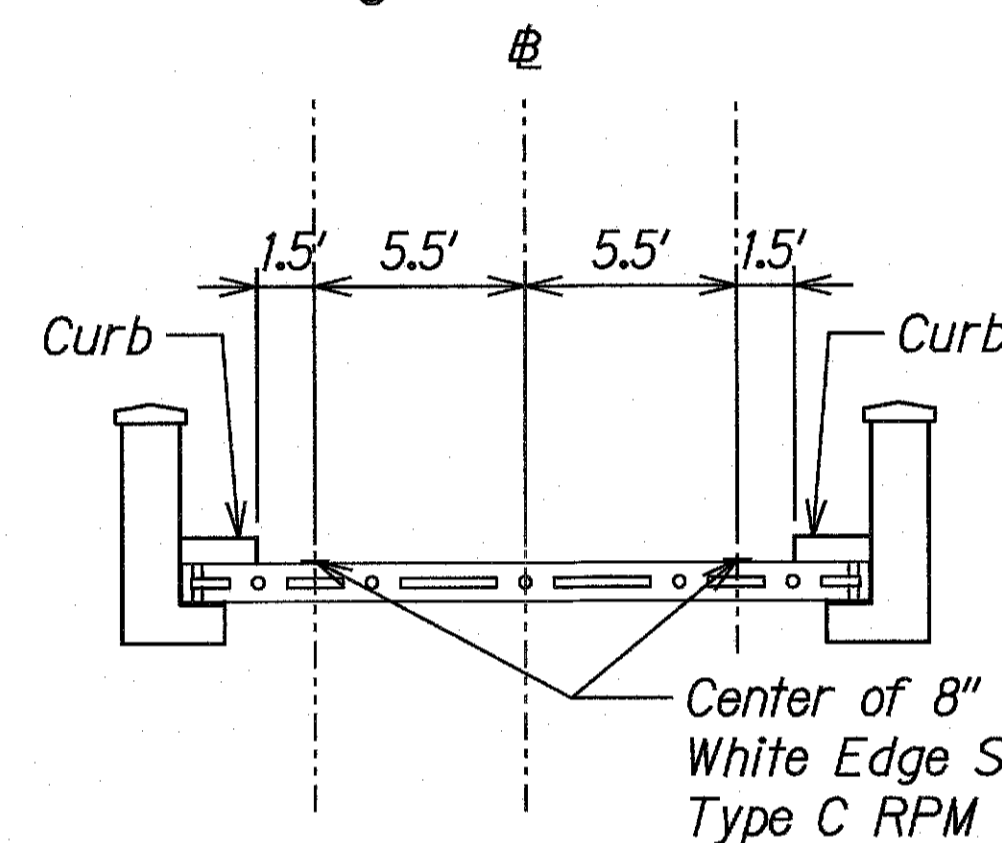

| LEGEND FOR AS-BUILT POSTINGS |                                     |
|------------------------------|-------------------------------------|
|                              | Squiggly line for as-built deletion |
|                              | Double line for as-built deletion   |
| Roadway                      | Text for as-built posting           |

**NOTES:**  
1. See Structural Plans for bridge drain hole locations.

| Date     | Revision                                |
|----------|-----------------------------------------|
| 10/15/19 | △ Reflector Markers Added               |
| 9/20/19  | △ Bridge Striping Revisions, Added Note |
| 8/19/19  | △ Speed Hump Revisions                  |

STATE OF HAWAII  
DEPARTMENT OF TRANSPORTATION  
HIGHWAYS DIVISION

**SIGNING AND PAVEMENT MARKING PLAN - WAIKOKO**

KAUAI EMERGENCY FLOOD REPAIRS & CLEANUP  
At Various Locations April 2018, Rte. 560  
Fed. Aid Proj. No. ER-19(007)

Scale: 1"=20' Date: Oct. 2018

SHEET No. SS-3 OF 3 SHEETS

"AS-BUILT"