



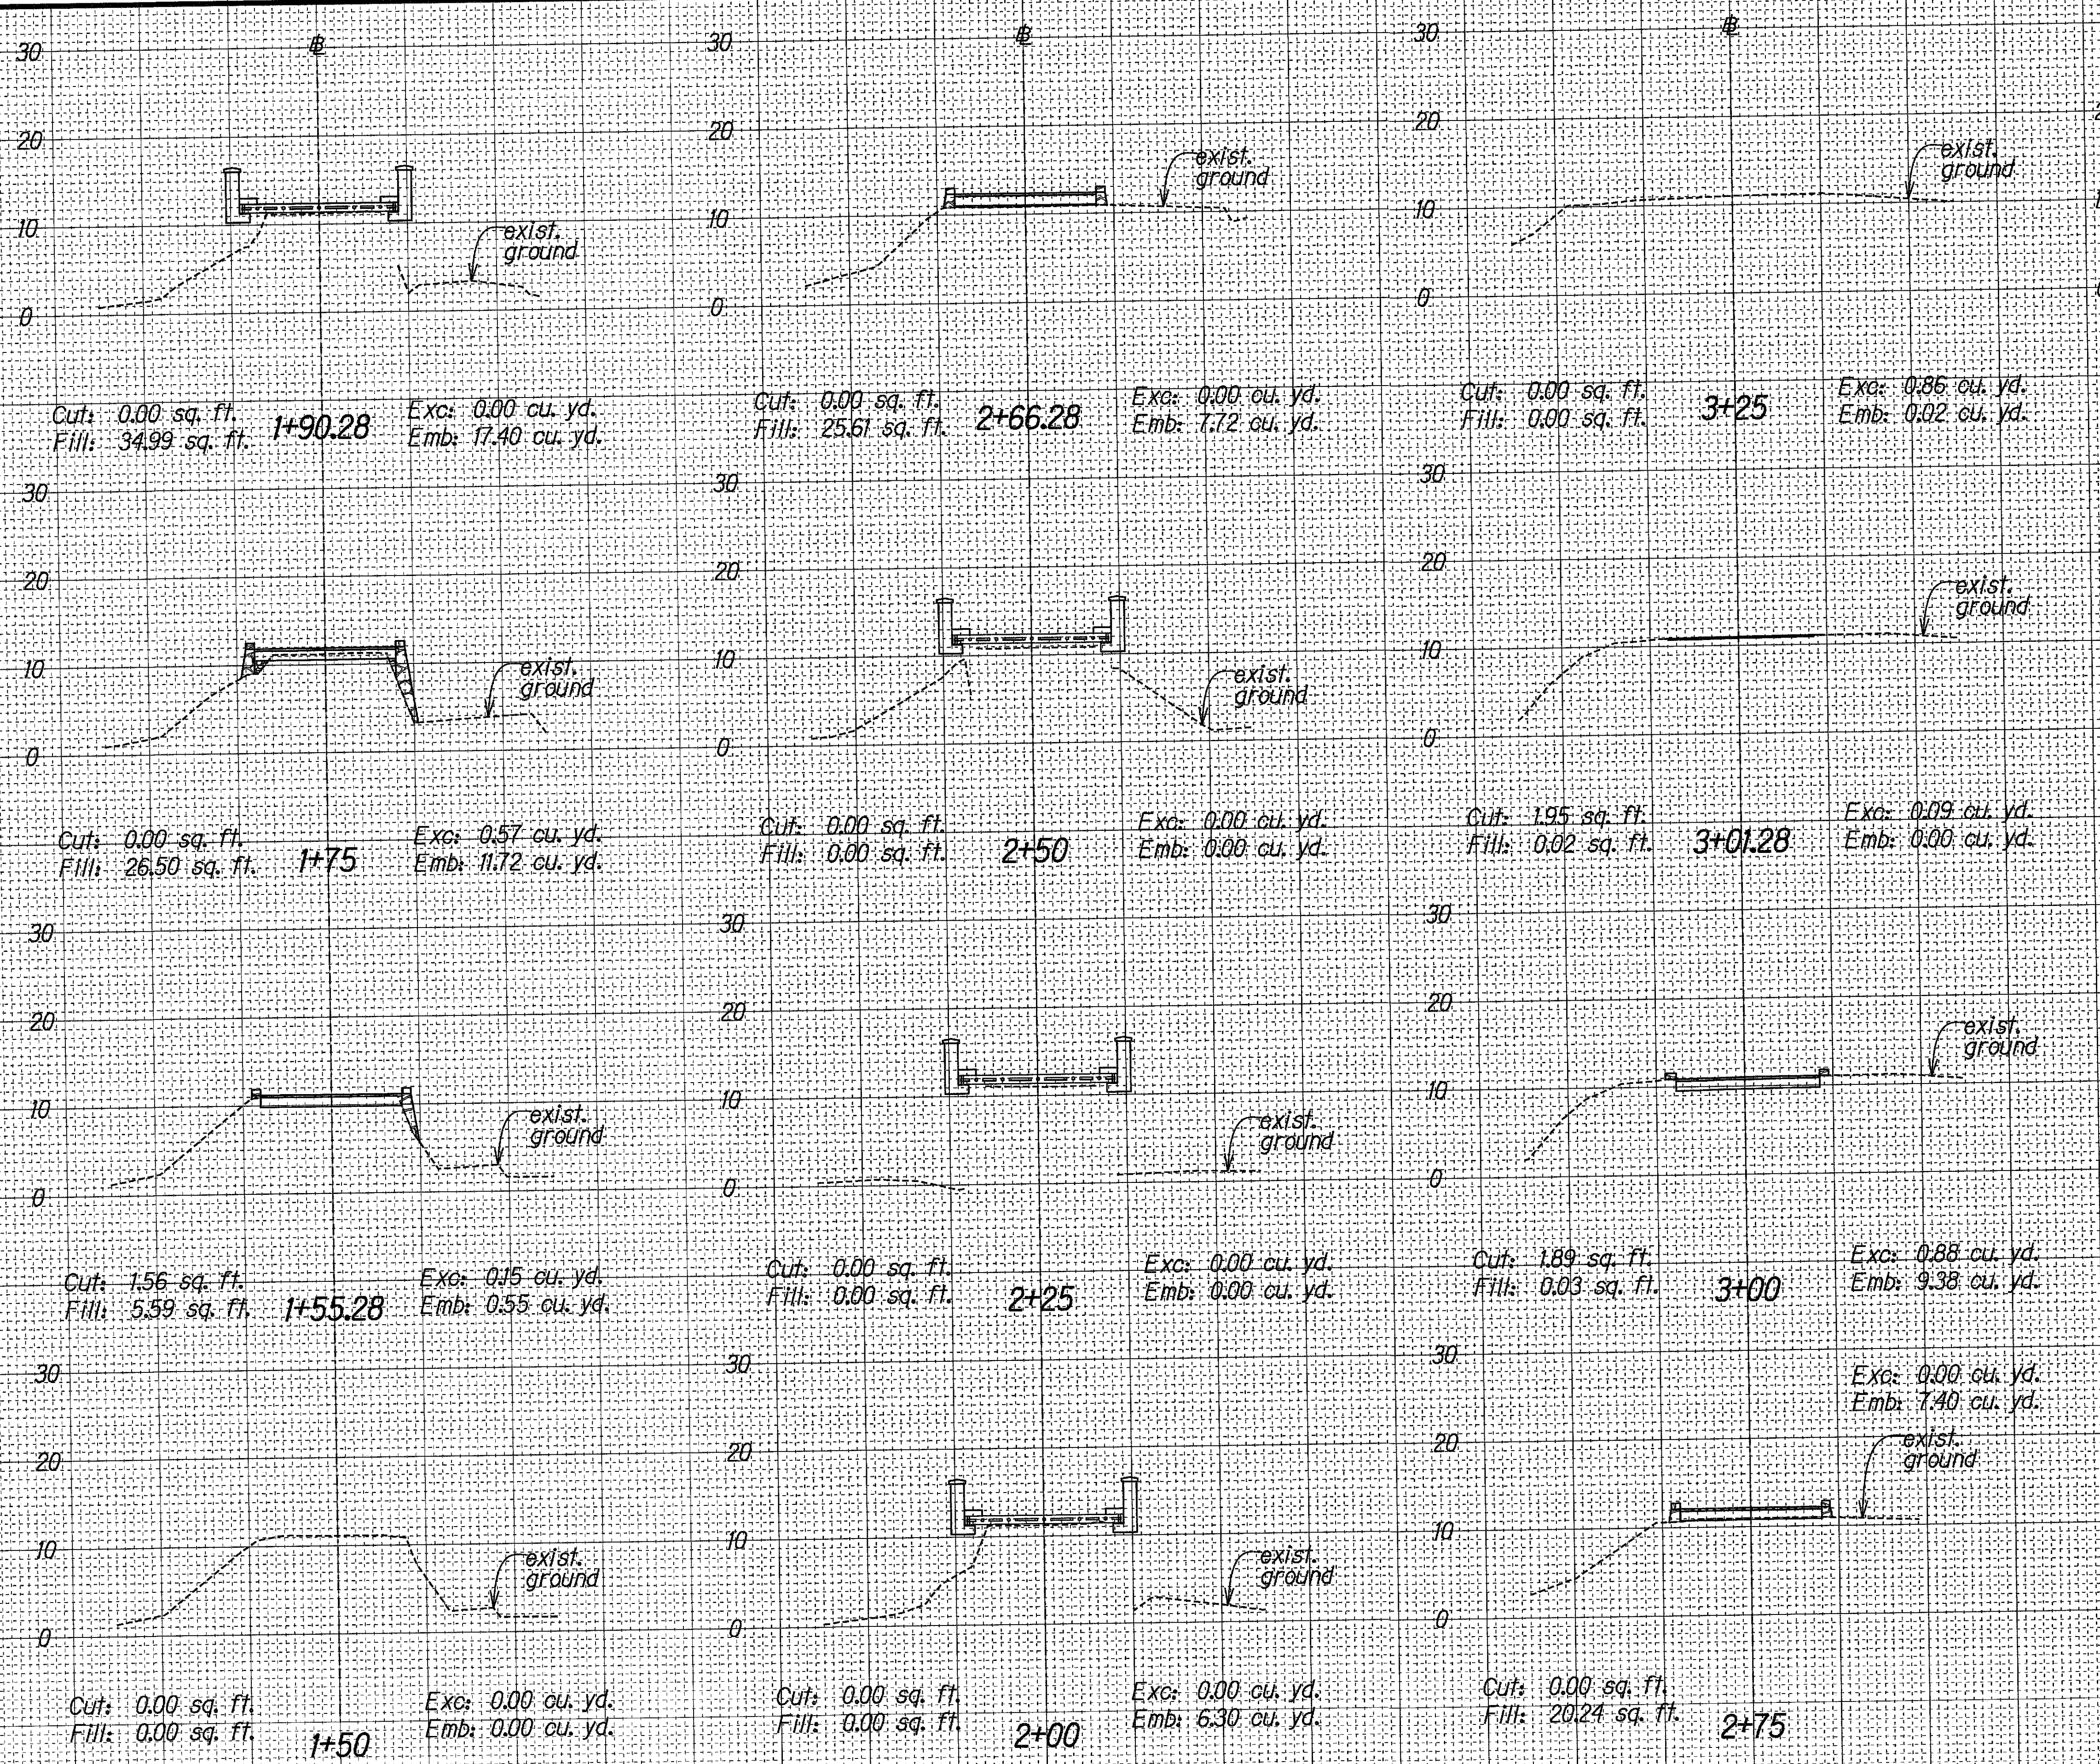

SUMMARY OF QUANTITIES	
	VOLUME
EXCAVATION	2.55 cu. yd.
EMBANKMENT	60.49 cu. yd.

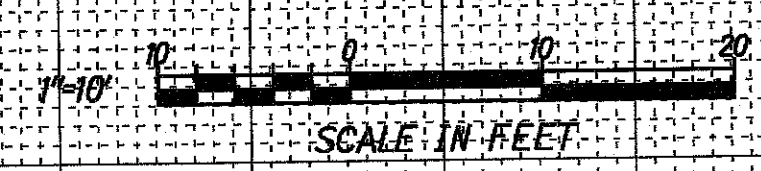

WAIKOKO STREAM BRIDGE CROSS SECTIONS

DATE _____
 SURVEY PLOTTED BY _____
 DRAWN BY _____
 CHECKED BY _____
 NOTE BOOK _____
 QUANTITIES BY _____
 CHECKED BY _____

T-16533A-Emergency Flood Repair/CADD/Sheet/WaikokoXS