



FED. ROAD DIST. NO.	STATE	FEDERAL AID PROJ. NO.	FISCAL YEAR	SHEET NO.	TOTAL SHEETS
HAWAII	HAW.	ER-19(007)	2018	11	51

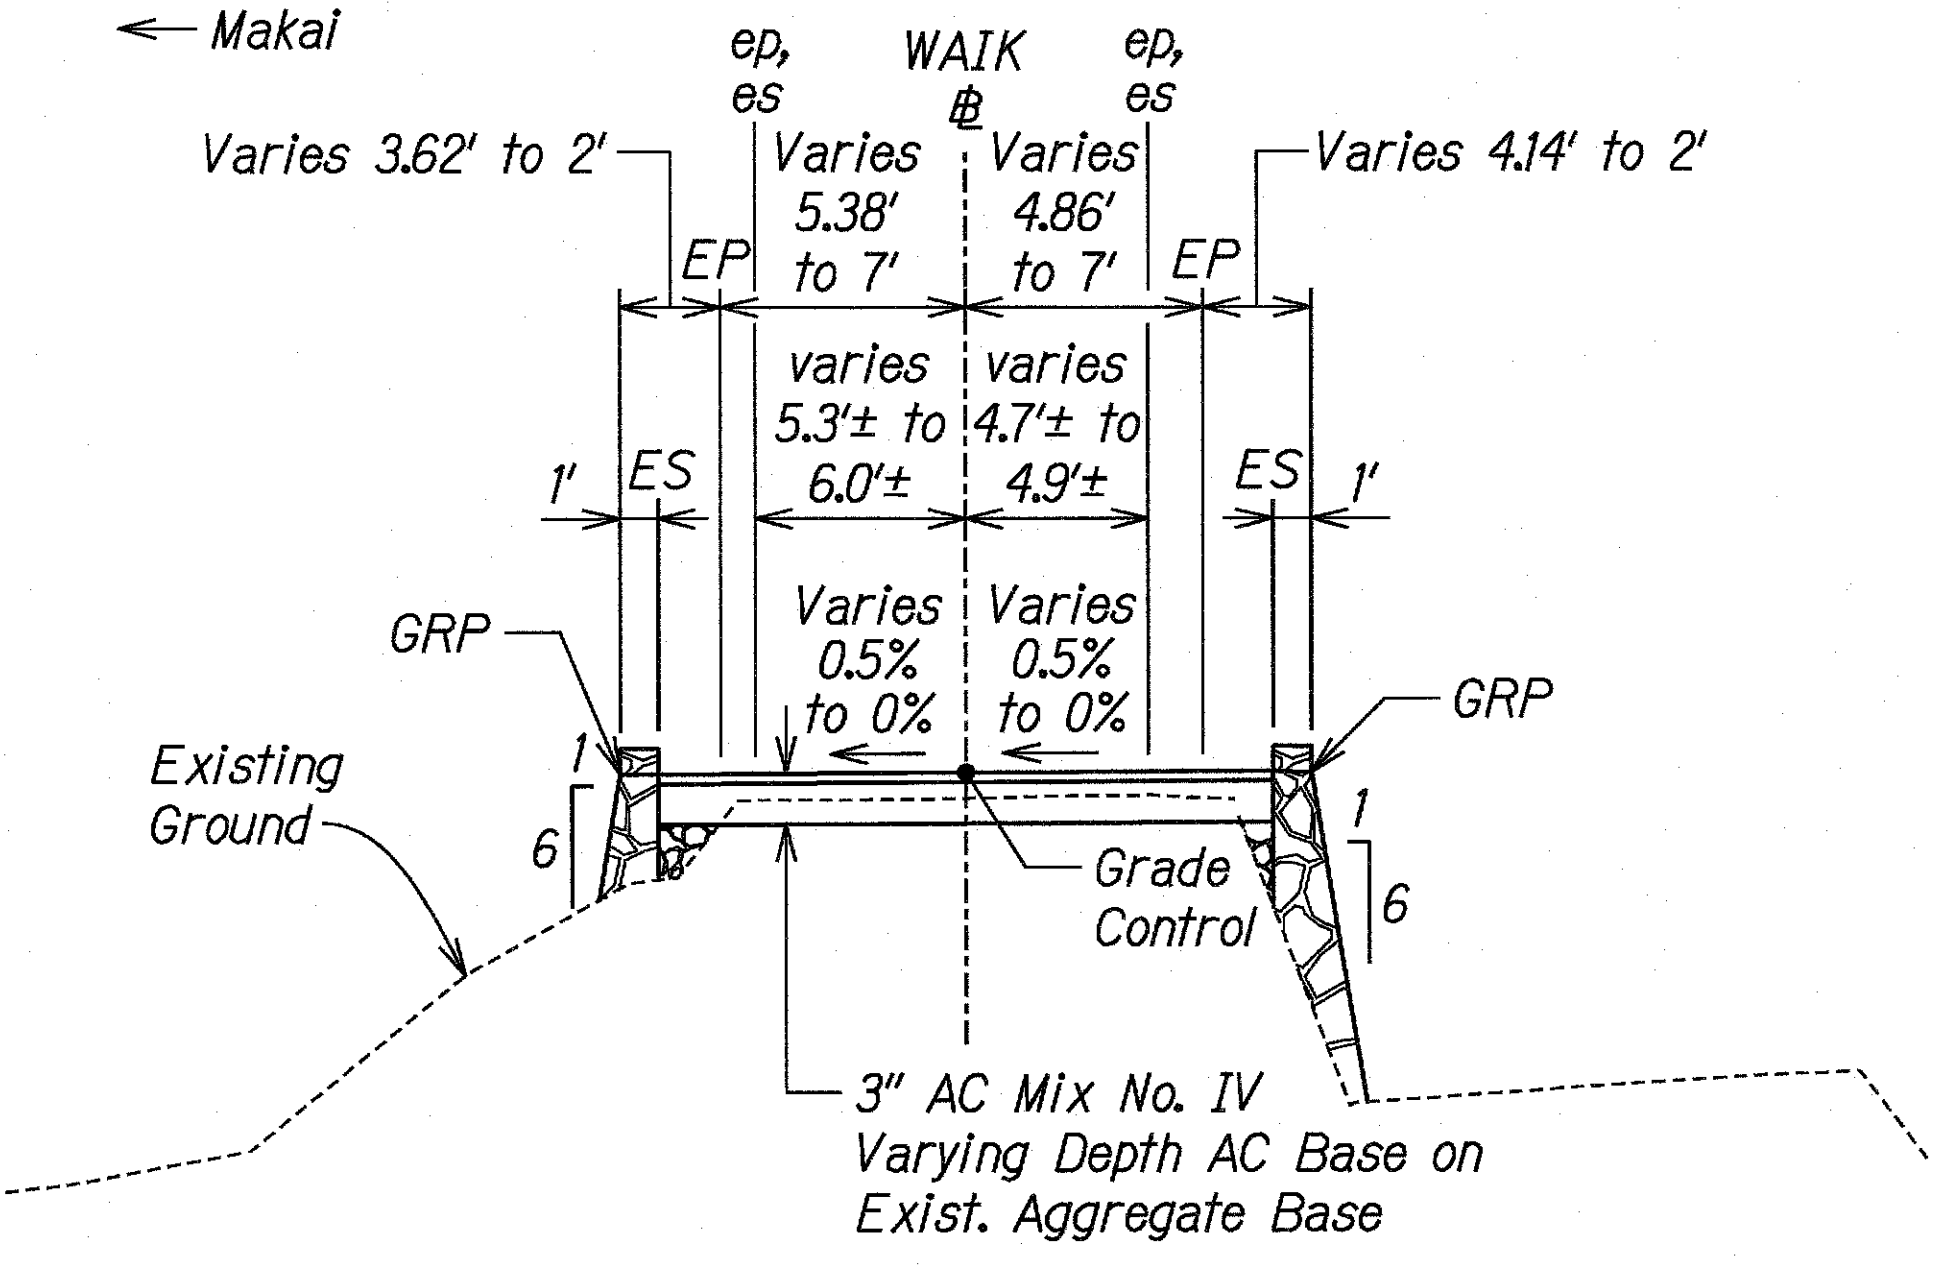


TYPICAL SECTION
KUHIO HWY (AT WEST APPROACH)
STA. 1+55.28 TO STA. 1+90.28
 Scale: 1" = 5'

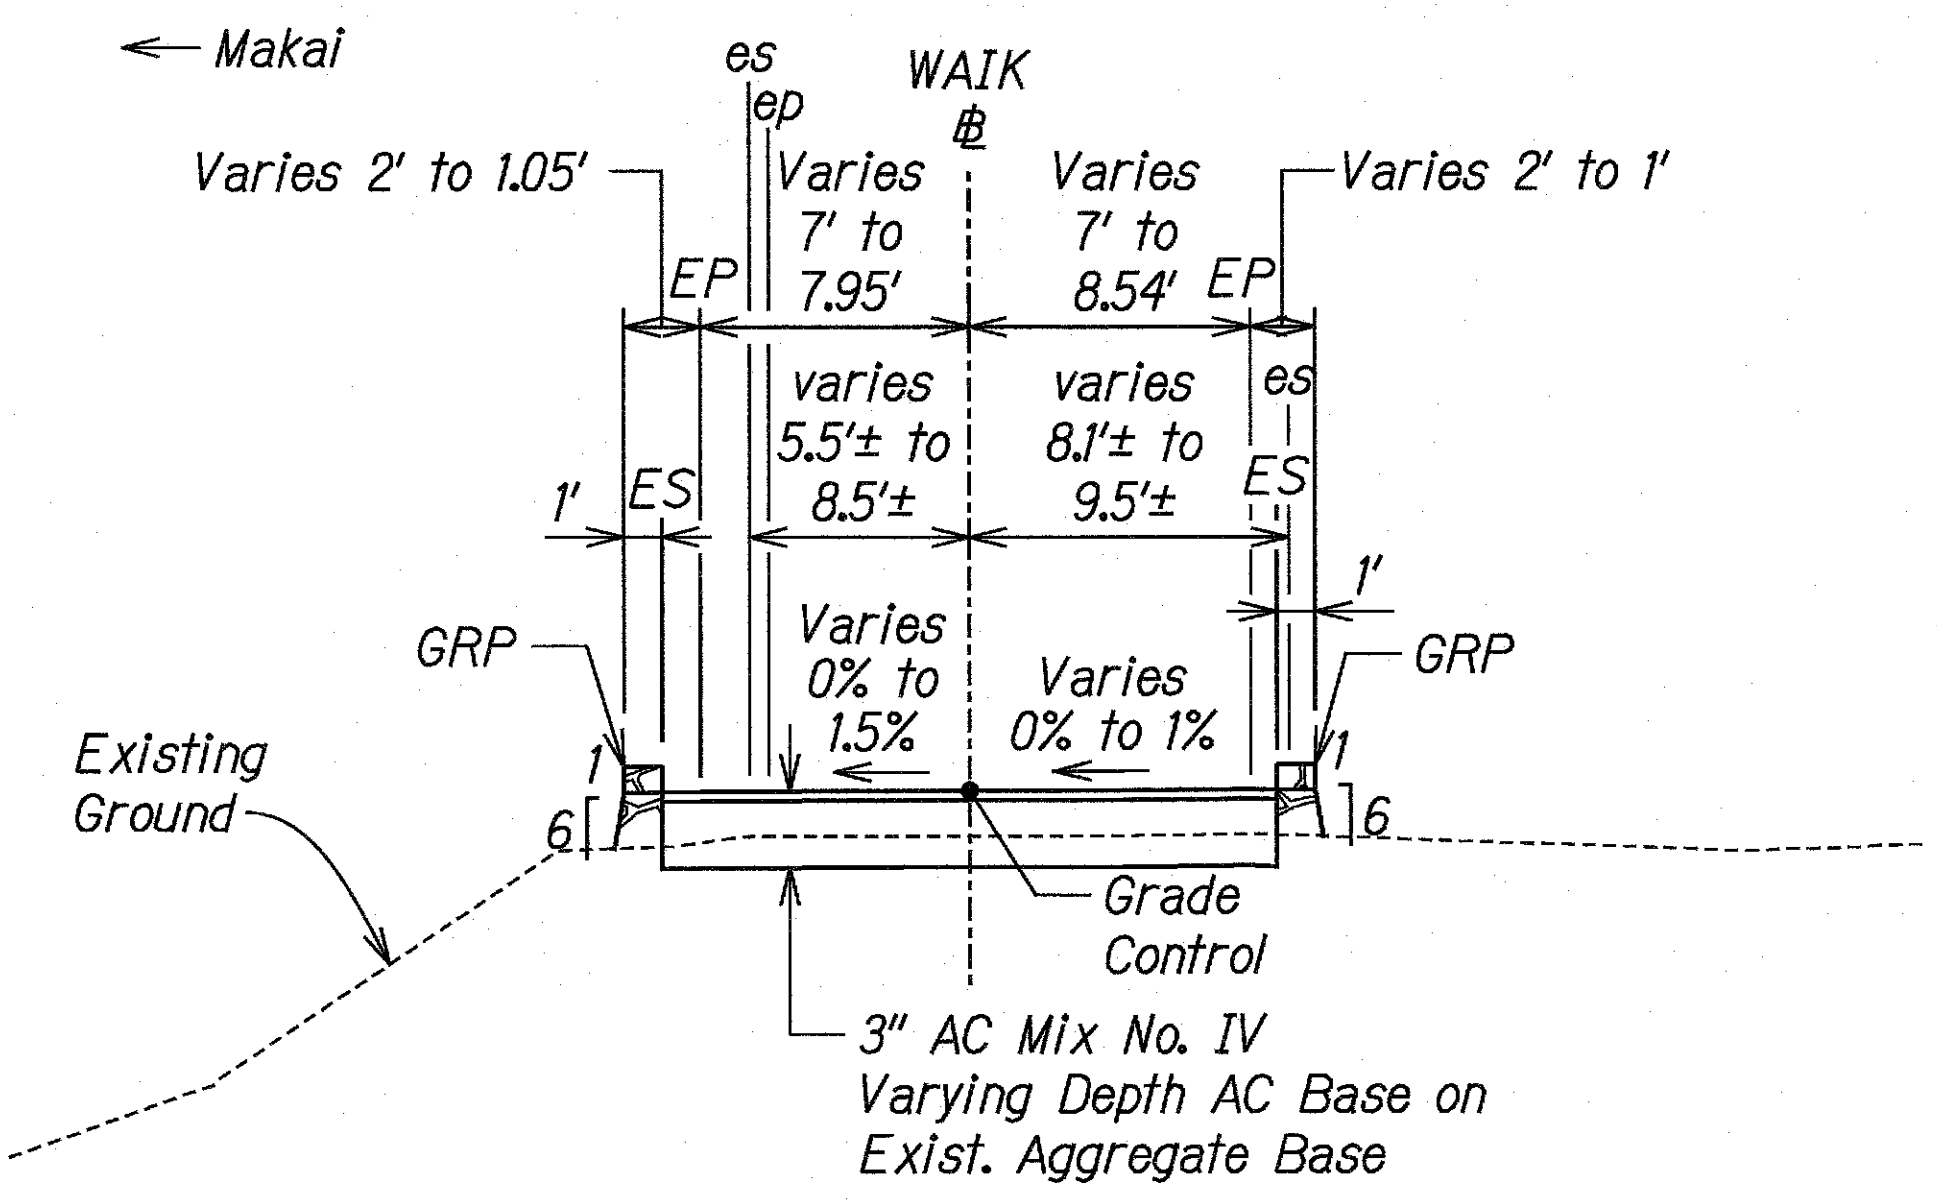

TYPICAL SECTION
KUHIO HWY (AT EAST APPROACH)
STA. 2+66.28 STA. 3+01.28
 Scale: 1" = 5'

ORIGINAL PLAN	DATE
NOTE BOOK	
DESIGNED BY	
CHECKED BY	
QUANTITIES BY	
NO.	

T-16553A-EMERGENCY FLOOD REPAIR/CADD/SHEETS/15-3499

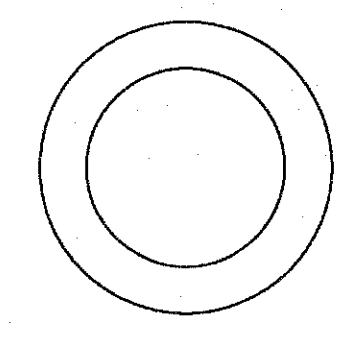

THIS WORK WAS PREPARED BY ME OR UNDER MY SUPERVISION.

SIGNATURE _____ EXPIRATION DATE OF THE LICENSE 04/30/20

STATE OF HAWAII
 DEPARTMENT OF TRANSPORTATION
 HIGHWAYS DIVISION

WAIKOKO STREAM BRIDGE
TYPICAL SECTIONS

KAUAI EMERGENCY FLOOD REPAIRS & CLEANUP
At Various Locations April 2018, Rte. 560
Proj. No. ER-19(007)

Scale: As Shown Date: OCT. 2018

SHEET No. T-1 OF 1 SHEETS