

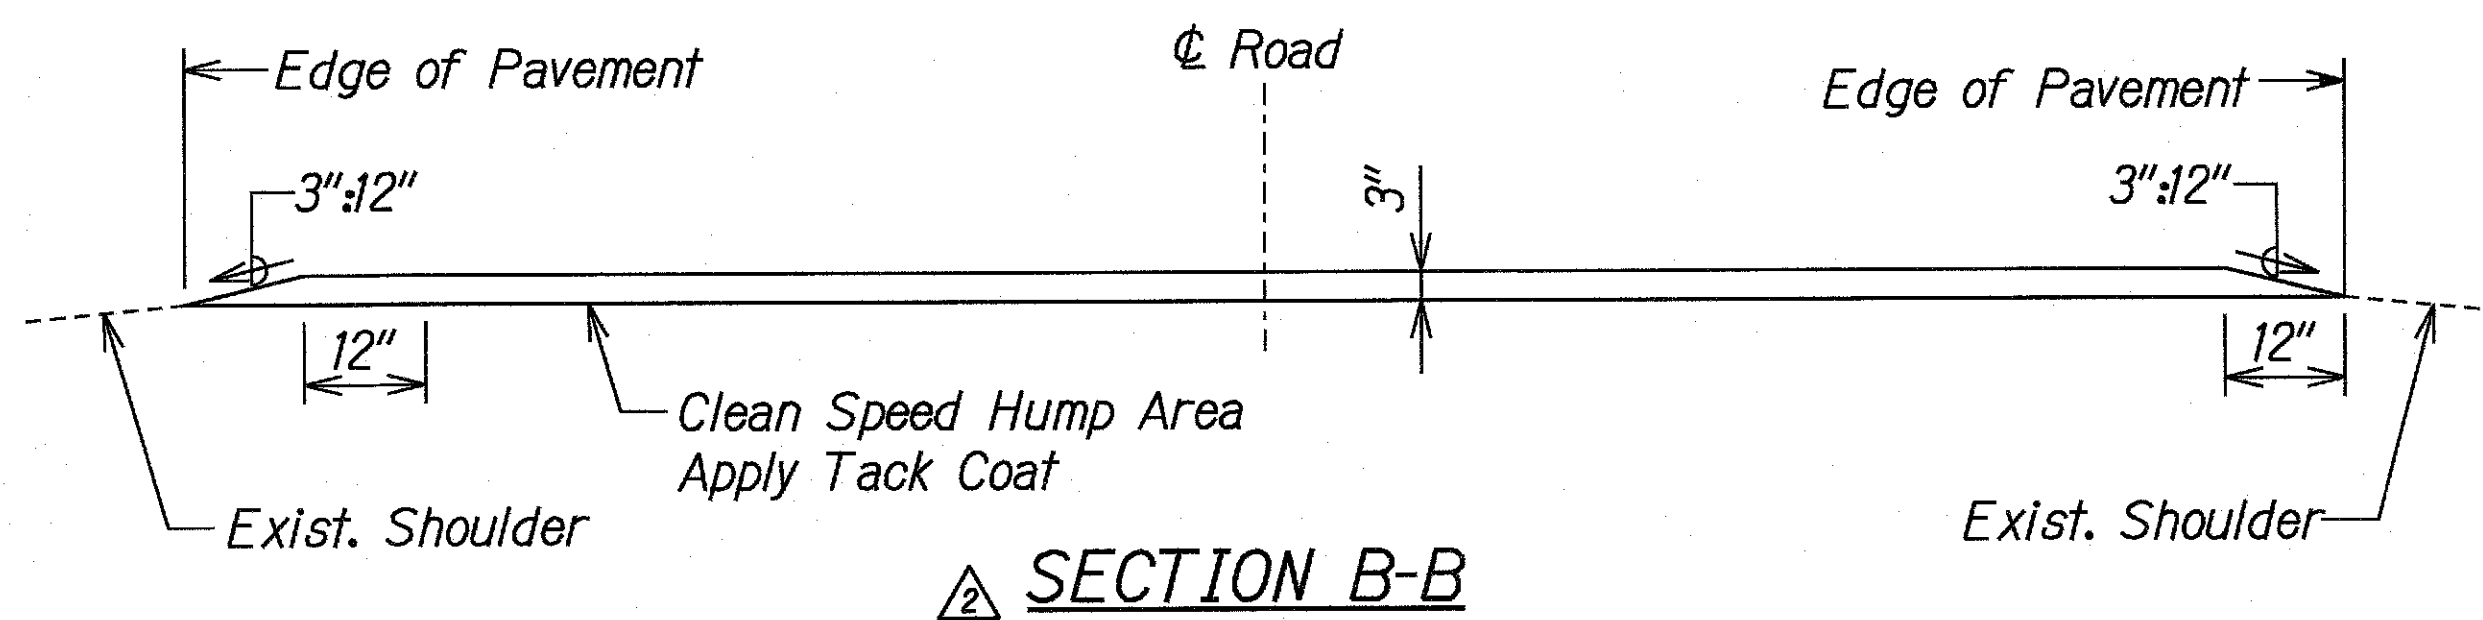
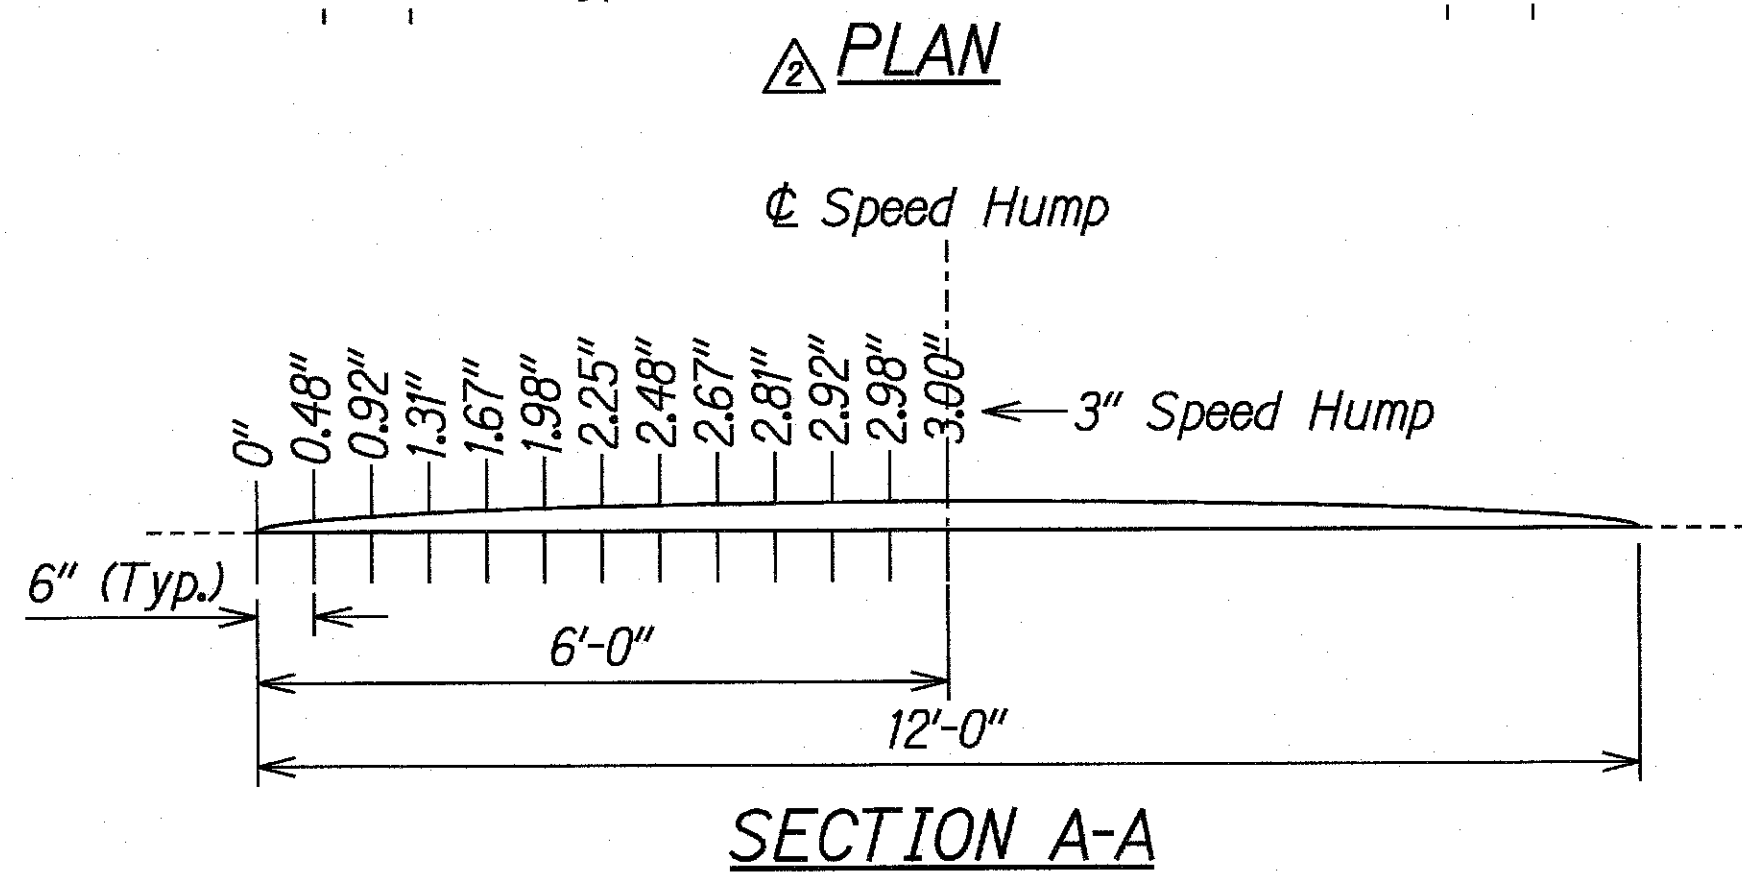


FED. ROAD DIST. NO.	STATE	FEDERAL AID PROJ. NO.	FISCAL YEAR	SHEET NO.	TOTAL SHEETS
HAWAII	HAW.	ER-19(007)	2018	15	43

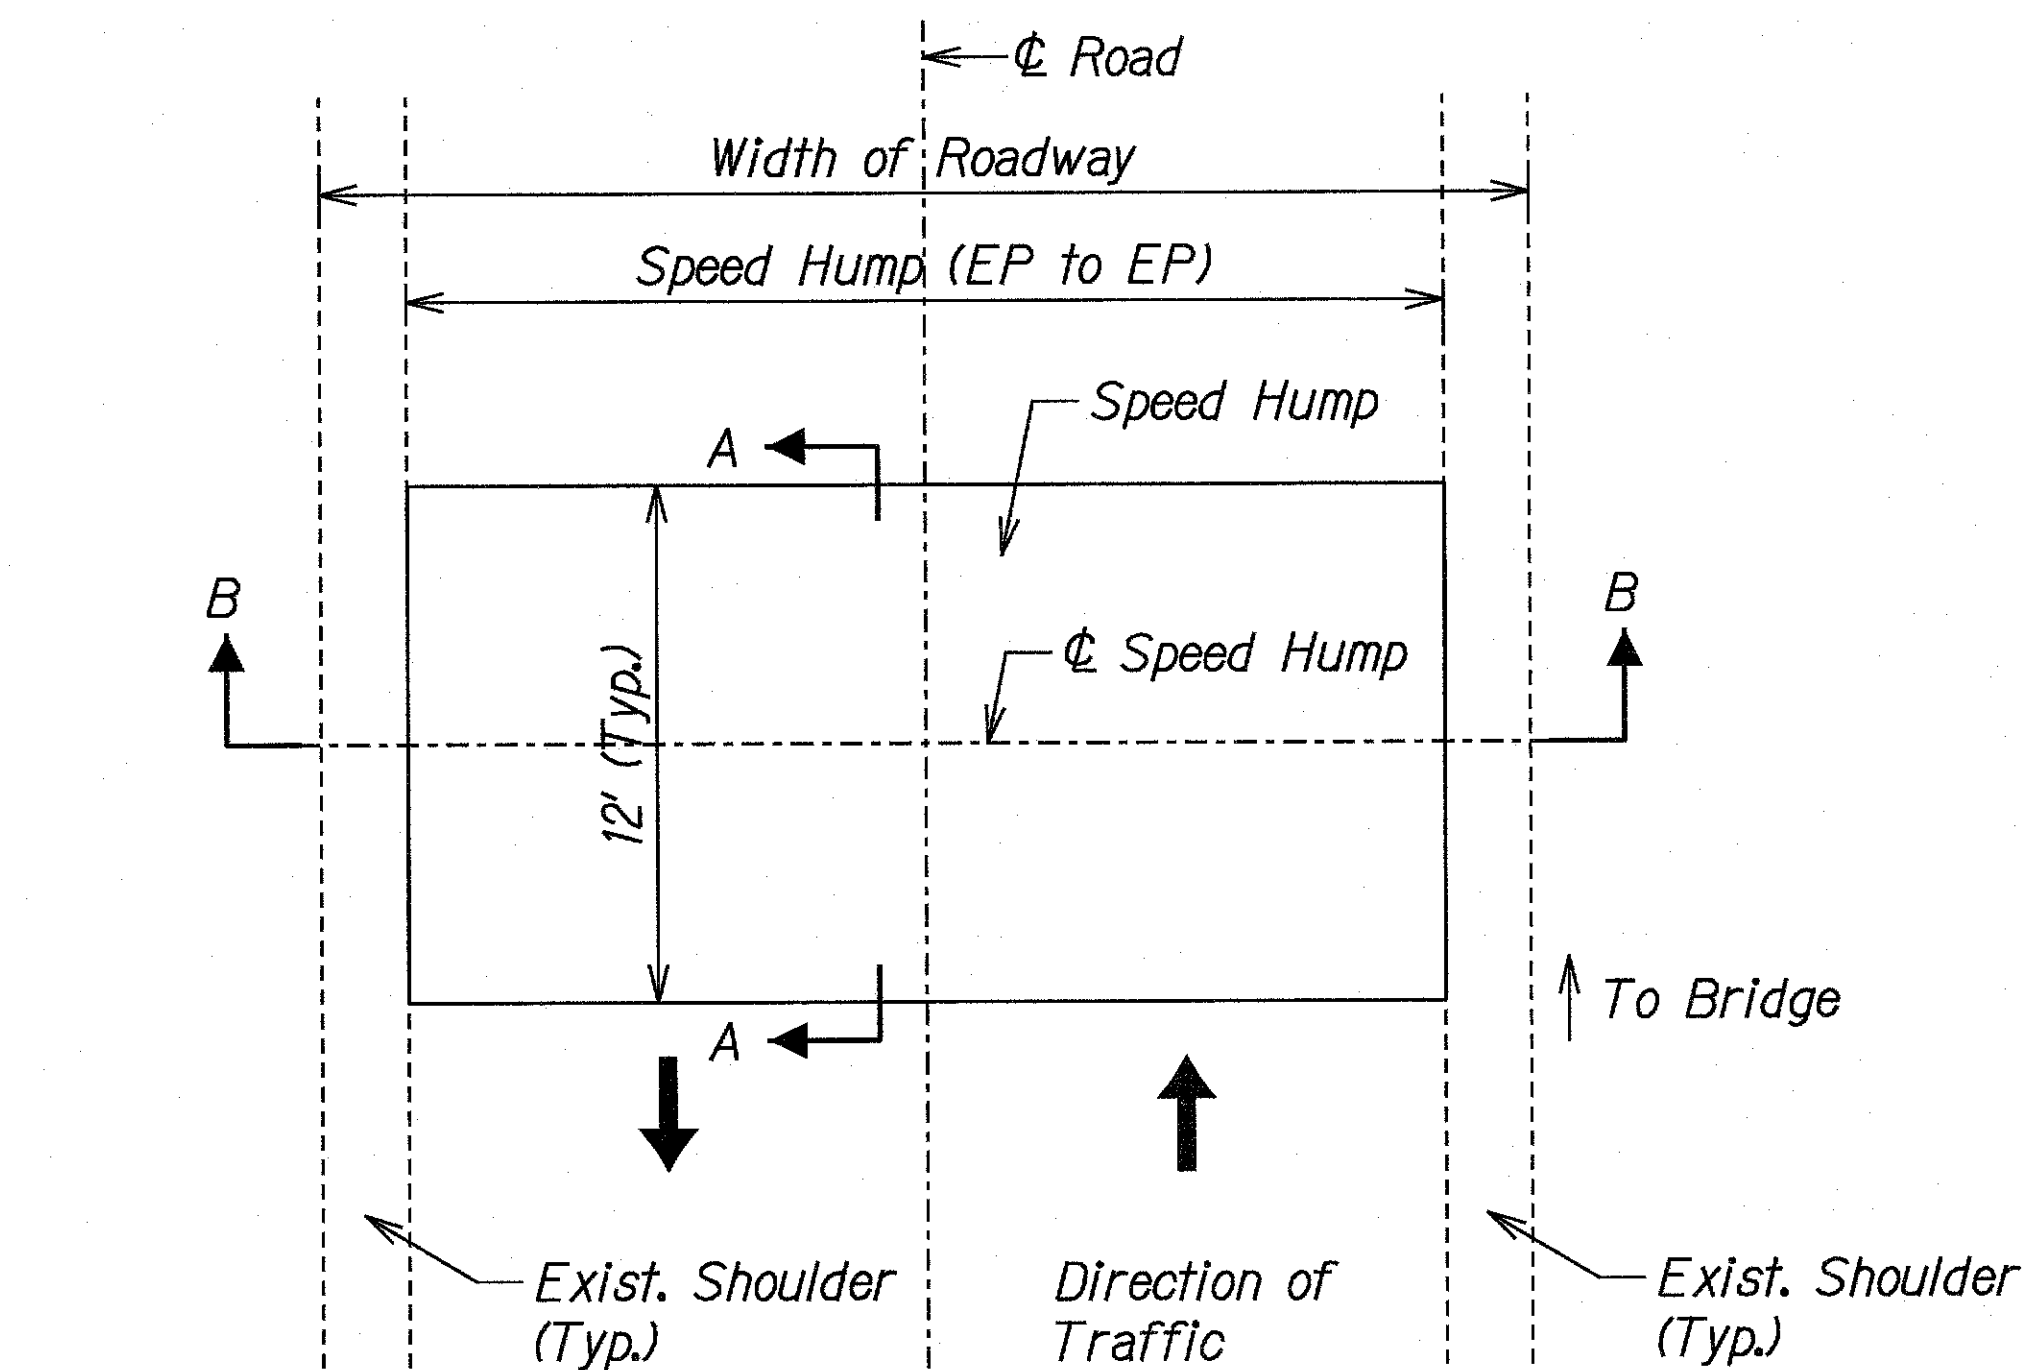


TYPICAL SPEED HUMP DETAIL
Not to Scale

LEGEND FOR AS-BUILT POSTINGS	
	Squiggly line for as-built deletion
	Double line for as-built deletion
Roadway	Text for as-built posting

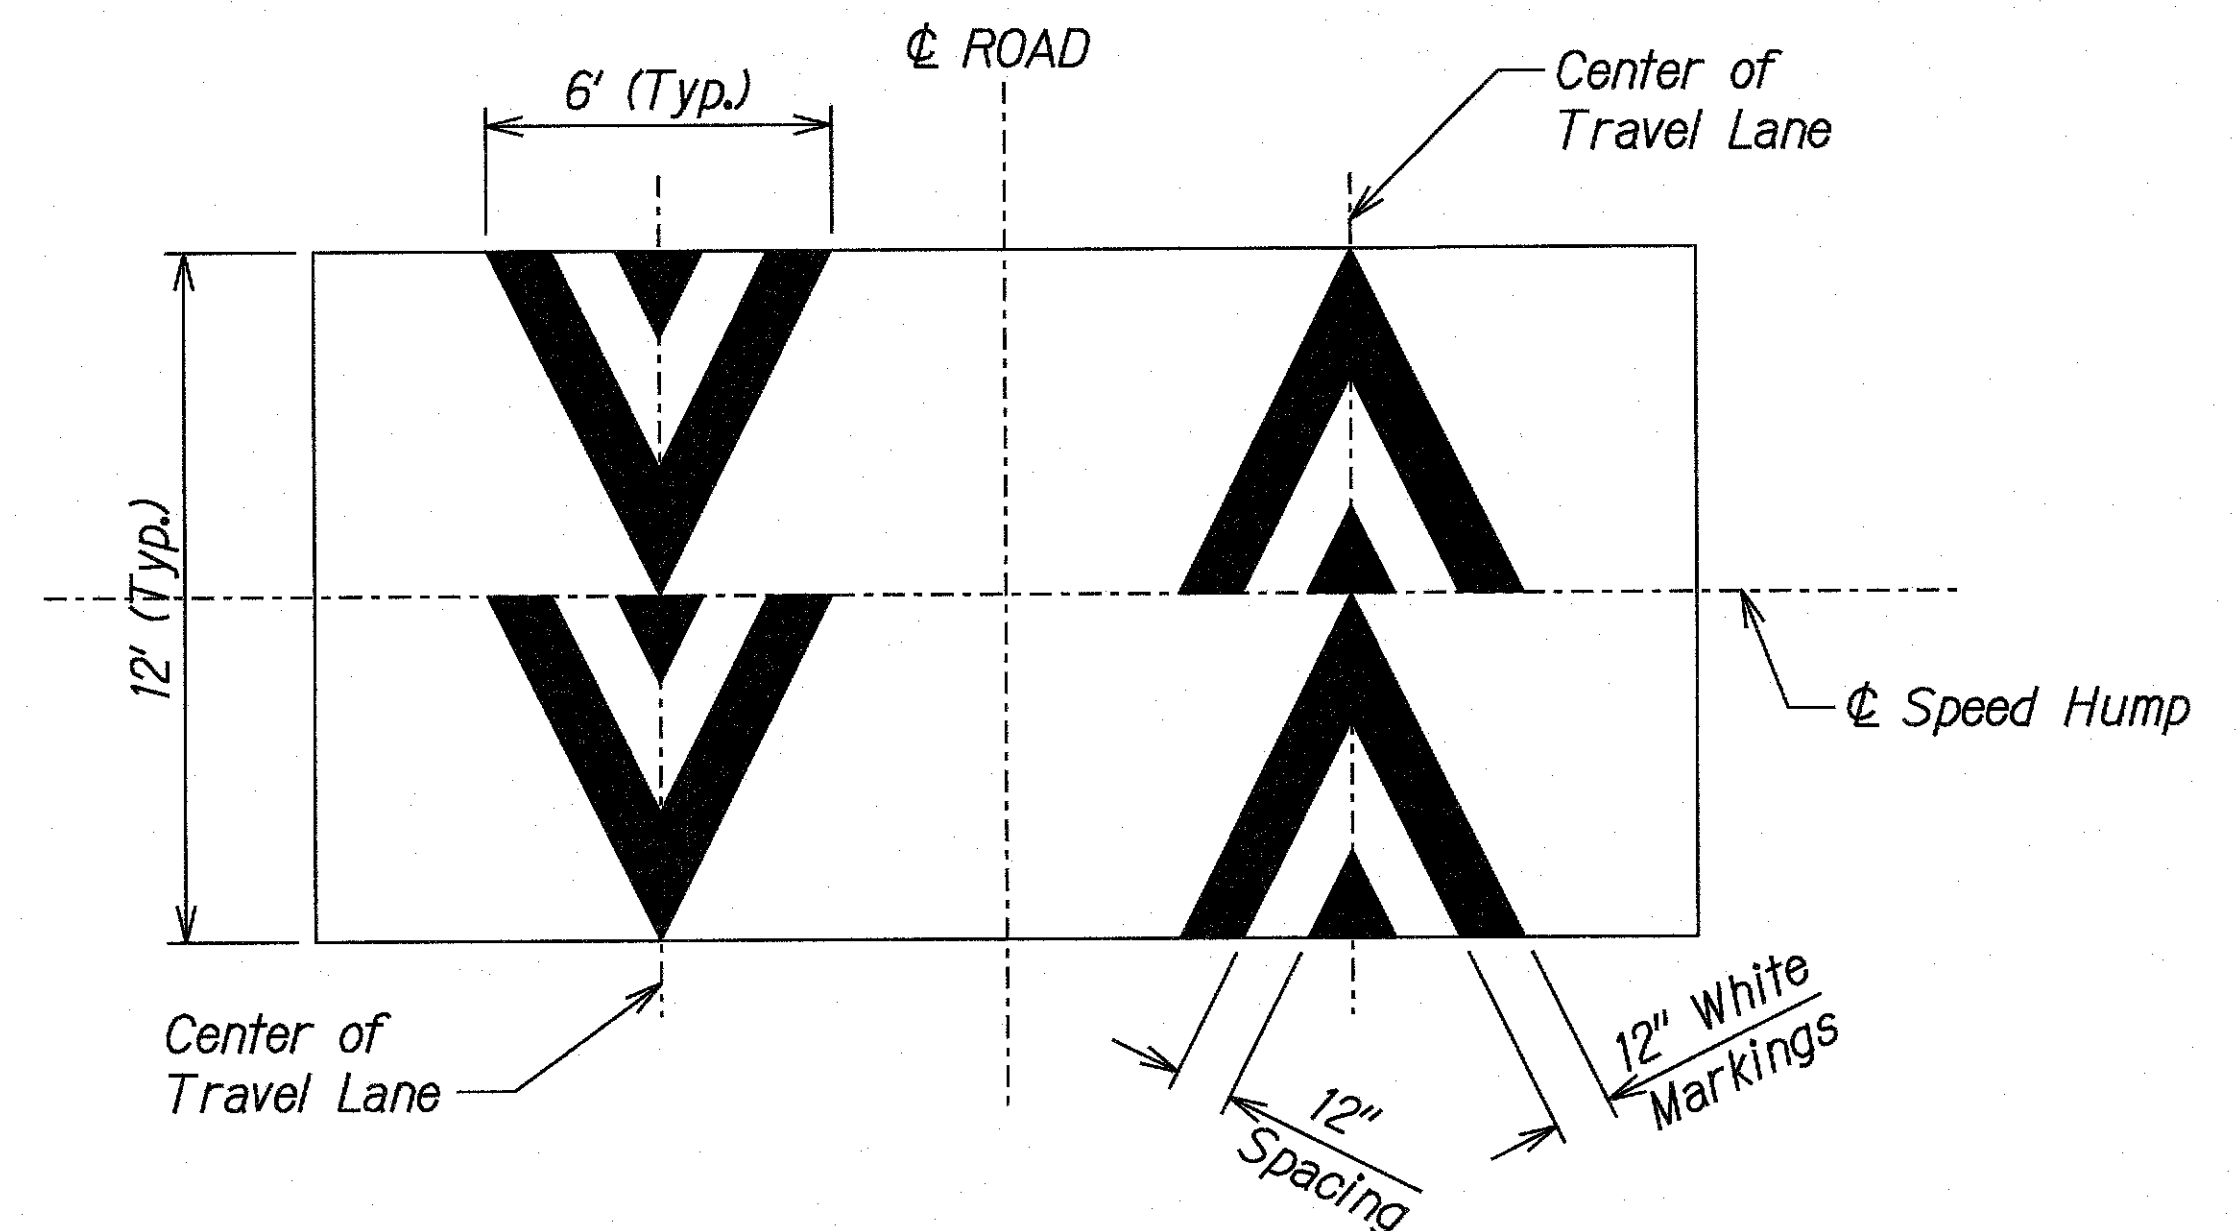

Typical Speed Hump Pavement Marking Detail

* See Bridge Pavement Marking Plans for Placement and Spacing Otherwise Use Dimensions as Shown in Typical Detail.

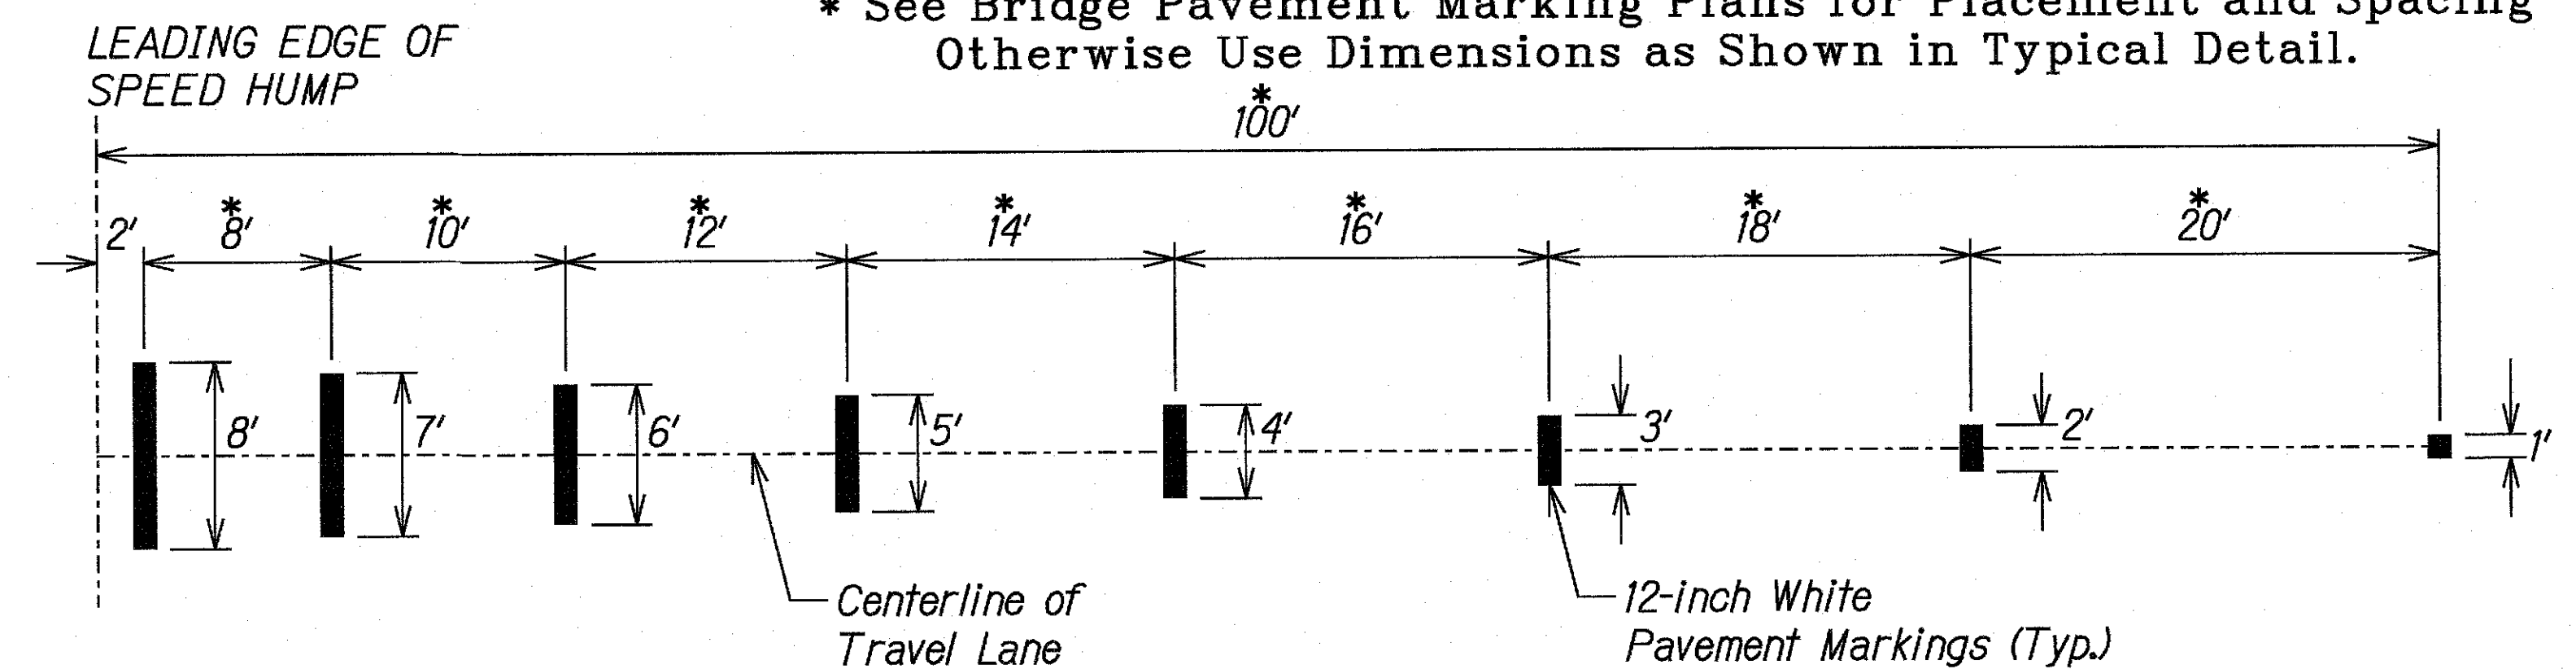

Typical Advance Speed Hump Pavement Marking Detail
(Where Shown on Pavement Marking Plan)

TYPICAL PAVEMENT MARKINGS FOR SPEED HUMPS
Not to Scale

SURVEY PLOTTED BY	DATE
DRAWN BY	
DESIGNED BY	
QUANTITIES BY	
CHECKED BY	
ORIGINAL PLAN	
NOTE BOOK	
No.	

T:\16533A-EmergencyFloodRepair\CADD\Sheets\SpeedHump.dgn

8/8/19	Speed Hump Revisions
Date	Revision

STATE OF HAWAII DEPARTMENT OF TRANSPORTATION HIGHWAYS DIVISION	
SPEED HUMP DETAILS AND MARKINGS	
KAUAI EMERGENCY FLOOD REPAIRS & CLEANUP At Various Locations April 2018, Rte. 560 Fed. Aid Proj. No. ER-19(007)	
Scale: Not to Scale	Date: Oct. 2018
SHEET No. SS-2 OF 3 SHEETS	

"AS-BUILT"