


FED. ROAD DIST. NO.	STATE	FEDERAL AID PROJ. NO.	FISCAL YEAR	SHEET NO.	TOTAL SHEETS
HAWAII	HAW.	ER-19(007)	2018	13	43

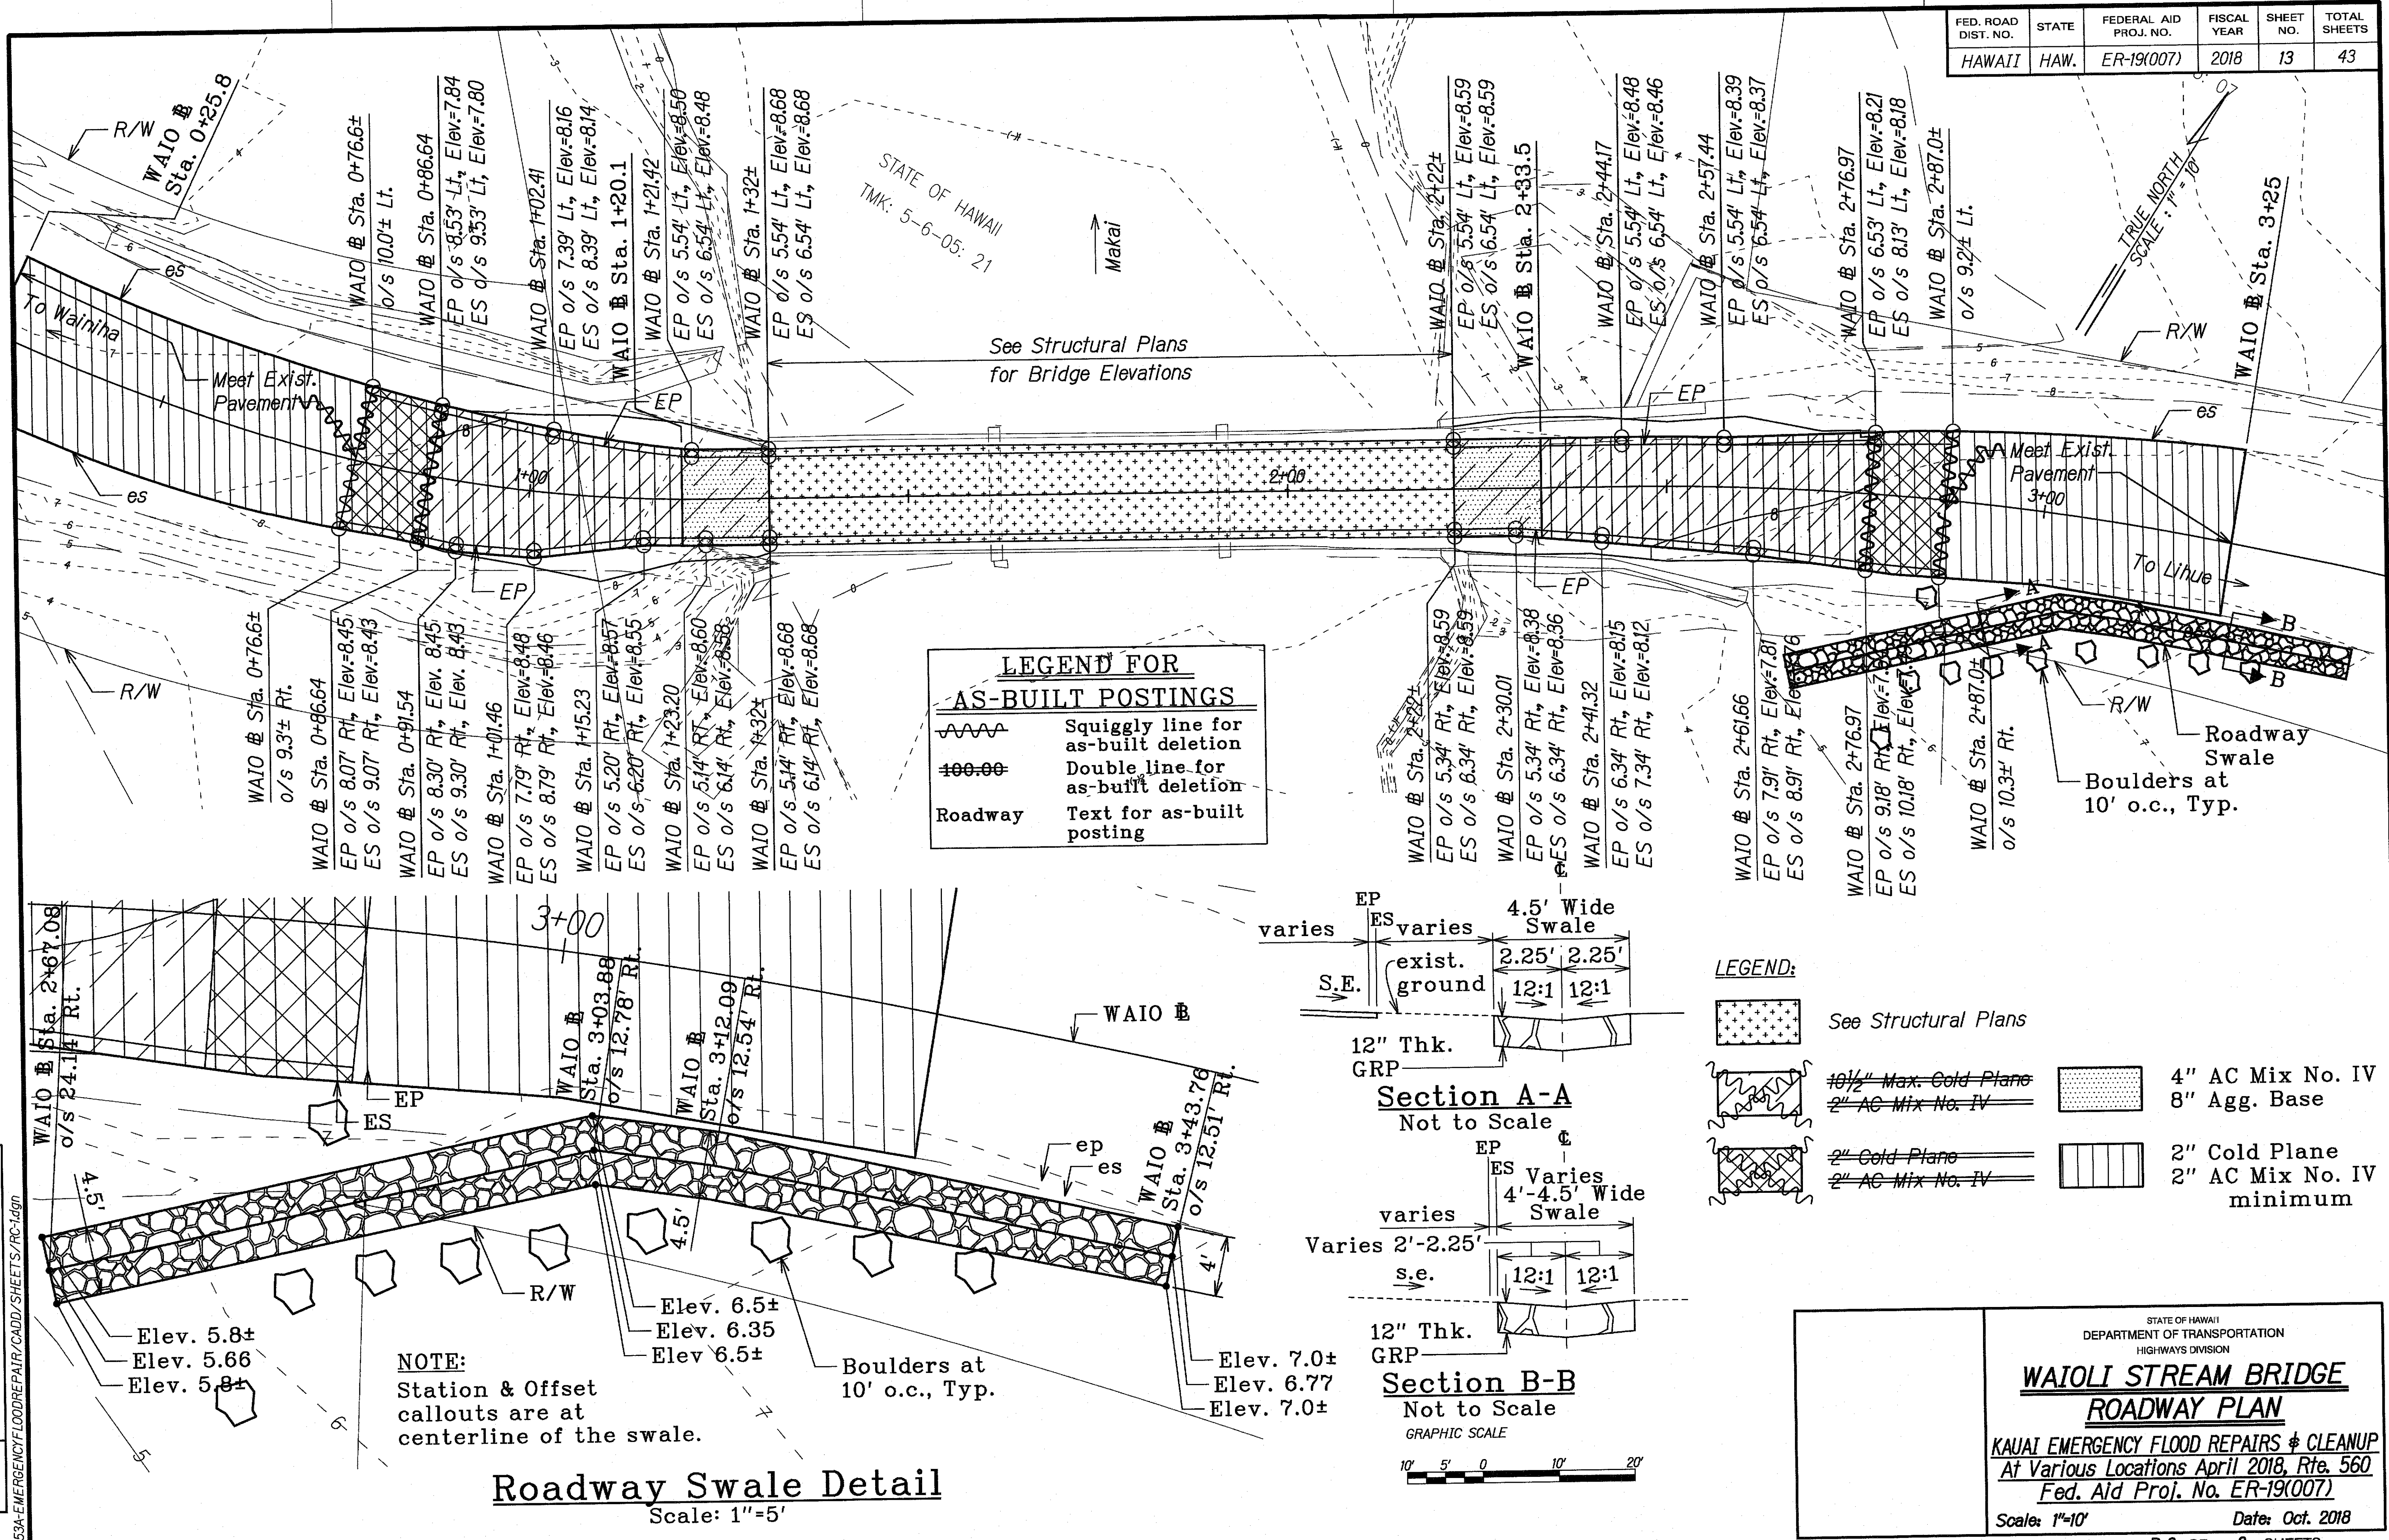


LEGEND FOR AS-BUILT POSTINGS

Squiggly line for as-built deletion

Double line for as-built deletion

Roadway Text for as-built posting

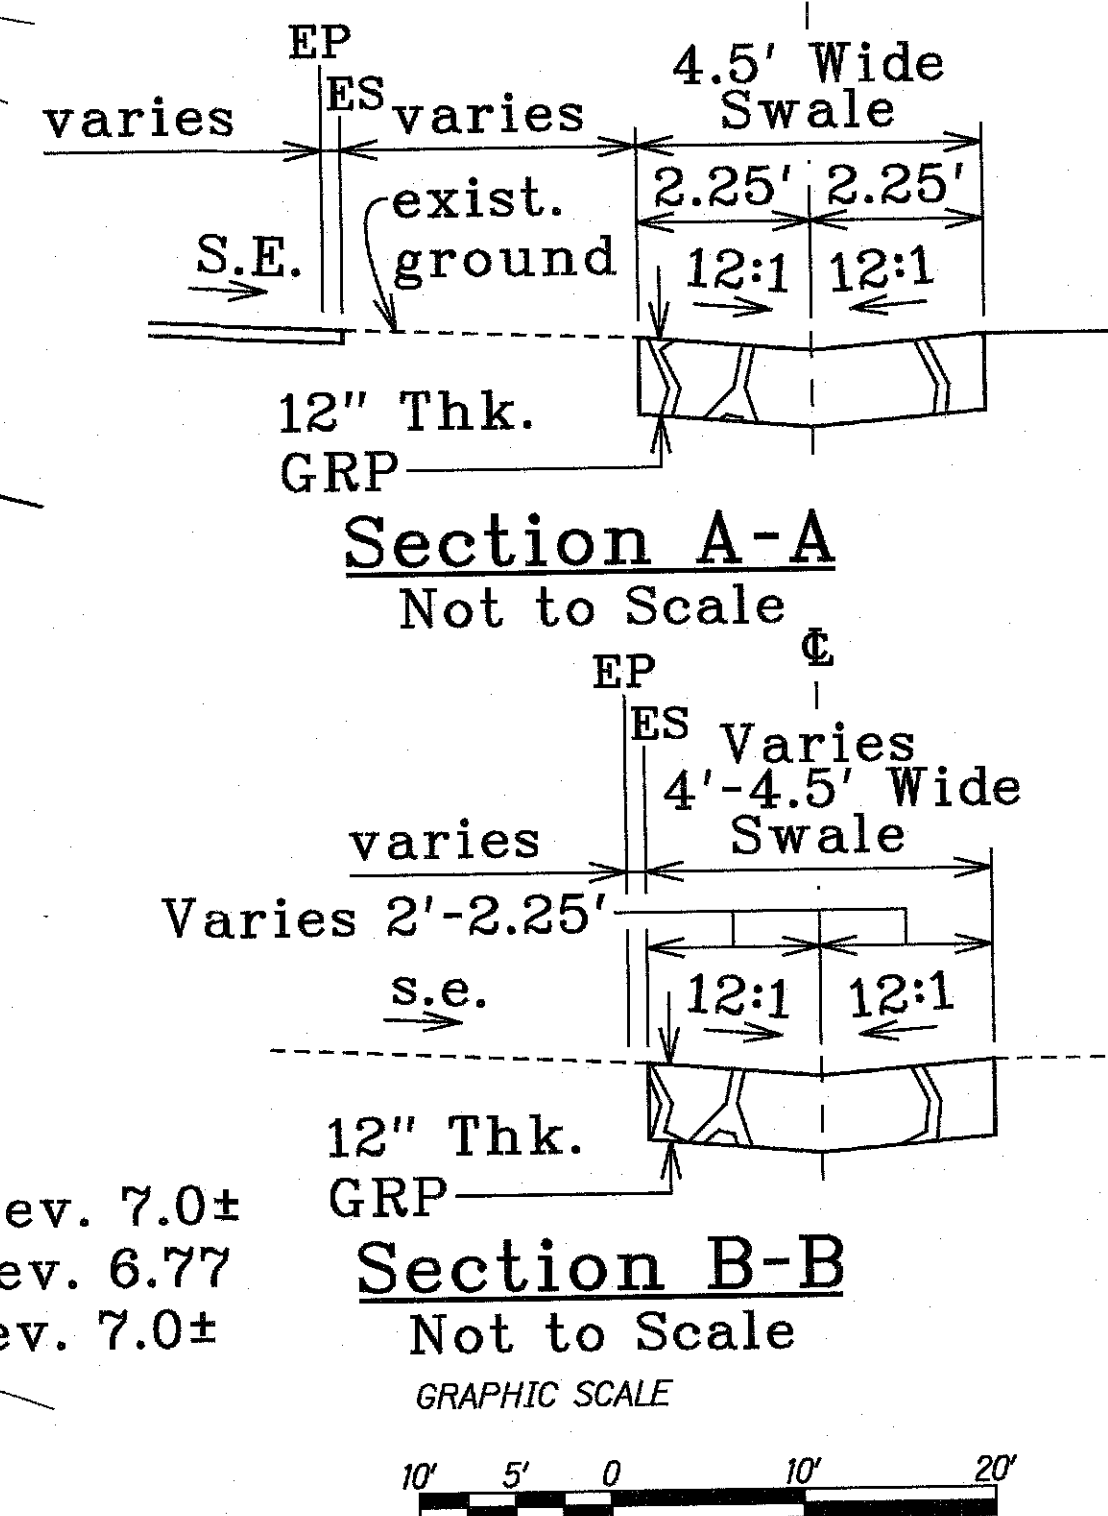

LEGEND:

See Structural Plans

4" AC Mix No. IV

8" Agg. Base

2" Cold Plane

2" AC Mix No. IV minimum

Roadway Swale Detail
Scale: 1"=5'

NOTE: Station & Offset callouts are at centerline of the swale.

Elev. 5.8±
Elev. 5.66
Elev. 5.8±

Elev. 6.5±
Elev. 6.35
Elev. 6.5±

Boulders at 10' o.c., Typ.

STATE OF HAWAII
DEPARTMENT OF TRANSPORTATION
HIGHWAYS DIVISION

**WAIOLI STREAM BRIDGE
ROADWAY PLAN**

KAUAI EMERGENCY FLOOD REPAIRS & CLEANUP
At Various Locations April 2018, Rte. 560
Fed. Aid Proj. No. ER-19(007)

Scale: 1"=10' Date: Oct. 2018

SHEET No. R-2 OF 2 SHEETS

"AS-BUILT"