


**BRIDGE STRIPING SECTION**  
Scale: 1"=5'

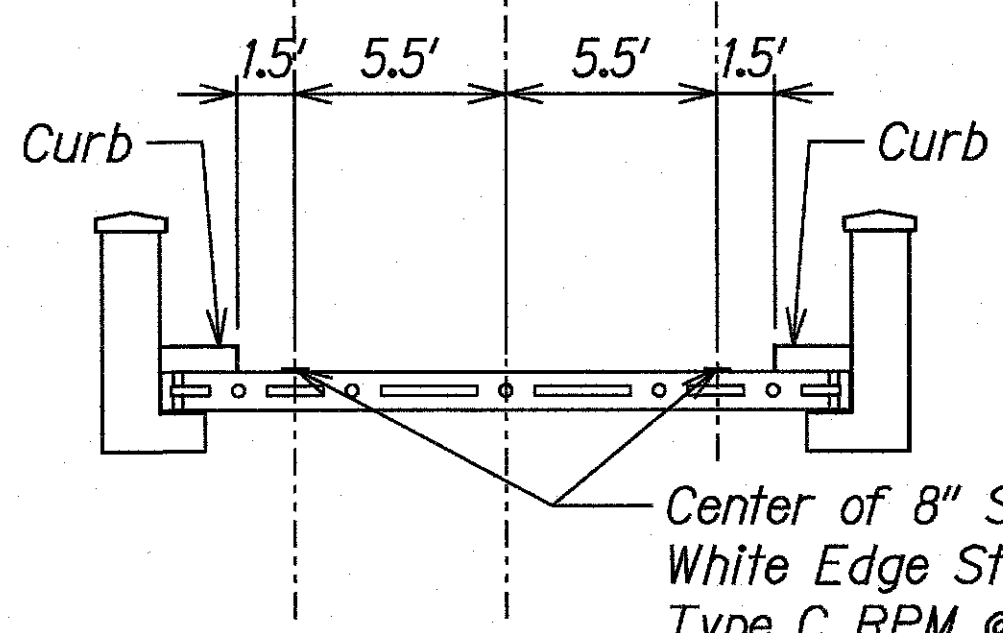

**NOTES:**  
1. See Structural Plans for bridge drain hole locations.

LEGEND FOR AS-BUILT POSTINGS	
	Squiggly line for as-built deletion
	Double line for as-built deletion
	Text for as-built posting

Date	Revision
10/15/19	△ Reflector Markers Added
9/20/19	△ Bridge Striping Revisions, Added Note
8/13/19	△ Speed Hump Revisions

STATE OF HAWAII  
DEPARTMENT OF TRANSPORTATION  
HIGHWAYS DIVISION

**SIGNING AND PAVEMENT MARKING PLAN - WAIPA**

KAUAI EMERGENCY FLOOD REPAIRS & CLEANUP  
At Various Locations April 2018, Rte. 560  
Fed. Aid Proj. No. ER-19(007)

Scale: 1"=20' Date: Oct. 2018

DATE	_____
DESIGNED BY	_____
CHECKED BY	_____
DATE	_____
DESIGNED BY	_____
CHECKED BY	_____

T:\16553A-EMERGENCY\FLOODREPAIR\CADD\SHEETS\SS-2.dgn

"AS-BUILT"