

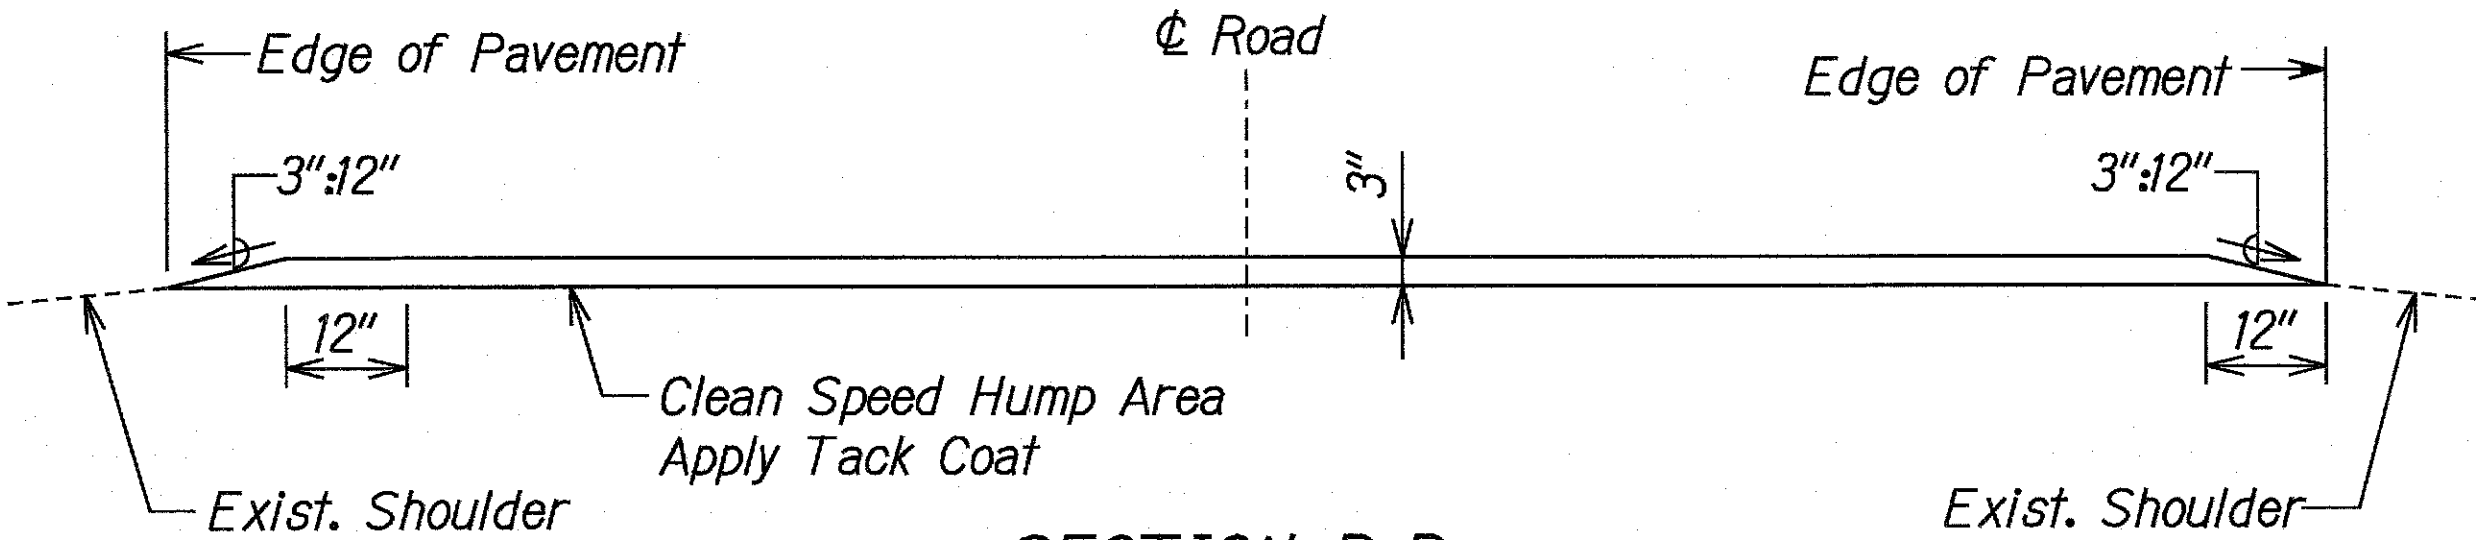
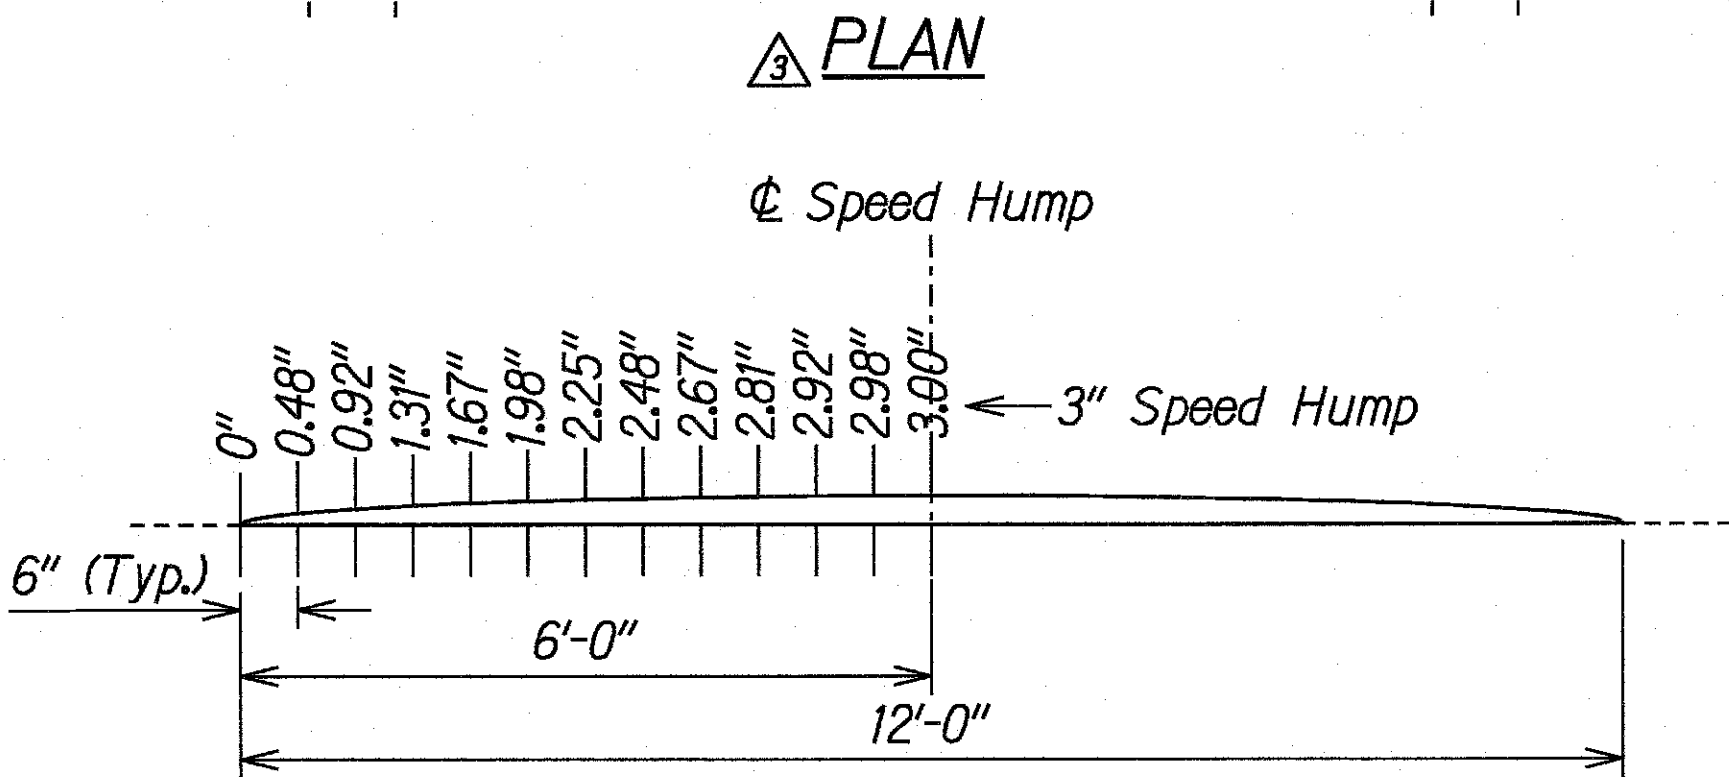


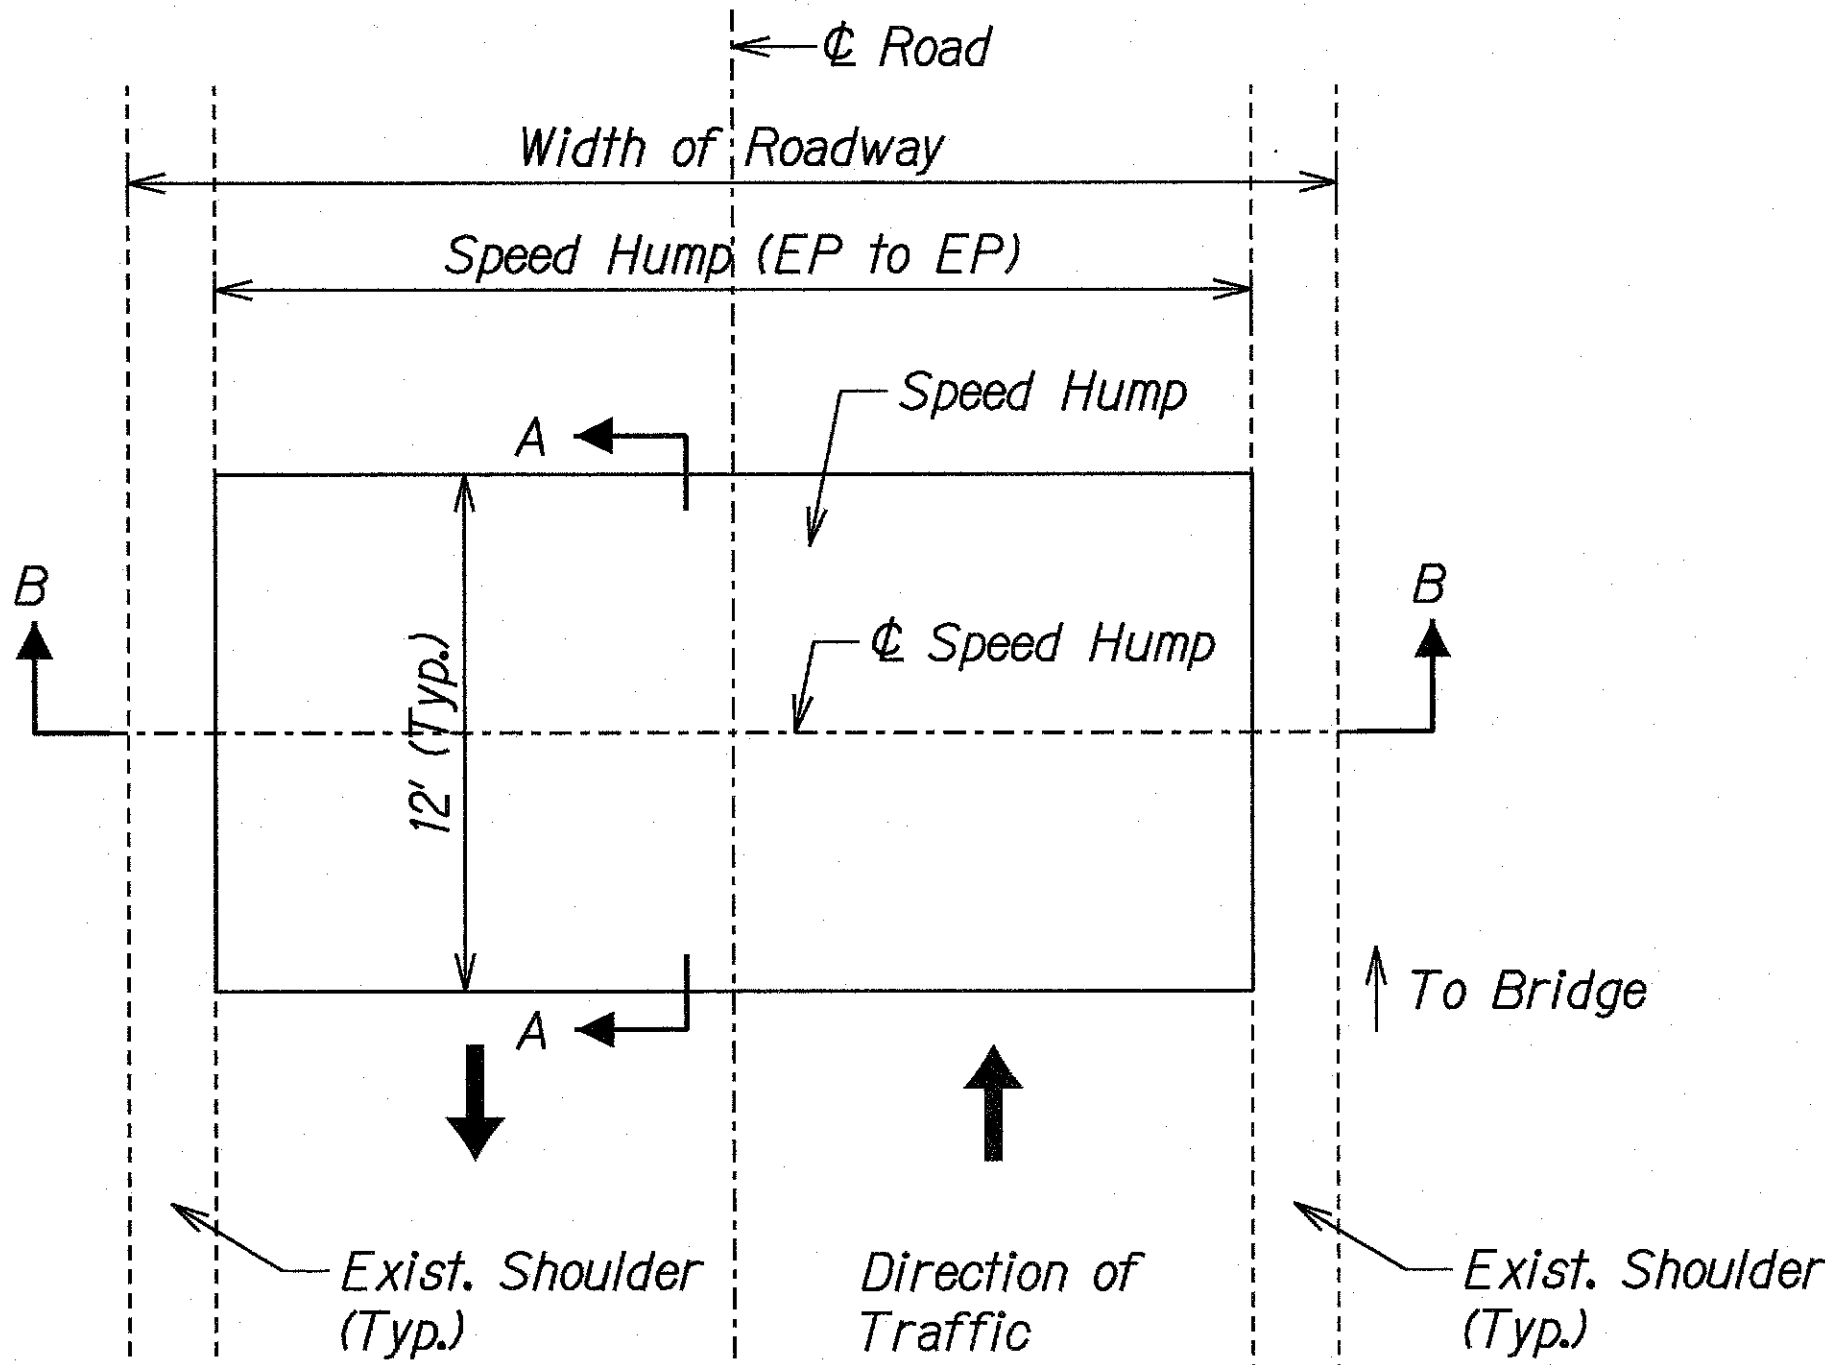

TYPICAL SPEED HUMP DETAIL


Not to Scale

LEGEND FOR AS-BUILT POSTINGS	
	Squiggly line for as-built deletion
	Double line for as-built deletion
Roadway	Text for as-built posting

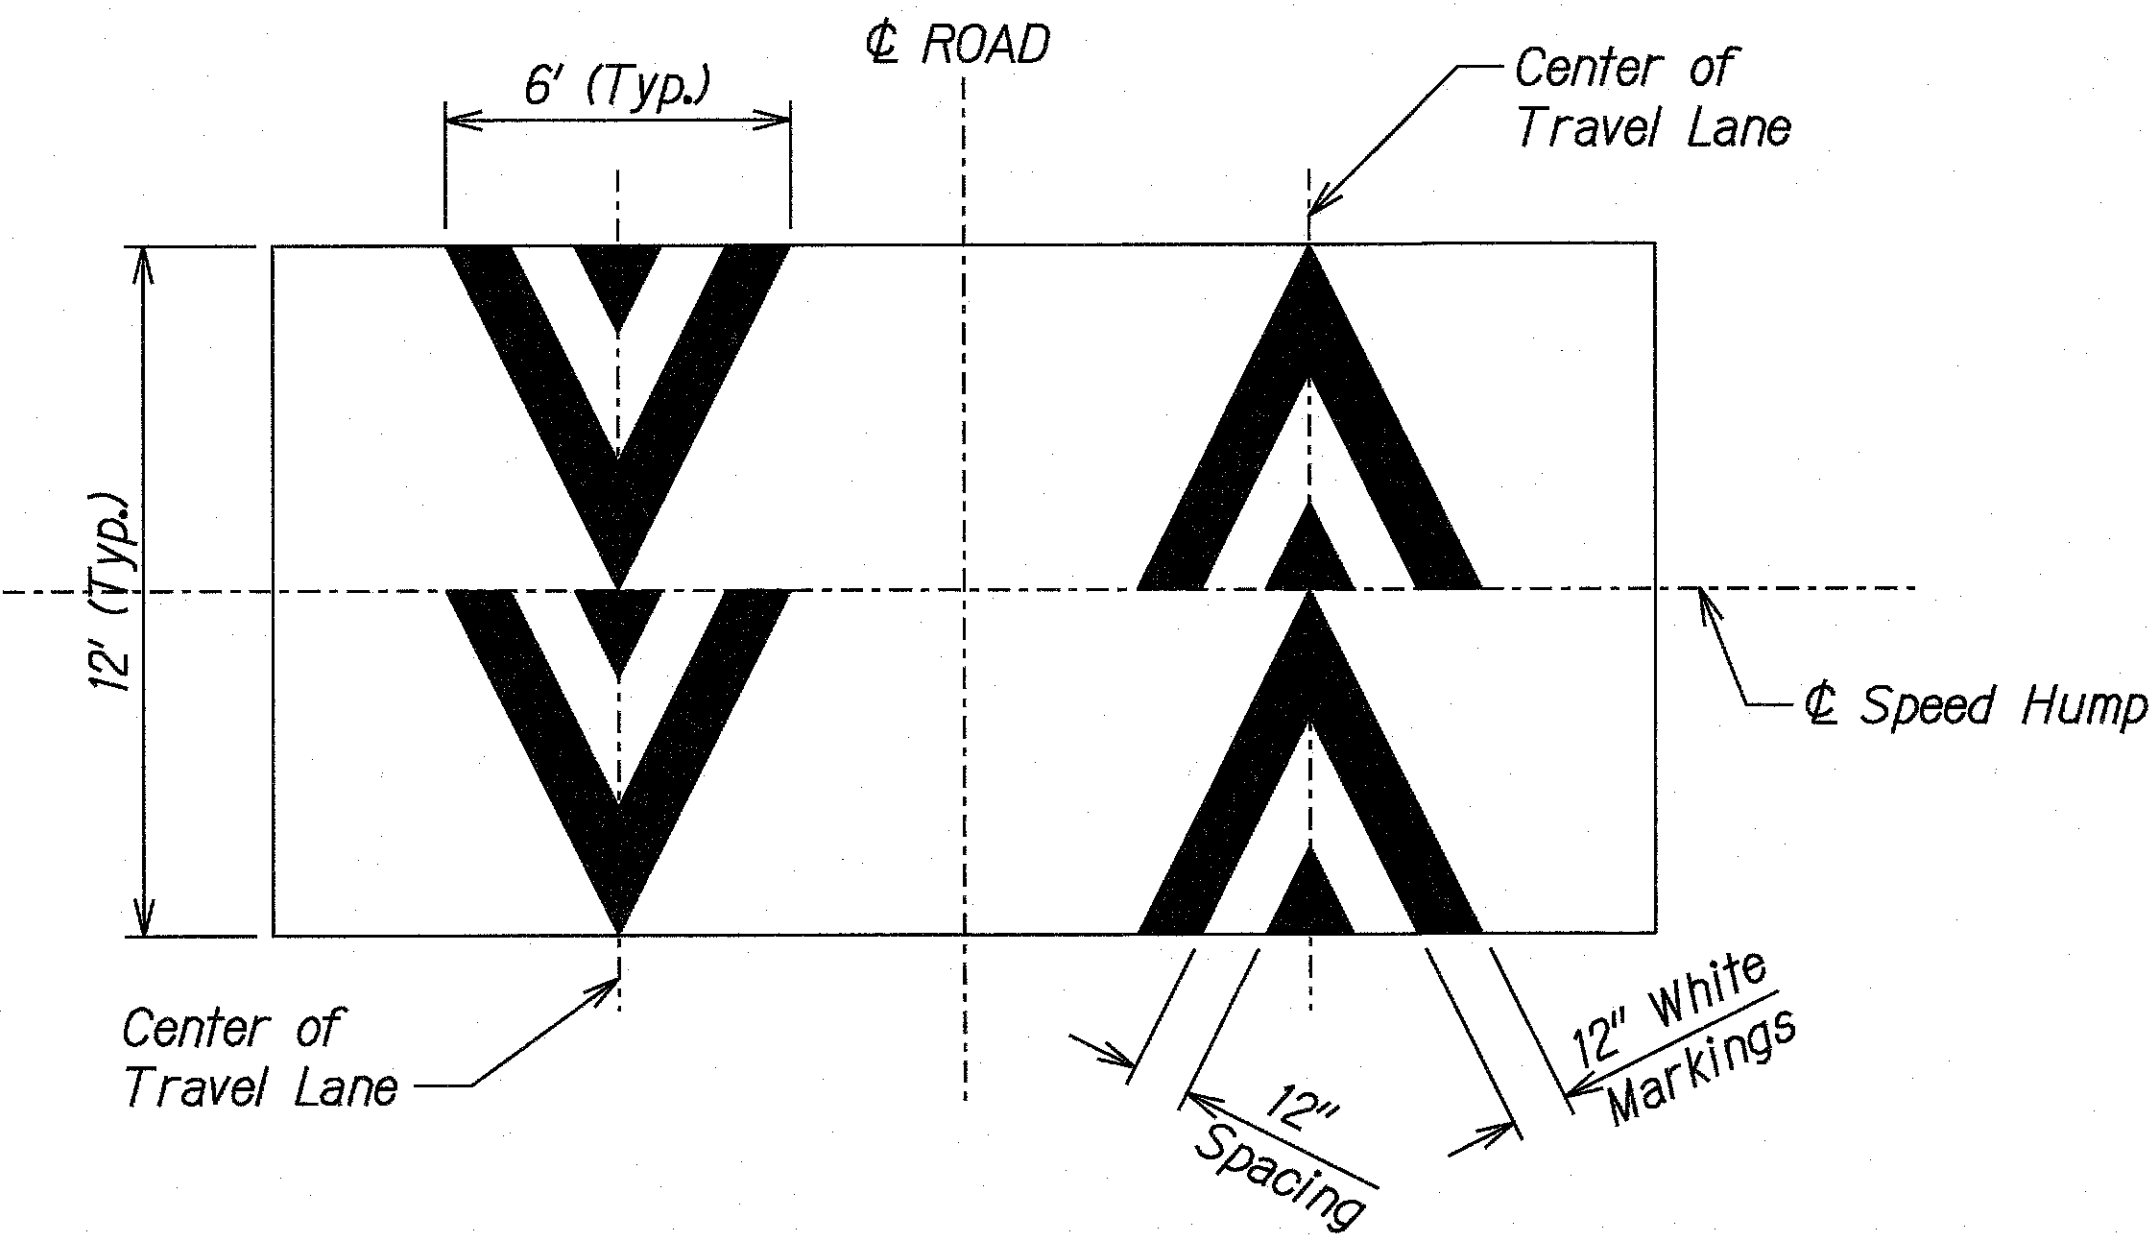

Typical Speed Hump Pavement Marking Detail

* See Bridge Pavement Marking Plans for Placement and Spacing. Otherwise Use Dimensions as Shown in Typical Detail.

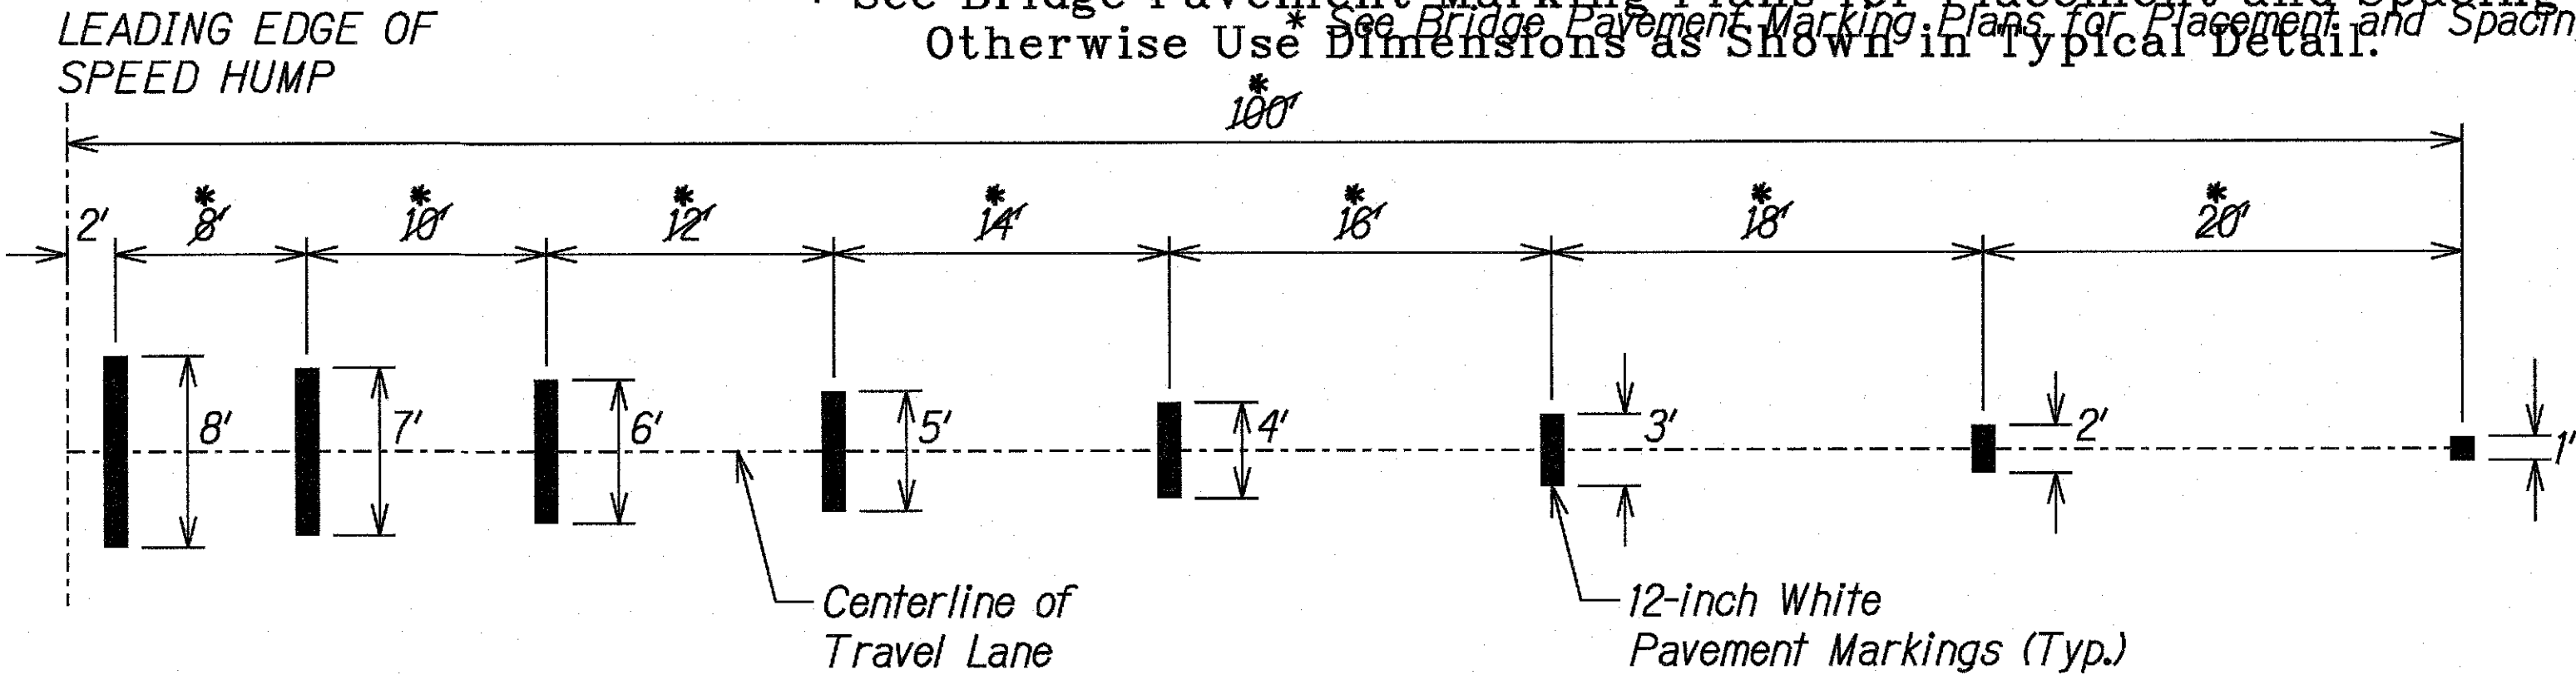

Typical Advance Speed Hump Pavement Marking Detail

(Where Shown on Pavement Marking Plan)

TYPICAL PAVEMENT MARKINGS FOR SPEED HUMPS

Not to Scale

SURVEY PLOTTED BY	DATE
DRAWN BY	
CHECKED BY	
NOTE BOOK	
QUANTITIES BY	
CHECKED BY	

T:\16533A-EmergencyFloodRepair\CADD\Sheets\SpeedHump.dgn

8/13/19	Speed Hump Revisions
Date	Revision

STATE OF HAWAII
DEPARTMENT OF TRANSPORTATION
HIGHWAYS DIVISION
SPEED HUMP DETAILS AND MARKINGS
KAUAI EMERGENCY FLOOD REPAIRS & CLEANUP
At Various Locations April 2018, Rte. 560
Fed. Aid Proj. No. ER-19(007)
Scale: Not to Scale Date: Oct. 2018

SHEET No. SS-2 OF 3 SHEETS

"AS-BUILT"