
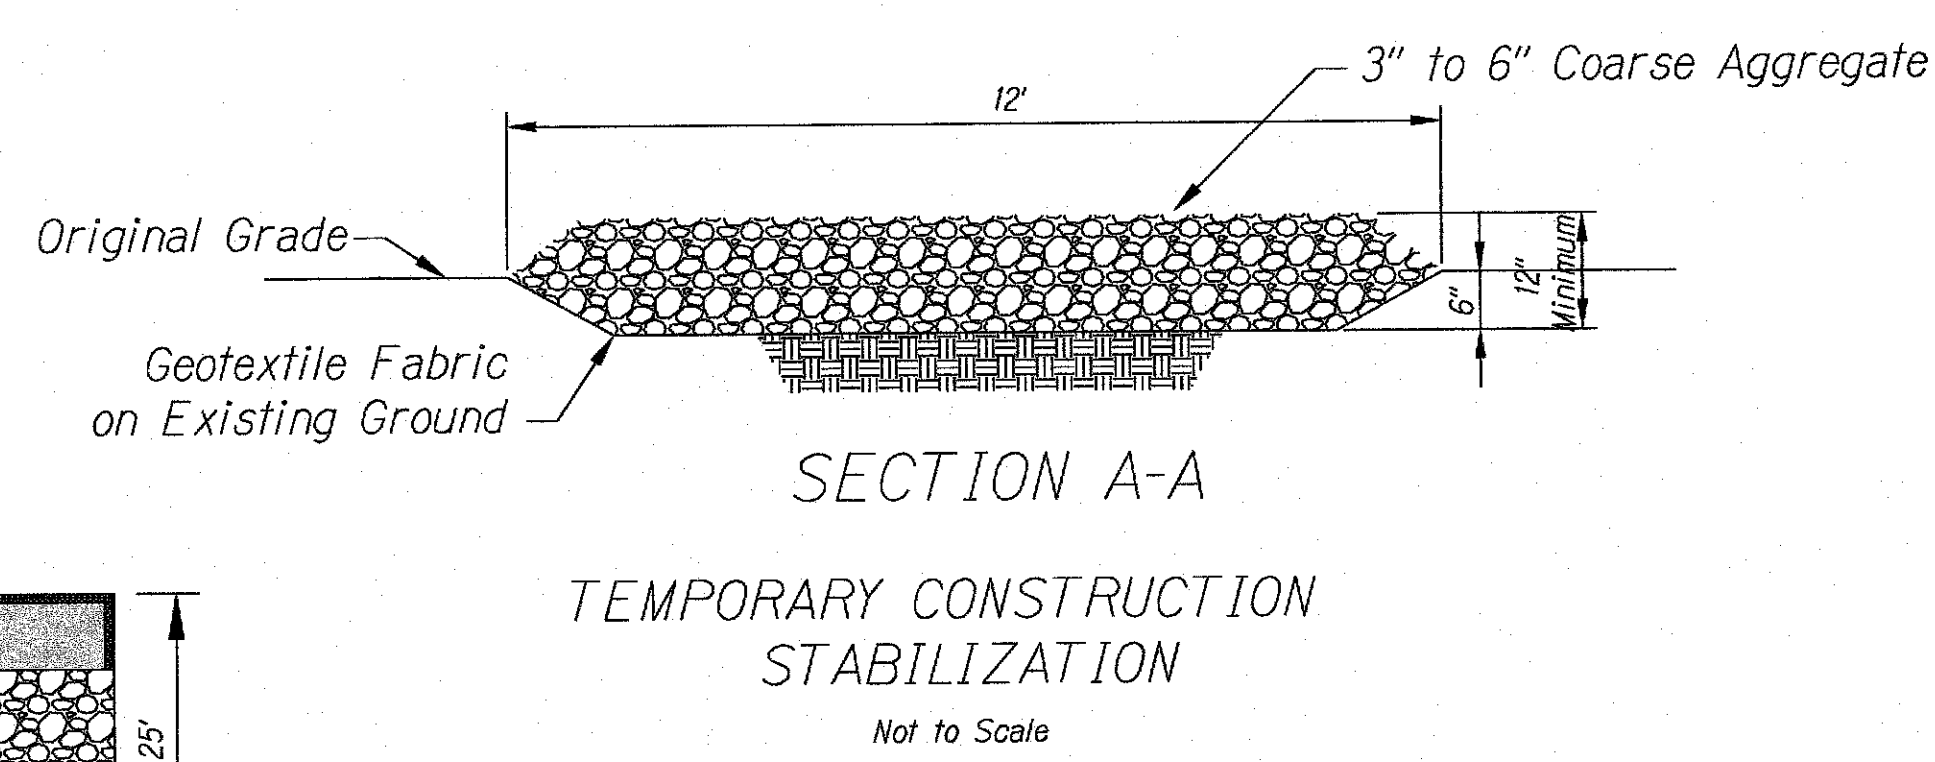
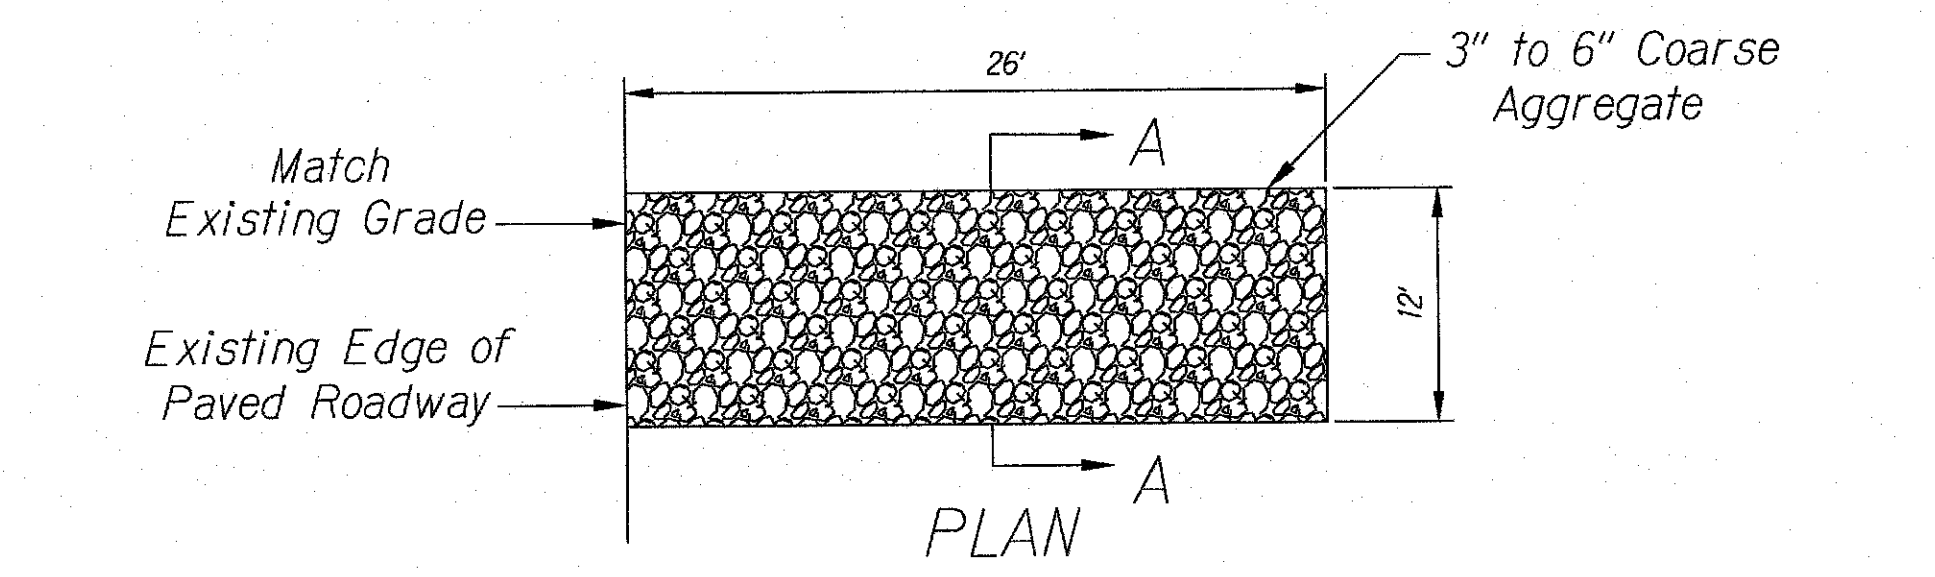



FED. ROAD DIST. NO.	STATE	FED. AID PROJ. NO.	FISCAL YEAR	SHEET NO.	TOTAL SHEETS
HAWAII	HAW.	ER-19(010)	2018	7	10

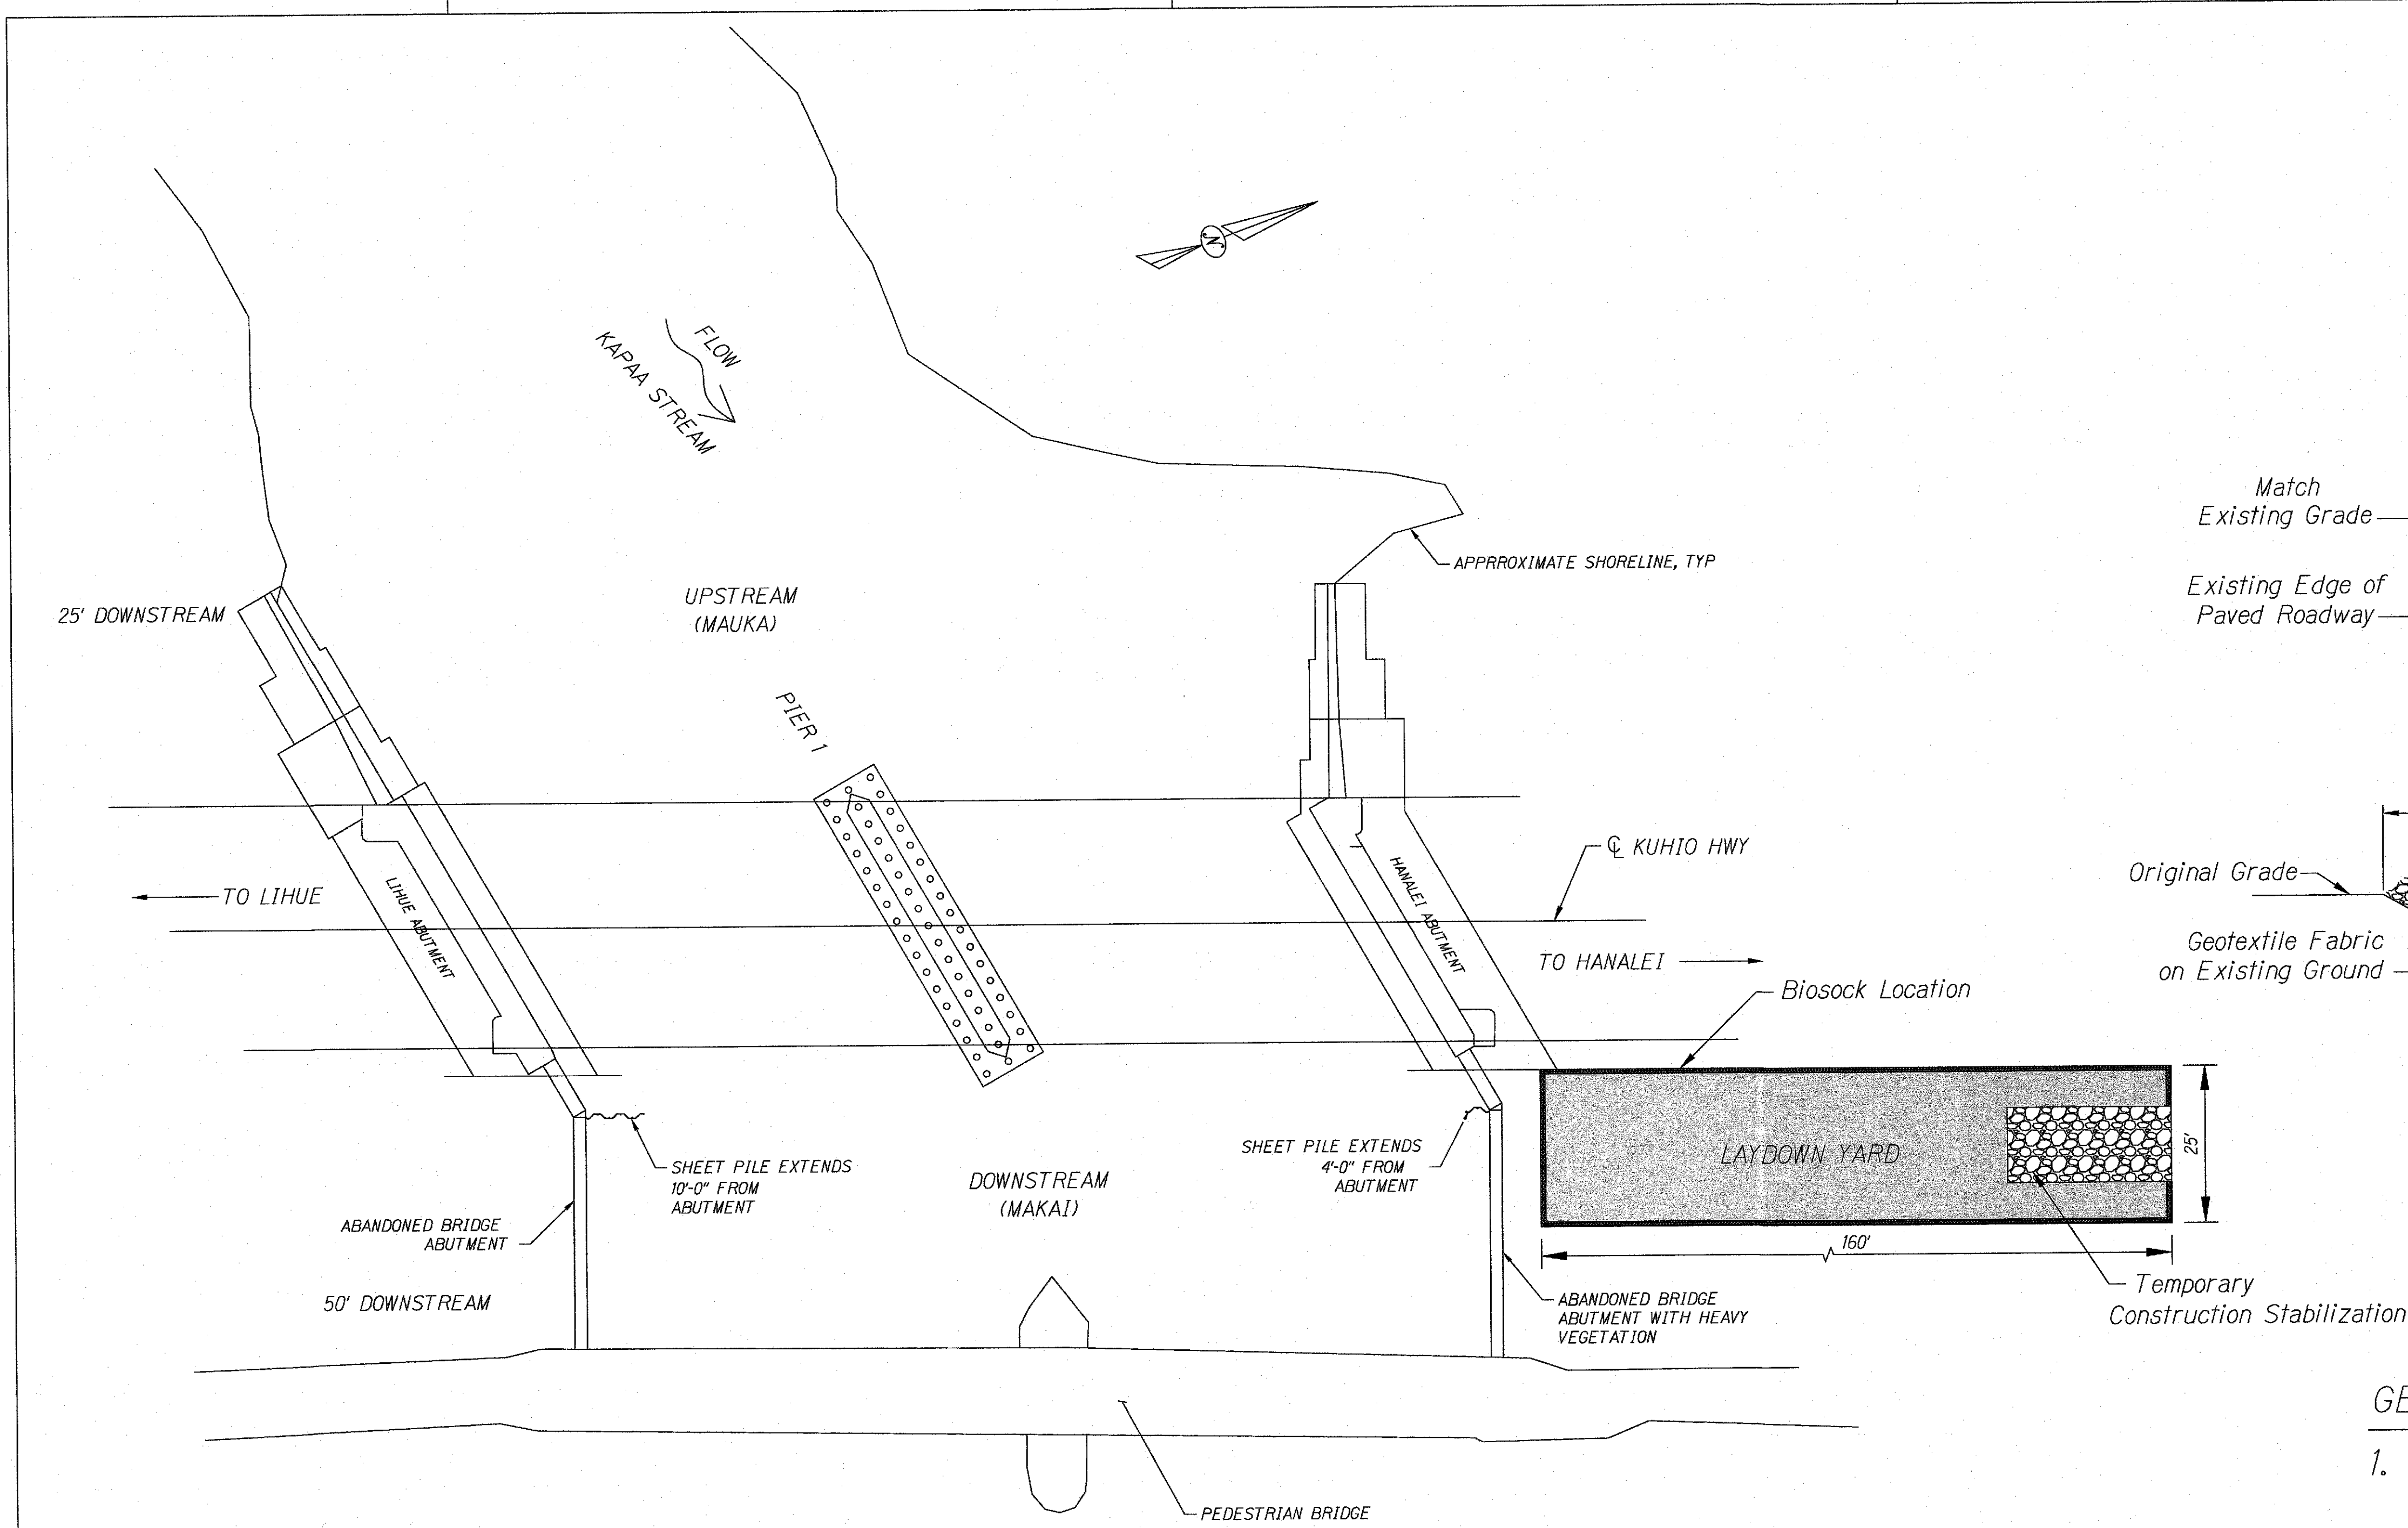

- GENERAL NOTES**
- Contractor shall extend biosock limits to cover full length of storage/staging areas at no additional cost to the State. Biosocks shown on plans are minimum.
  - No vehicles, equipment, or material shall be stored or parked on the bridge

## AS-BUILT DRAWING

- BIOSOCK COMPOST FILTER SOCK NOTES:**
- Remove accumulated sediment when the depth reaches 1/3 of the barrier height.
  - Biosock material and compost shall be removed at the completion of construction and shall be disposed of properly.
  - No staking is required for slopes < 4:1.
  - Compost shall not contain biosolids and should be consistent with United States Environmental Protection Agency guidelines.

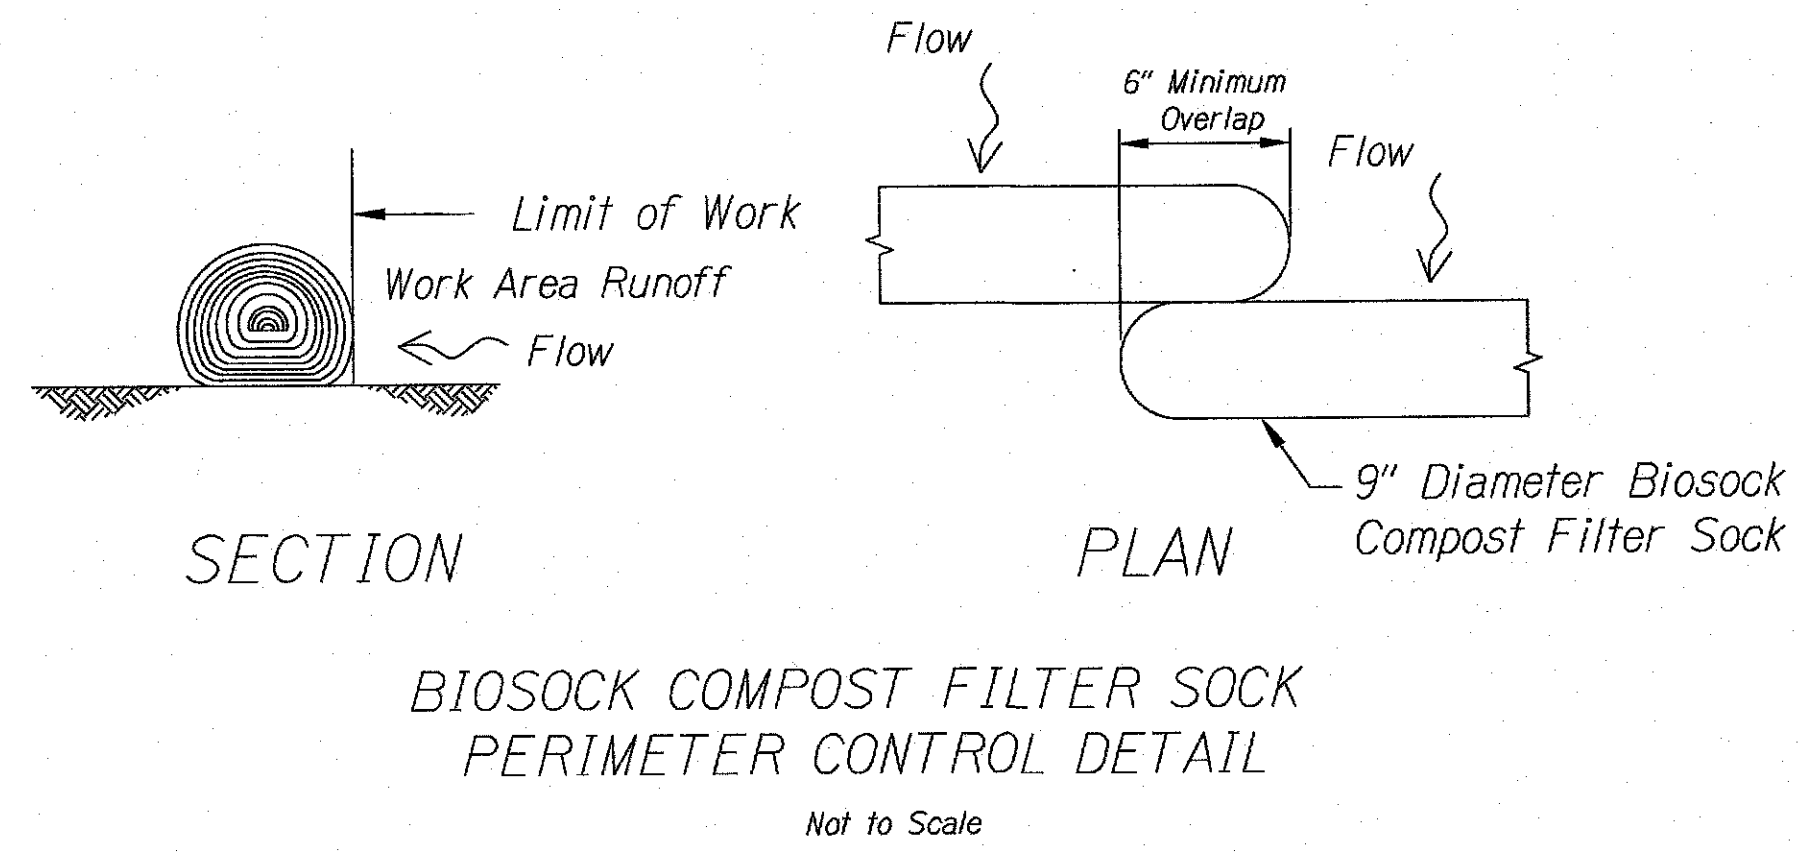

THIS WORK WAS PREPARED BY ME OR UNDER MY SUPERVISION.

SIGNATURE: *James I. Kincaid* EXPIRATION DATE OF THE LICENSE: \_\_\_\_\_

STATE OF HAWAII  
DEPARTMENT OF TRANSPORTATION  
HIGHWAYS DIVISION

**BIOSOCK & TEMPORARY  
CONSTRUCTION STABILIZATION DETAIL**

KAPAA STREAM  
SCOUR COUNTERMEASURES

Proj. No. ER-19(010)

Scale: None Date: Oct. 26, 2018

SHEET No. 7 OF 10 SHEETS

DATE	_____
SURVEY PLOTTED BY	_____
DRAWN BY	_____
CHECKED BY	_____
NOTED BY	_____
QUANTITIES BY	_____
CHECKED BY	_____
ORIGINAL PLAN	_____
NOTE BOOK	_____
NO.	_____