


FED. ROAD DIST. NO.	STATE	FED. AID PROJ. NO.	FISCAL YEAR	SHEET NO.	TOTAL SHEETS
HAWAII	HAW.	ER-19(010)	2018	10	10

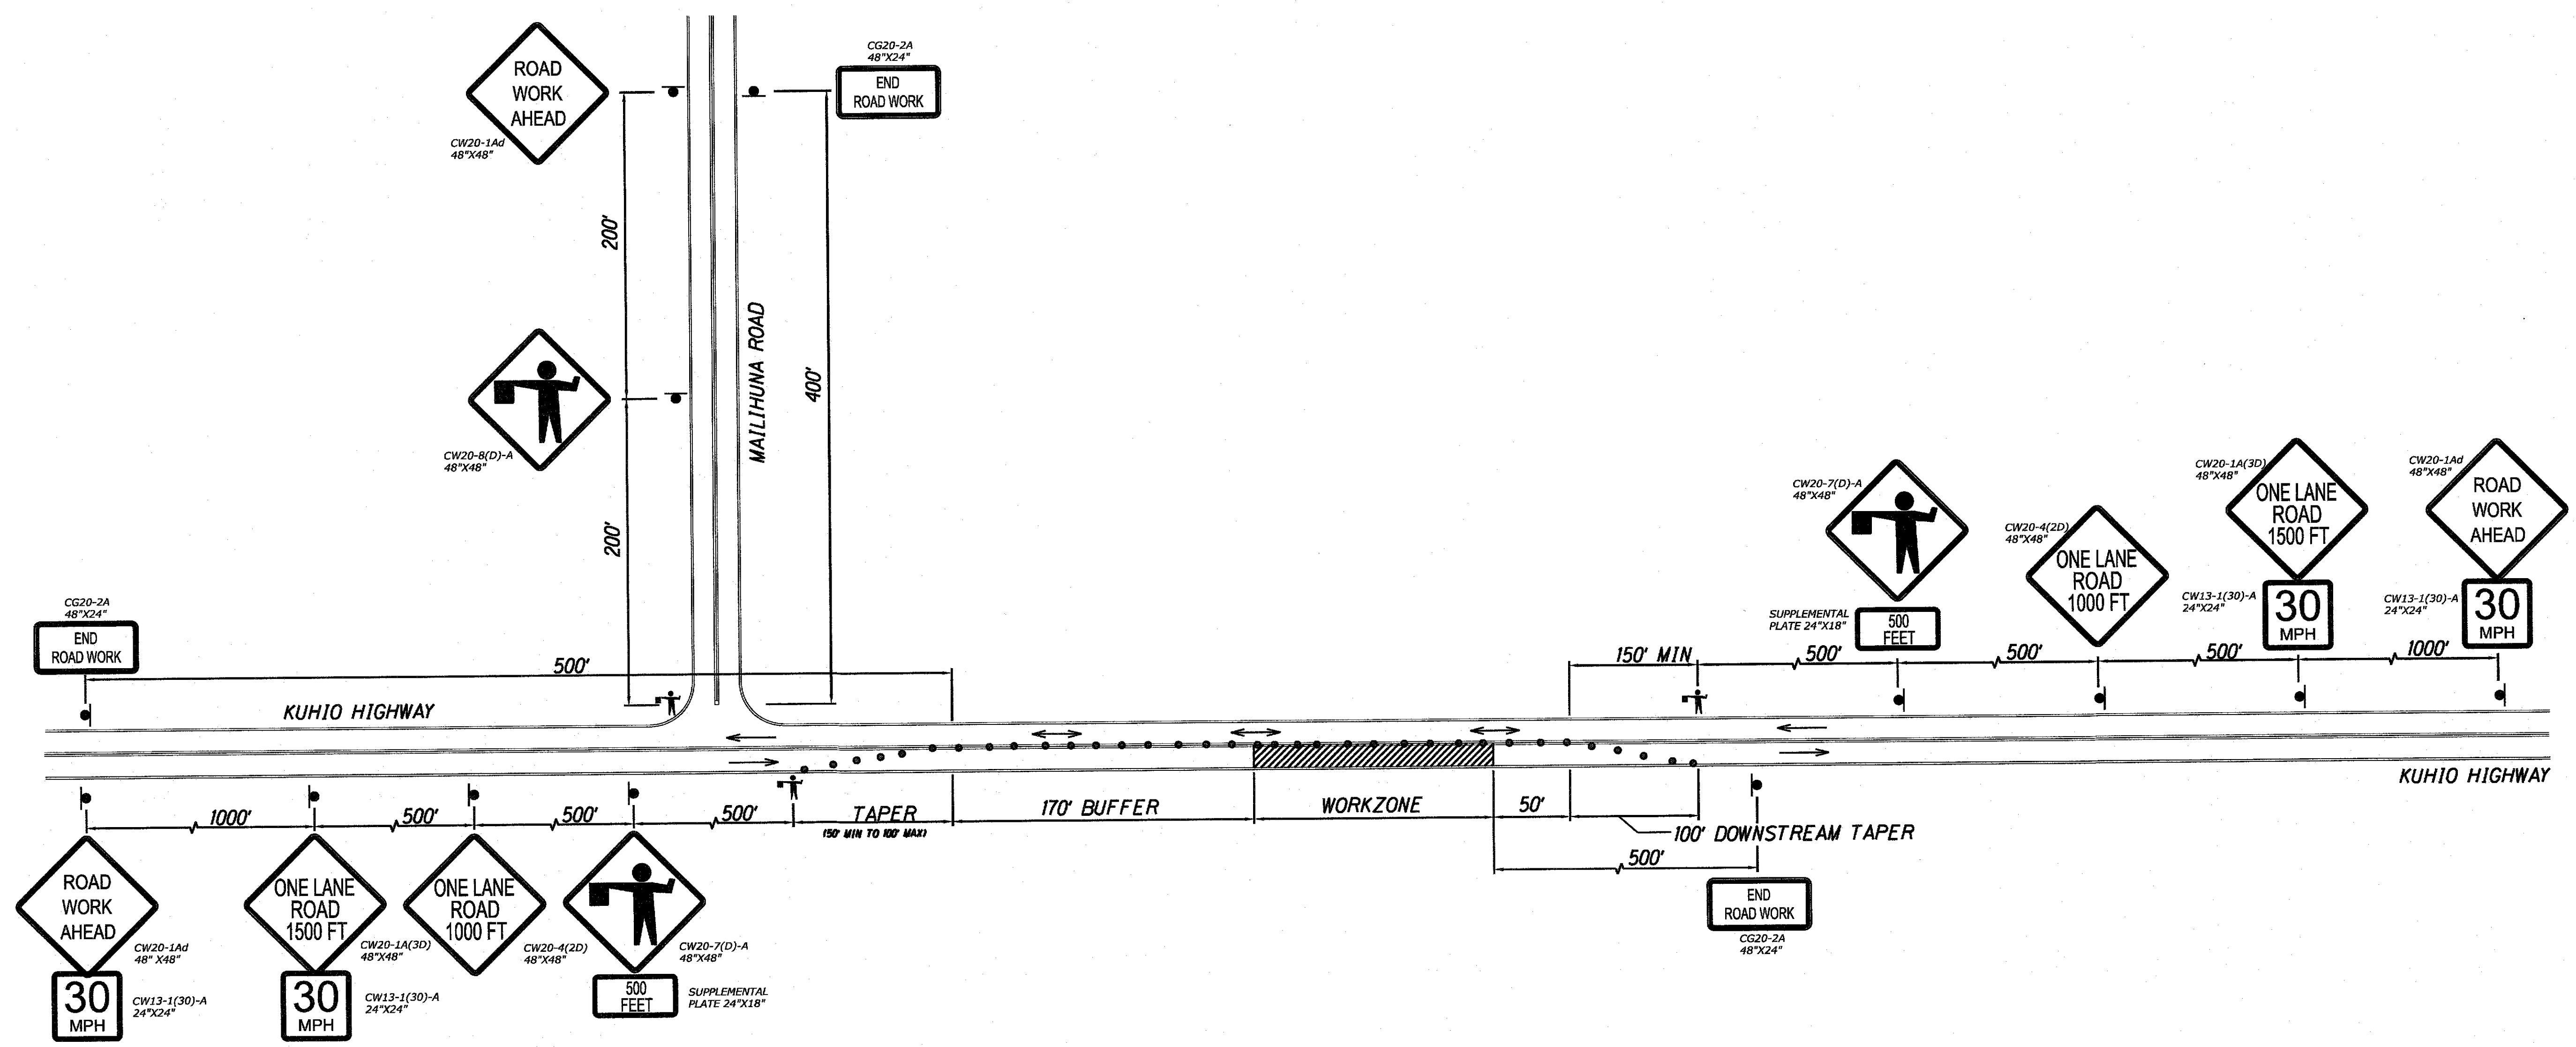

THREE FLAGGER OPERATION ON A TWO-LANE ROAD
KAPAA STREAM BRIDGE (POSTED SPEED = 40MPH)

AS-BUILT DRAWING

ORIGINAL PLAN	SURVEY PLOTTED BY	DATE
NOTED BY	DRAWN BY	
CHECKED BY	QUANTITIES BY	

THIS WORK WAS PREPARED BY ME OR UNDER MY SUPERVISION.
SIGNATURE: *James I. Kincaid* EXPIRATION DATE OF THE LICENSE: _____

STATE OF HAWAII
DEPARTMENT OF TRANSPORTATION
HIGHWAYS DIVISION

TRAFFIC CONTROL PLAN
KAPAA STREAM
SCOUR COUNTERMEASURES
Proj. No. ER-19(010)

Scale: None Date: Dec 03, 2018

SHEET No. TC-1 OF 10 SHEETS