



| FED. ROAD DIST. NO. | STATE | PROJ. NO. | FISCAL YEAR | SHEET NO. | TOTAL SHEETS |
|---------------------|-------|-----------|-------------|-----------|--------------|
| HAWAII              | HAW.  | 56A-02-92 | 1993        | 4         | 5            |

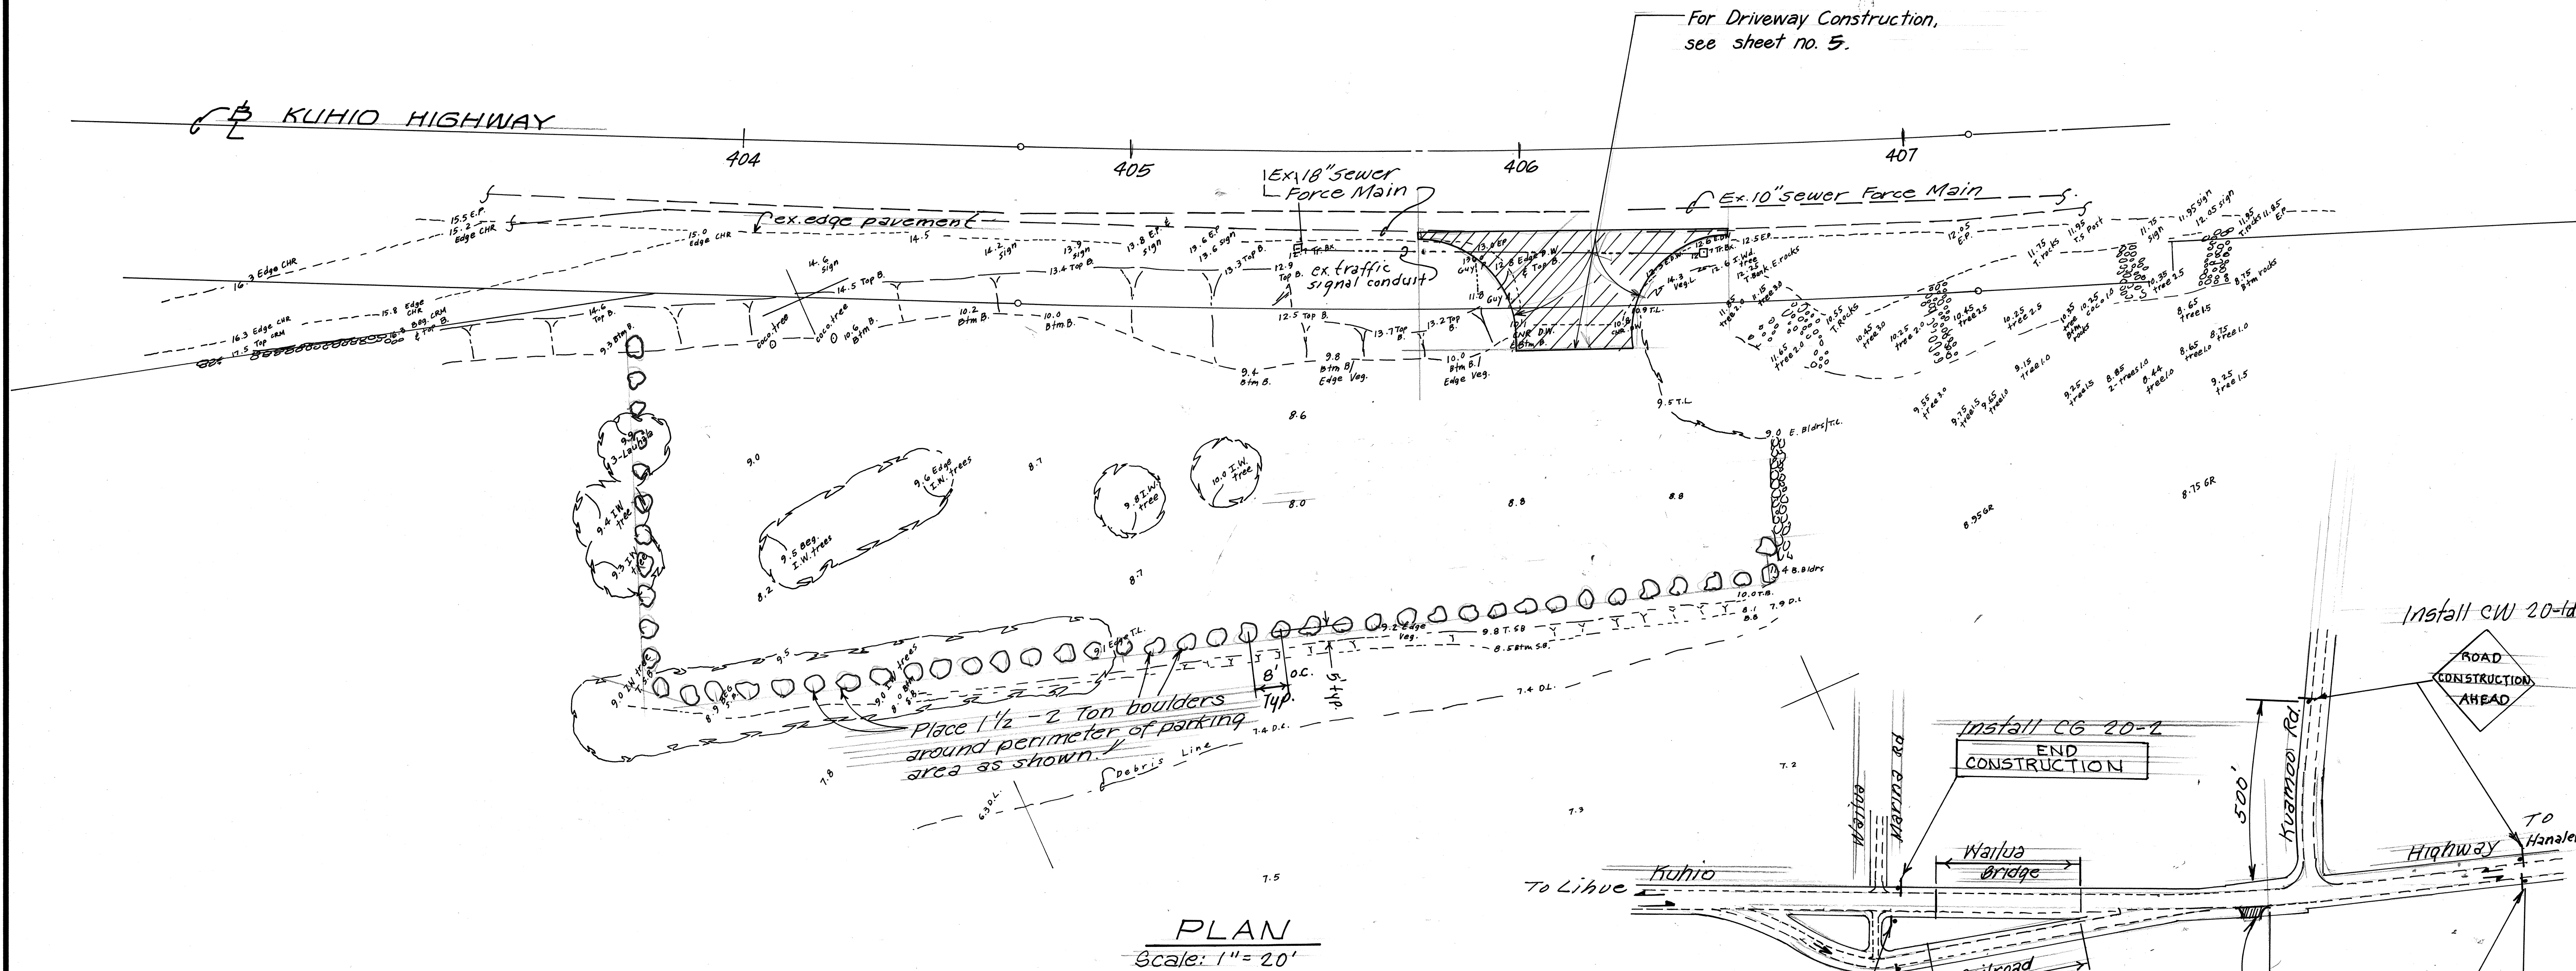


PLAN  
Scale: 1" = 20'

PLAN  
Construction Sign Installation  
N.T.S.

|                   |       |
|-------------------|-------|
| DATE              | _____ |
| SURVEY PLOTTED BY | _____ |
| PLAN              | _____ |
| DRAWN BY          | _____ |
| DESIGNED BY       | _____ |
| CHECKED BY        | _____ |
| NO.               | _____ |

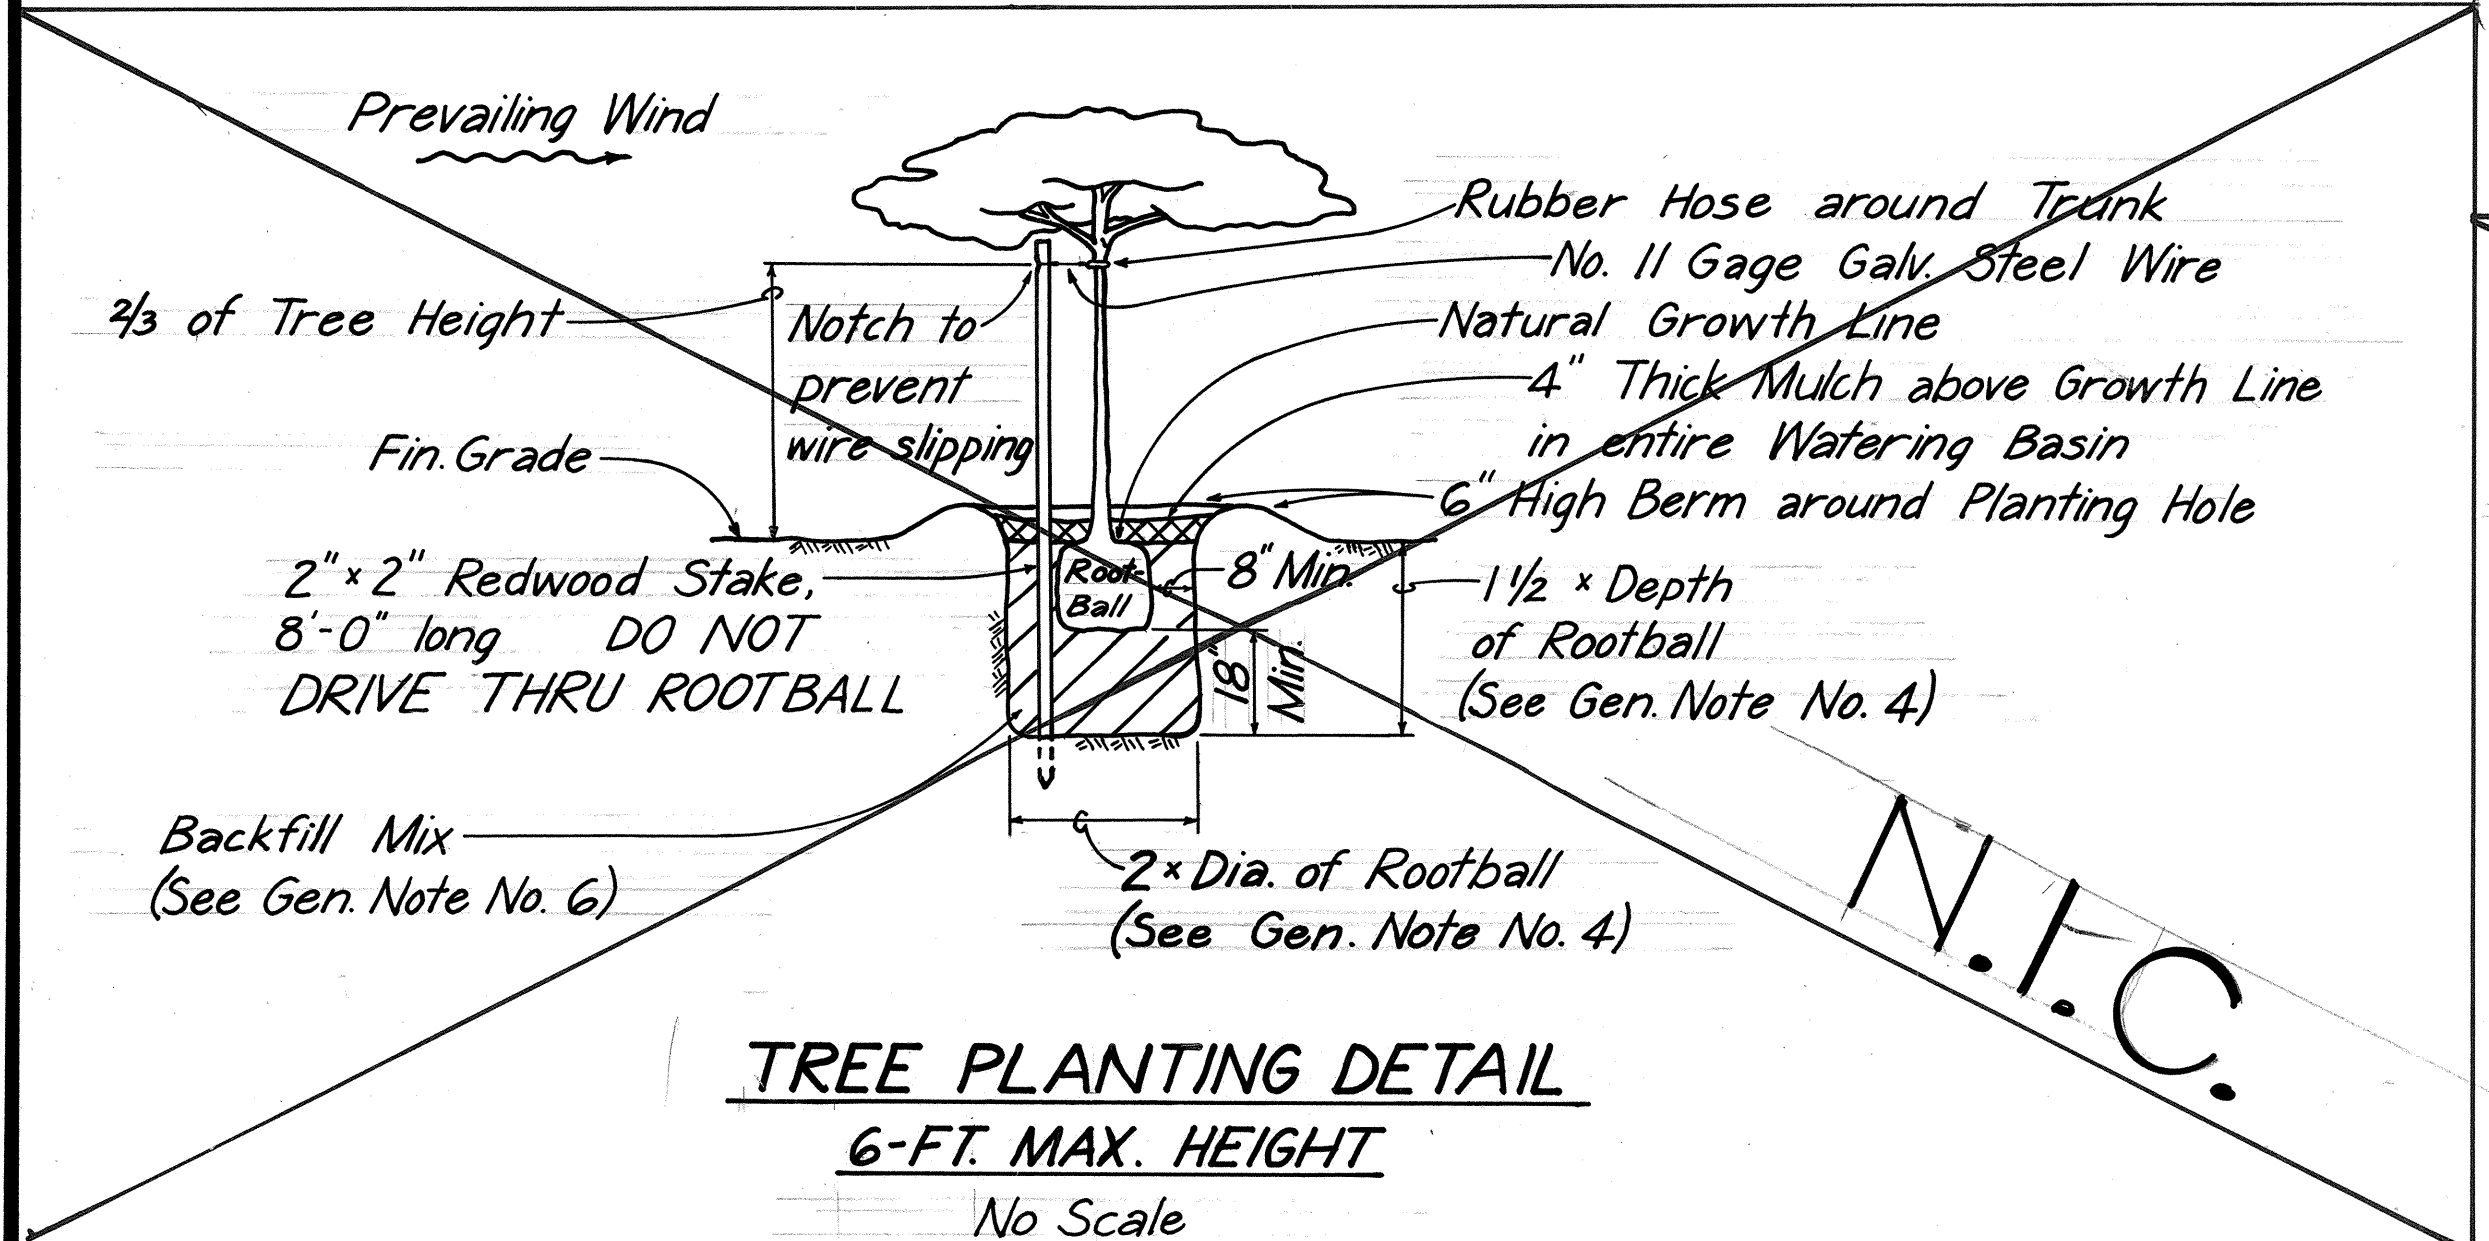

TREE PLANTING DETAIL  
6-FT. MAX. HEIGHT  
No Scale

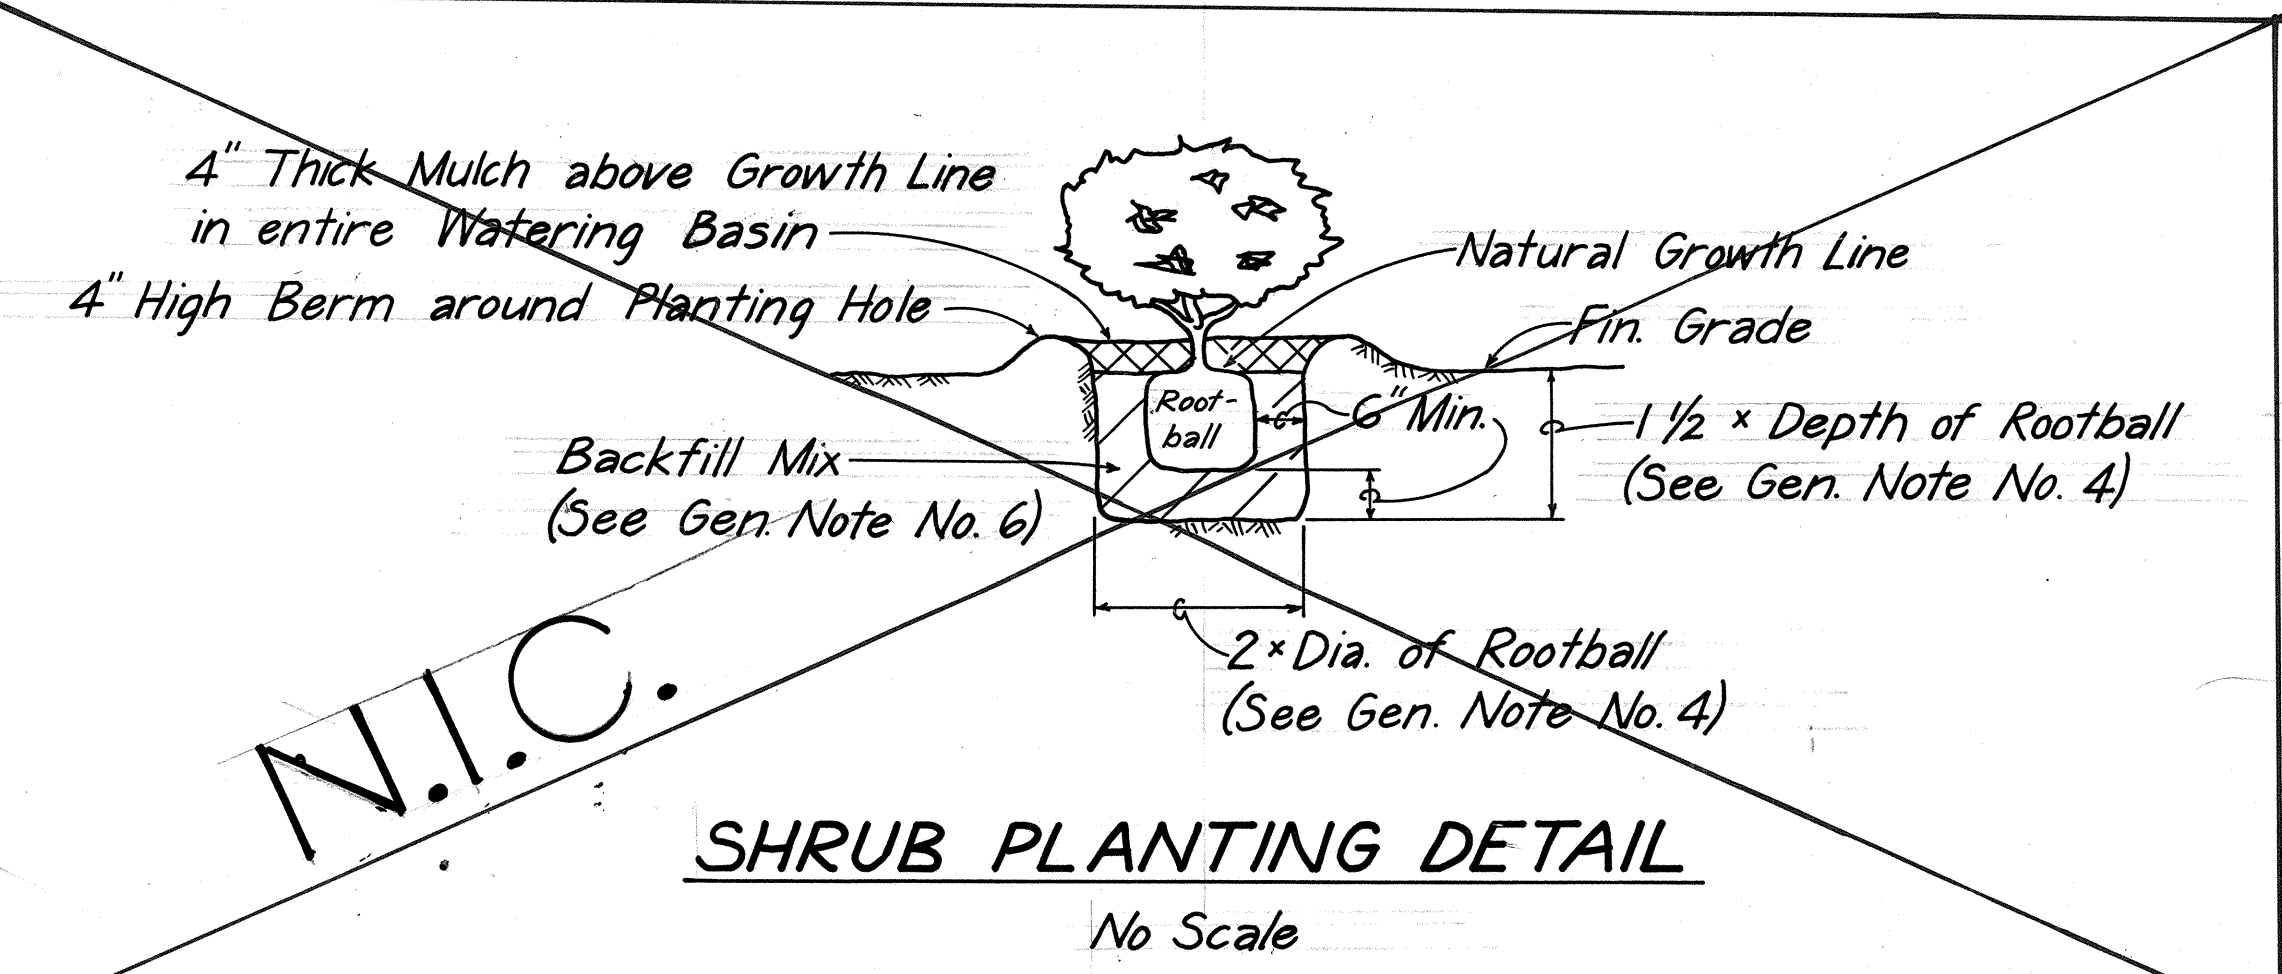

SHRUB PLANTING DETAIL  
No Scale

STATE OF HAWAII  
DEPARTMENT OF TRANSPORTATION  
HIGHWAYS DIVISION

### PLAN

KUHIO HIGHWAY SAFETY IMPROVEMENTS  
VICINITY OF COCO PALMS HOTEL  
PROJECT NO. 56A-02-92  
SCALE: AS SHOWN JAN. 1992  
SHEET NO. 1 OF 4 SHEETS