	INDEX TO DRAWINGS
SHEET NO.	
	TITLE SHEET
2	STANDARD PLANS
3	GENERAL NOTES
4	PLAN
5	STRIPING PLAN & DETAILS
neumata kinjenteka kinjenja ki kinjenja se na pri neumata kinjeni di se se t	

energia de la que que se esta de la composição de la comp	
Name of the second	
· · · · · · · · · · · · · · · · · · ·	
*	
alie alie alie alie alie alie alie alie	시도 하는 보고 마이트 경기 되었다. 경기에 보는 사람들이 되었다. 그리고 있는 것이 되었다. 된 경기 기업적 기계를 보통하고 있었다. 기업 전체 시간 이 보는 사람들이 모르는 것이 되었다.
	에 가지 있다. 그 시간 이 경험 교육하고 있는 것이다. 생물 기술 시간 전략 전략 전략 전략 기술
· · ·	

STATE OF HAWAII


DEPARTMENT OF TRANSPORTATION

HIGHWAYS DIVISION
HONOLULU, HAWAII
"AS-BUILT"
PLANS FOR

KUHIO HIGHWAY SAFETY IMPROVEMENTS VICINITY OF COCO PALMS HOTEL


PROJECT NO. 56A-02-92


DISTRICT OF KAWAIHAU
ISLAND OF KAUAI

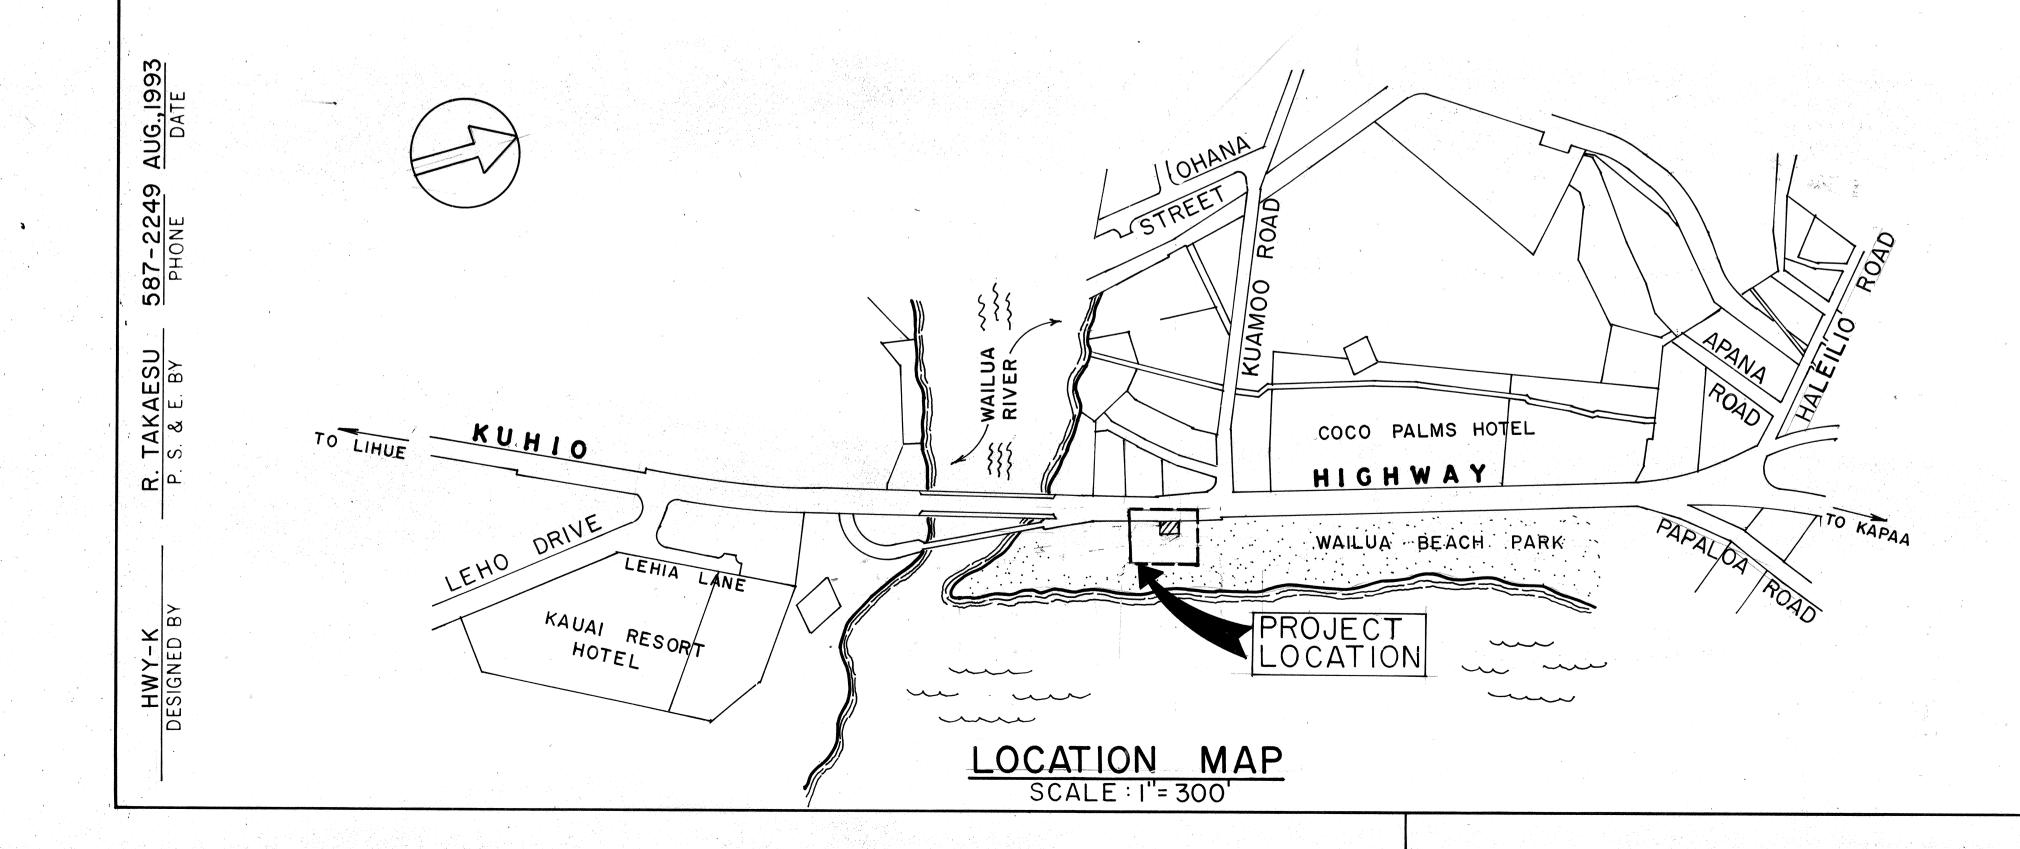

FED. ROAD DIST. NO. STATE PROJ. NO. FISCAL SHEET TOTAL YEAR NO. SHEETS

HAWAII HAW. 56A-02-92 1993 1 5

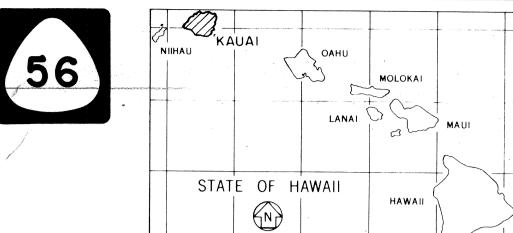

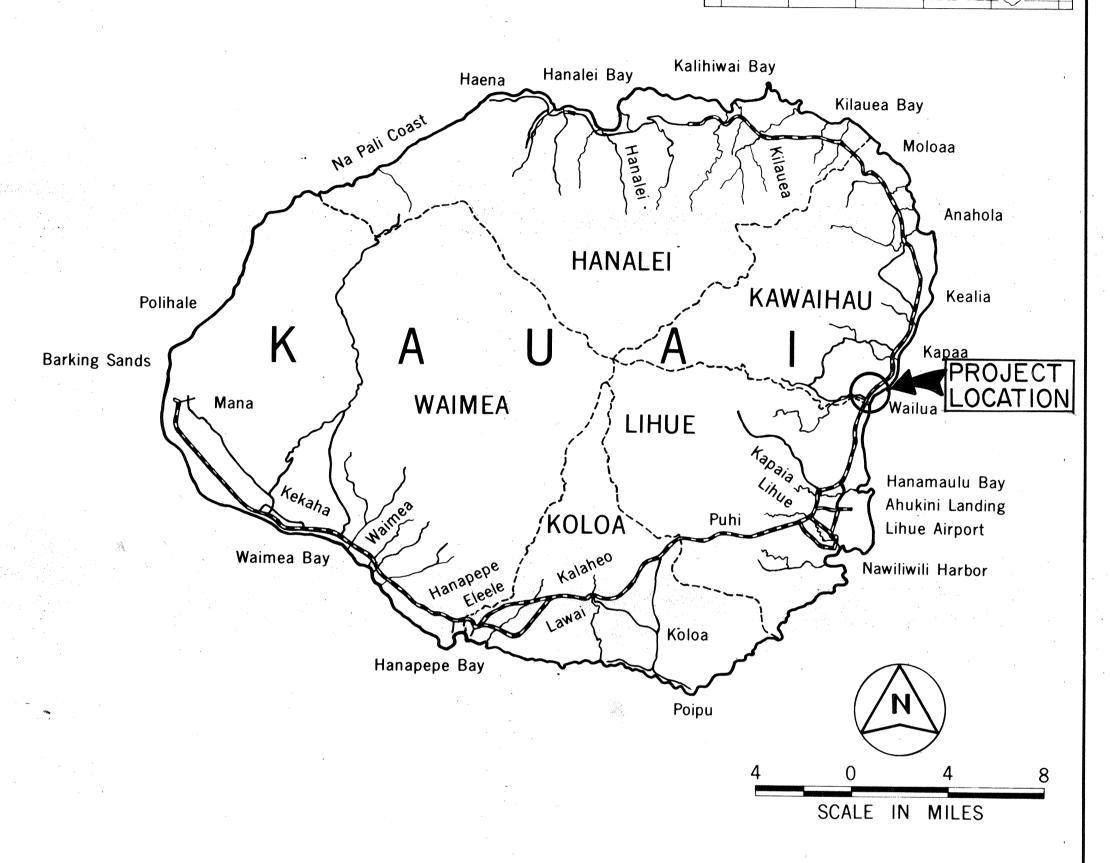


FEDERAL AID PROJECTS PREVIOUSLY CONSTRUCTED OR UNDER CONSTRUCTION

MILE POST 5.92 TO MILE POST 5.93

CHANGES MADE DURING CONSTRUCTION HAVE BEEN INCORPORATED ON THESE PLANS EXCEPT CHANGES IN THE ORIGINAL THEORETICAL QUANTITIES. FOR ACTUAL QUANTITIES, REFER TO PROJECT LEDGER AND/OR COMPUTATION BOOK.

RESIDENT ENGINEER

6/14/94 DATE

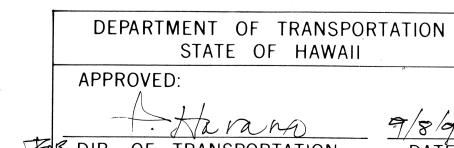

FR DIR. OF TRANSPORTATION