


FED. ROAD DIST. NO.	STATE	FED. AID PROJ. NO.	FISCAL YEAR	SHEET NO.	TOTAL SHEETS
HAWAII	HAW.	ER-23(004), Unit 1	2020	15	15

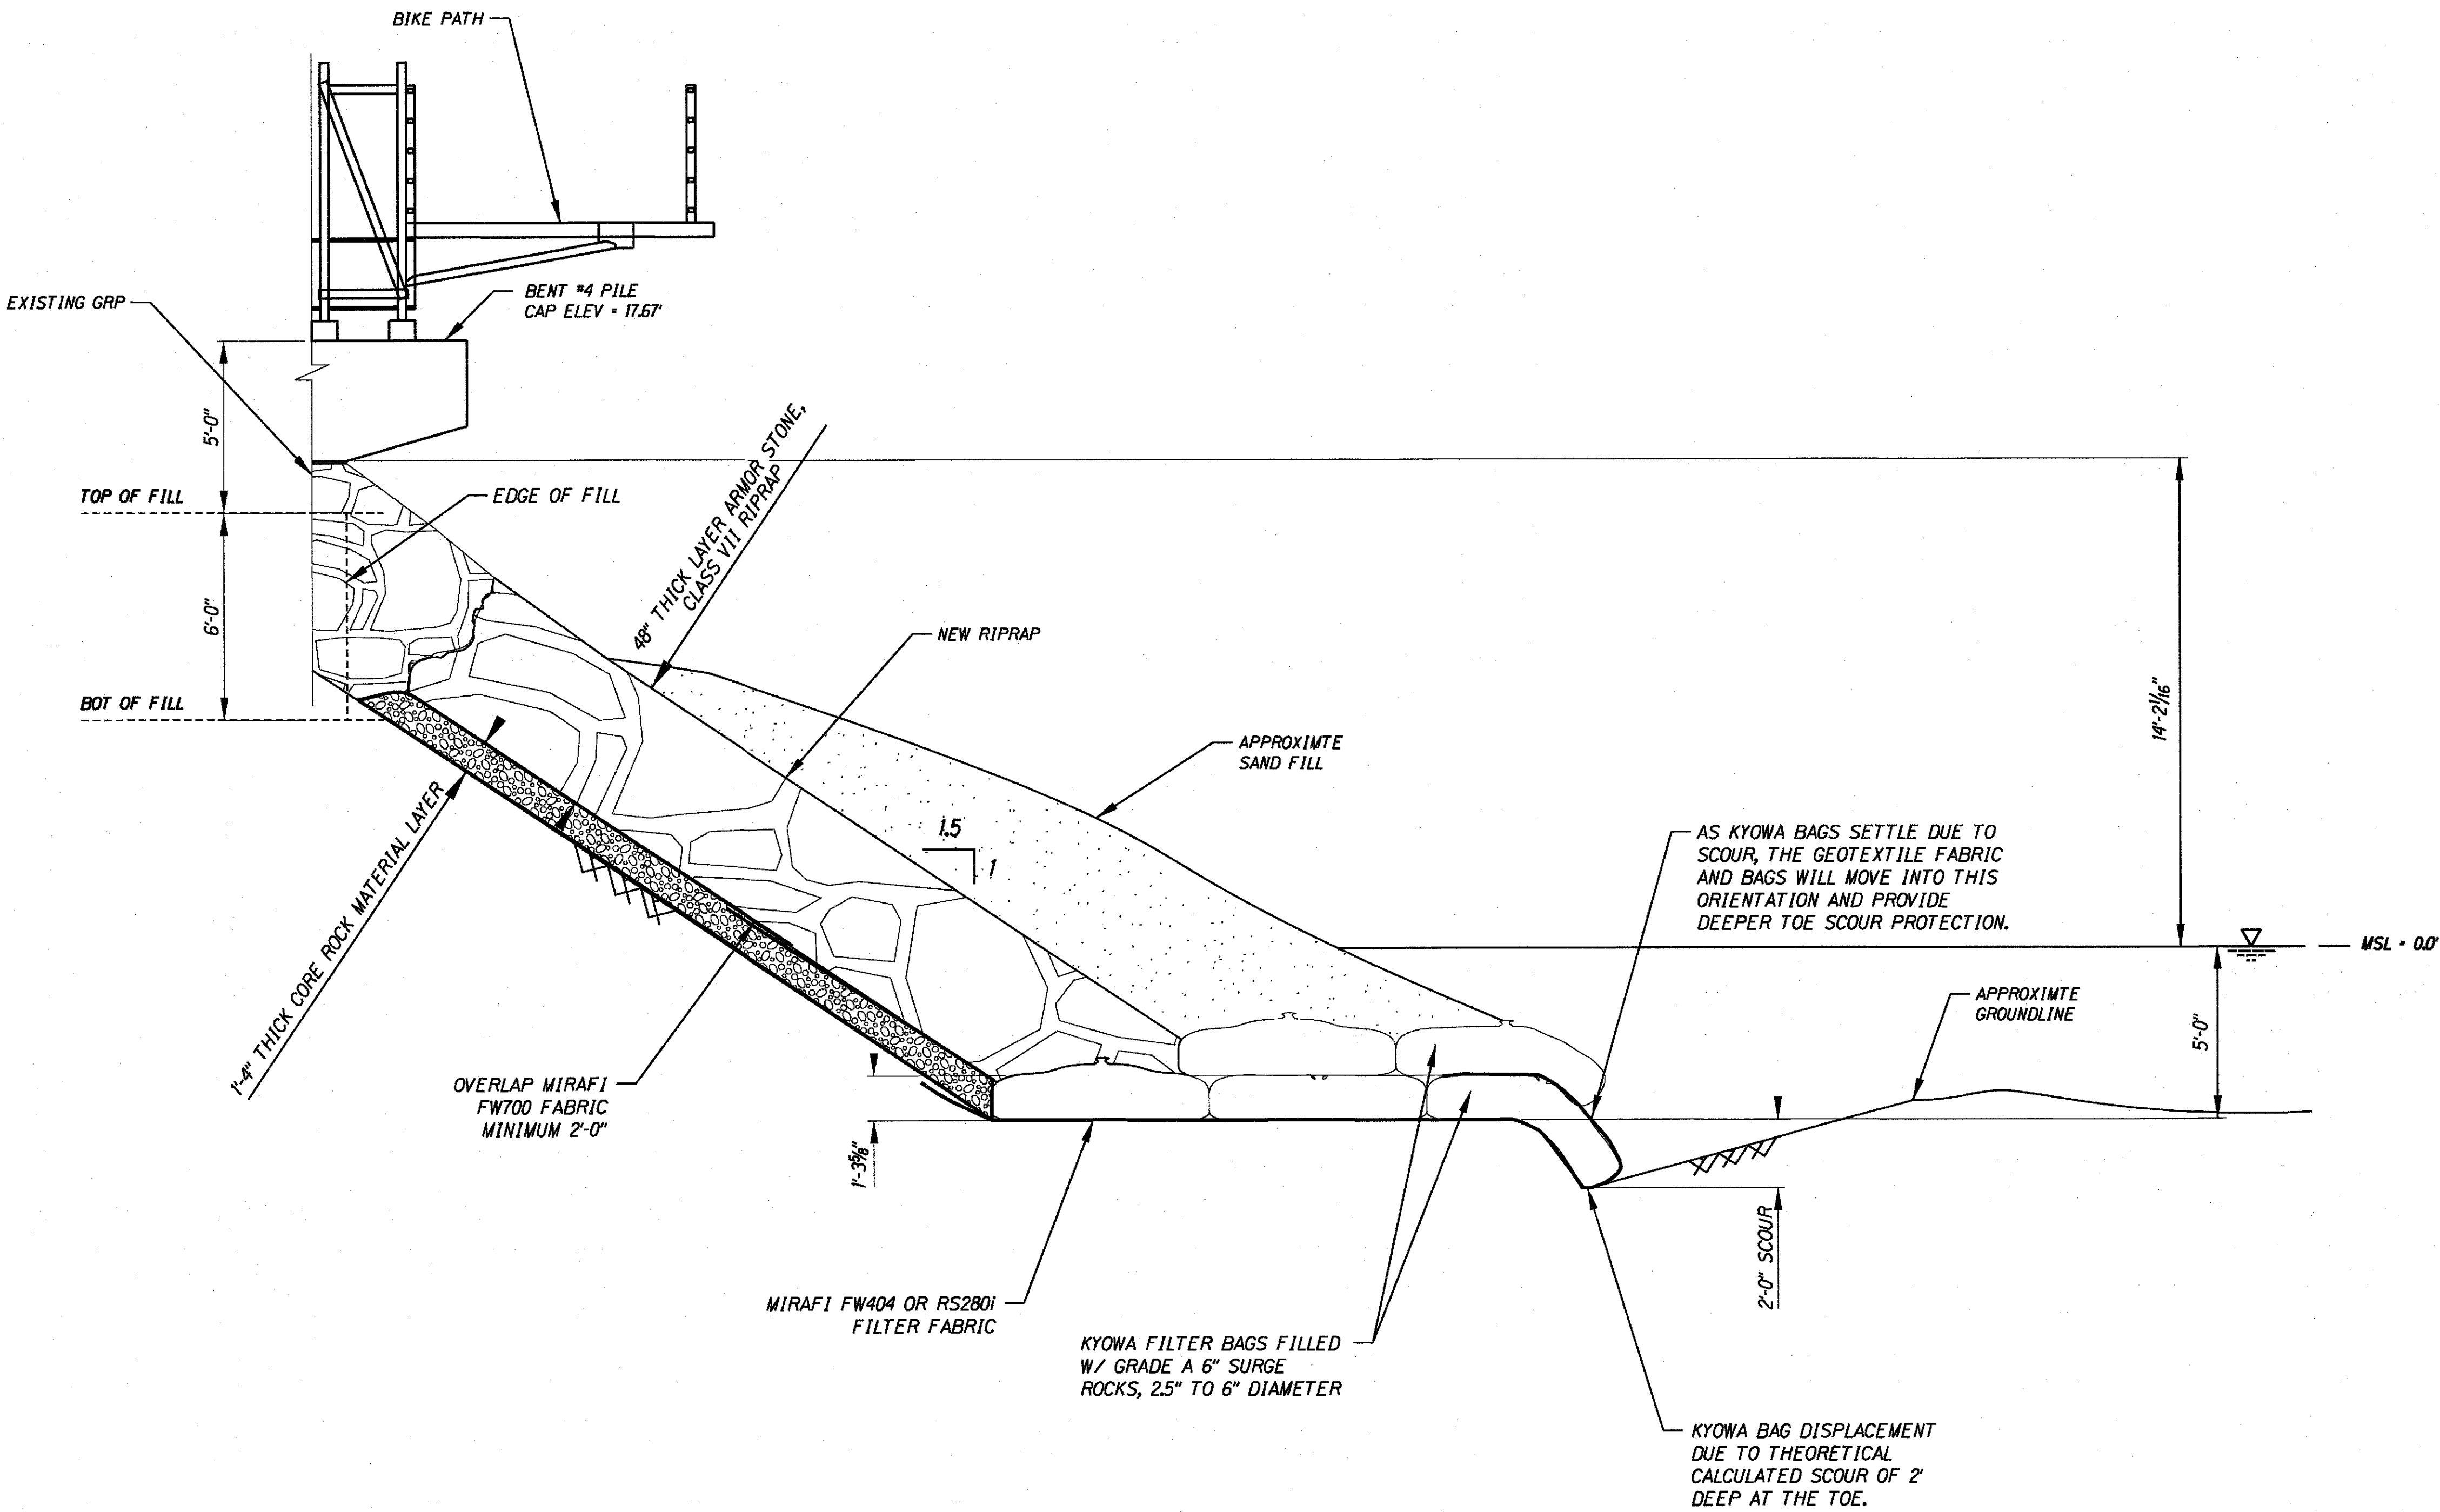

ESTIMATED BAG DISPLACEMENT DUE TO POTENTIAL SCOUR
SECTION D-D
(STA. 0+64.12 TO 1+17.62)

AS-BUILT DRAWING

DESIGNED BY	DATE
DRAWN BY	
CHECKED BY	
IN CHARGE BY	
NOTED BY	
DATE	

THIS WORK WAS PREPARED BY ME OR UNDER MY SUPERVISION.

SIGNATURE: *James I. Kincaid* EXPIRATION DATE: 08/30/2022

STATE OF HAWAII
DEPARTMENT OF TRANSPORTATION
HIGHWAYS DIVISION

**RIPRAP REVETMENT -
ESTIMATED BAG DISPLACEMENT
DUE TO SCOUR**

WAILUA RIVER REVETMENT REPAIRS
Proj. No. ER-23(004), Unit 1
Scale: None Date: AUGUST, 2020

SHEET No. 15 OF 15 SHEETS