


FED. ROAD DIST. NO.	STATE	FED. AID PROJ. NO.	FISCAL YEAR	SHEET NO.	TOTAL SHEETS
HAWAII	HAW.	ER-23(004), Unit 1	2020	14	15

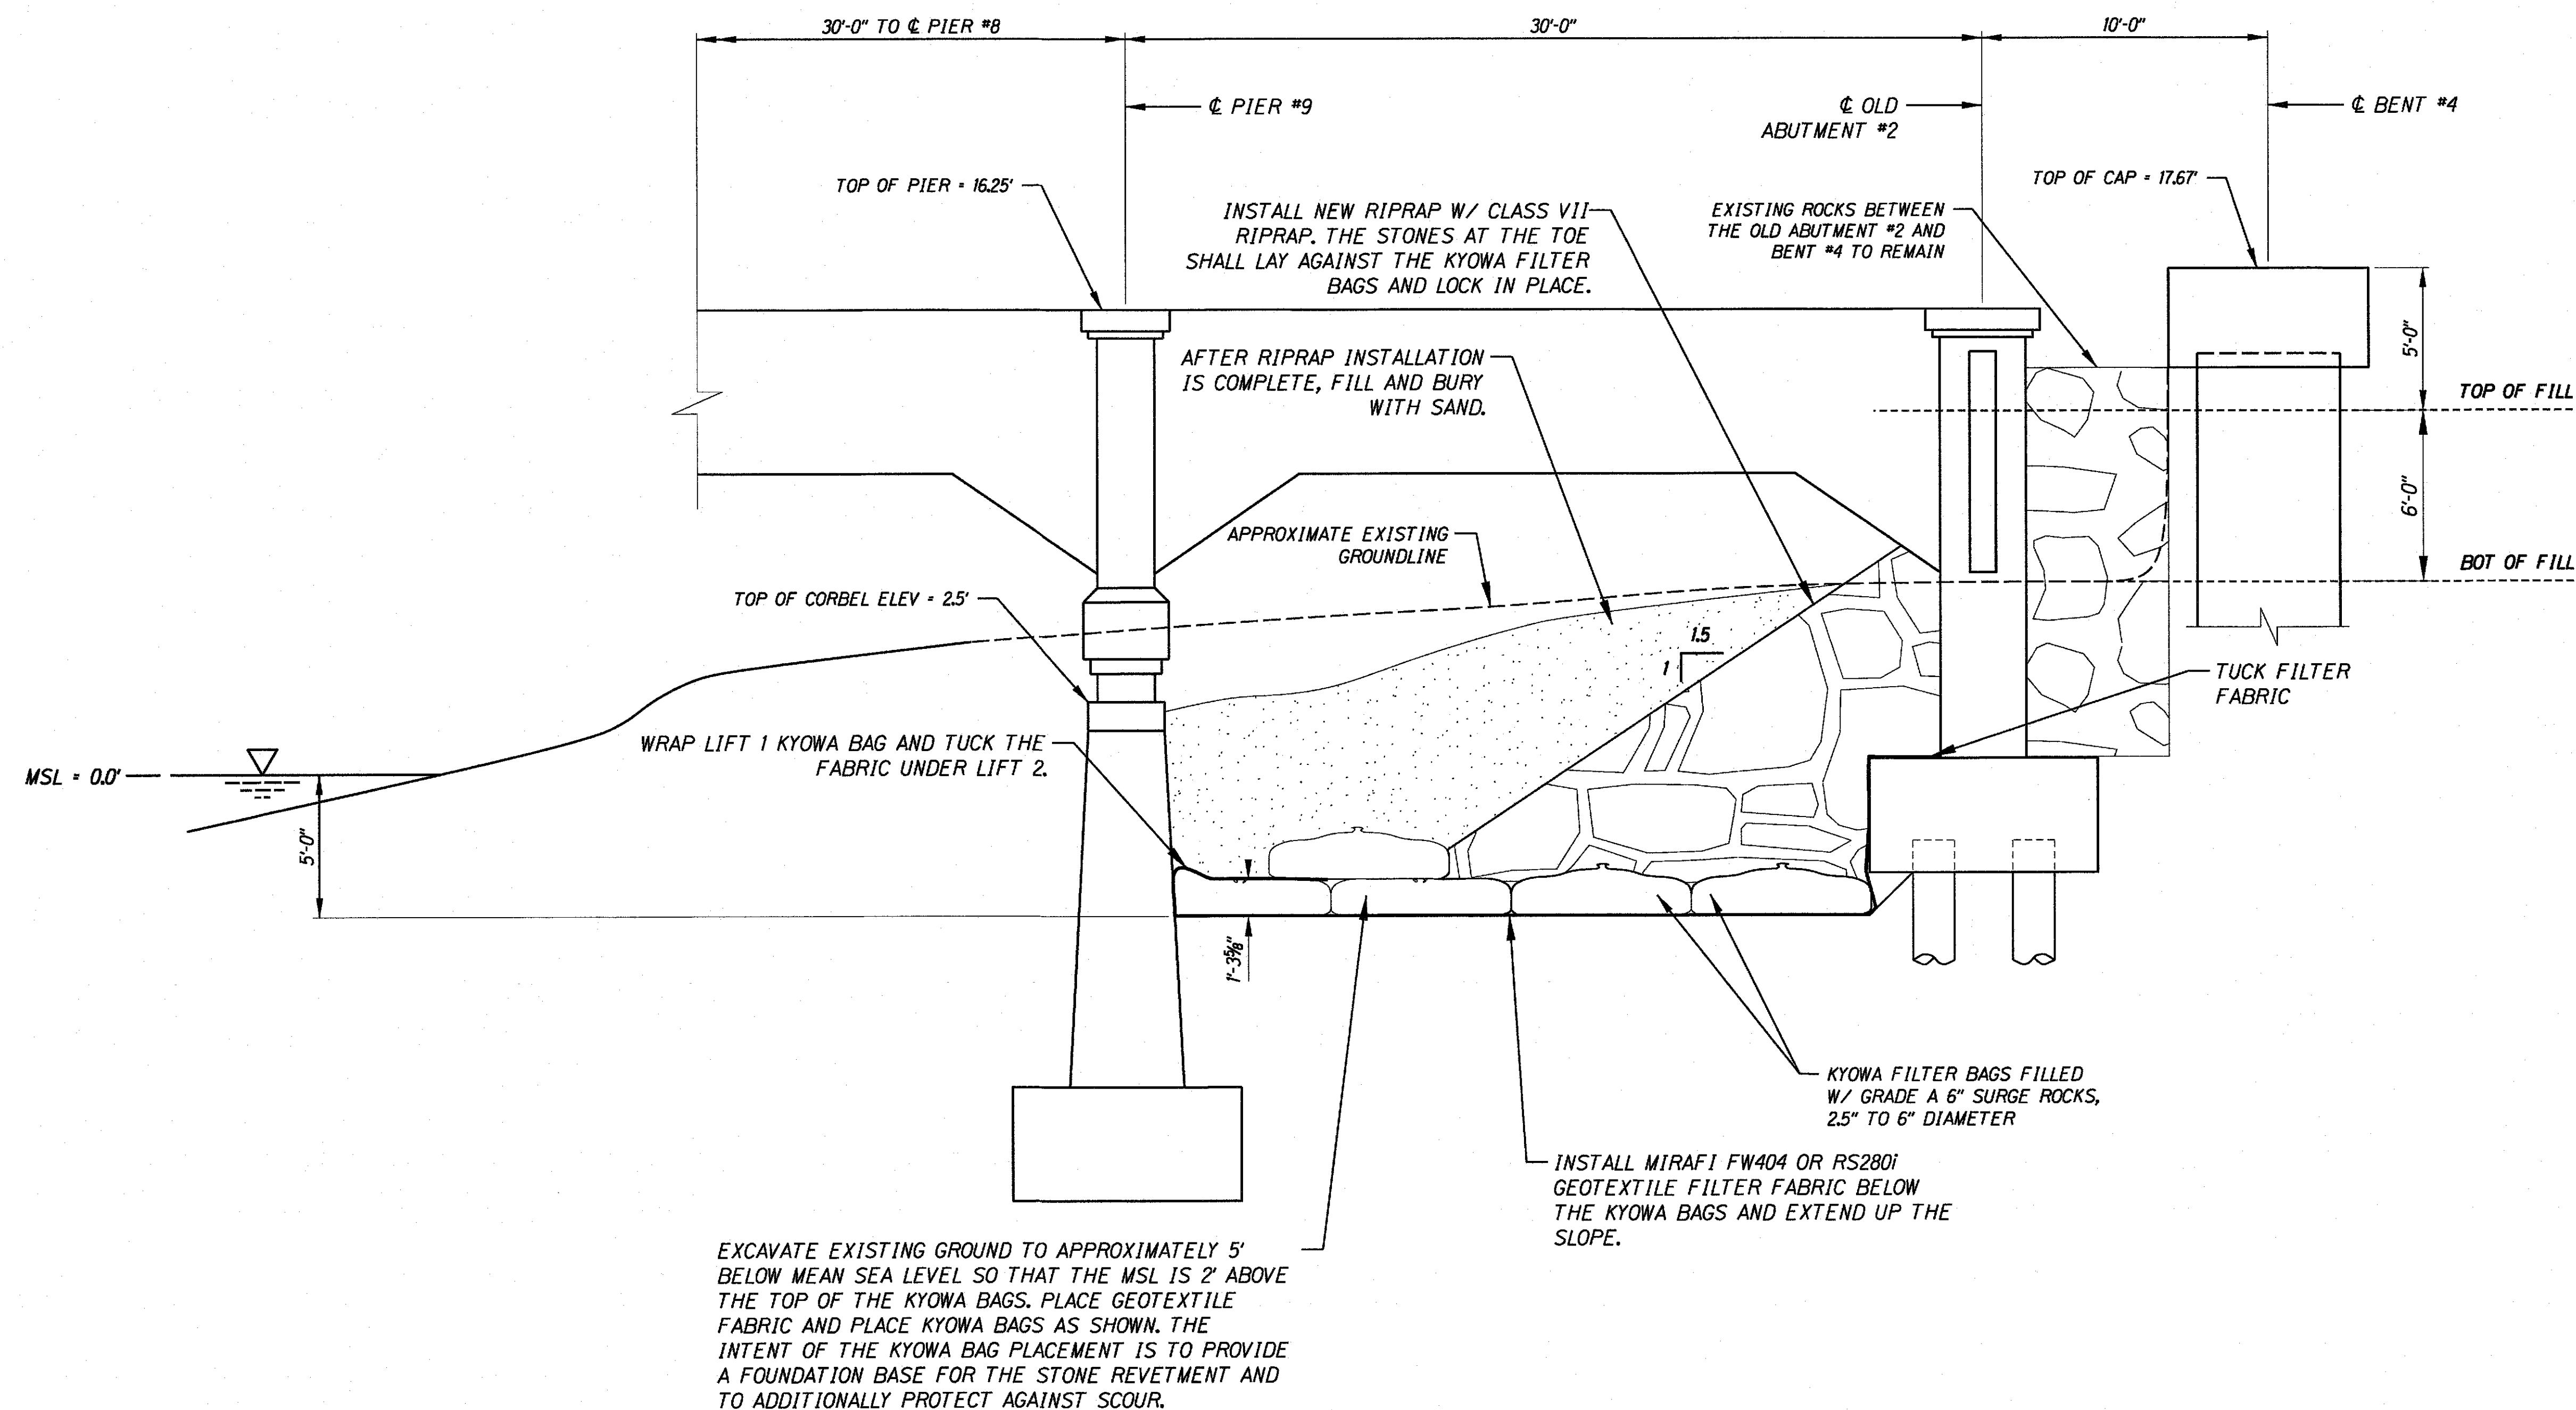

SECTION F-F
(STA 0+22.47 TO 0+34.47)

AS-BUILT DRAWING

ORIGINAL PLAN	DATE
SURVEY PLATTED BY	
DRAWN BY	
DESIGNED BY	
CHECKED BY	
NOTED BY	
IN CHARGE	

<p>THIS WORK WAS PREPARED BY ME OR UNDER MY SUPERVISION.</p> <p>SIGNATURE: <i>James I. Kincaid</i> DATE: APR 30, 2022</p> <p>EXPIRATION DATE OF THE LICENSE:</p>	<p>STATE OF HAWAII DEPARTMENT OF TRANSPORTATION HIGHWAYS DIVISION</p> <p>RIPRAP REVETMENT - RIVER SIDE CROSS SECTION F-F</p> <p>WAILUA RIVER REVETMENT REPAIRS Proj. No. ER-23(004), Unit 1</p> <p>Scale: None Date: AUGUST, 2020</p>
	SHEET No. 14 OF 15 SHEETS