


FED. ROAD DIST. NO.	STATE	FED. AID PROJ. NO.	FISCAL YEAR	SHEET NO.	TOTAL SHEETS
HAWAII	HAW.	ER-23(004), Unit 1	2020	13	15

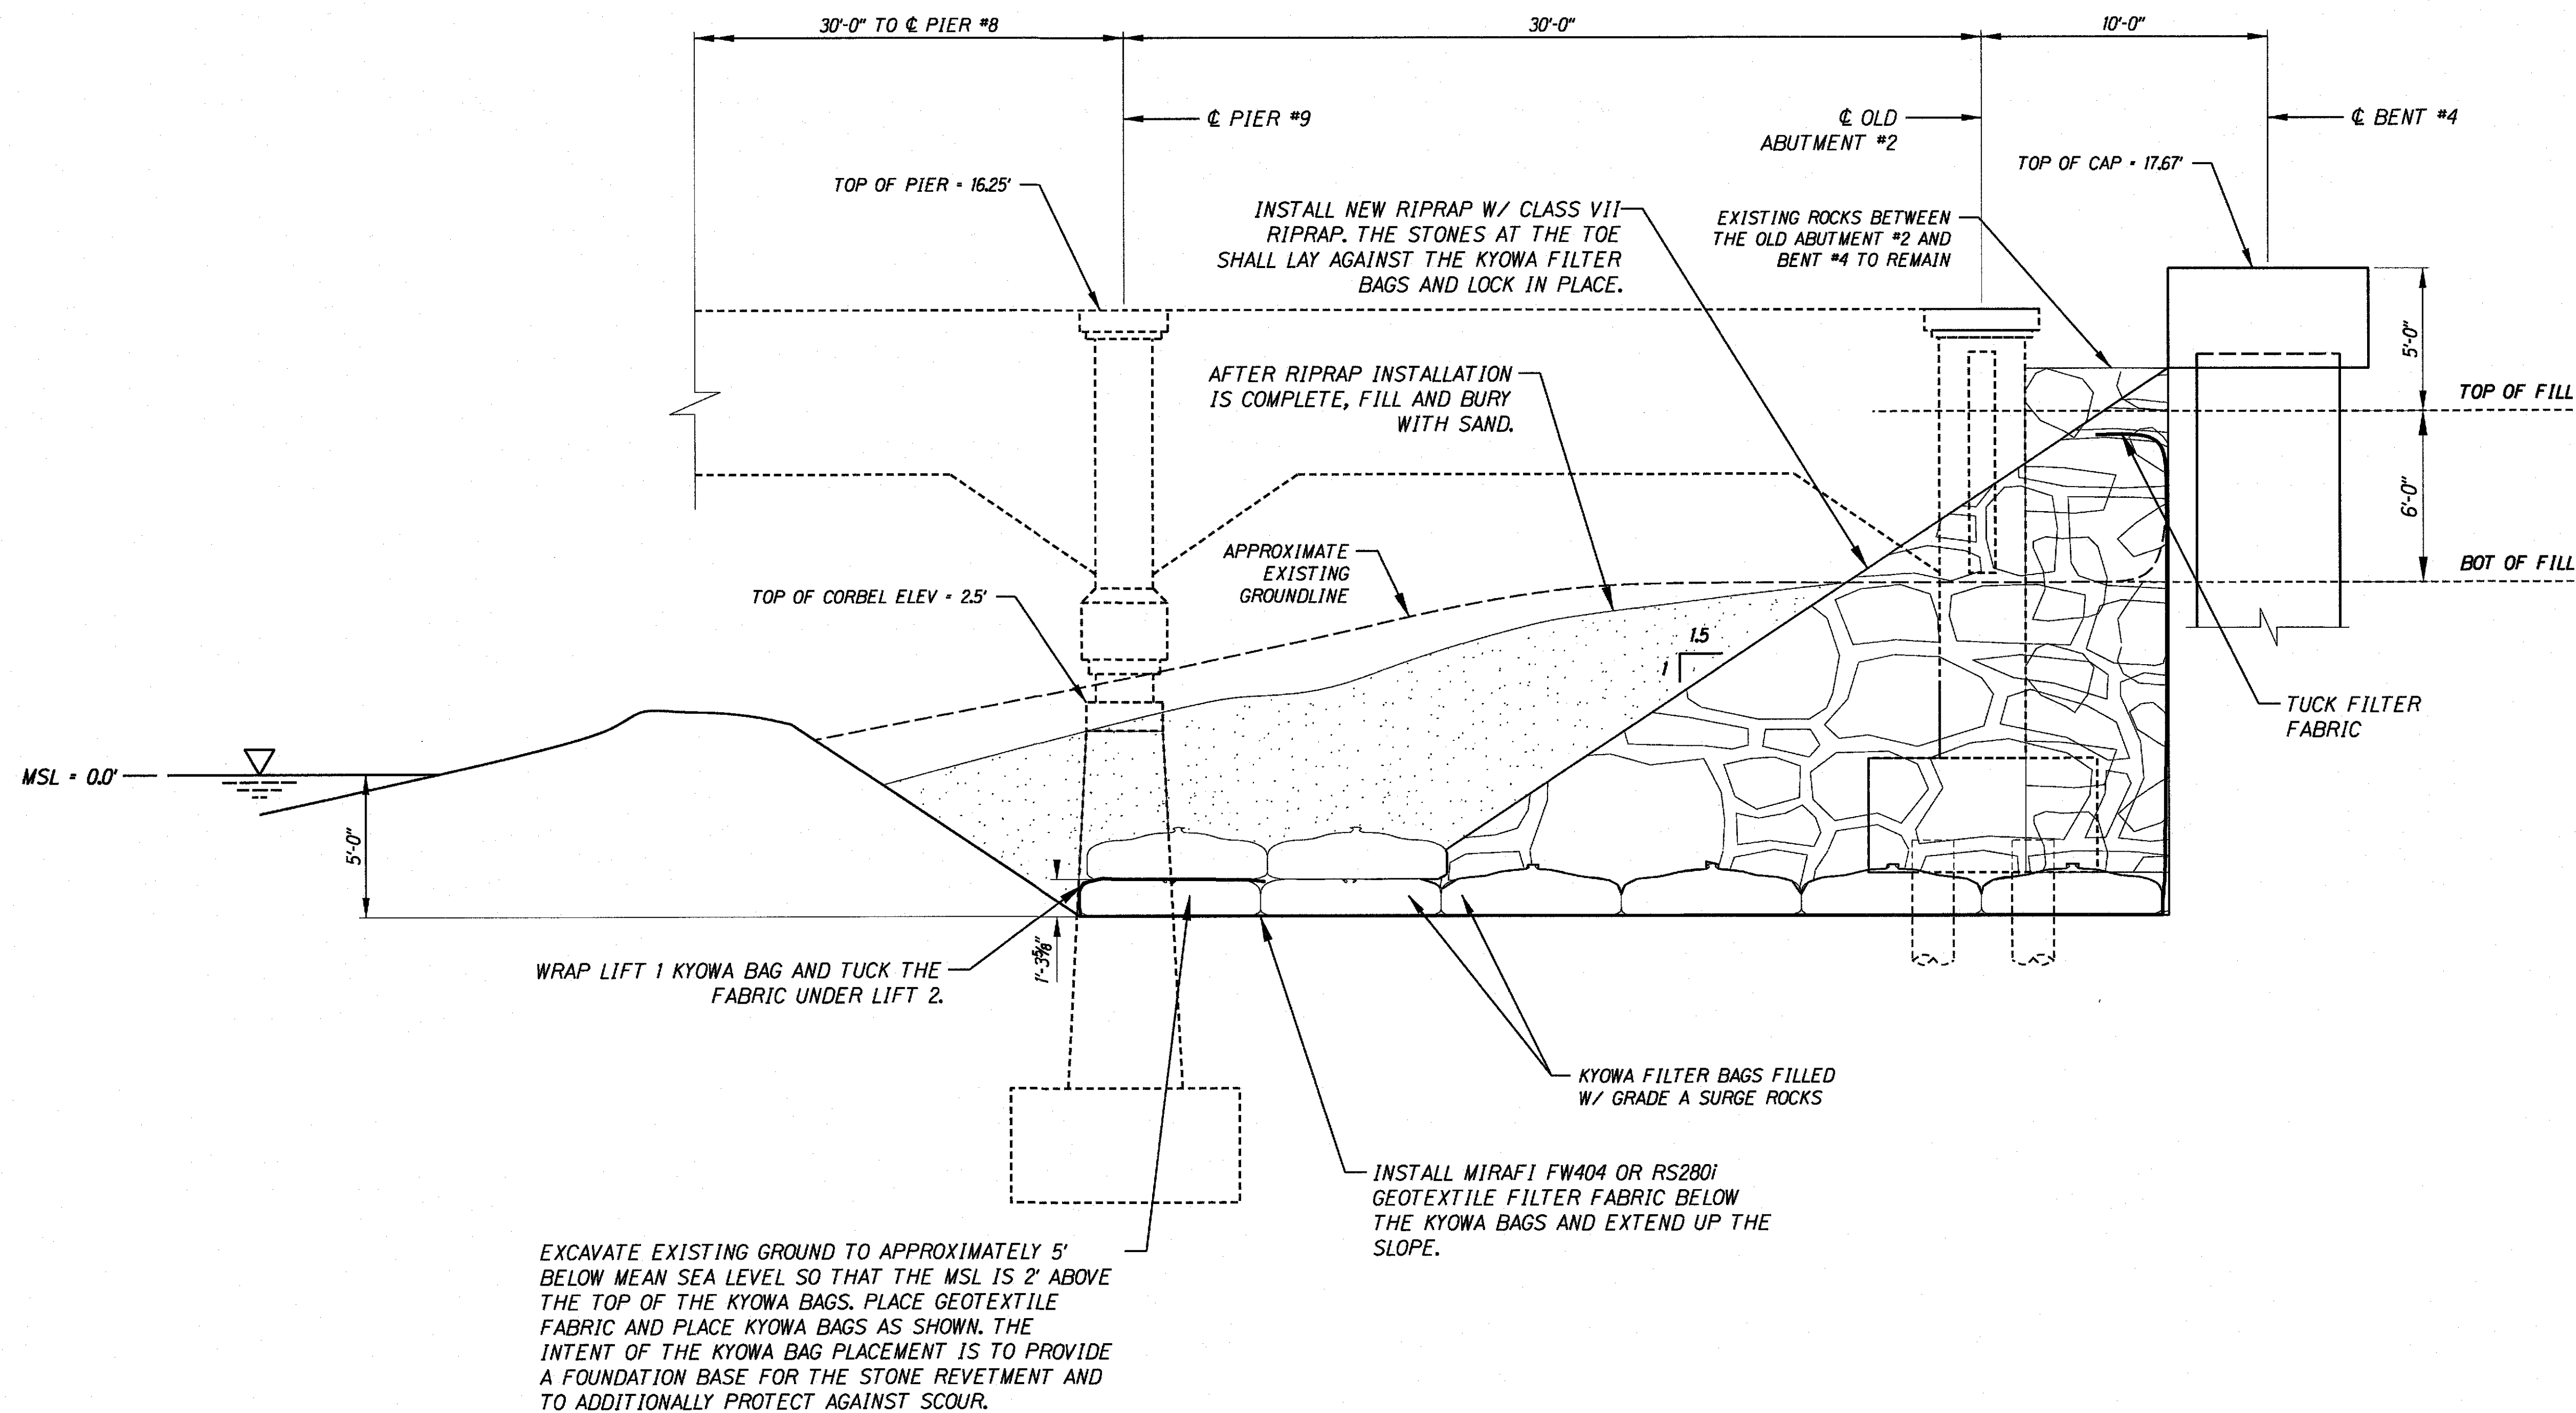

SURVEY PLANNED BY	DATE
DRAWN BY	
DESIGNED BY	
CHECKED BY	
NOTED BY	
DATE	

SECTION E-E
(STA 0+00 TO 0+22.47 & 0+34.47 TO 0+64.12)

AS-BUILT DRAWING

THIS WORK WAS PREPARED BY ME OR UNDER MY SUPERVISION.

SIGNATURE: *James I. Kincaid* DATE: 8/30/2020

EXPIRATION DATE OF THE LICENSE: 8/30/2022

STATE OF HAWAII
DEPARTMENT OF TRANSPORTATION
HIGHWAYS DIVISION

**RIPRAP REVETMENT - RIVER
SIDE CROSS SECTION E-E**

WAILUA RIVER REVETMENT REPAIRS
Proj. No. ER-23(004), Unit 1

Scale: None Date: AUGUST, 2020

SHEET No. 13 OF 15 SHEETS