

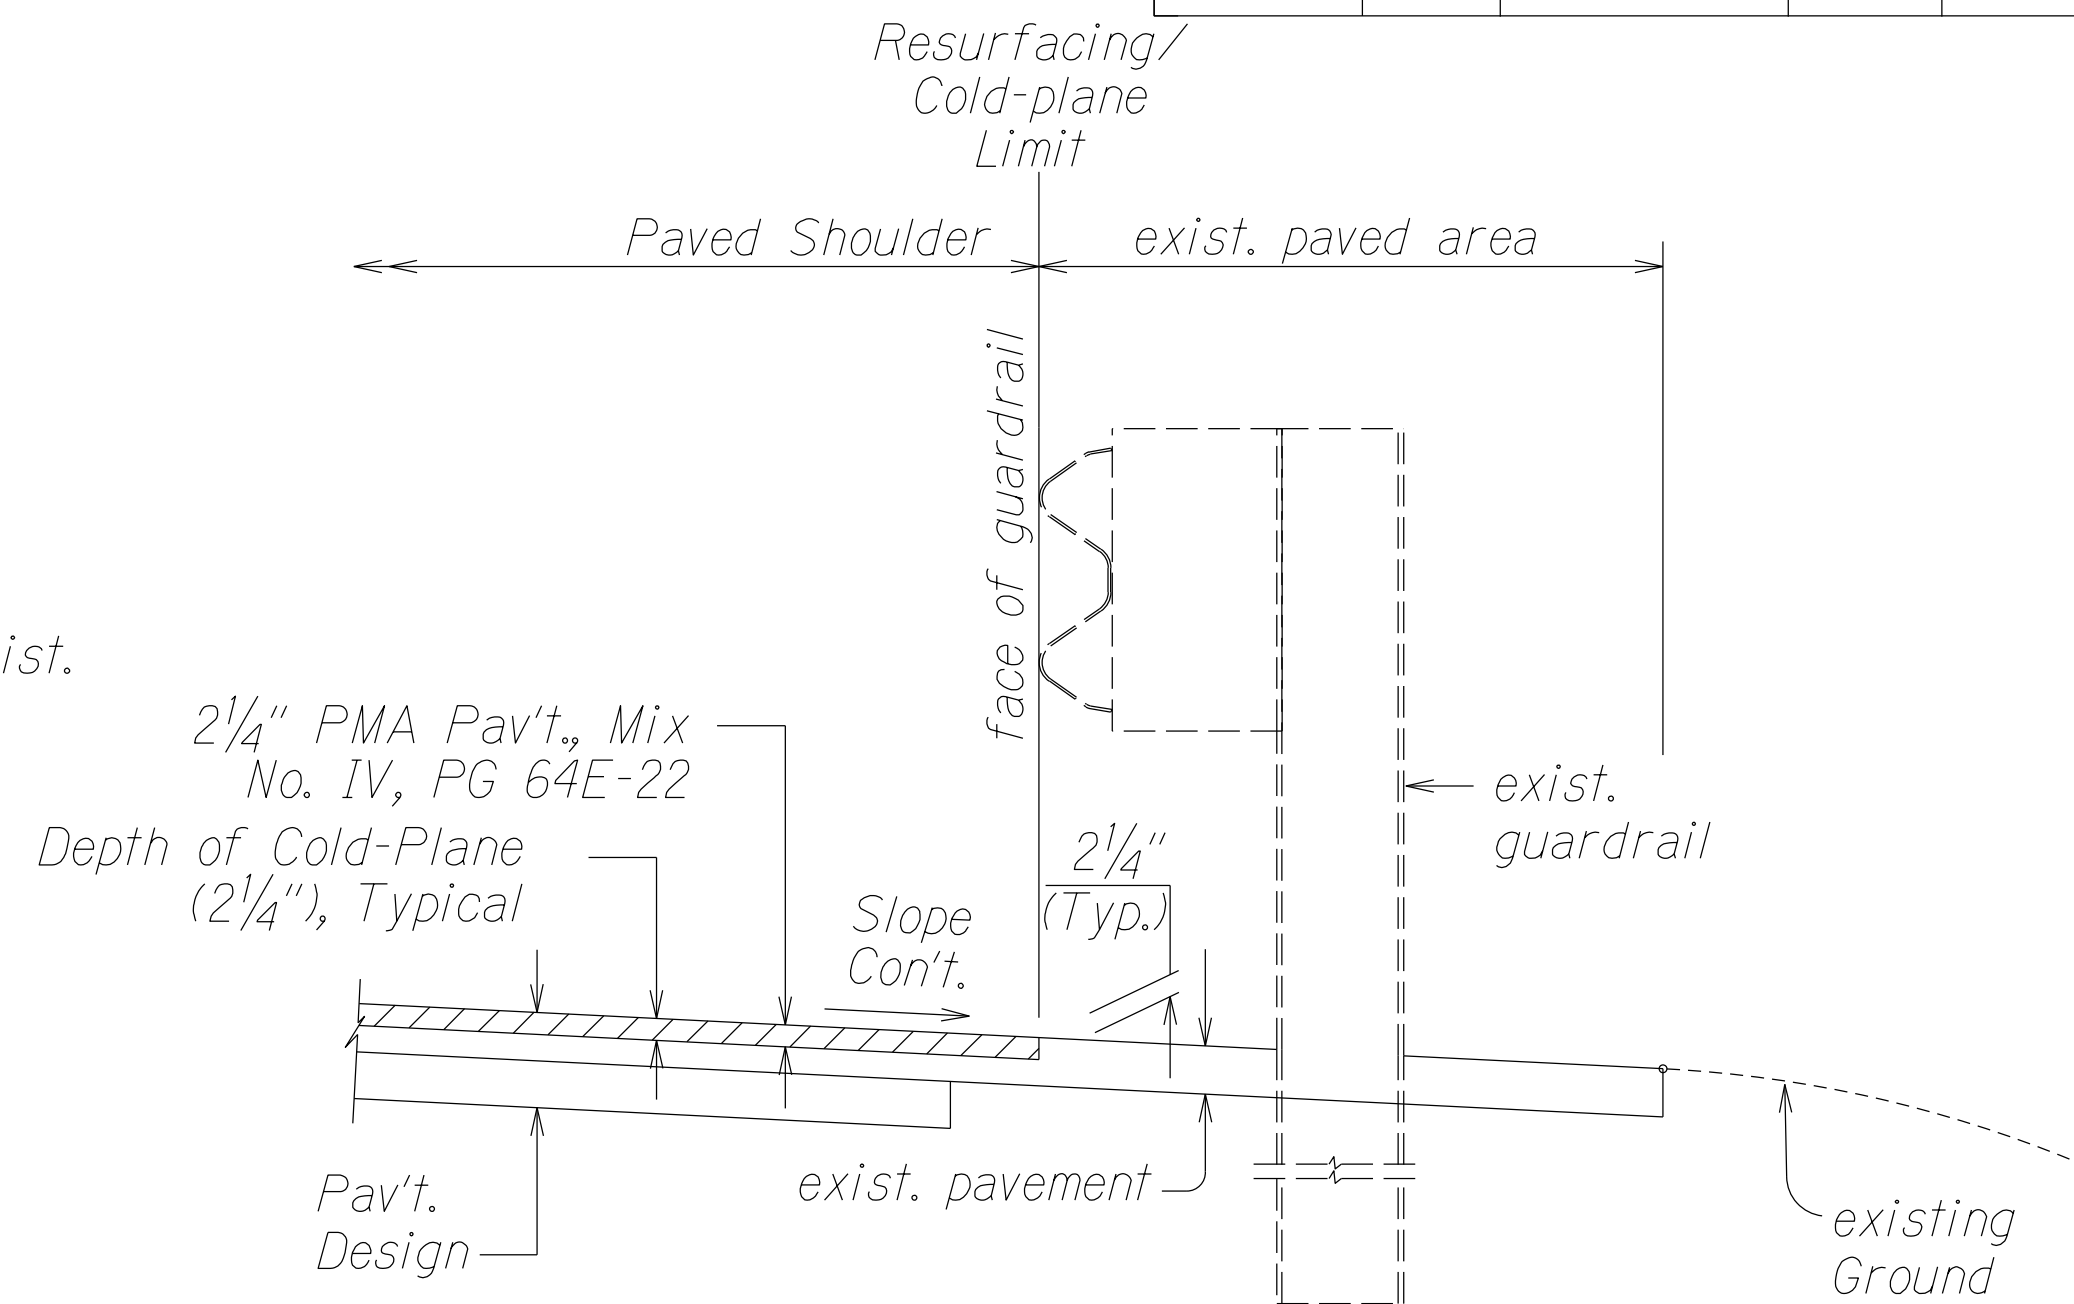
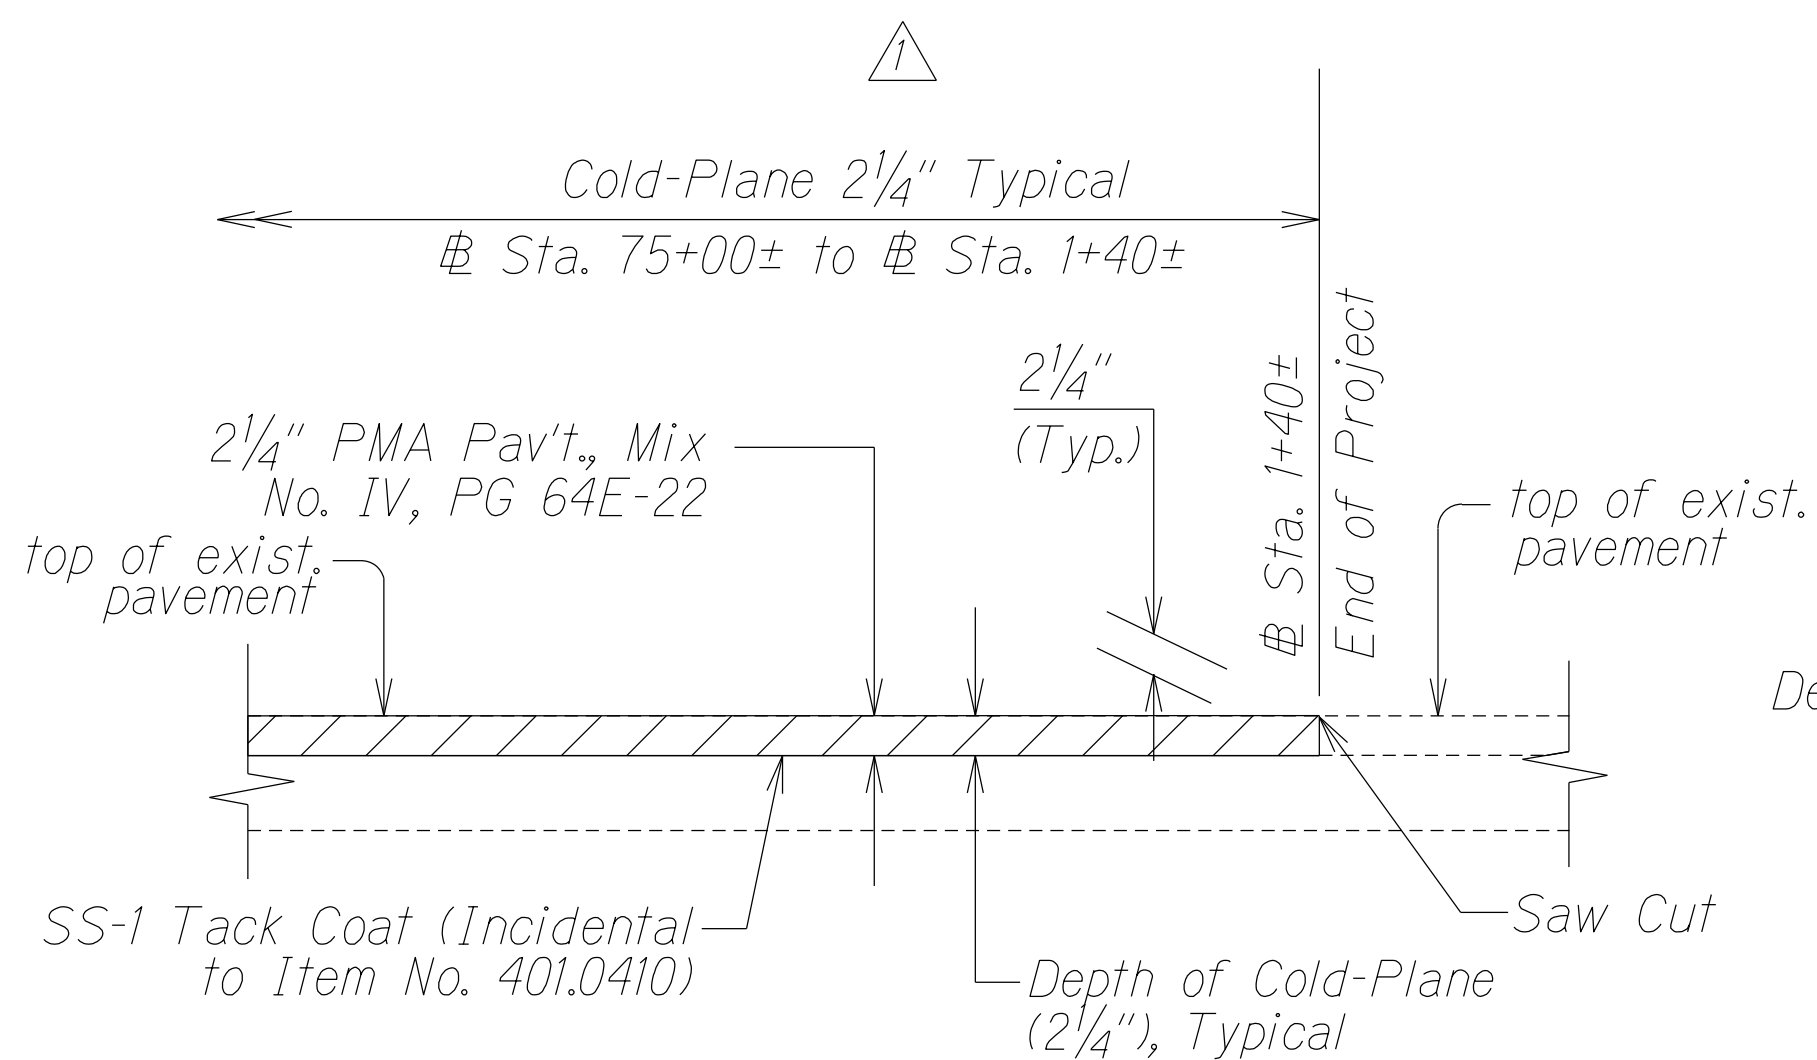


FED. ROAD DIST. NO.	STATE	FED-AID PROJ. NO.	FISCAL YEAR	SHEET NO.	TOTAL SHEETS
HAWAII	HAW.	STP-056-1(064)	2022	ADD.9	40

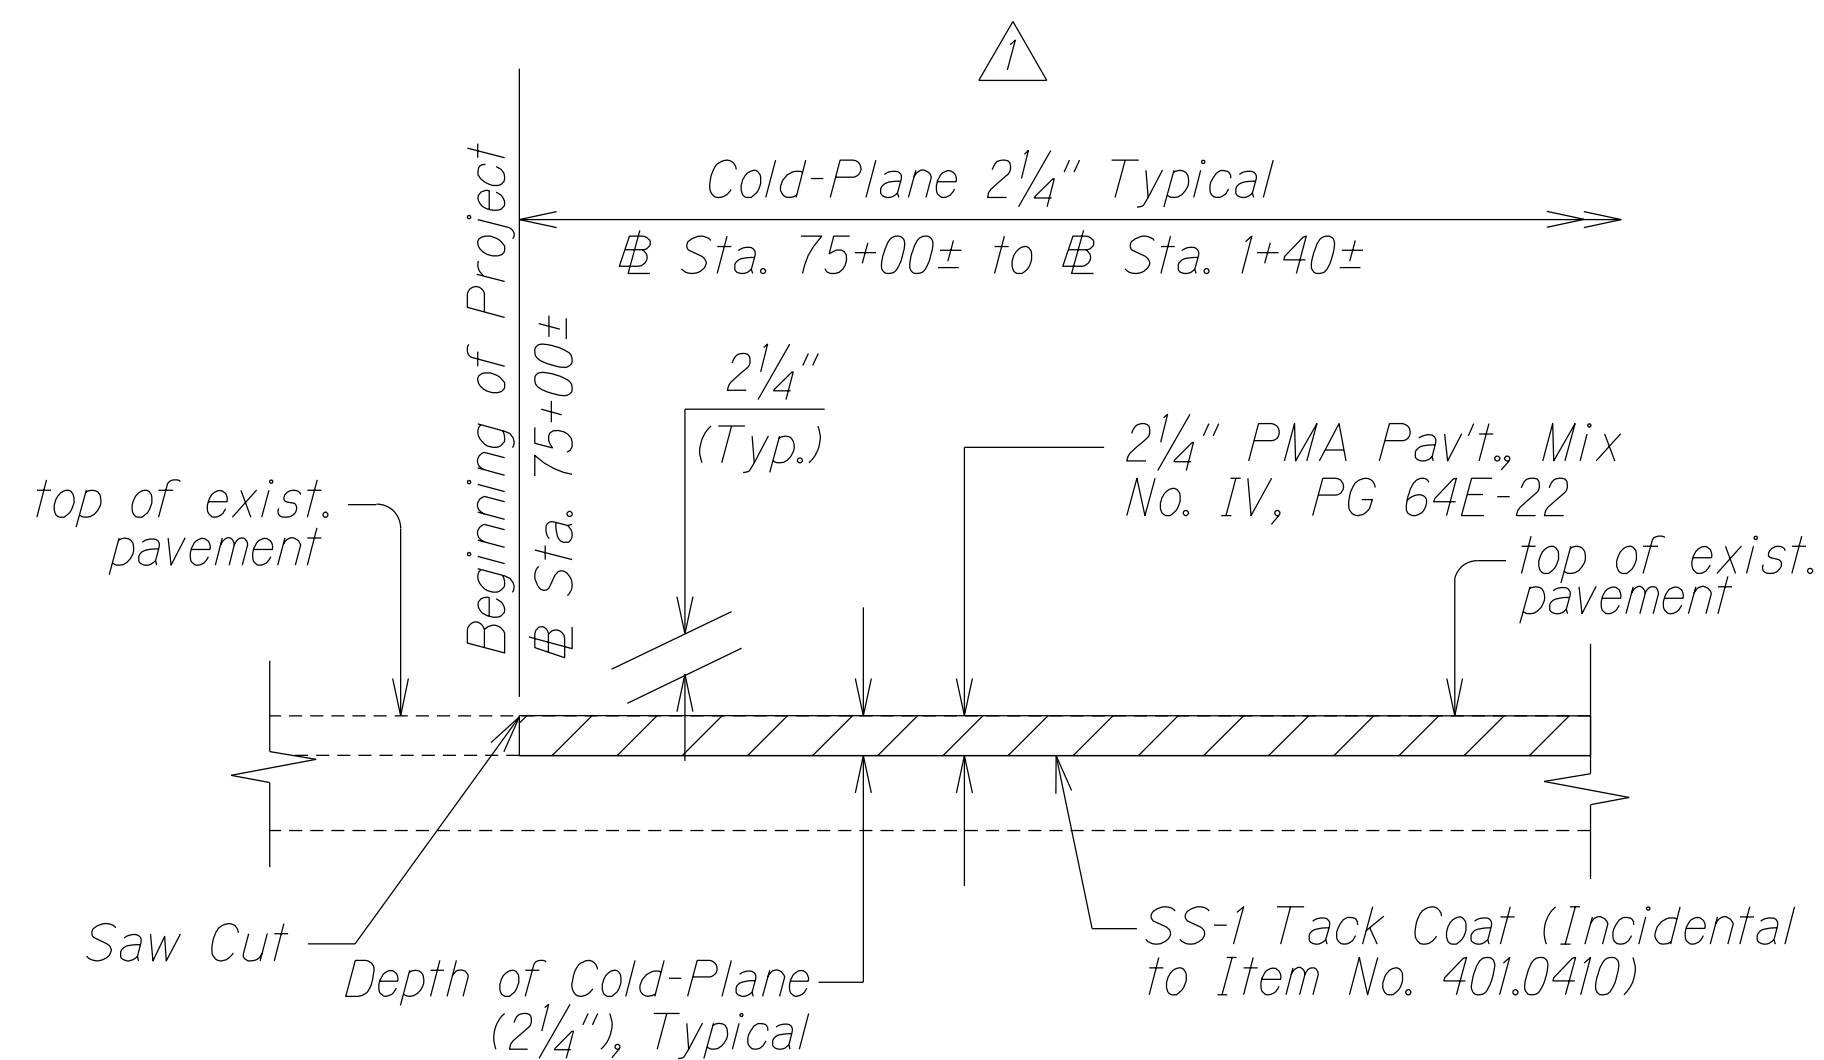


COLD PLANED TRANSITION TO EXISTING A.C. PAVEMENT AT THE BEGINNING AND END OF PROJECT
Not to Scale

RESURFACING AT GUARDRAIL
Not to Scale

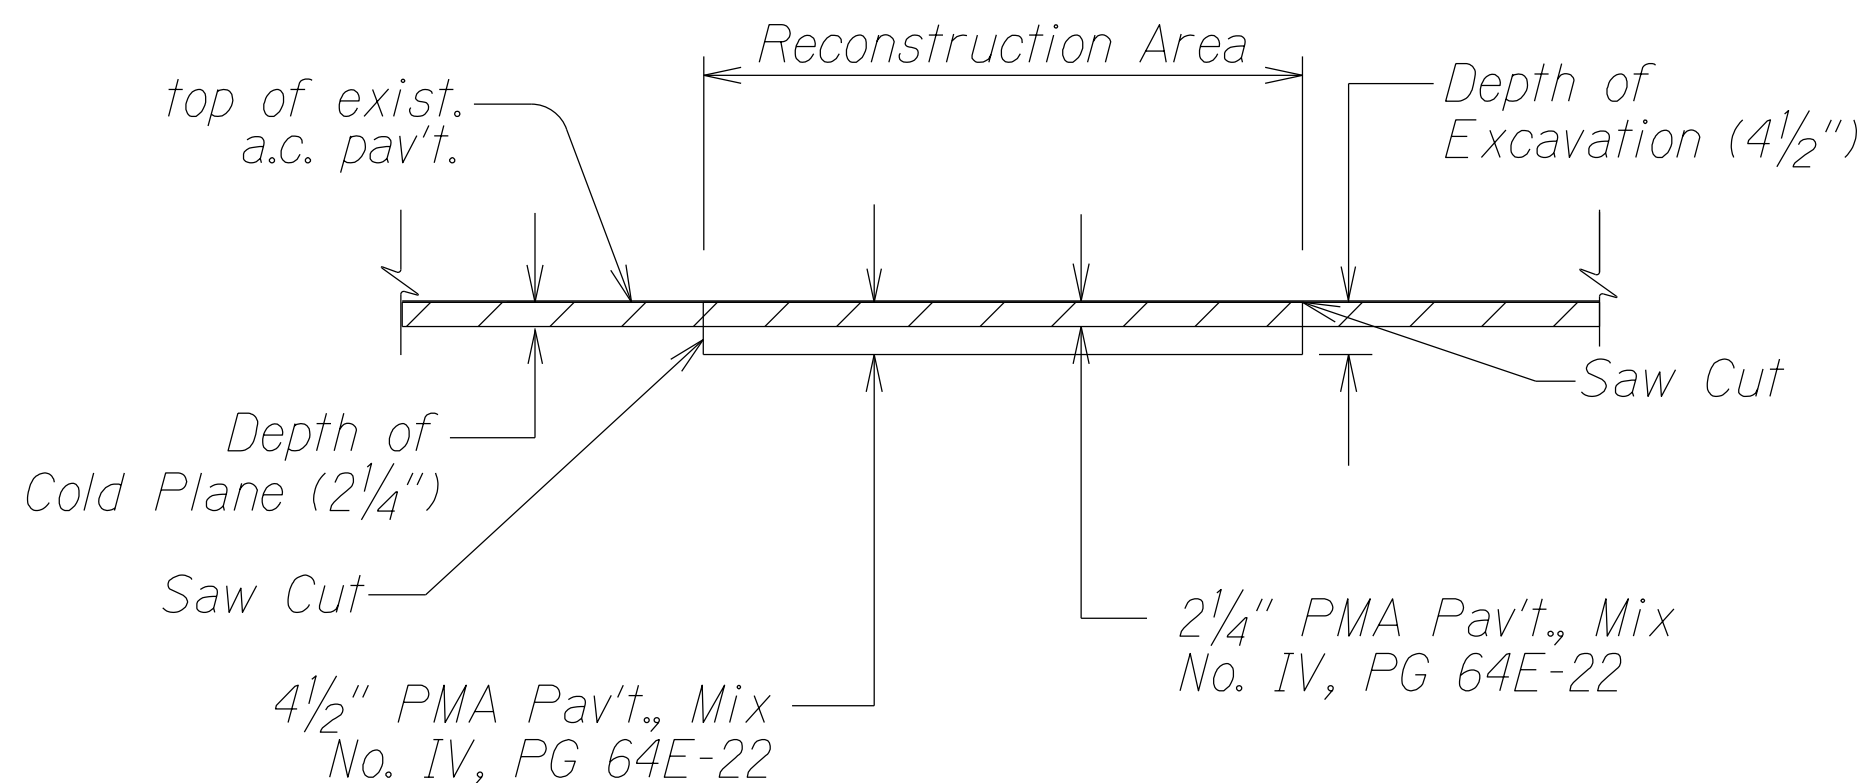

A.C. PAVEMENT RECONSTRUCTION DETAIL
Not to Scale

Note:
Reconstruct weakened pavement areas prior to cold plane. The exposed remaining base course or subbase materials should be properly recompactd to dense and unyielding conditions prior to placement of the asphalt concrete base layer.

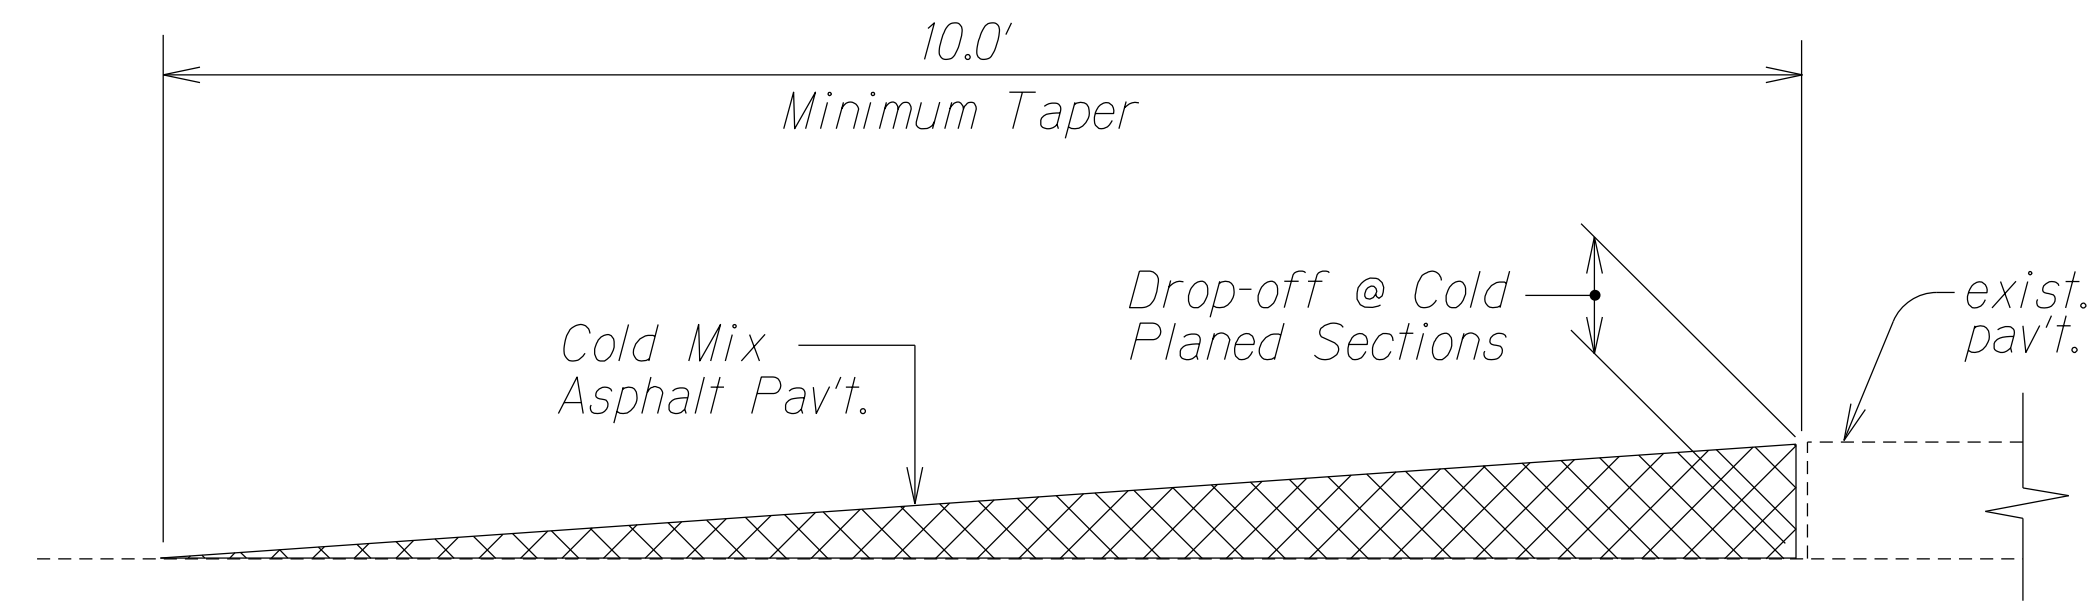

TEMPORARY TRANSITION AT COLD PLANED AREAS
Not to Scale

Note: Contractor shall construct temporary pavement taper to prevent sharp pavement drop-offs at all cold planed sections. Prior to final PMA Pavement, Mix No. IV placement, temporary pavement taper shall be removed.

8/11/22		Cold Planed Transition to Exist. A.C. Pavement at the Beginning and End of Project Detail
8/11/22		Revise A.C. Pavement Reconstruction Detail
DATE	REVISION	
STATE OF HAWAII DEPARTMENT OF TRANSPORTATION HIGHWAYS DIVISION		
<u>TYPICAL SECTIONS</u>		
<u>KUHIO HIGHWAY RESURFACING</u> <u>Kahiliholo Road to Ka Haku Road</u> <u>Federal-Aid Project No. STP-056-1(064)</u>		
Not to Scale		Date: January 2022
SHEET No. 3 OF 3 SHEETS		