



FED. ROAD DIST. NO.	STATE	FED-AID PROJ. NO.	FISCAL YEAR	SHEET NO.	TOTAL SHEETS
HAWAII	HAW.	STP-056-1(064)	2022	7	40

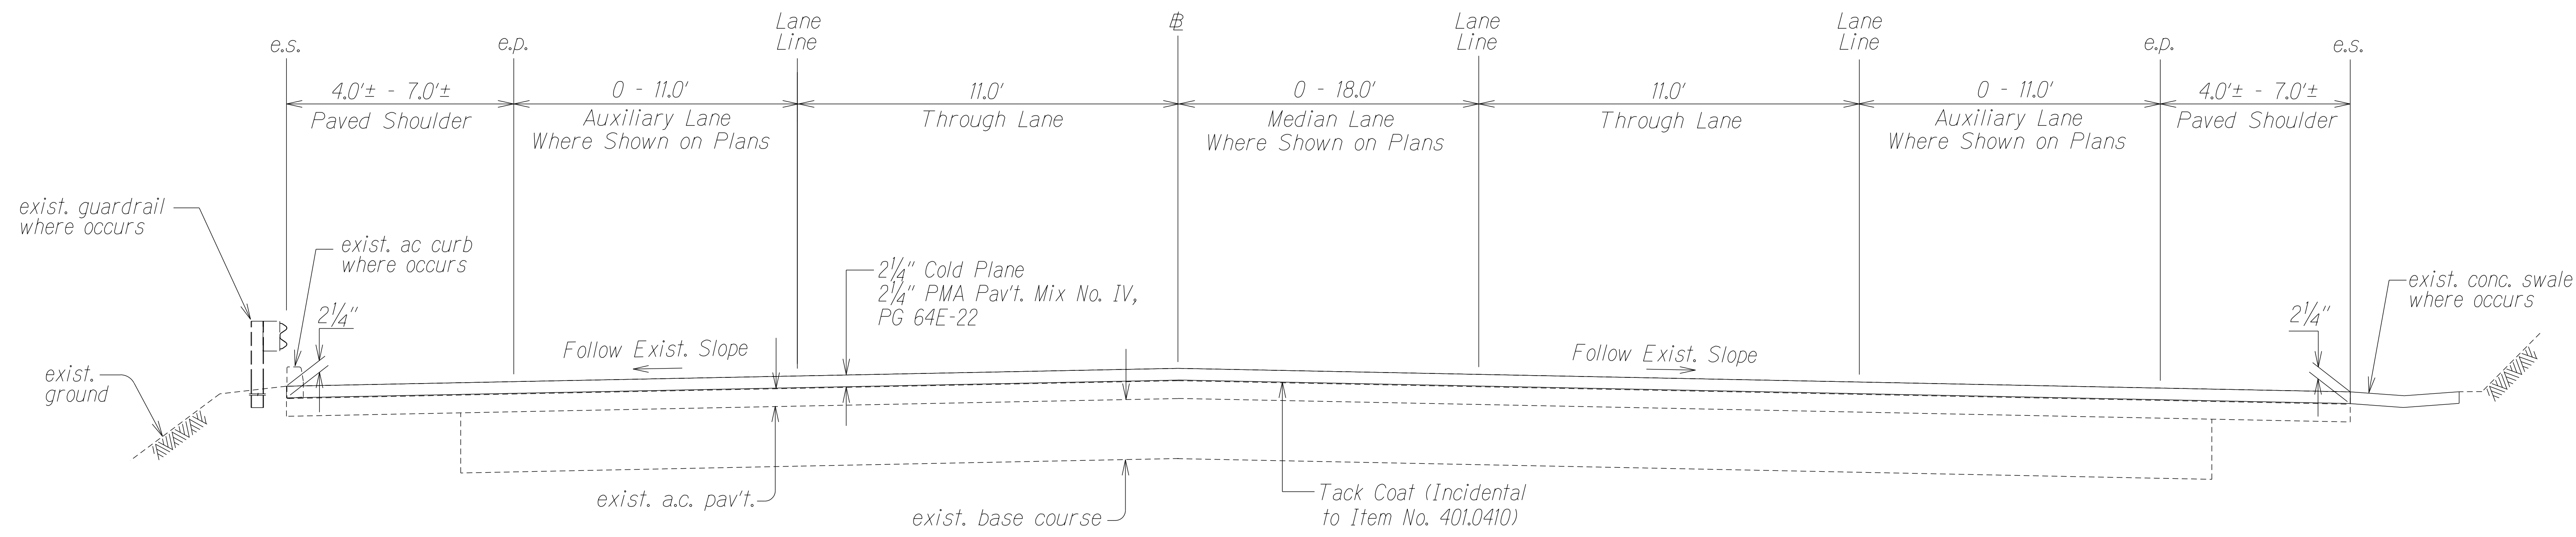

TYPICAL TANGENT SECTION  
Scale:  $\frac{3}{8}" = 1'-0"$

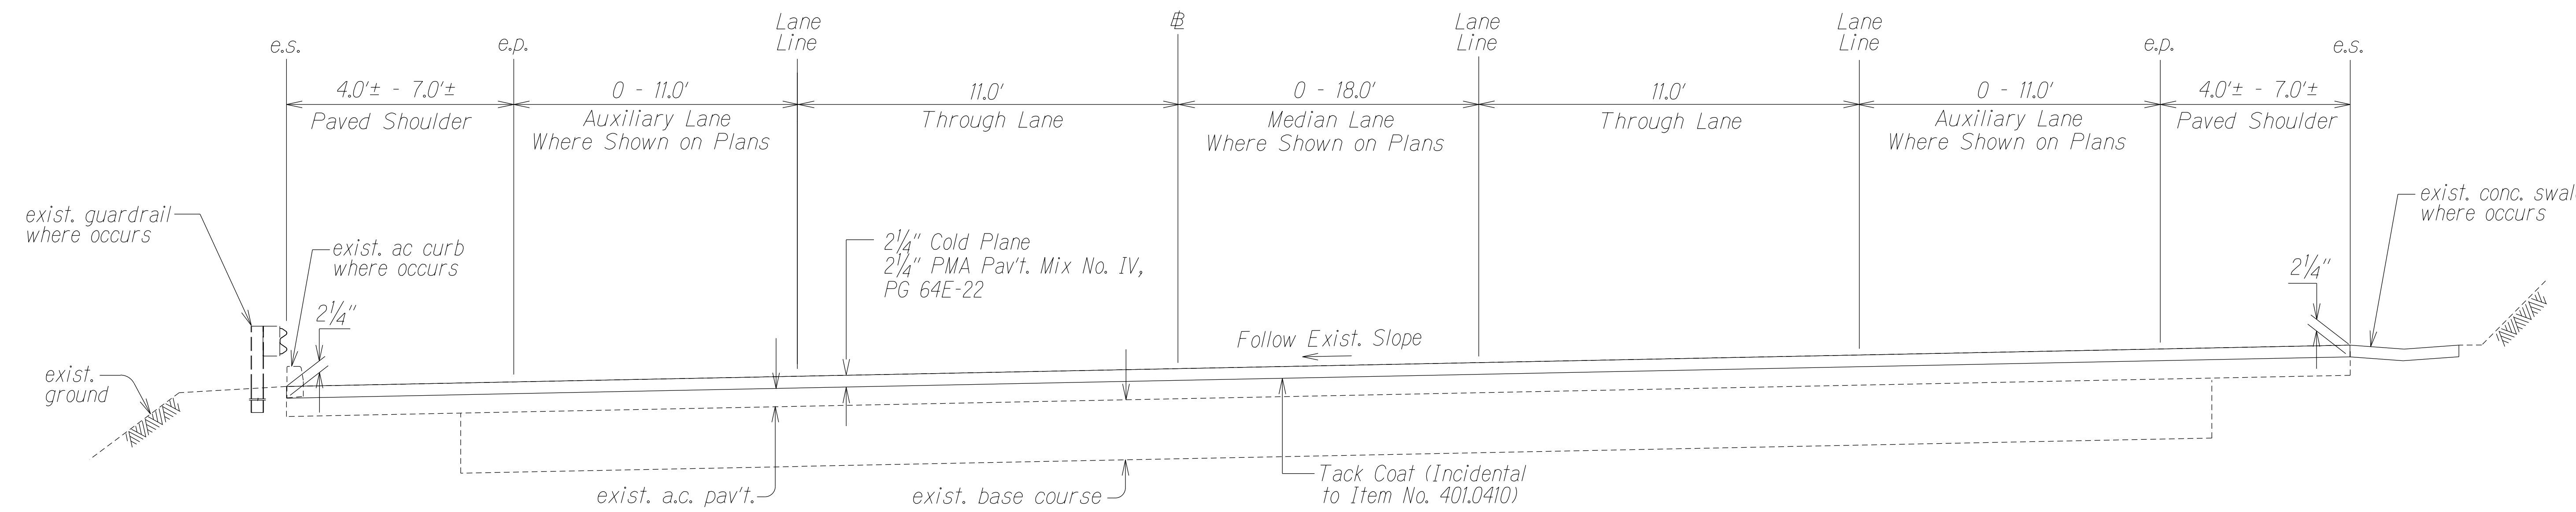

TYPICAL SUPERELEVATION SECTION  
Scale:  $\frac{3}{8}" = 1'-0"$


ORIGINAL PLAN	SURVEY PLOTTED BY	DATE
NOTE BOOK	DRAWN BY	12/07
QUANTITIES BY	DESIGNED BY	
CHECKED BY		

STATE OF HAWAII  
DEPARTMENT OF TRANSPORTATION  
HIGHWAYS DIVISION


TYPICAL SECTIONS  
KUHIO HIGHWAY RESURFACING  
Kahiliholo Road to Ka Haku Road  
Federal-Aid Project No. STP-056-1(064)  
Scale: As Shown      Date: January 2022

SHEET No. 1 OF 3 SHEETS


FED. ROAD DIST. NO.	STATE	FED-AID PROJ. NO.	FISCAL YEAR	SHEET NO.	TOTAL SHEETS
HAWAII	HAW.	STP-056-1(064)	2022	8	40

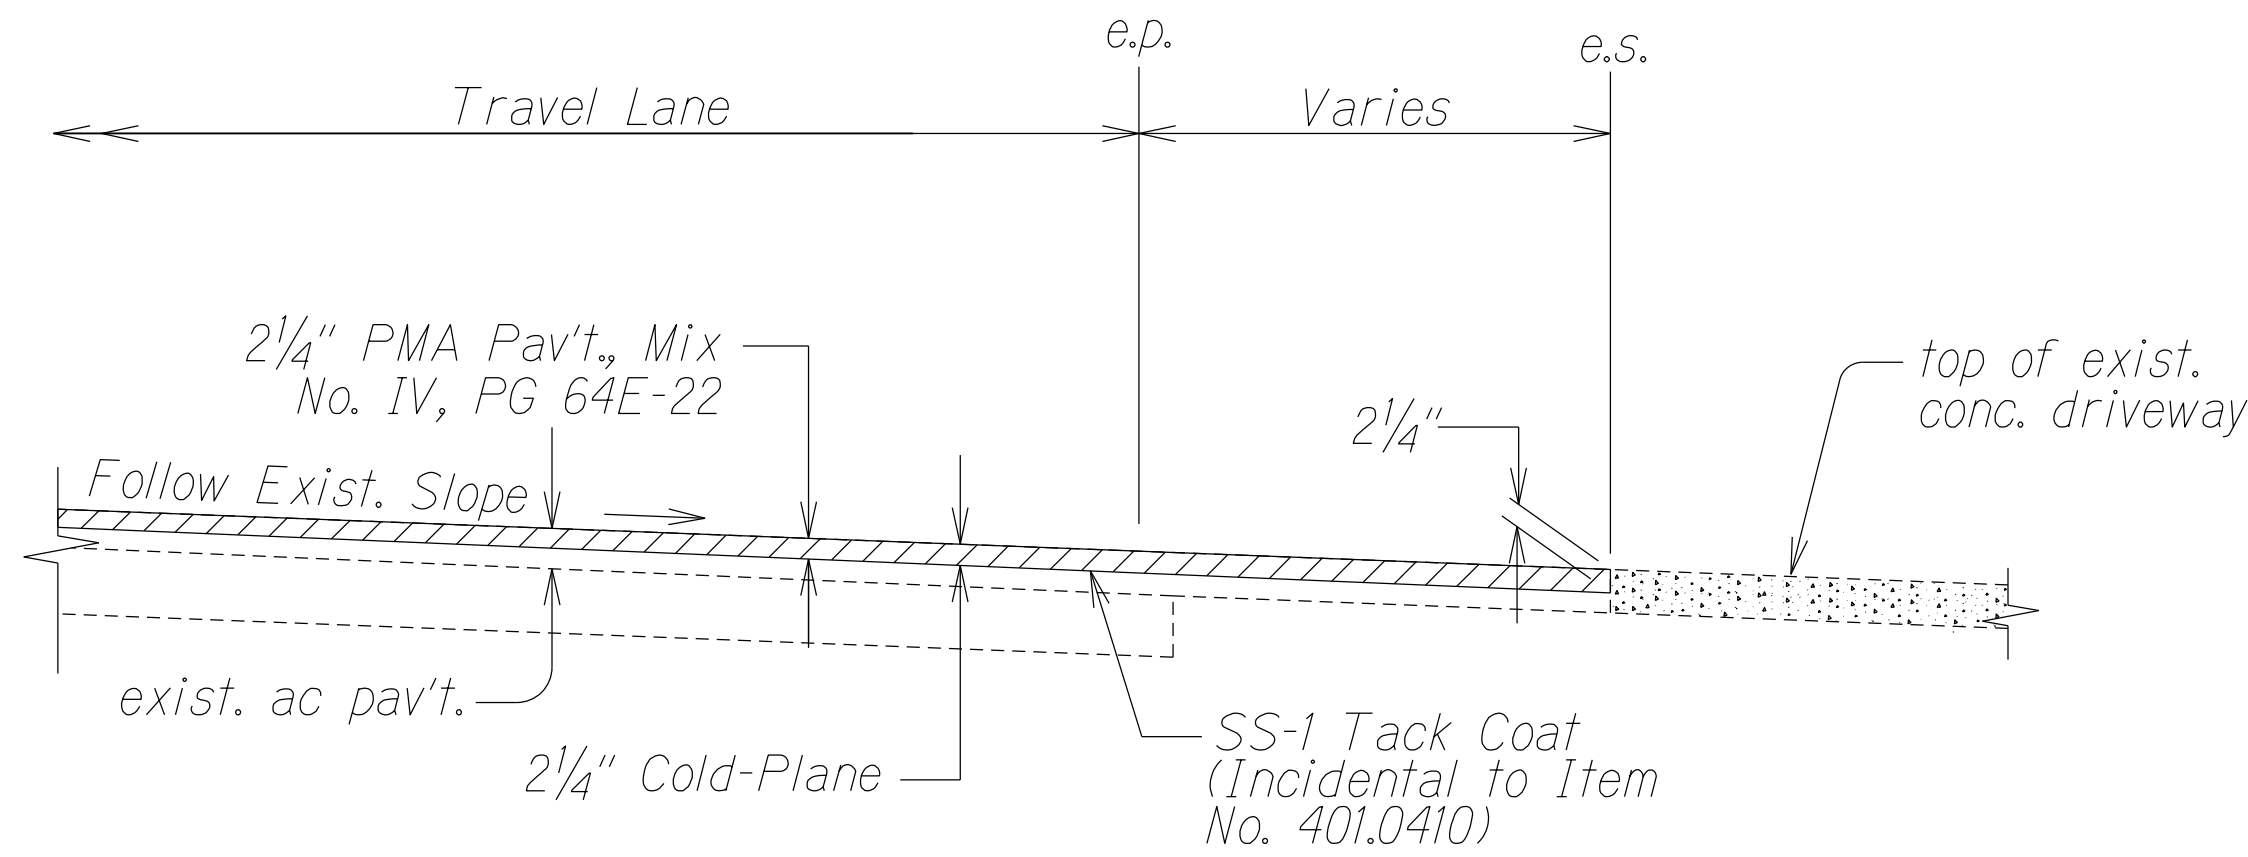


RESURFACING AT CONCRETE DRIVEWAYS  
Not to Scale

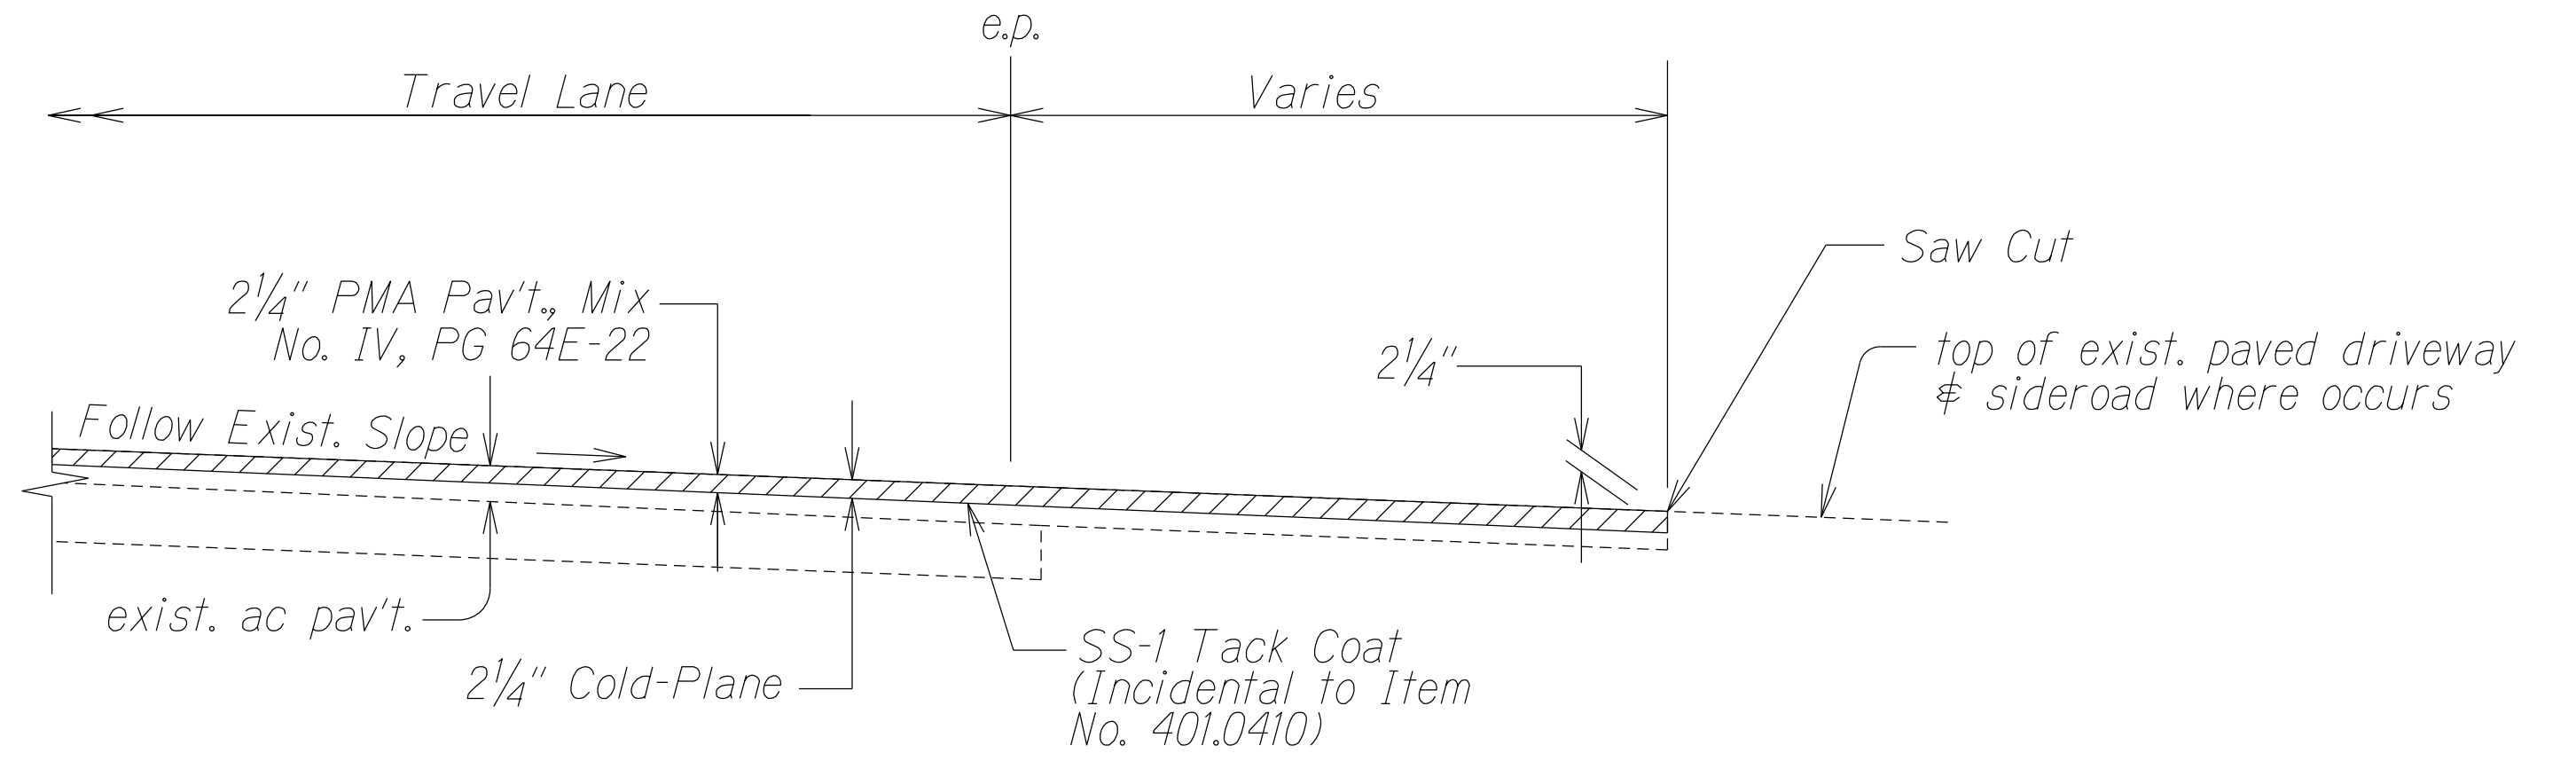


RESURFACING AT PAVED SIDEROADS/DRIVEWAYS  
Not to Scale

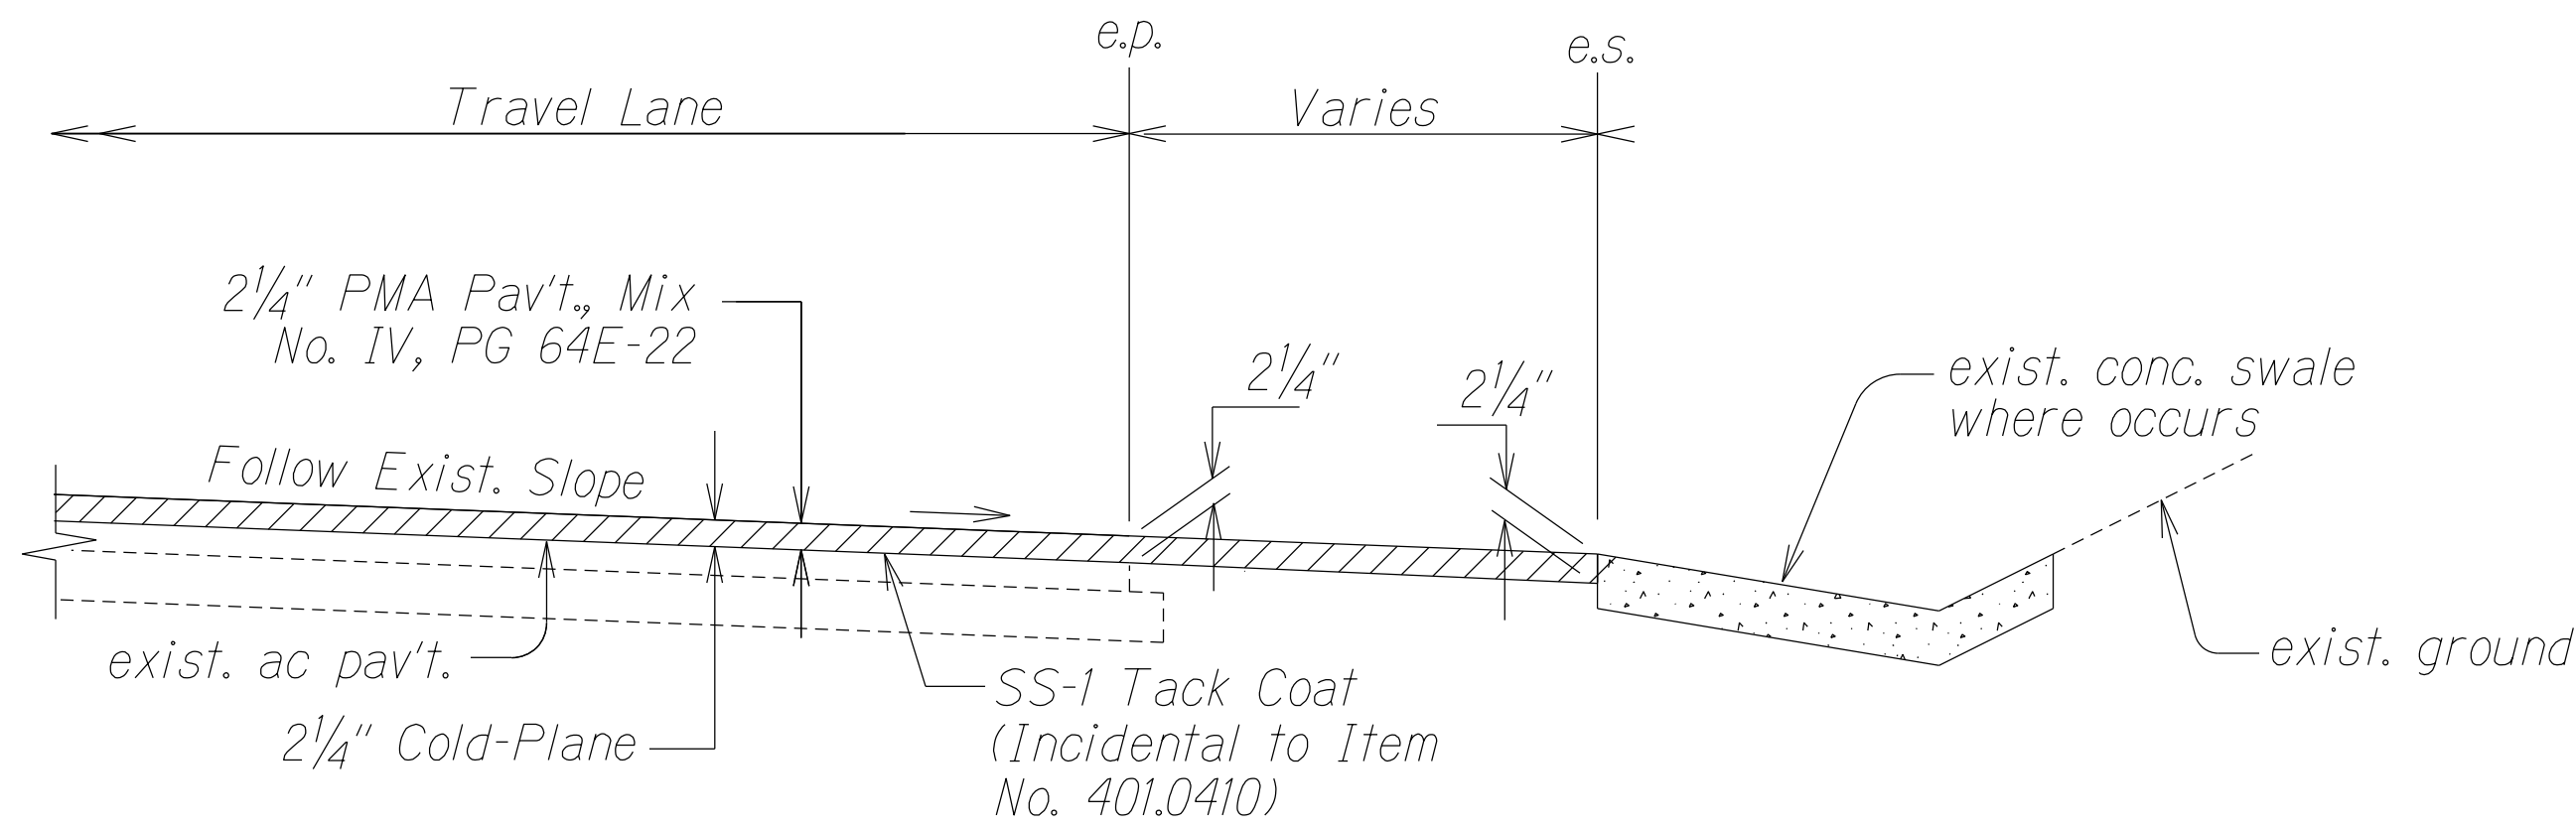

RESURFACING AT CONCRETE OR ASPHALT SWALE  
Not to Scale

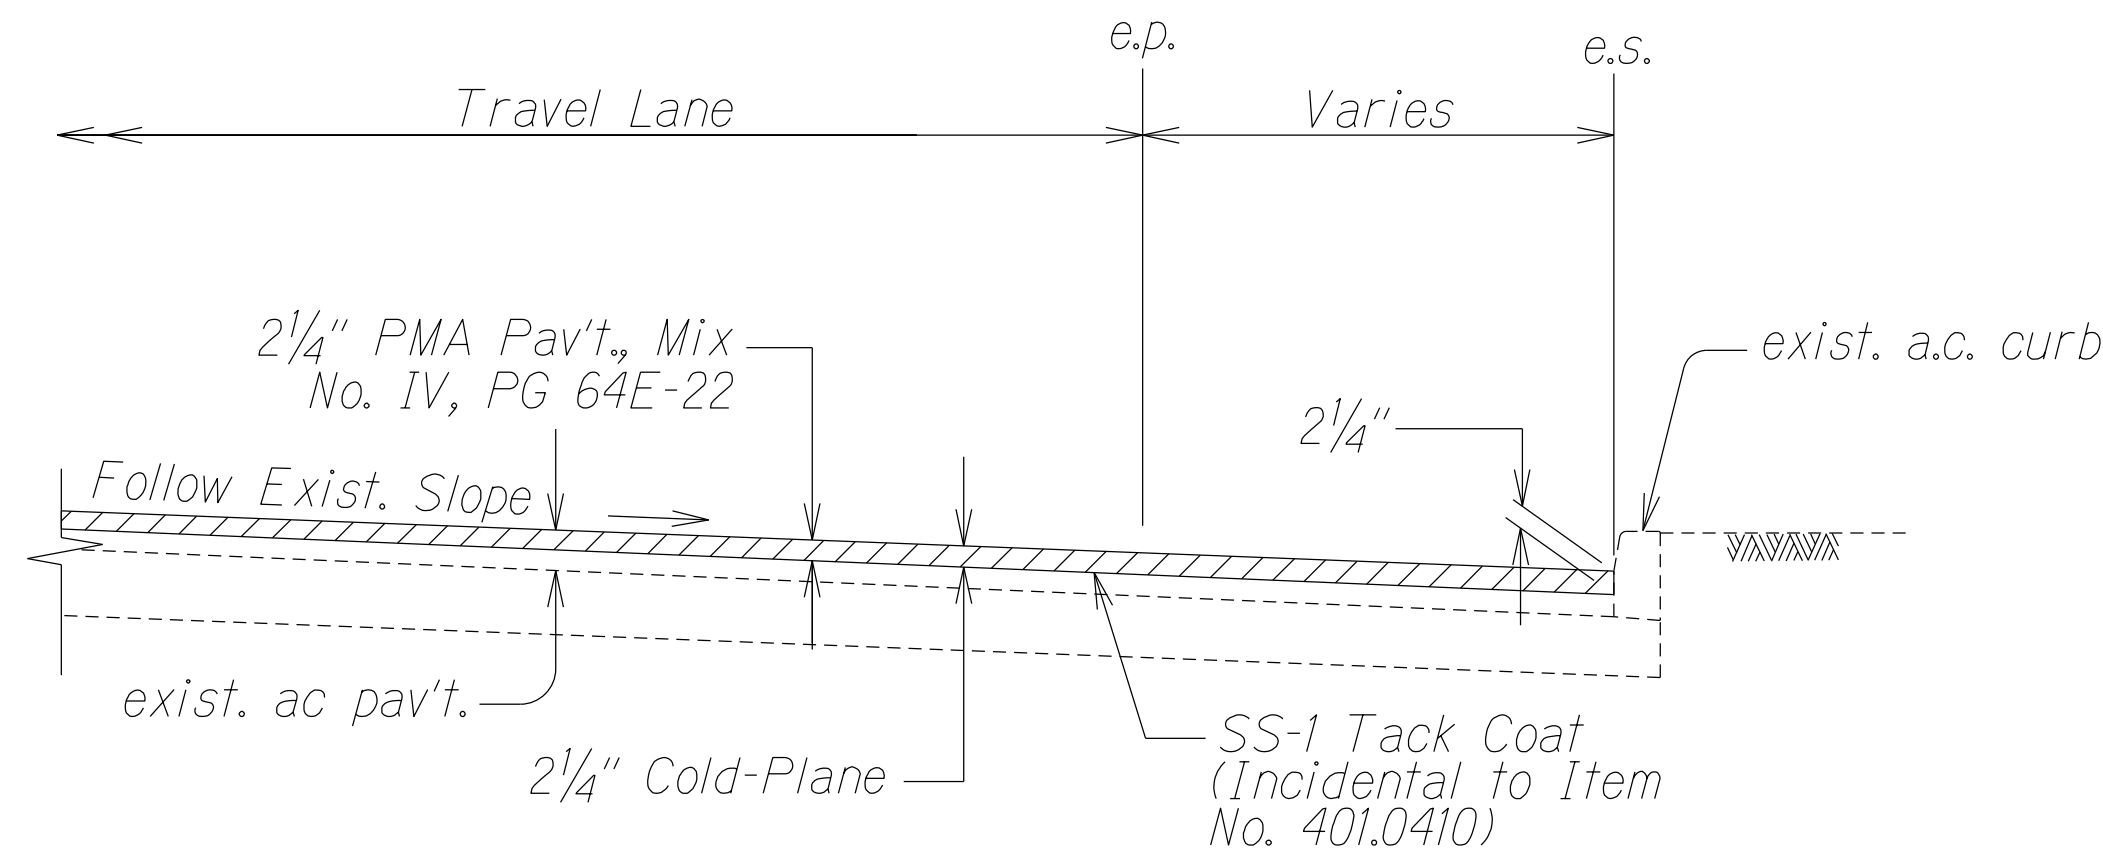

RESURFACING AT A.C. CURB  
Not to Scale

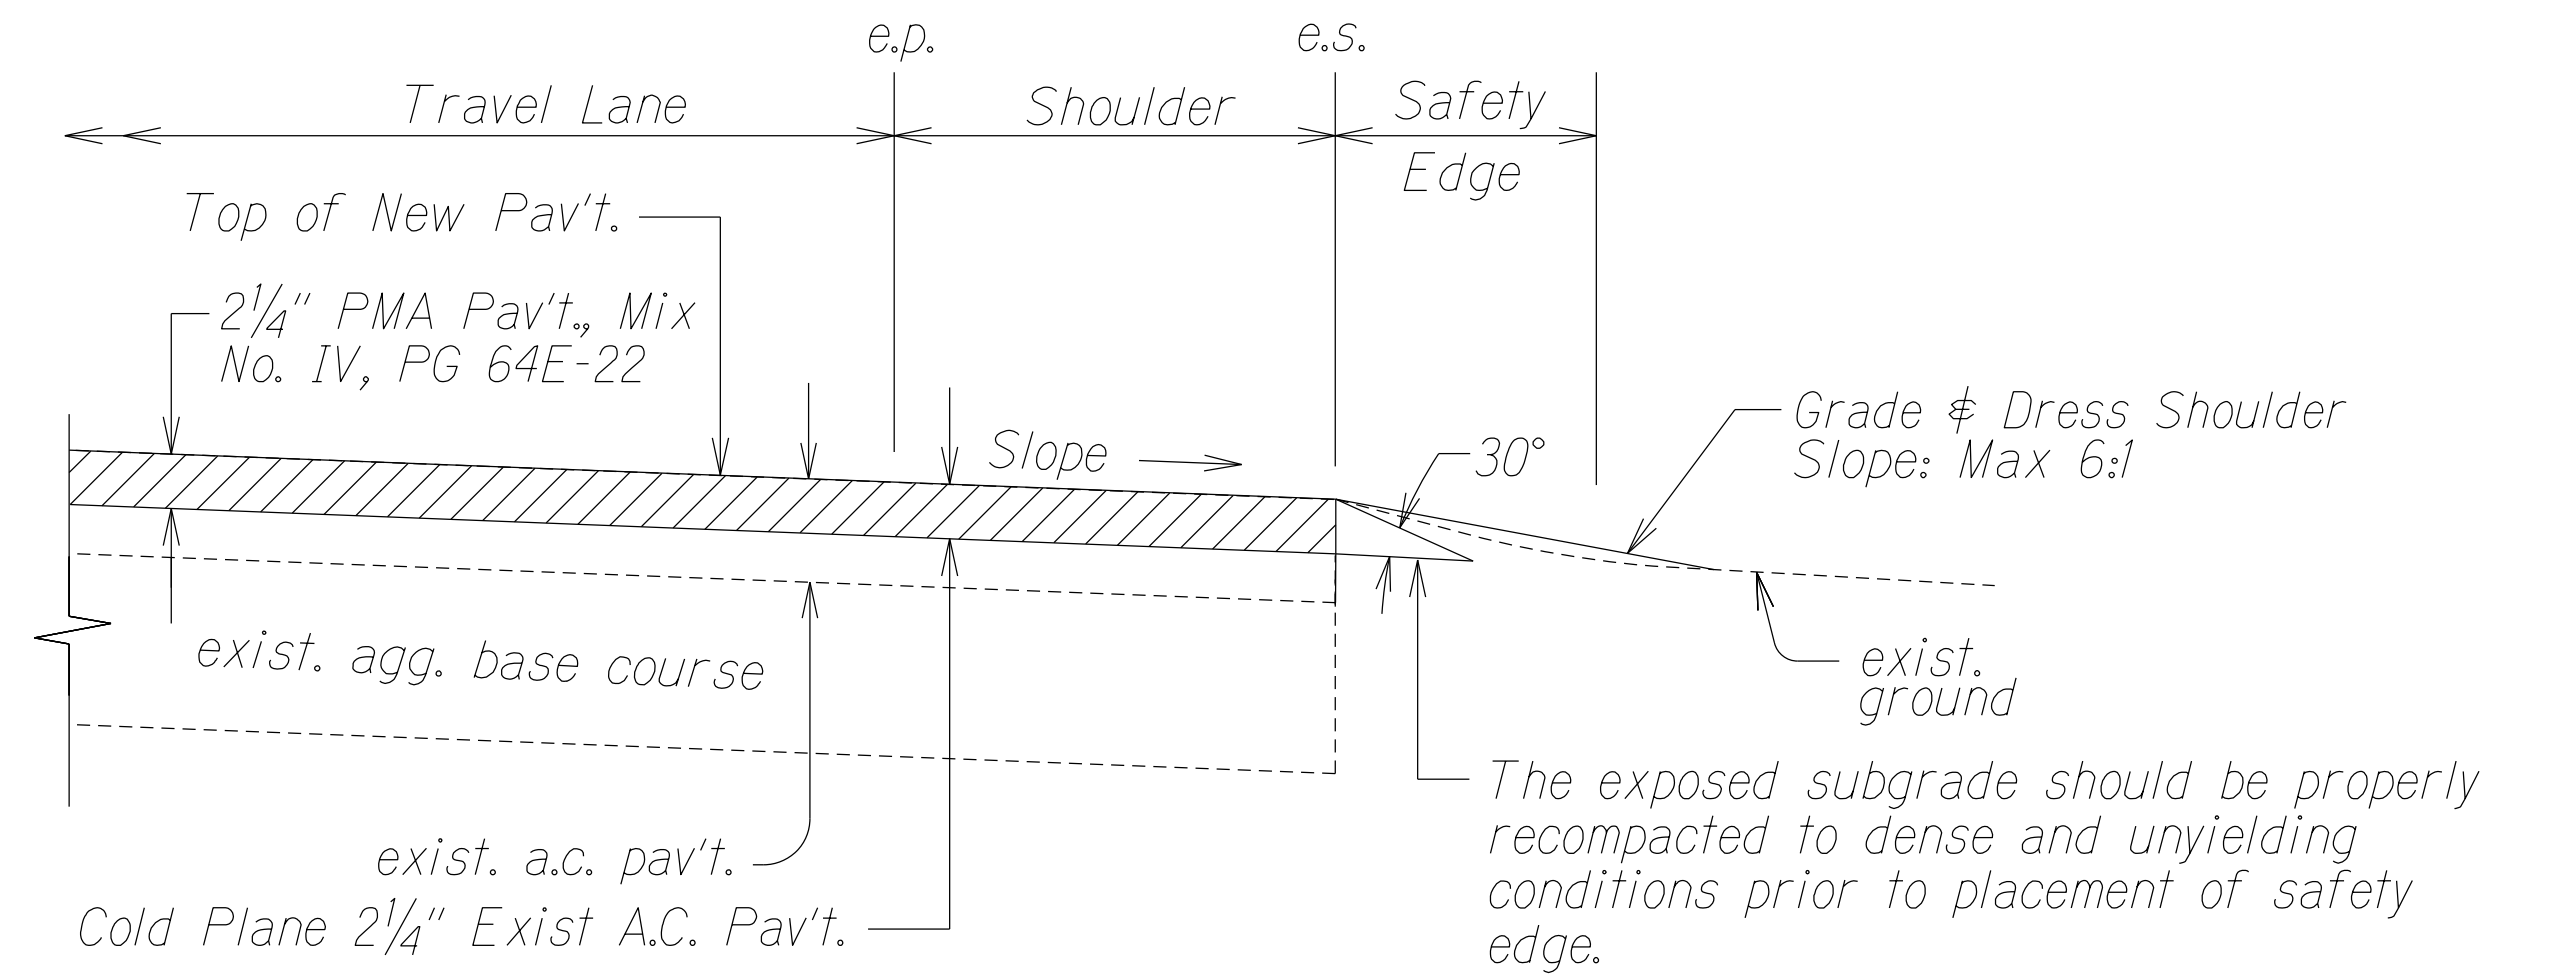




TYPICAL PAVEMENT EDGE DETAIL  
Not to Scale

Note:

- Contractor shall mount a device directly on the paver screed extension to provide a 30° beveled shoulder edge.
- Construct safety edge at all edges of a.c. pavement. This work shall be considered incidental to Item No. 401.0410 - PMA Pavement Mix No. IV.


STATE OF HAWAII  
DEPARTMENT OF TRANSPORTATION  
HIGHWAYS DIVISION  
TYPICAL SECTIONS  
KUHIO HIGHWAY RESURFACING  
Kahiloholo Road to Ka Haku Road  
Federal-Aid Project No. STP-056-1(064)  
Not to Scale Date: January 2022  
SHEET No. 2 OF 3 SHEETS

FED. ROAD DIST. NO.	STATE	FED-AID PROJ. NO.	FISCAL YEAR	SHEET NO.	TOTAL SHEETS
HAWAII	HAW.	STP-056-1(064)	2022	ADD.9	40

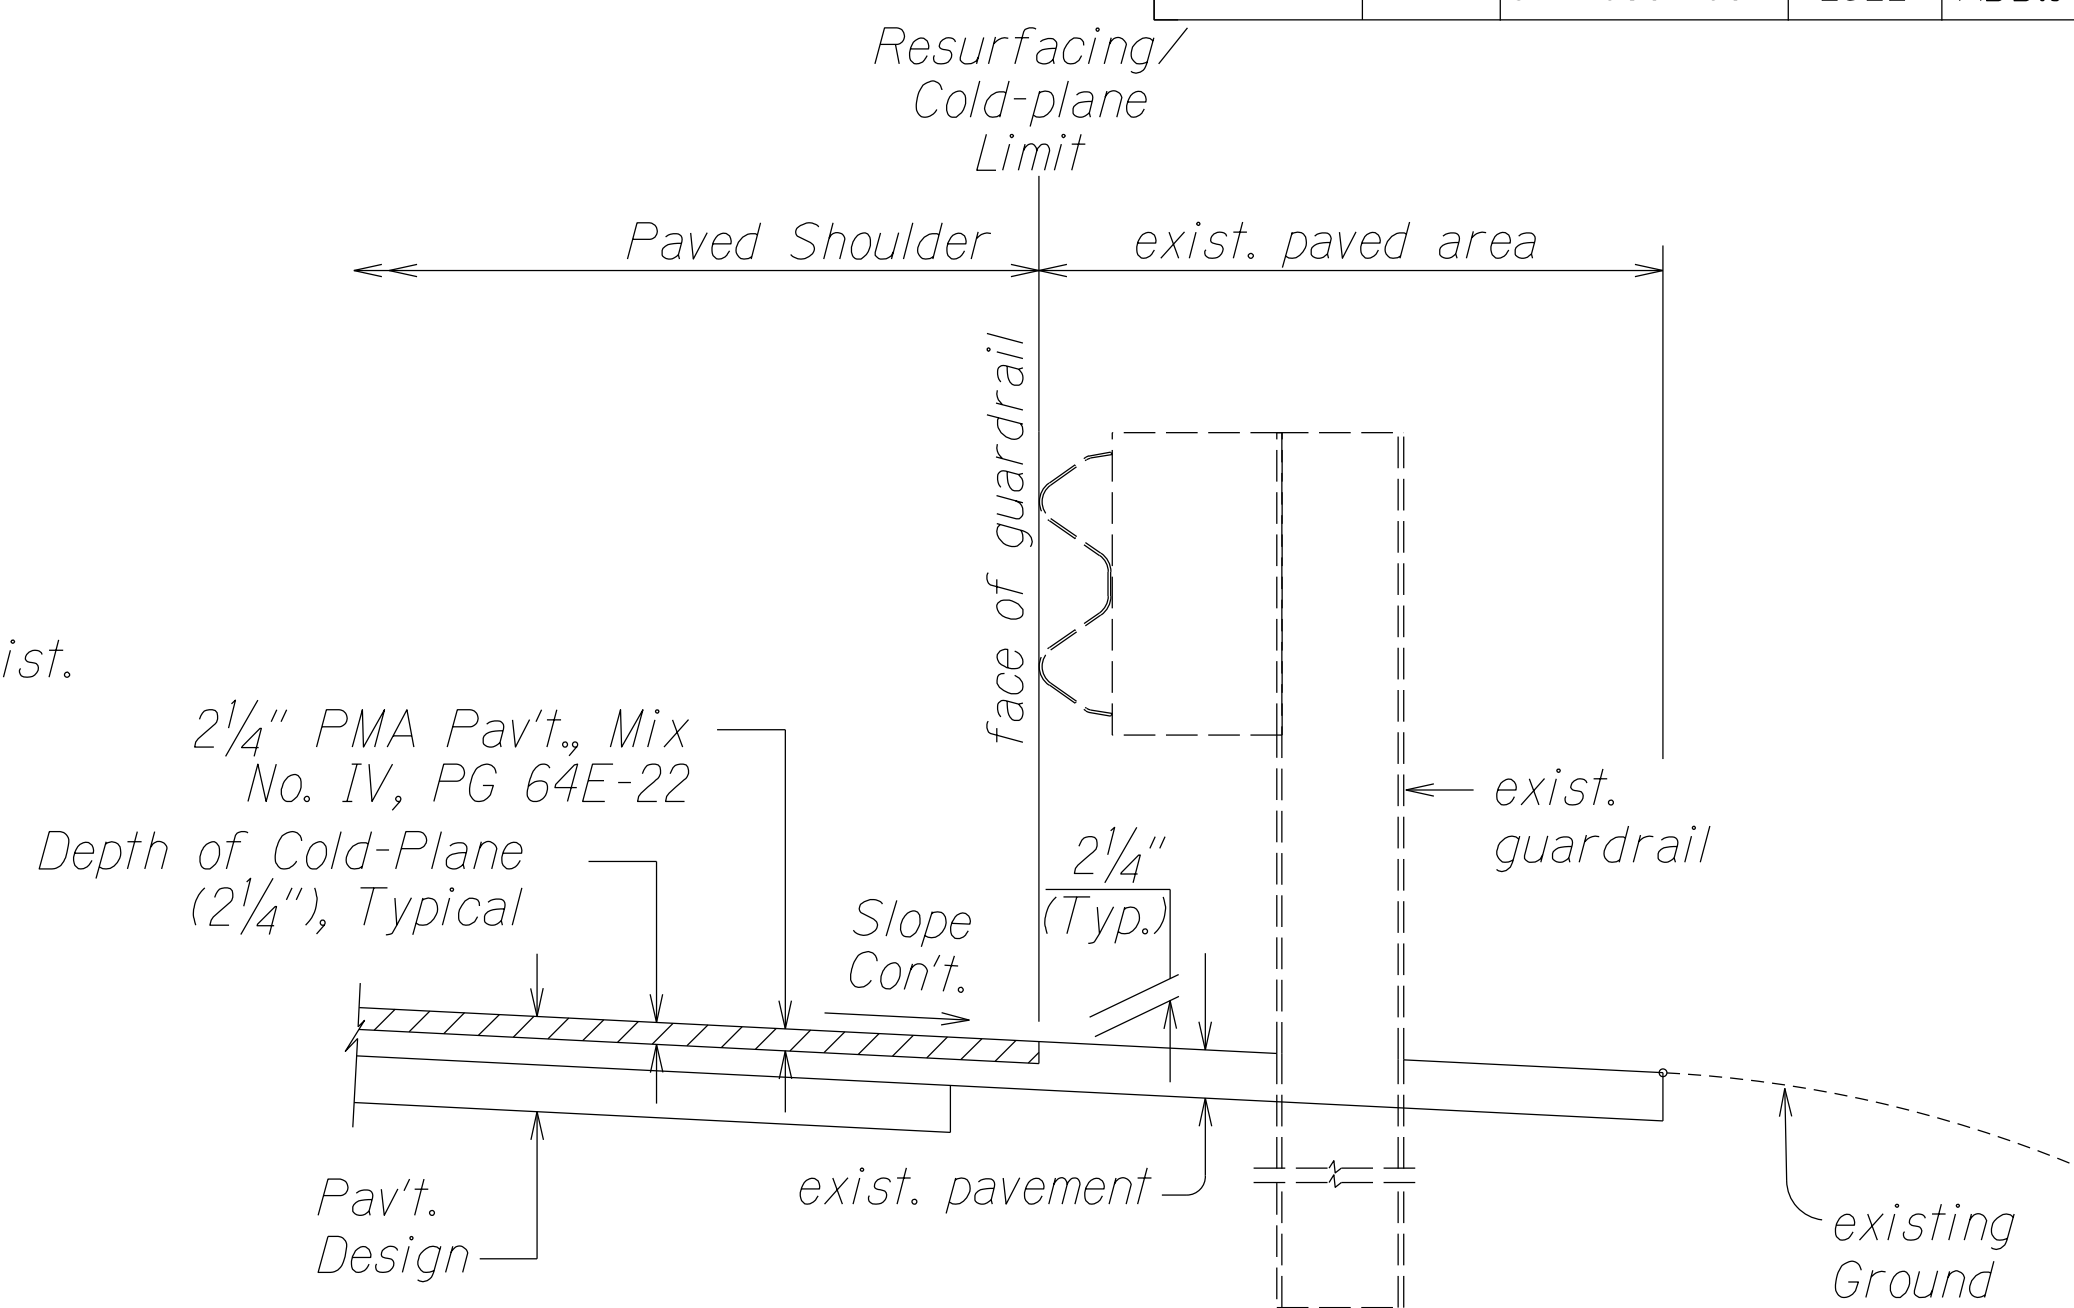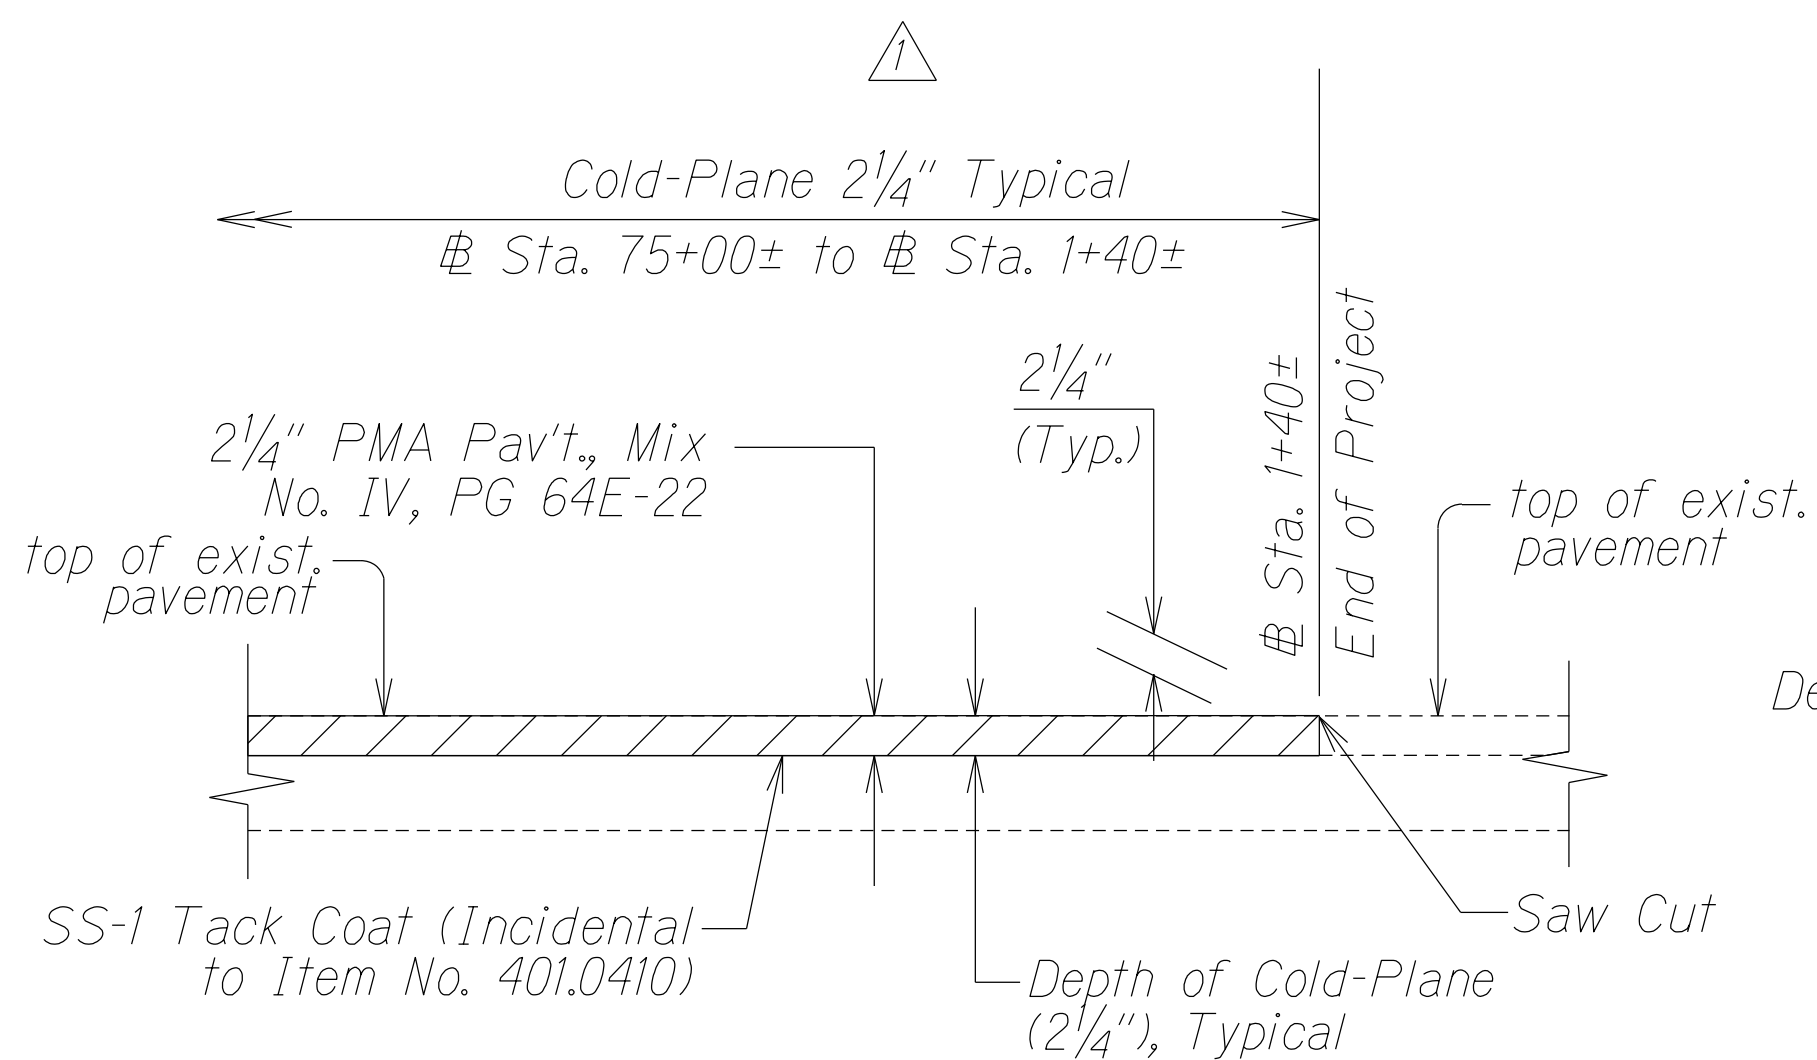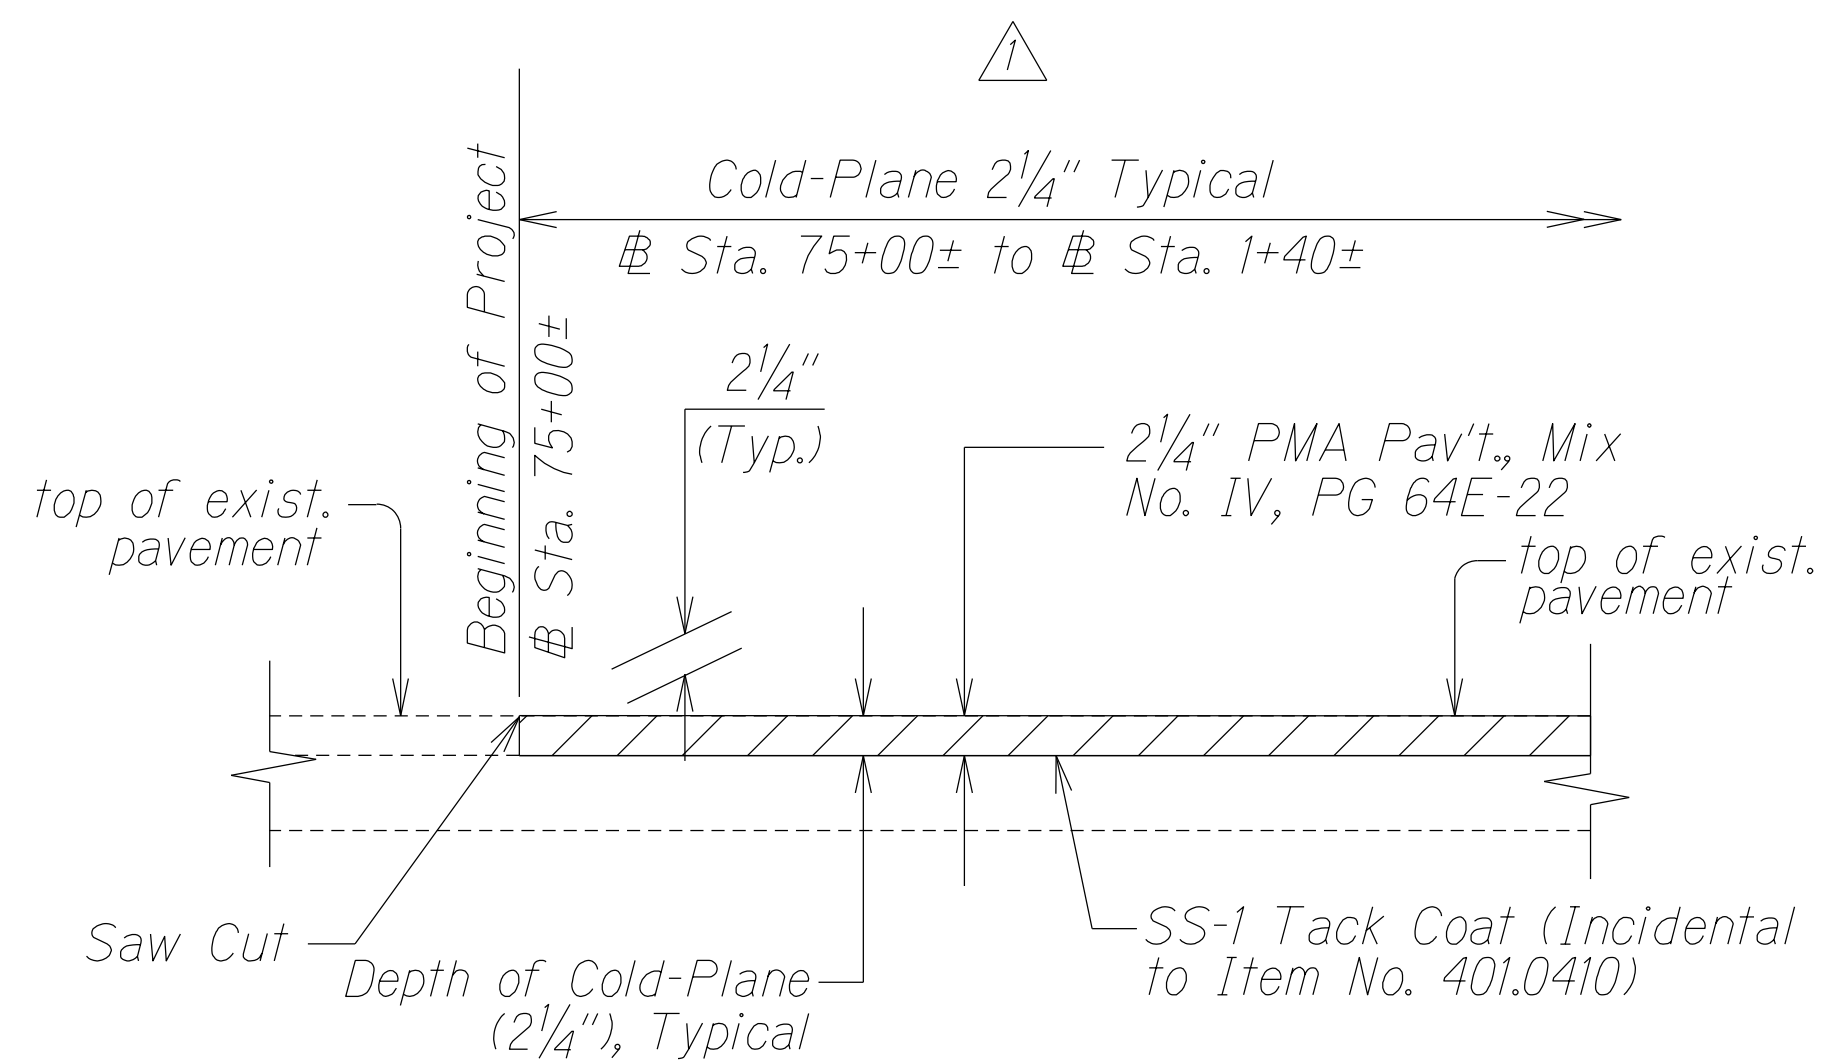


COLD PLANED TRANSITION TO EXISTING A.C. PAVEMENT AT THE BEGINNING AND END OF PROJECT  
Not to Scale

RESURFACING AT GUARDRAIL  
Not to Scale

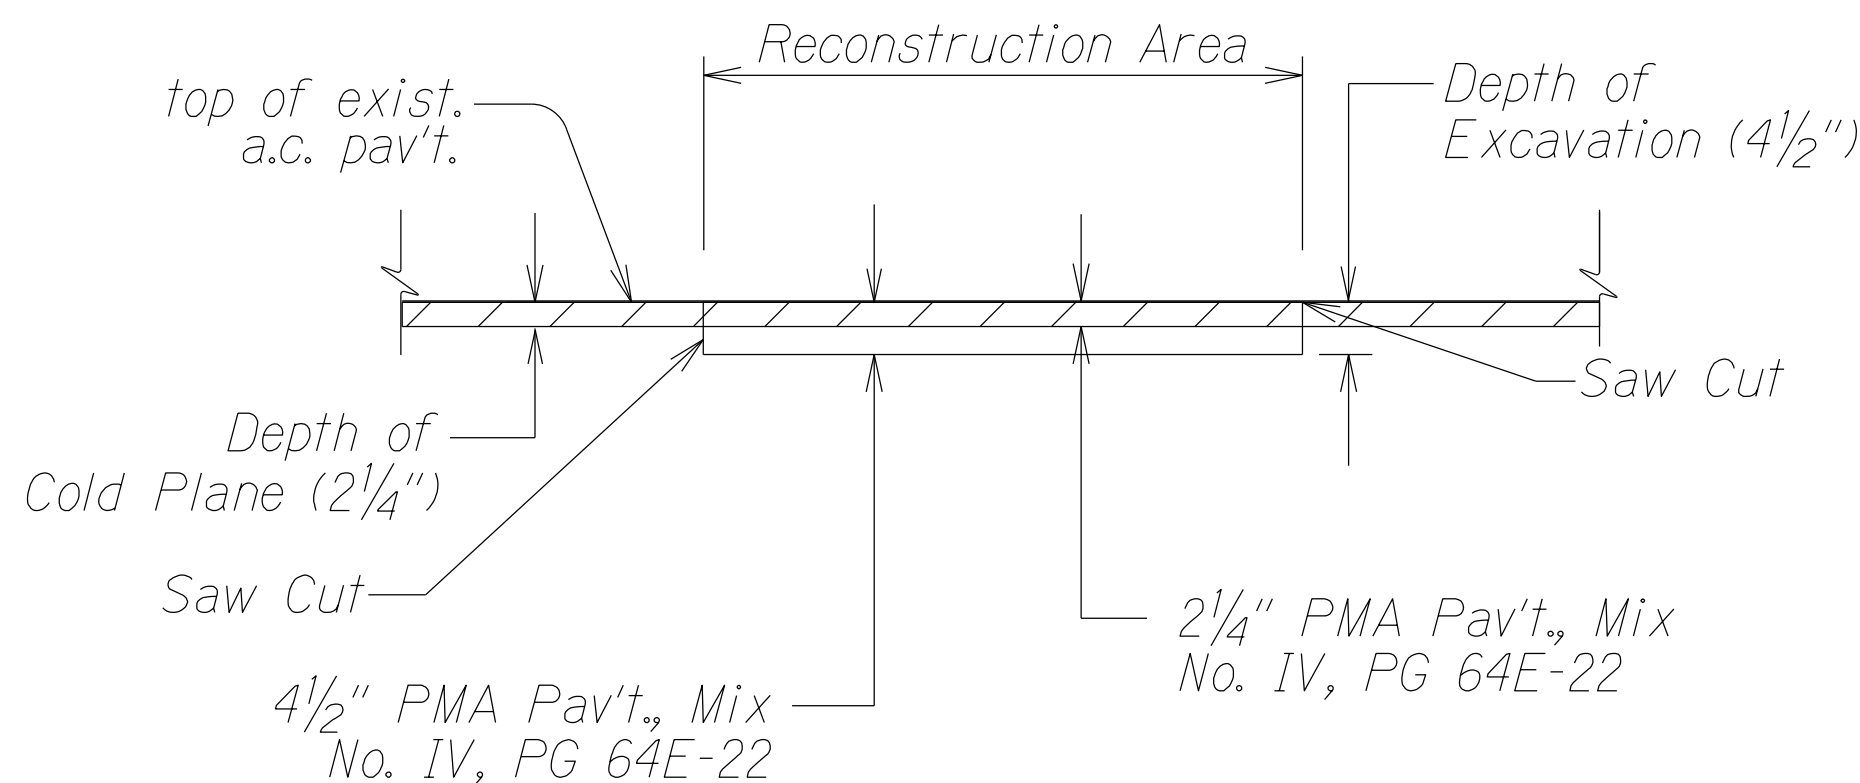

A.C. PAVEMENT RECONSTRUCTION DETAIL  
Not to Scale

Note:  
Reconstruct weakened pavement areas prior to cold plane. The exposed remaining base course or subbase materials should be properly recompact to dense and unyielding conditions prior to placement of the asphalt concrete base layer.

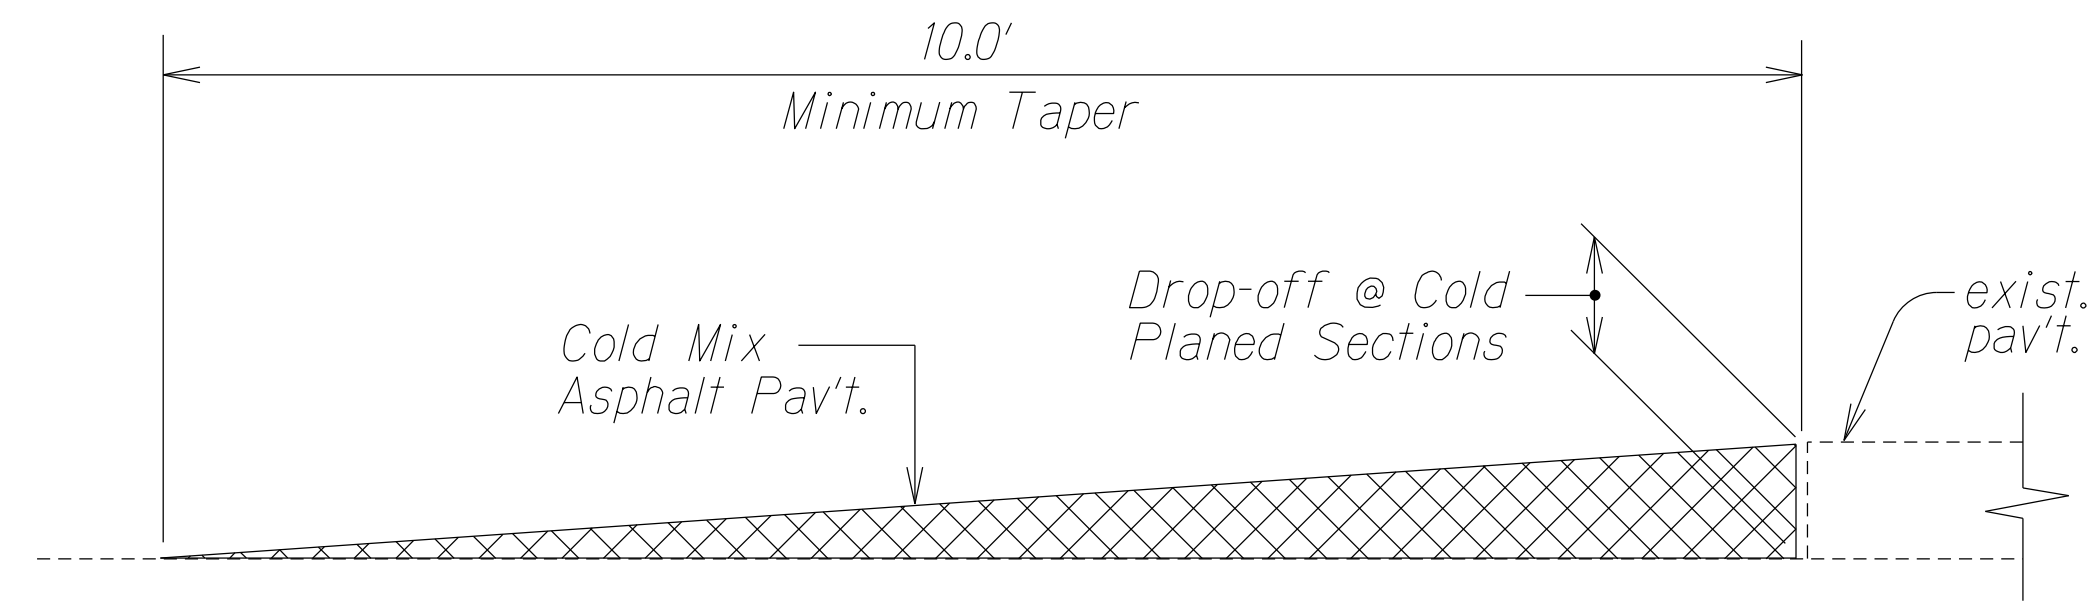

TEMPORARY TRANSITION AT COLD PLANED AREAS  
Not to Scale

Note: Contractor shall construct temporary pavement taper to prevent sharp pavement drop-offs at all cold planed sections. Prior to final PMA Pavement, Mix No. IV placement, temporary pavement taper shall be removed.

8/11/22		Cold Planed Transition to Exist. A.C. Pavement at the Beginning and End of Project Detail
8/11/22		Revise A.C. Pavement Reconstruction Detail
DATE	REVISION	
STATE OF HAWAII DEPARTMENT OF TRANSPORTATION HIGHWAYS DIVISION		
<u>TYPICAL SECTIONS</u>		
<u>KUHIO HIGHWAY RESURFACING</u> <u>Kahiliholo Road to Ka Haku Road</u> <u>Federal-Aid Project No. STP-056-1(064)</u>		
Not to Scale		Date: January 2022
SHEET No. 3 OF 3 SHEETS		