


FED. ROAD DIST. NO.	STATE	FED-AID PROJ. NO.	FISCAL YEAR	SHEET NO.	TOTAL SHEETS
HAWAII	HAW.	NH-056-110621	2023	ADD.16	33

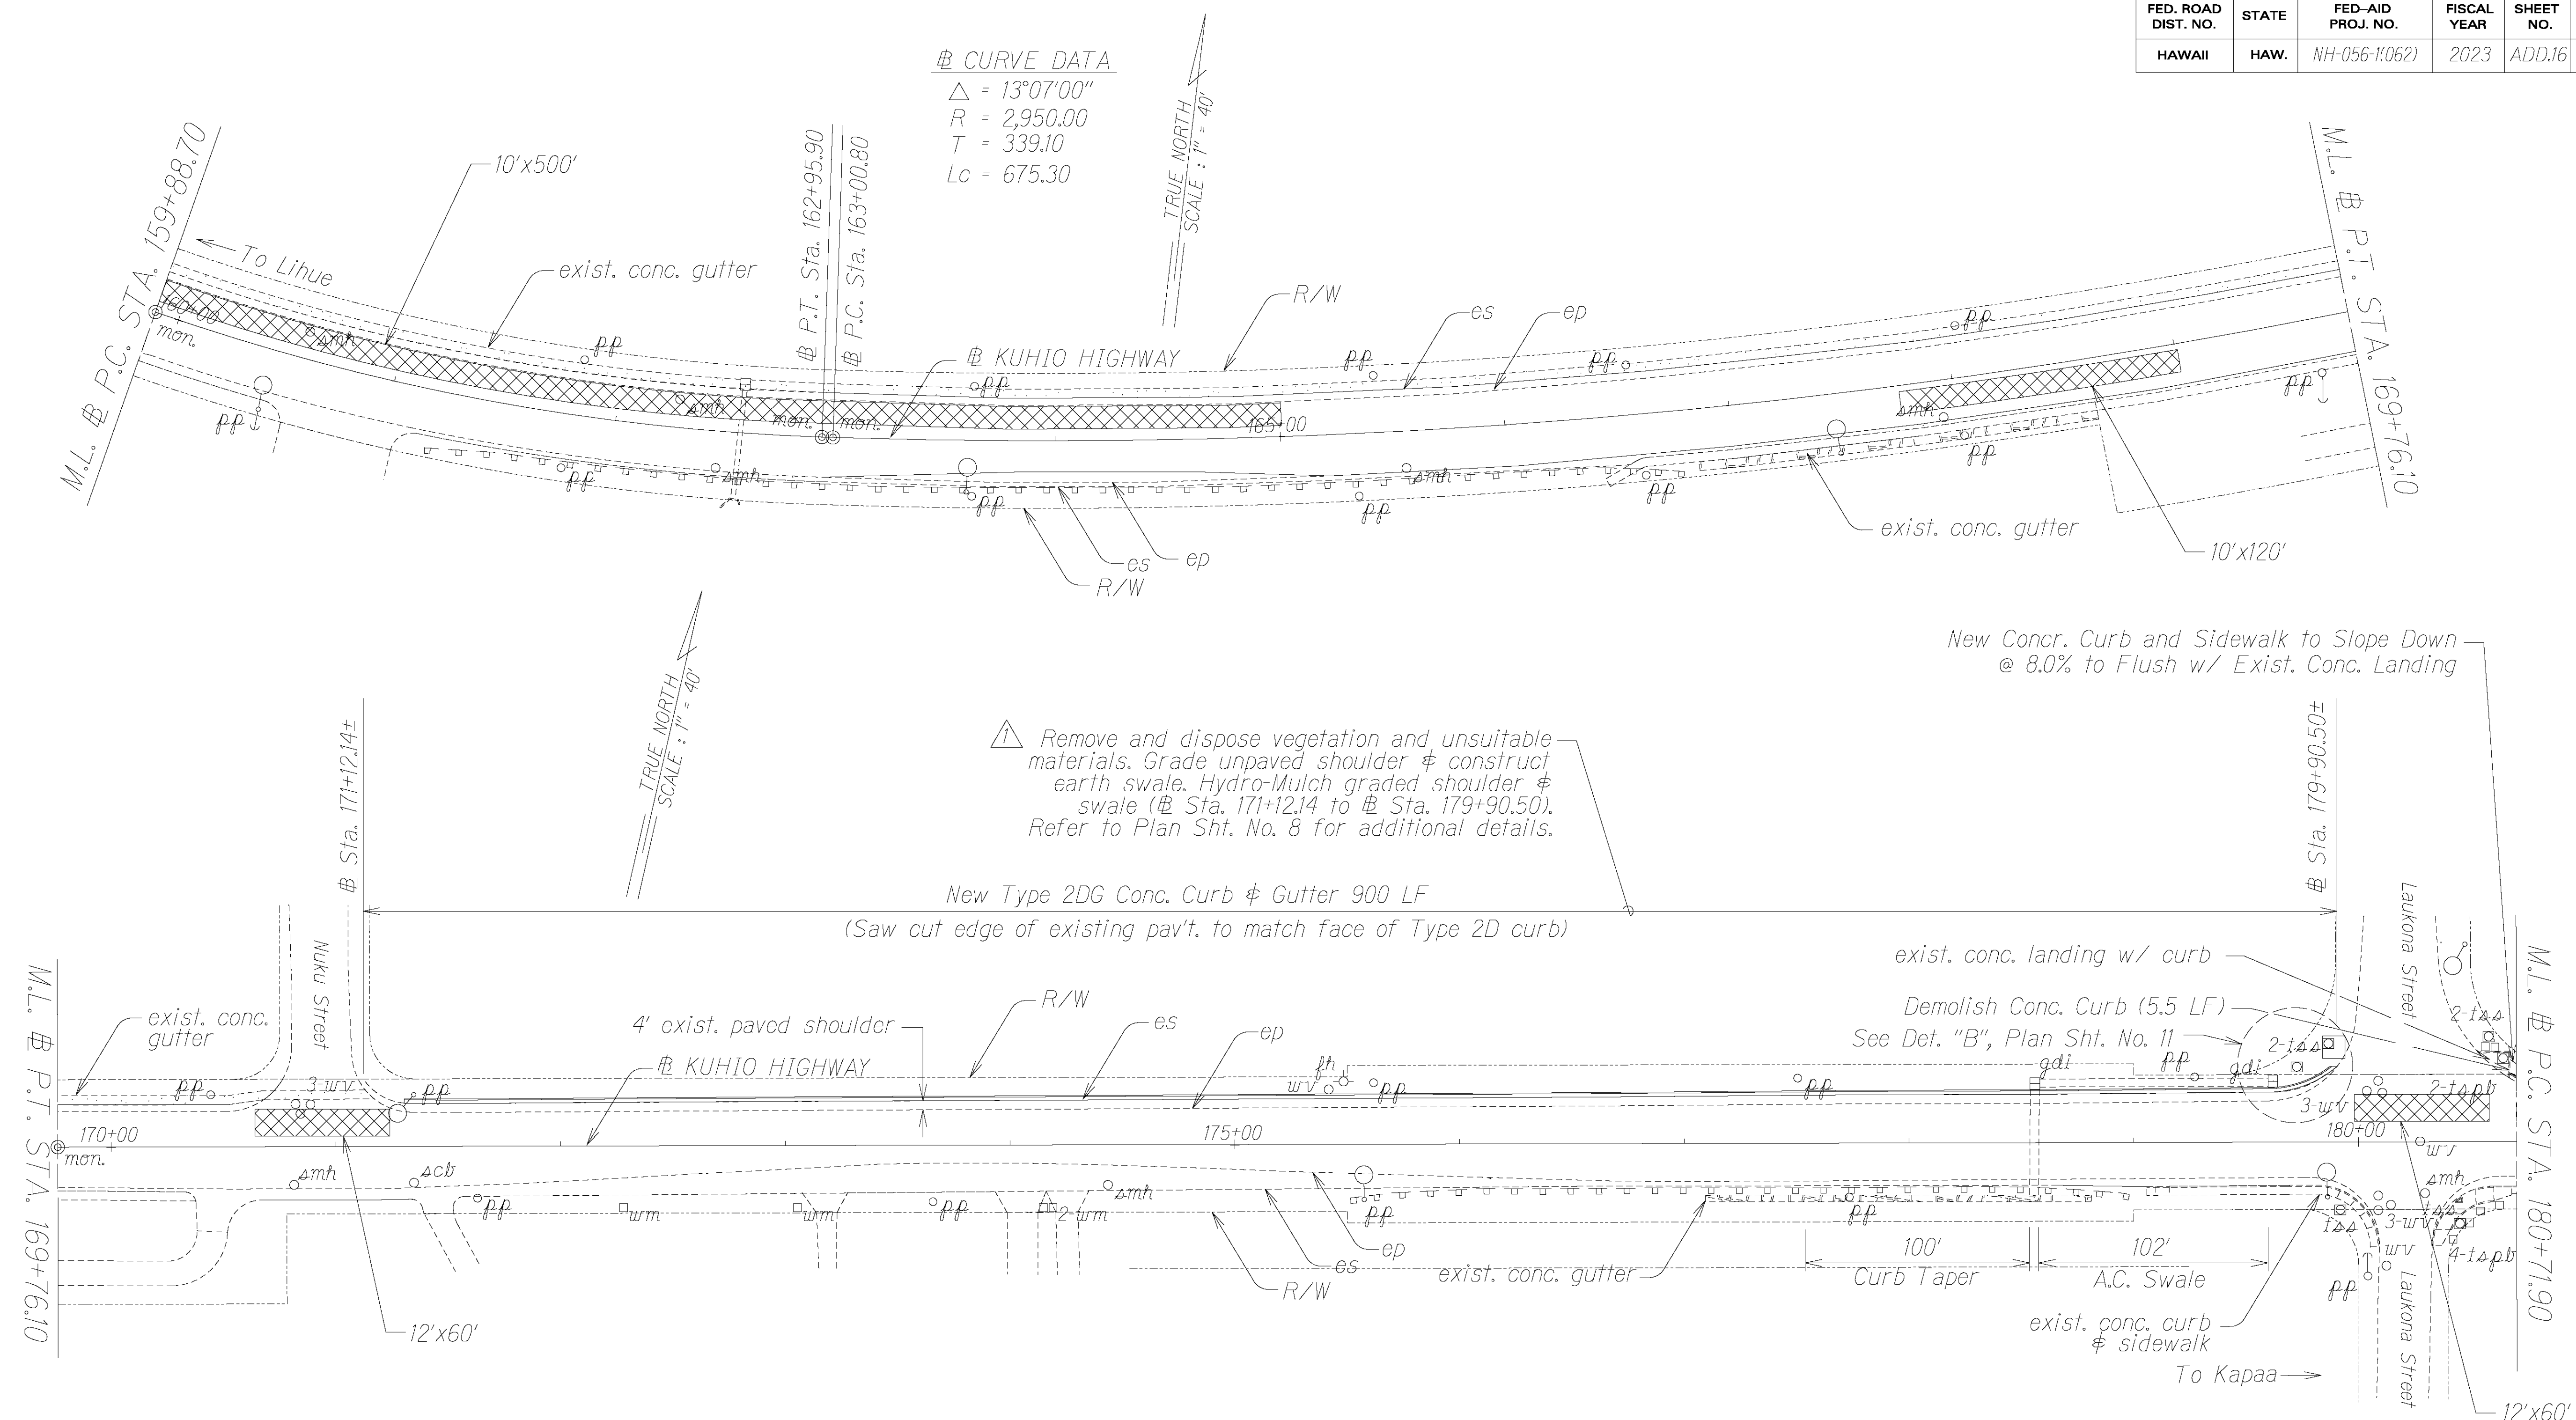

1/06/23	 Notes on Remove & dispose – vegetation and unsuitable materials
DATE	REVISION
STATE OF HAWAII DEPARTMENT OF TRANSPORTATION HIGHWAYS DIVISION <u>ROADWAY PLAN</u> KUHIO HIGHWAY RESURFACING Lauikini Road to Kapule Highway Federal-Aid Project No. NH-056-1(062)	
Scale: 1" = 40' Date: Jan. 2023	
SHEET No. 3 OF 6 SHEETS	