


INDEX TO DRAWINGS	
SHEET NO.	DESCRIPTION
1	TITLE SHEET
2	PLAN AND GENERAL NOTES

STATE OF HAWAII  
DEPARTMENT OF TRANSPORTATION  
HIGHWAYS DIVISION  
HONOLULU, HAWAII  
"AS-BUILT"  
PLANS FOR  
SUBSURFACE INVESTIGATION OF  
KUHIO HIGHWAY  
WAIKAEA BRIDGE WIDENING  
FEDERAL AID PROJECT NO. BR-056-1(35)  
DISTRICT OF KAWAIHAU  
ISLAND OF KAUAI

NO SIGNIFICANT CHANGES WERE MADE DURING CONSTRUCTION ON THESE PLANS EXCEPT CHANGES IN THE ORIGINAL THEORETICAL QUANTITIES. FOR ACTUAL QUANTITIES, REFER TO PROJECT LEDGER AND/OR COMPUTATION BOOK.



Ronald Carter 12/27/95  
RESIDENT ENGINEER DATE

UNIT "C"  
DESIGNED BY  
R. HIRONAKA  
P.S. & E. BY  
587-2250  
PHONE  
JULY, 1994  
DATE

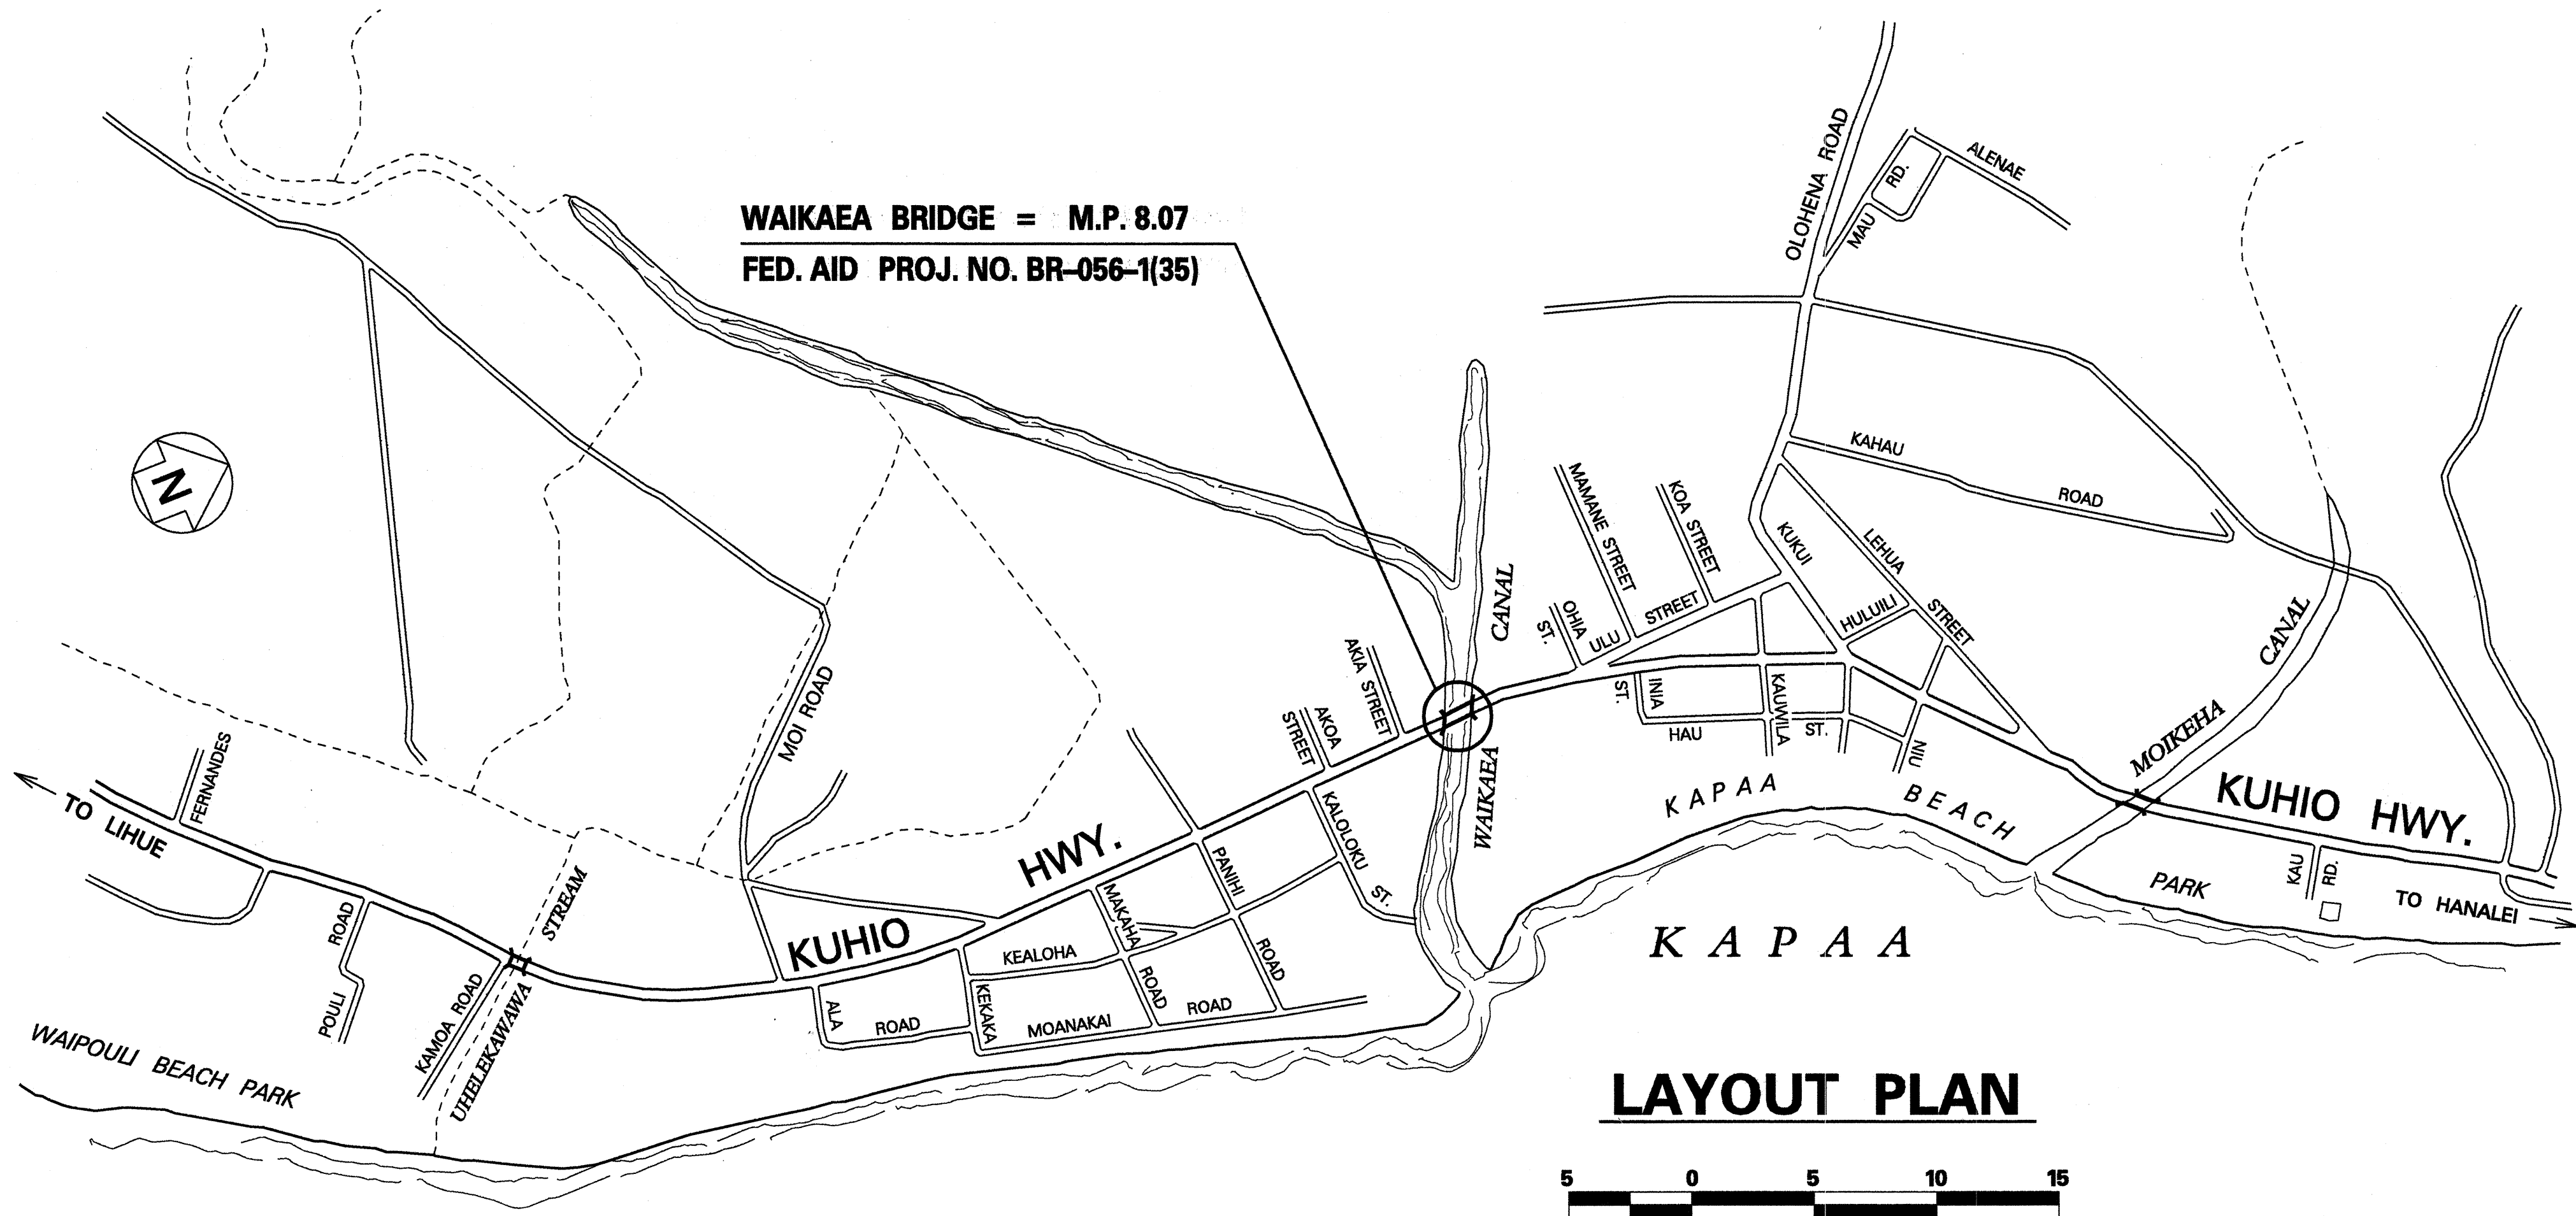


LAYOUT PLAN  
SCALE IN HUNDRED FEET

FED. ROAD DIST. NO.	STATE	FED. AID PROJ. NO.	FISCAL YEAR	SHEET NO.	TOTAL SHEETS
HAWAII	HAW.	BR-056-1(35)	1995	1	2

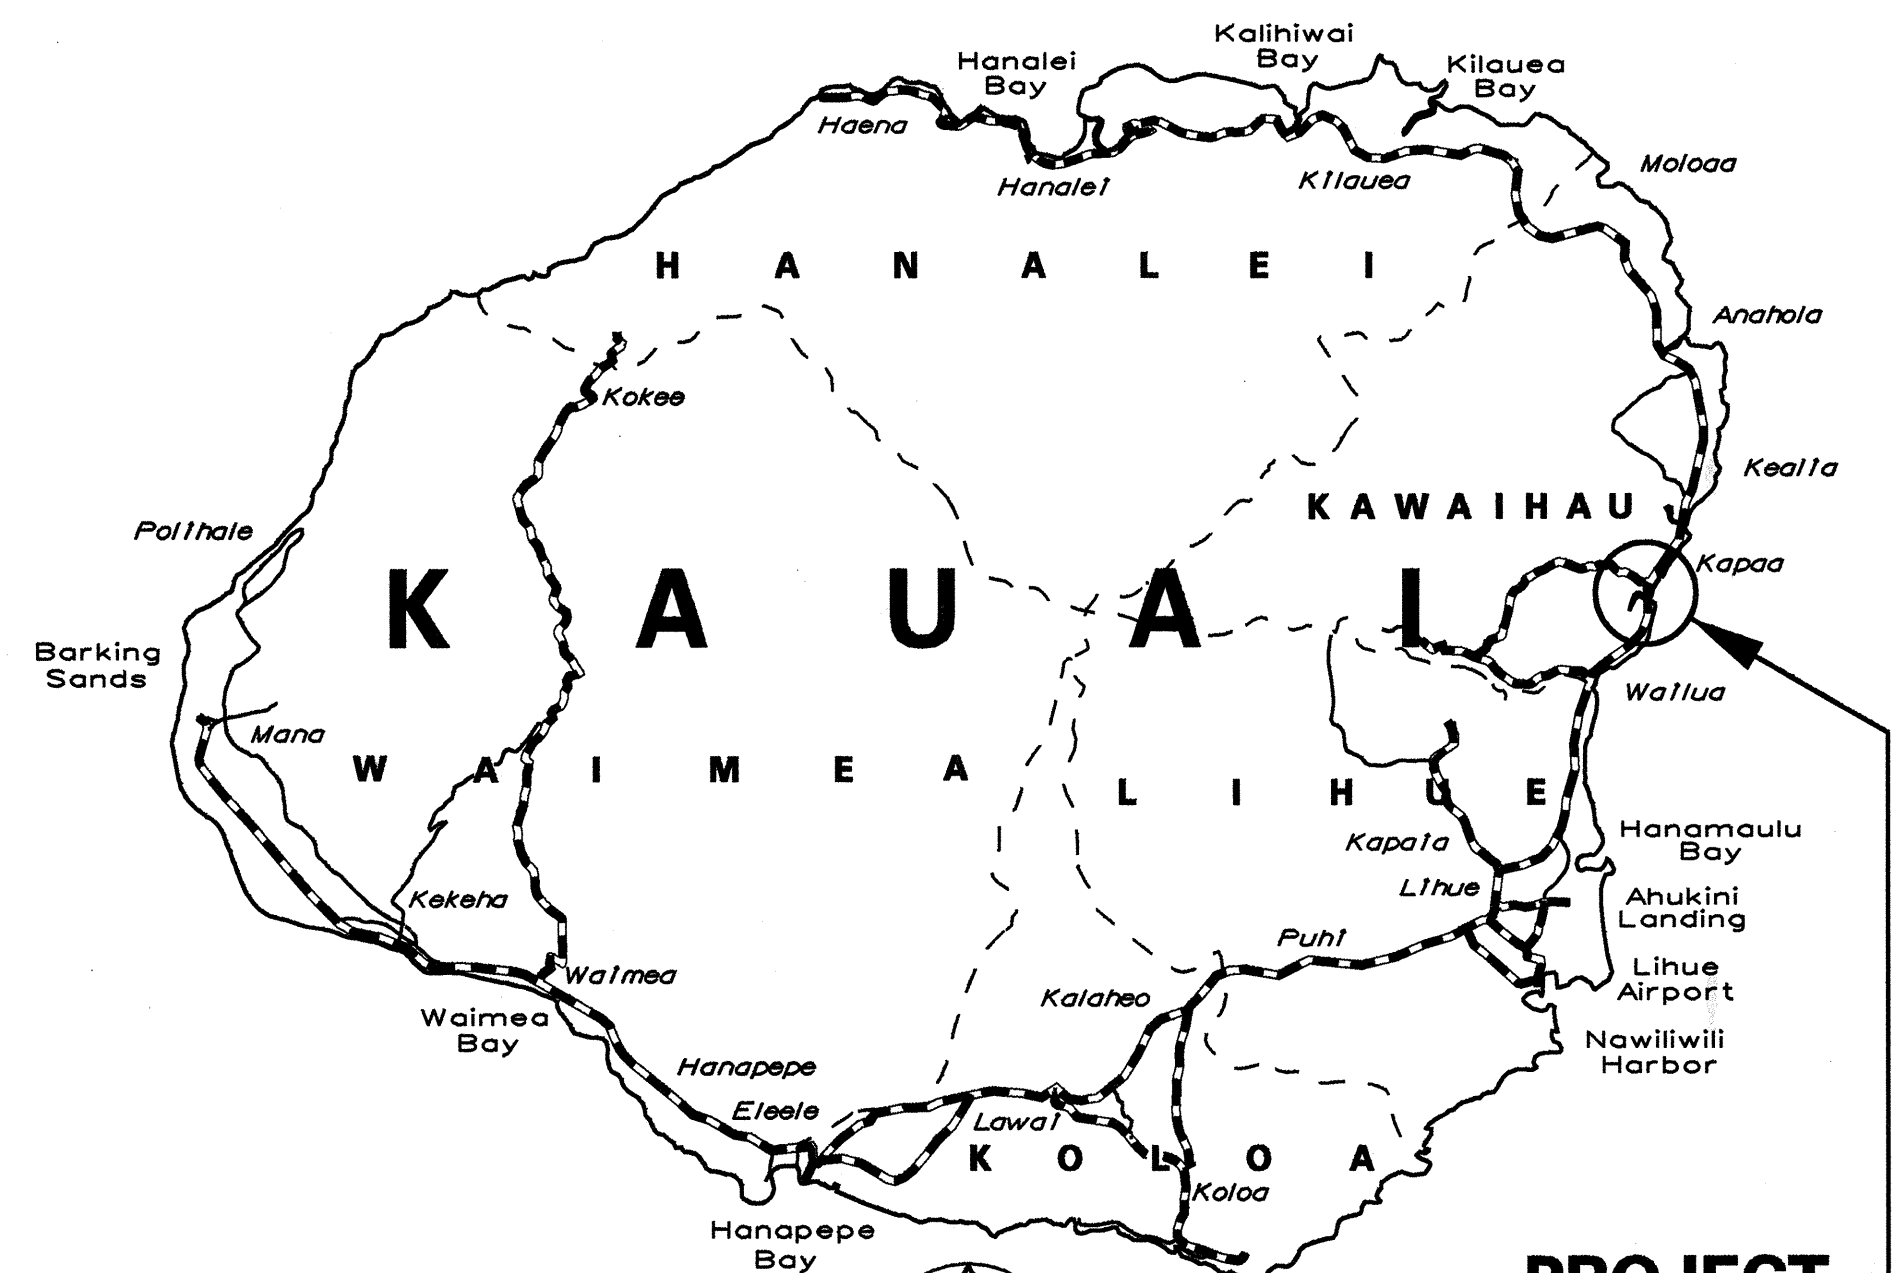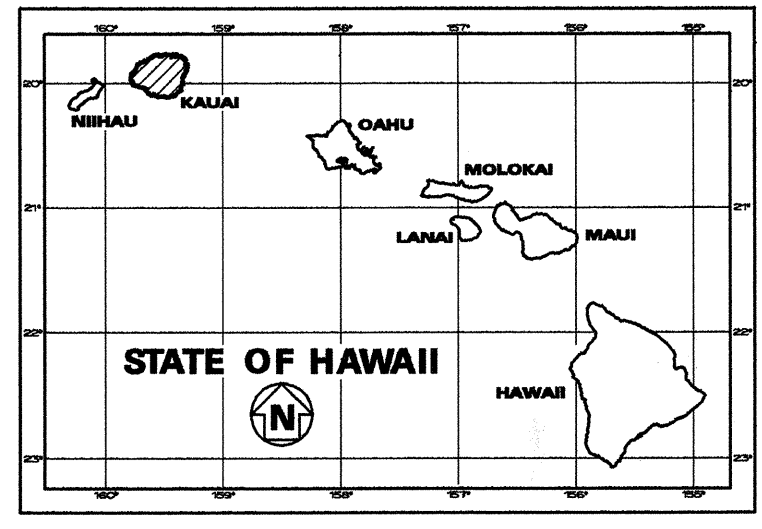

PROJECT LOCATION

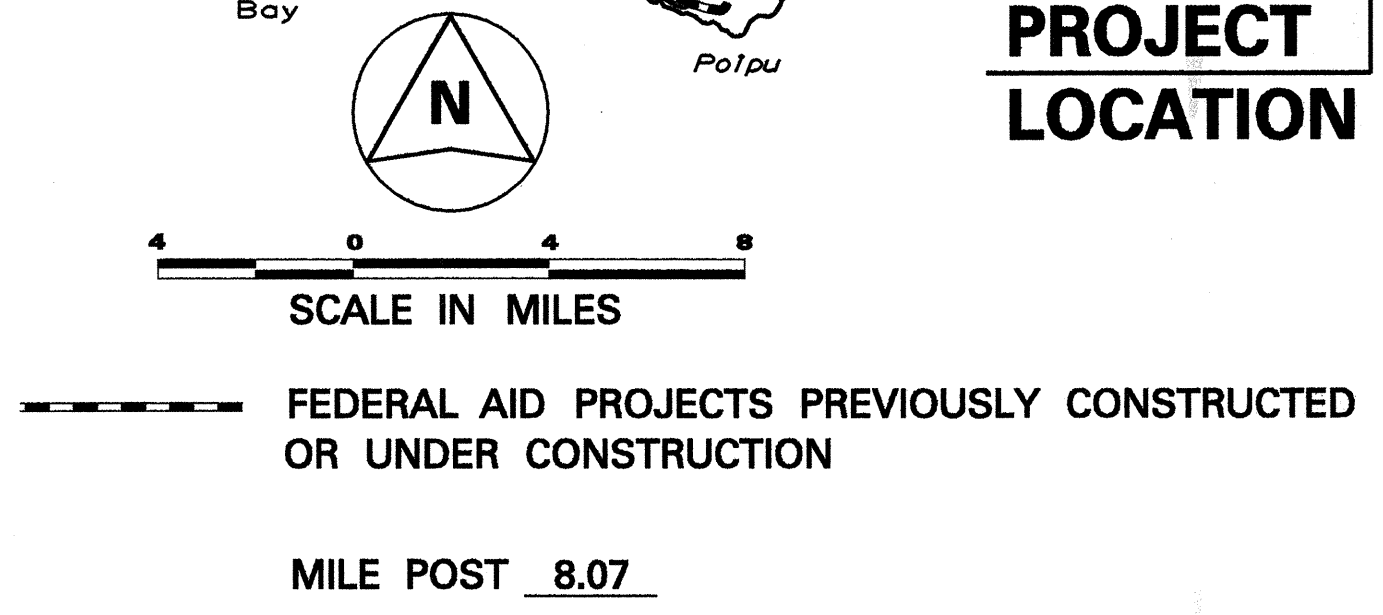

DESIGN DESIGNATION

ADT (1993)	30,400
ADT (2013)	39,300
DHV	3,400
D	60/40
T	2.5 %
T <sub>24</sub>	2.5 %

DEPARTMENT OF TRANSPORTATION  
STATE OF HAWAII  
APPROVED:  
A. Herano 12/21/94  
DIR. OF TRANSPORTATION DATE