




FED. ROAD DIST. NO.	STATE	FED-AID PROJ. NO.	FISCAL YEAR	SHEET NO.	TOTAL SHEETS
HAWAII	HAW.	NH-056-1(063)	2023	ADD.34	43

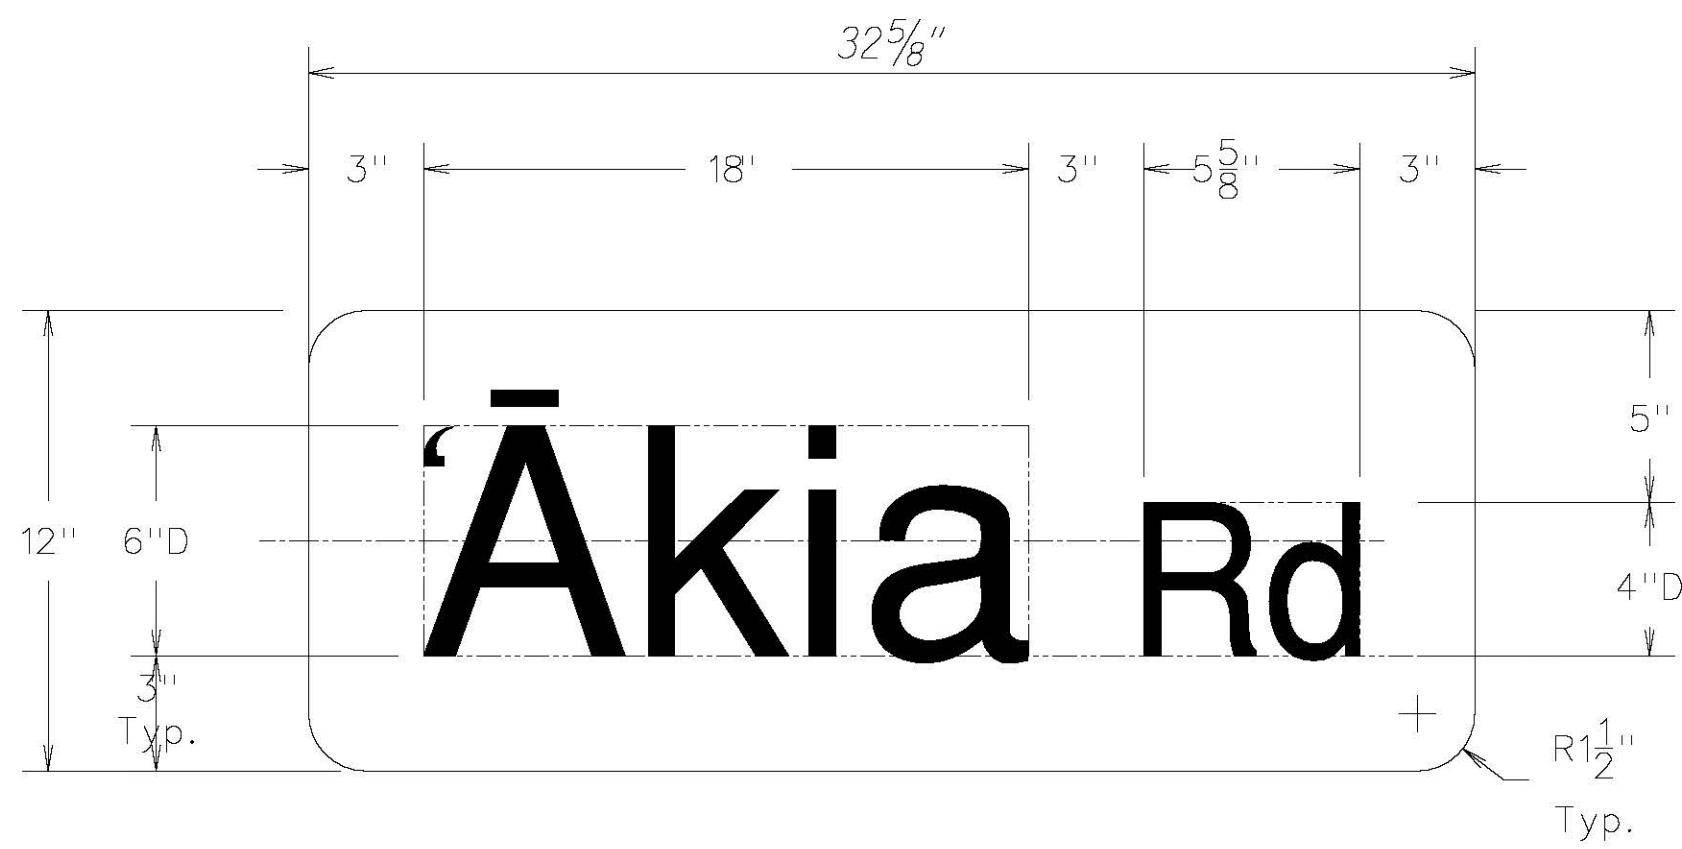


D3-1-1
Not to Scale

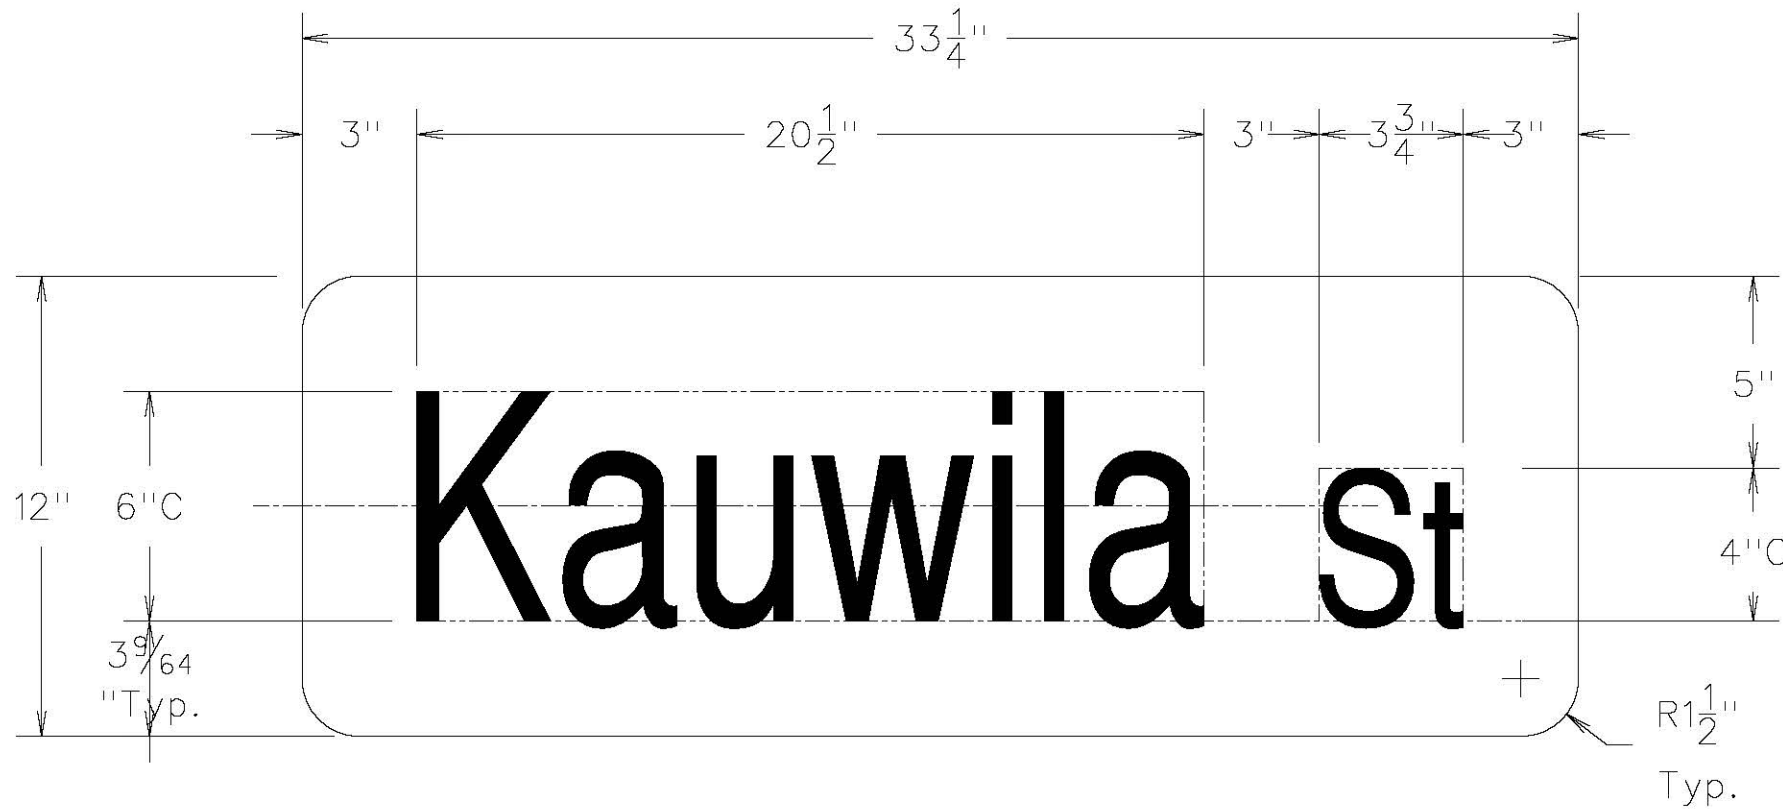


D3-1-5
Not to Scale

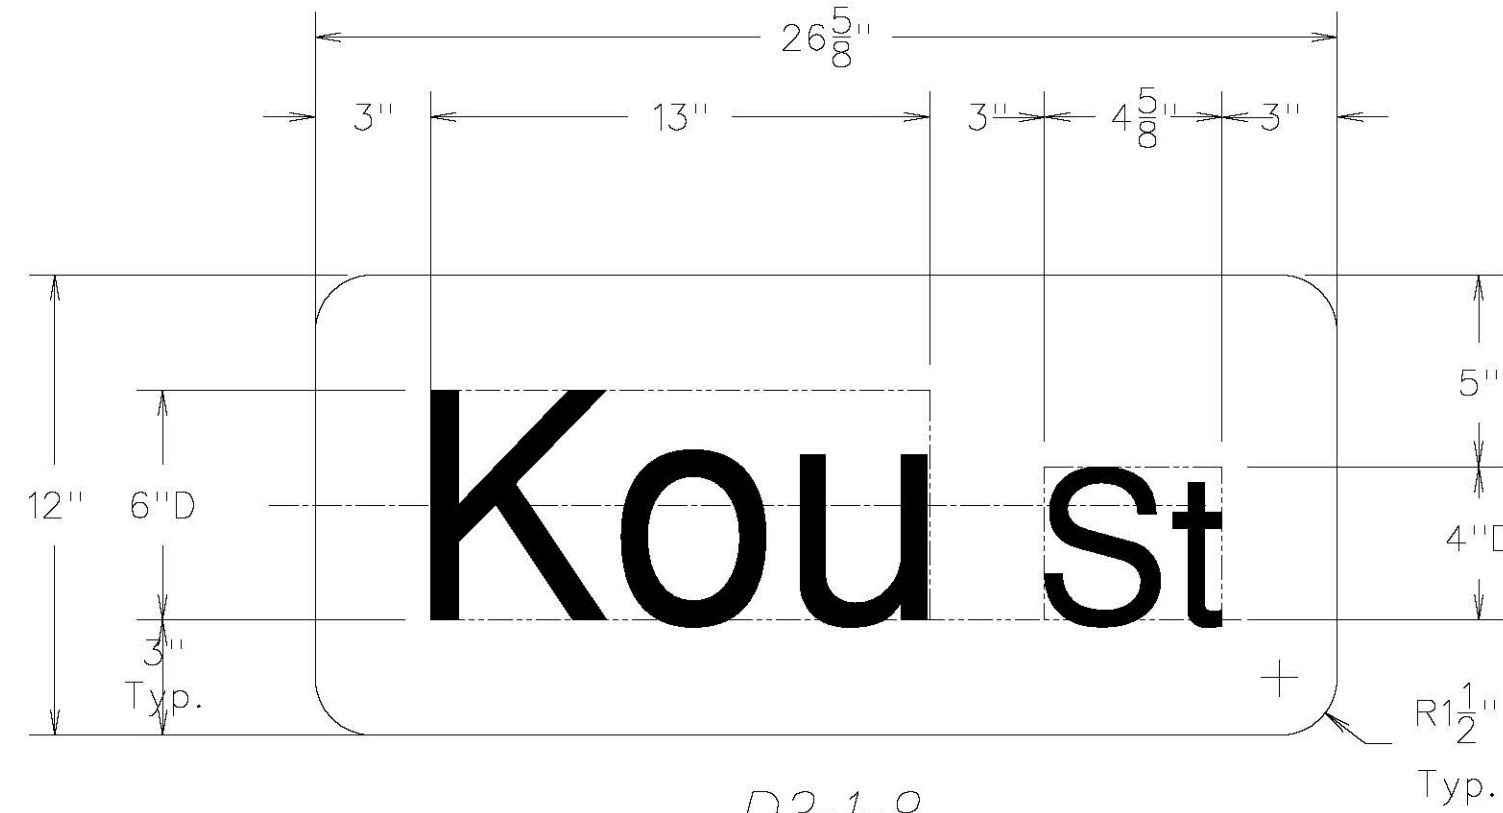


D3-1-8
Not to Scale

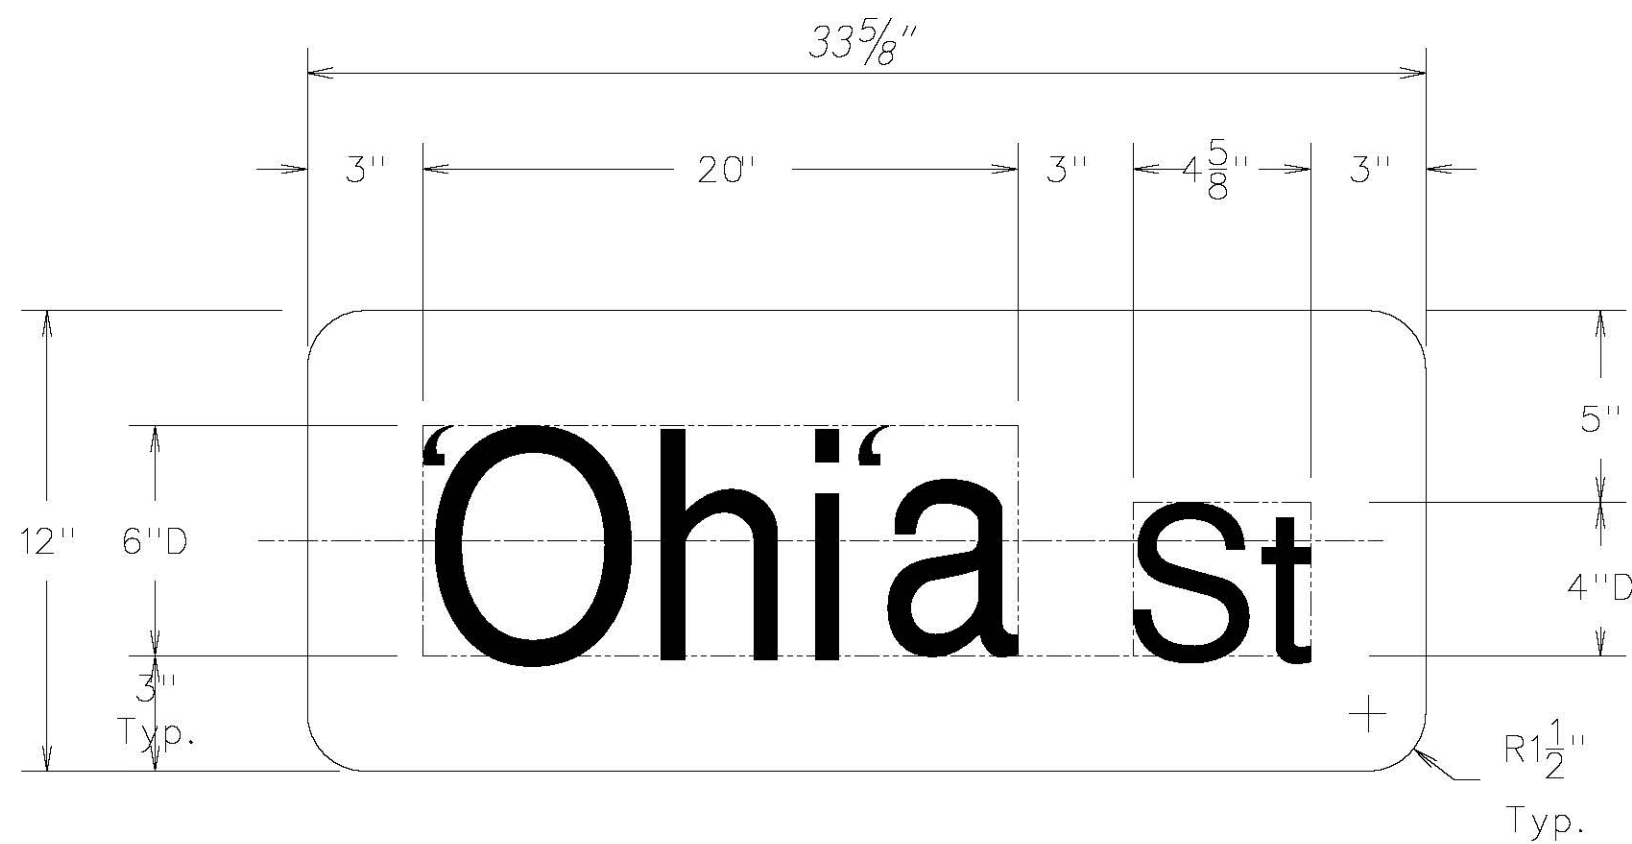


D3-1-2
Not to Scale

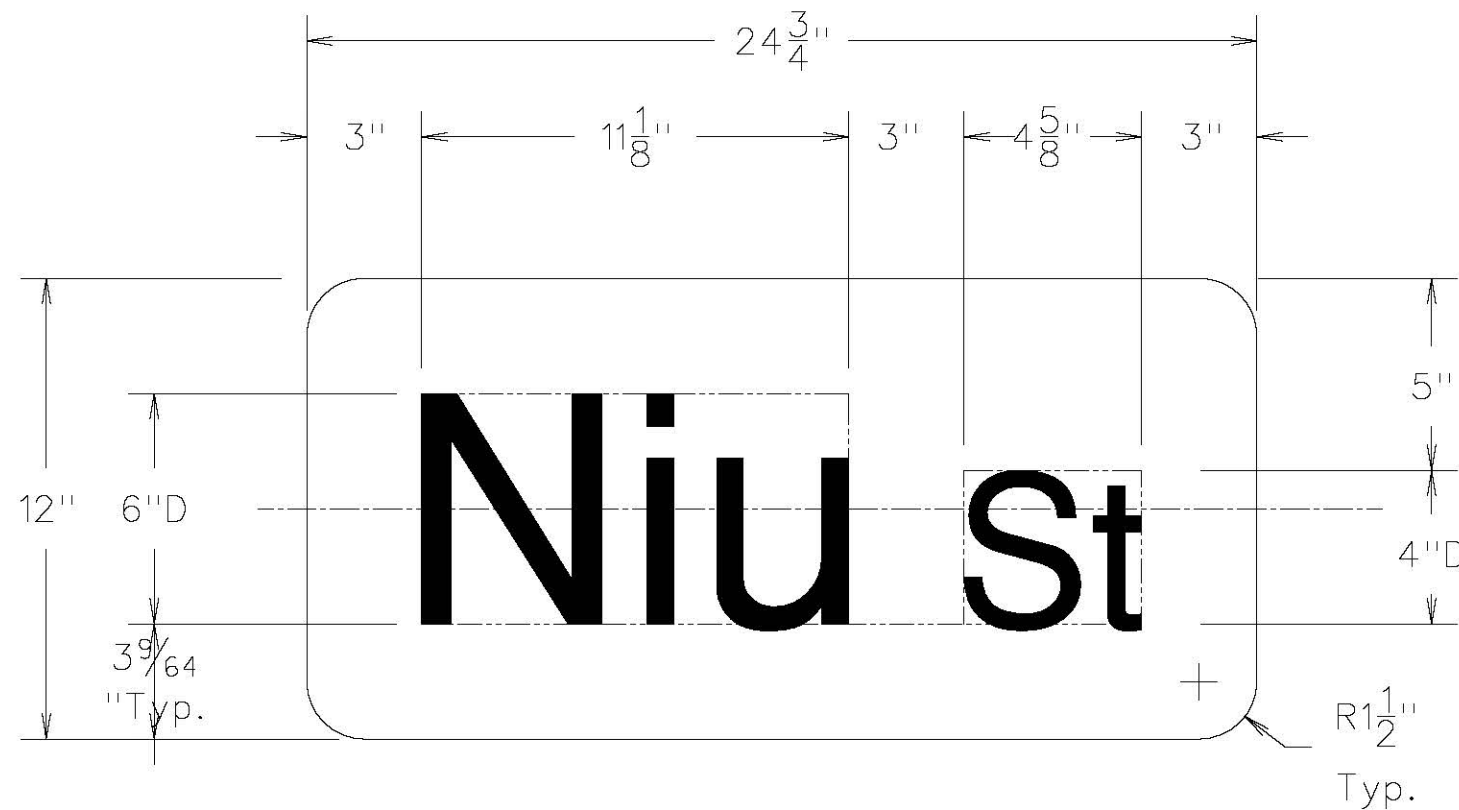


D3-1-6
Not to Scale

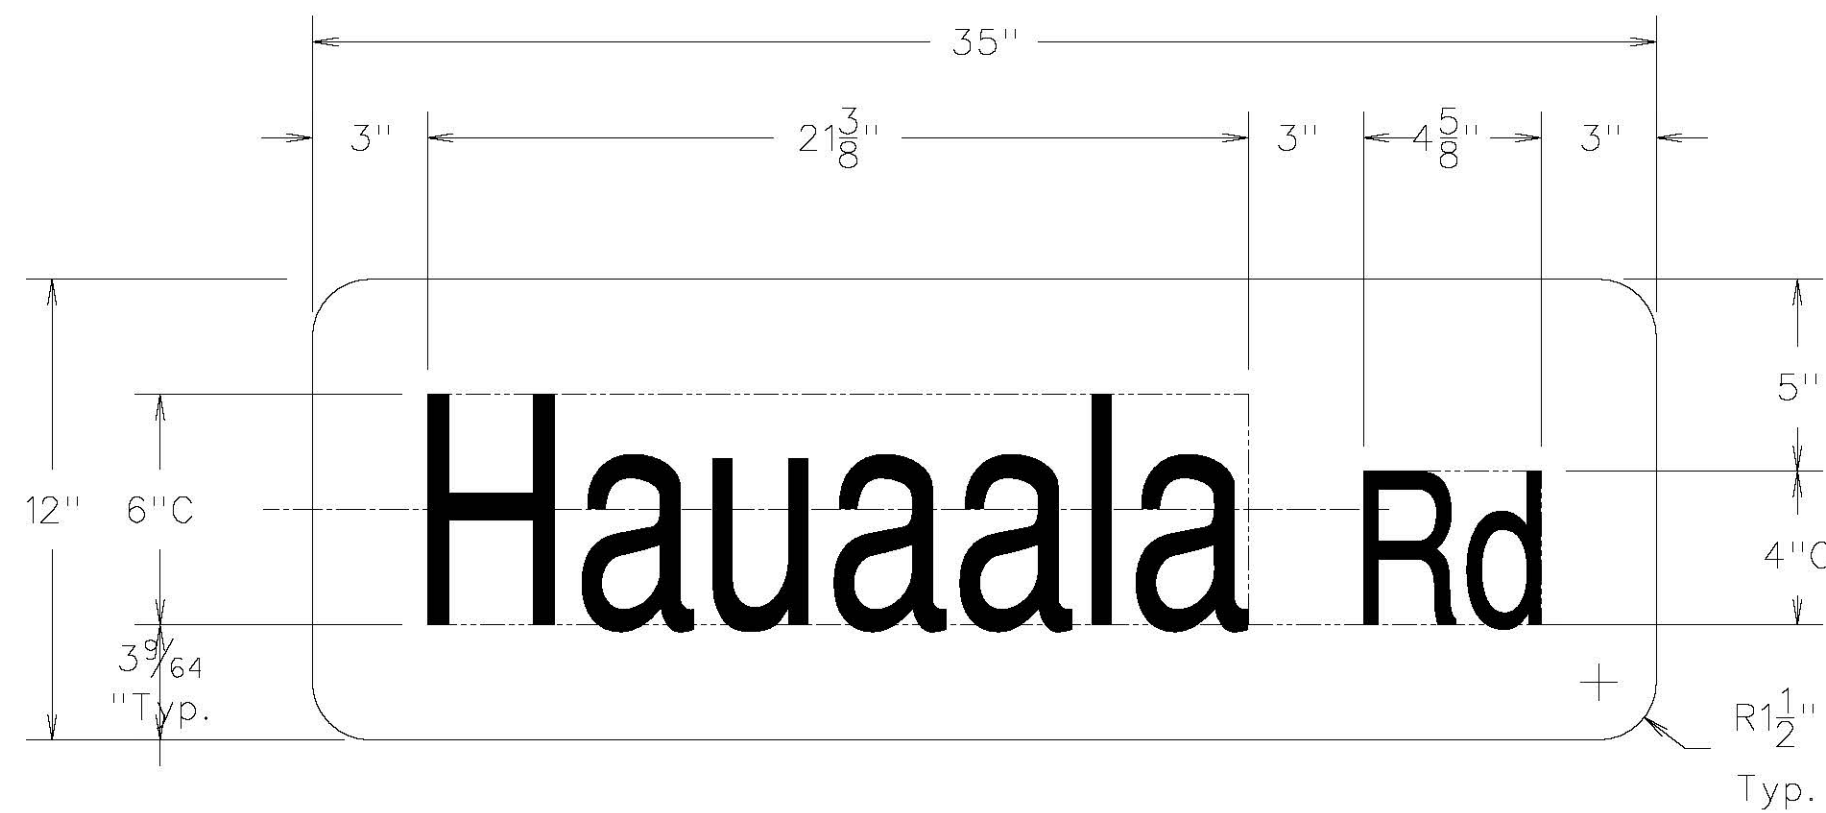


D3-1-9
Not to Scale

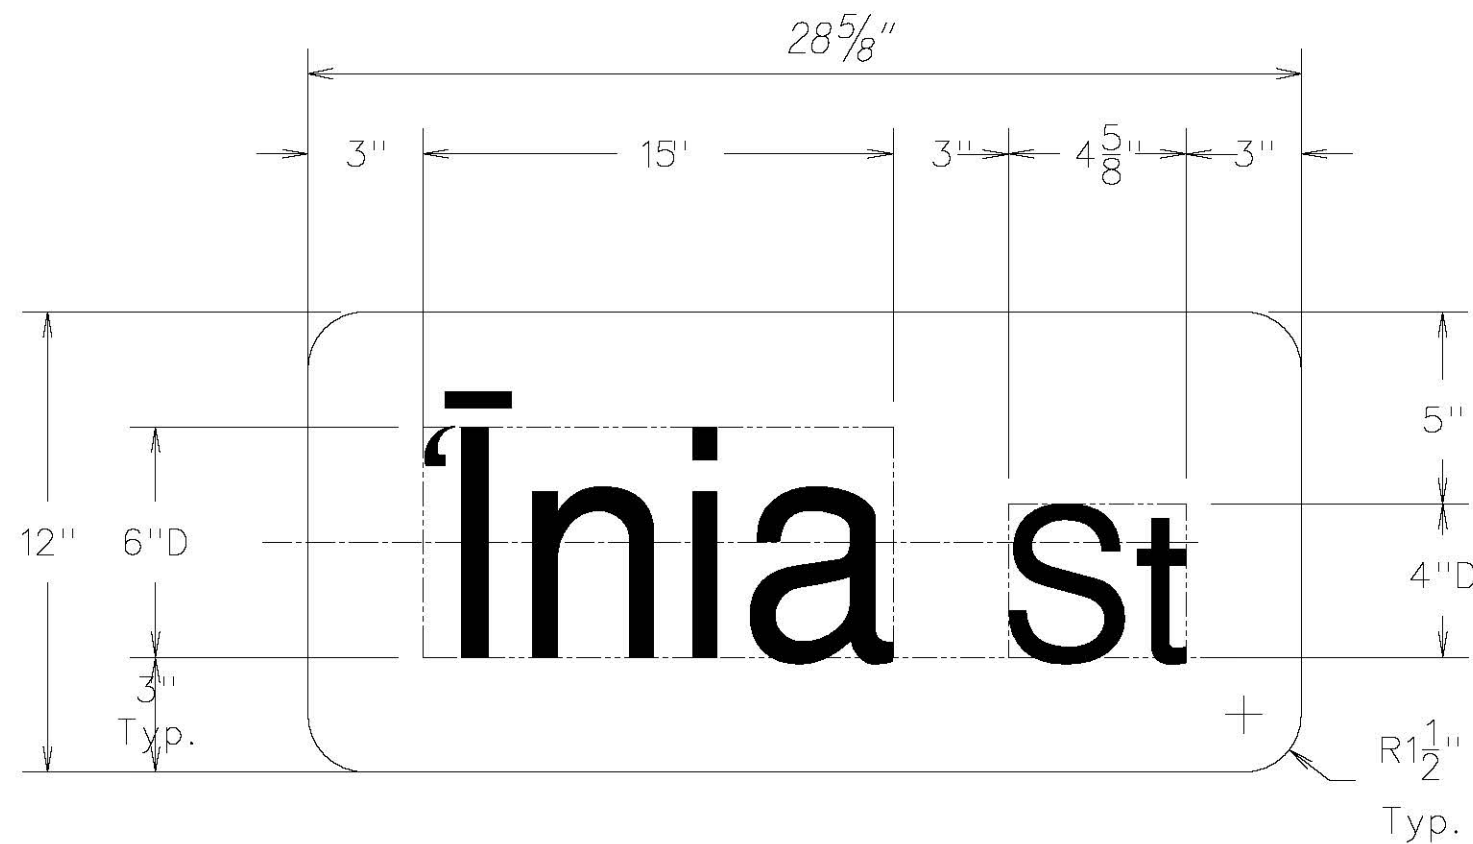

D3-1-4
Not to Scale

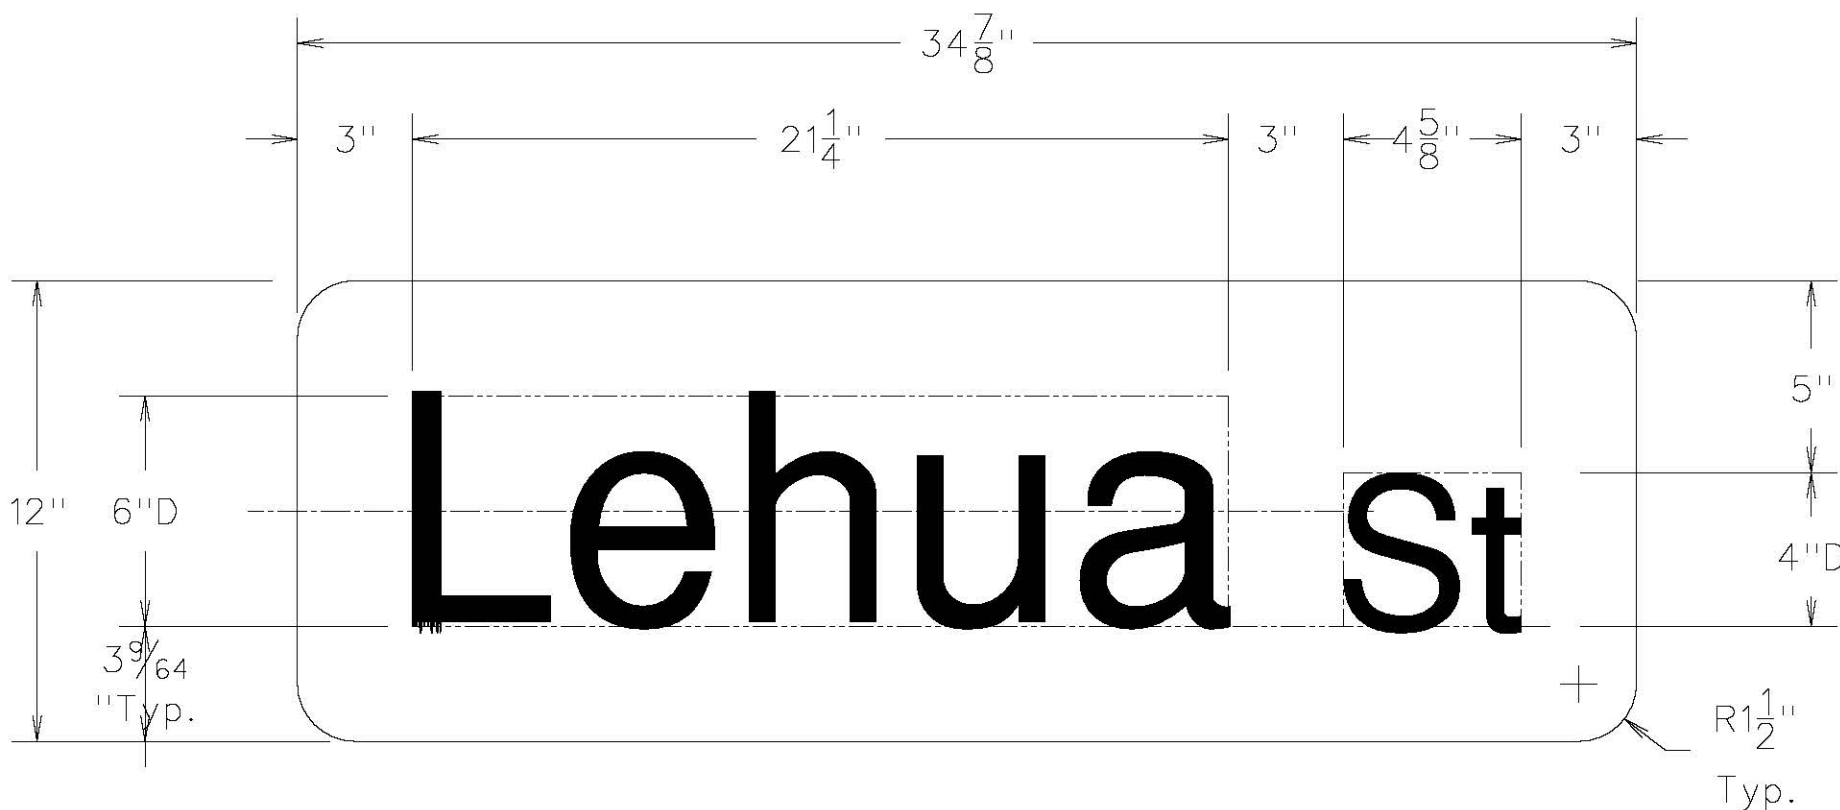

D3-1-7
Not to Scale

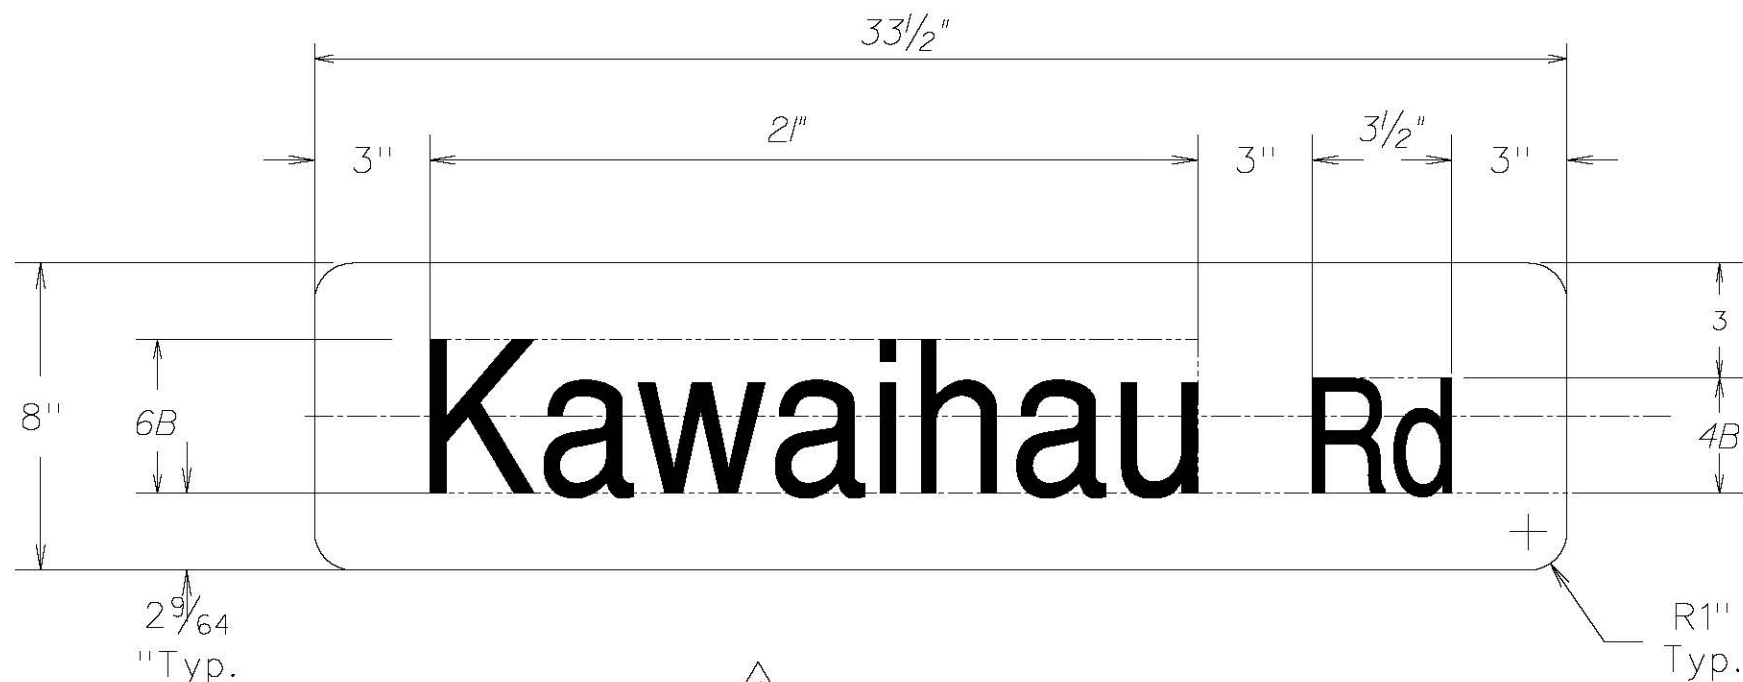

△ D3-1-10
Not to Scale

SURVEY PLOTTED BY	DATE
DRAWN BY	X
DESIGNED BY	X
QUANTITIES BY	X
CHECKED BY	X


ORIGINAL PLAN	NOTE BOOK
4/21/23	4/21/23
N	N

STREET NAME SIGN
Not to Scale

Lettering — White
Background — Green

4/21/23	△ — Revise D3-1-10
DATE	REVISION
STATE OF HAWAII DEPARTMENT OF TRANSPORTATION HIGHWAYS DIVISION	
SIGN DETAIL	
KUHIU HIGHWAY RESURFACING Waikaea Bridge to Mailihuna Road Federal-Aid Project No. NH-056-1(063)	
Scale: As Noted	Date: April 2023
SHEET No. 1 OF 4 SHEETS	


FED. ROAD DIST. NO.	STATE	FED-AID PROJ. NO.	FISCAL YEAR	SHEET NO.	TOTAL SHEETS
HAWAII	HAW.	NH-056-1(063)	2023	ADD.35	43

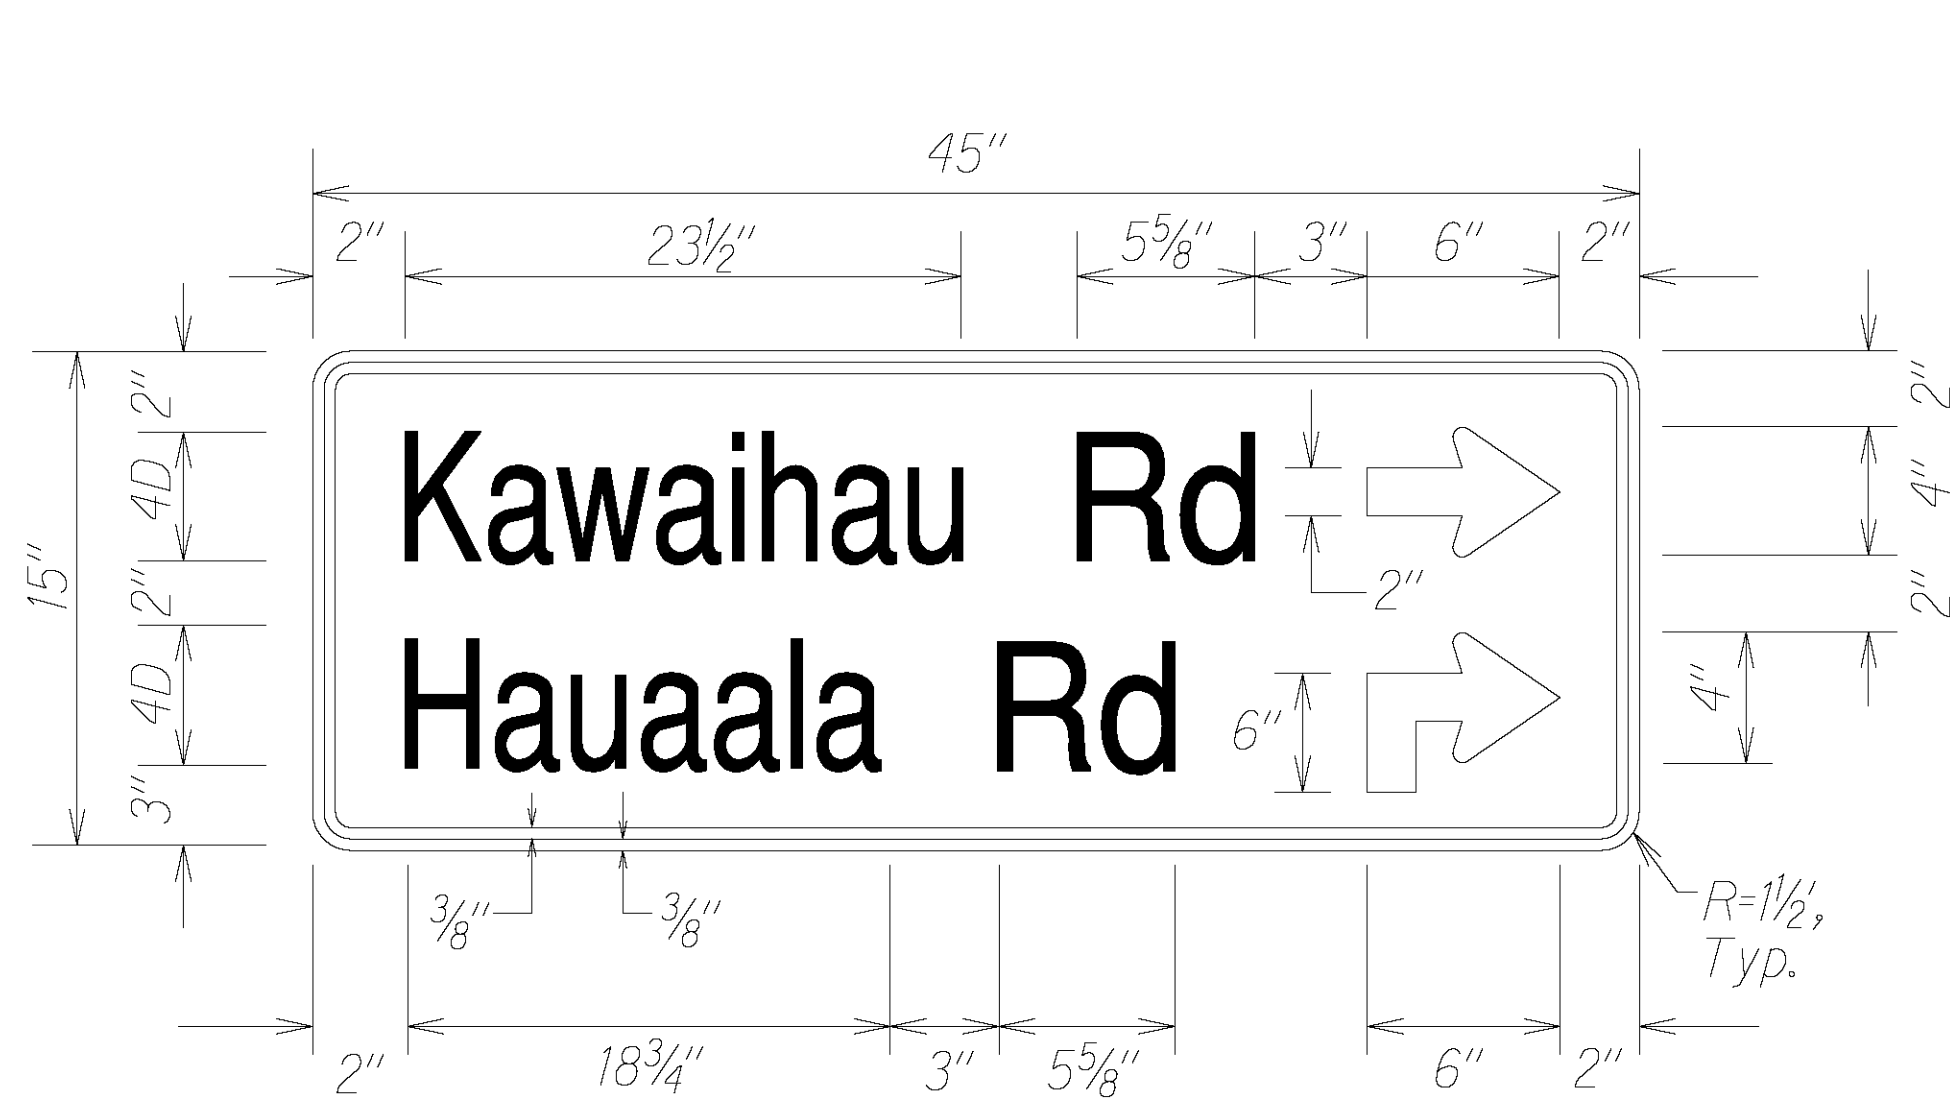

W16-8-1
Not to Scale

ADVANCE STREET NAME SIGN
Not to Scale

Border — Black
Lettering — Black
Background — Yellow

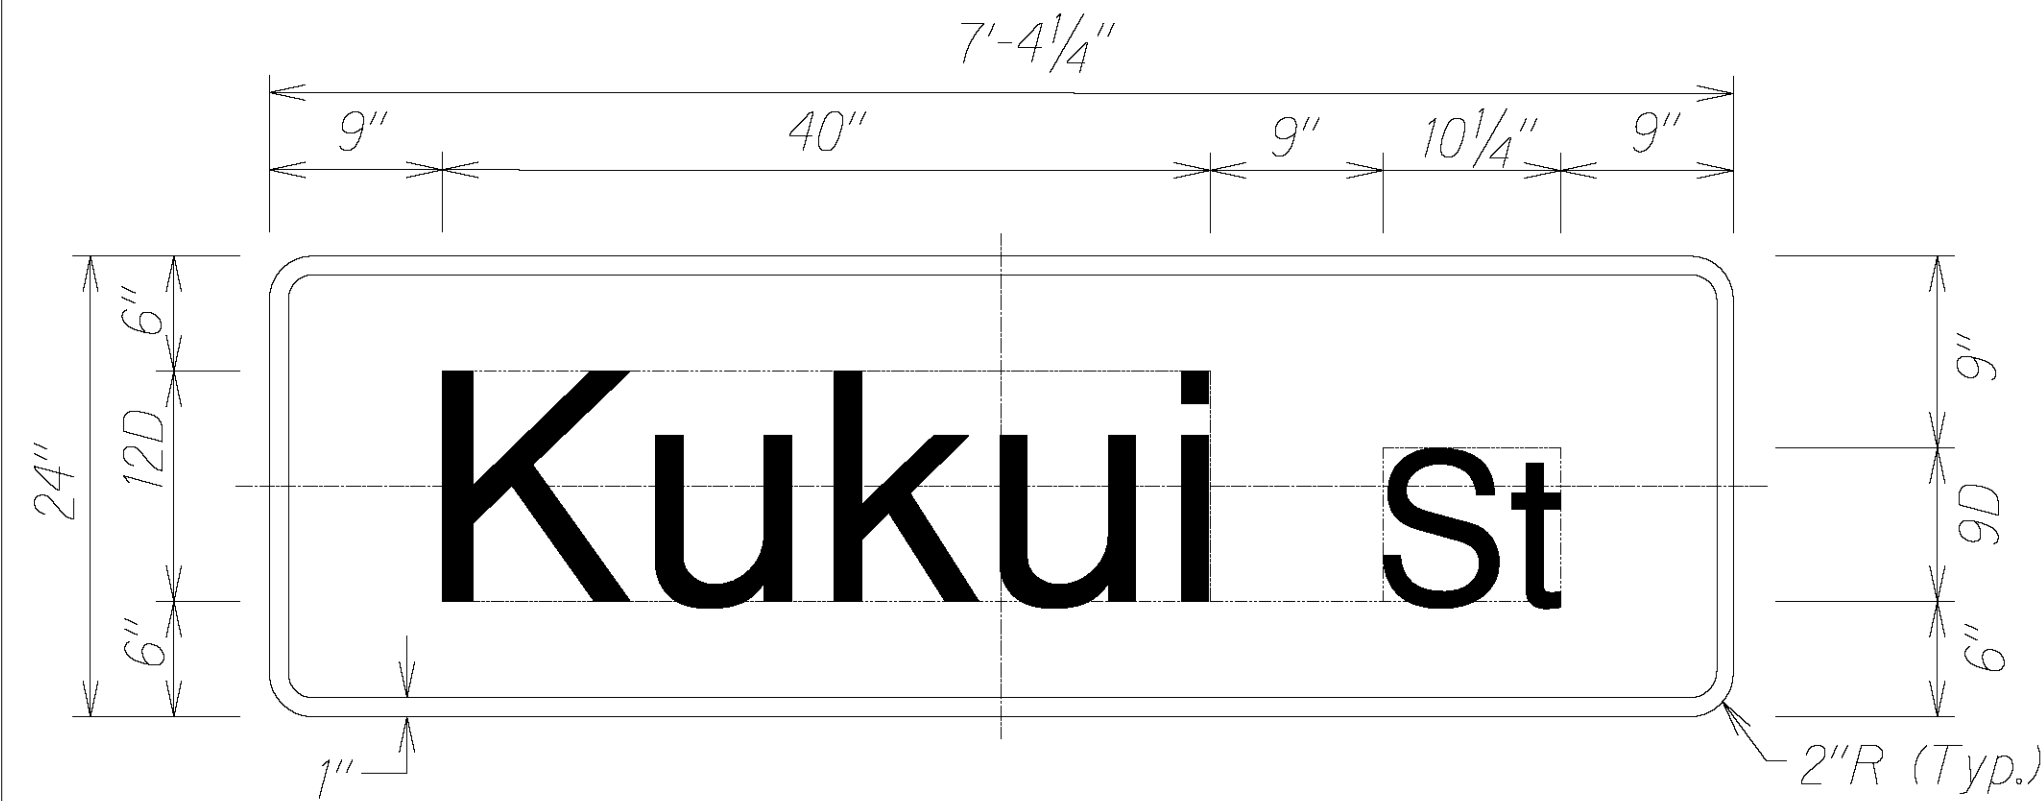

D3-2-1
Not to Scale

STREET NAME SIGN ON TRAFFIC SIGNAL MAST ARM
Not to Scale


Lettering — White
Background — Green
Border — White

Advance Street Name and Acknowledge sign shall be paid under Item No. 631.0400 - Supplemental Plaque and will not be paid separately.




Sign Support: 2-2" Square Tube

D2-1
Not to Scale

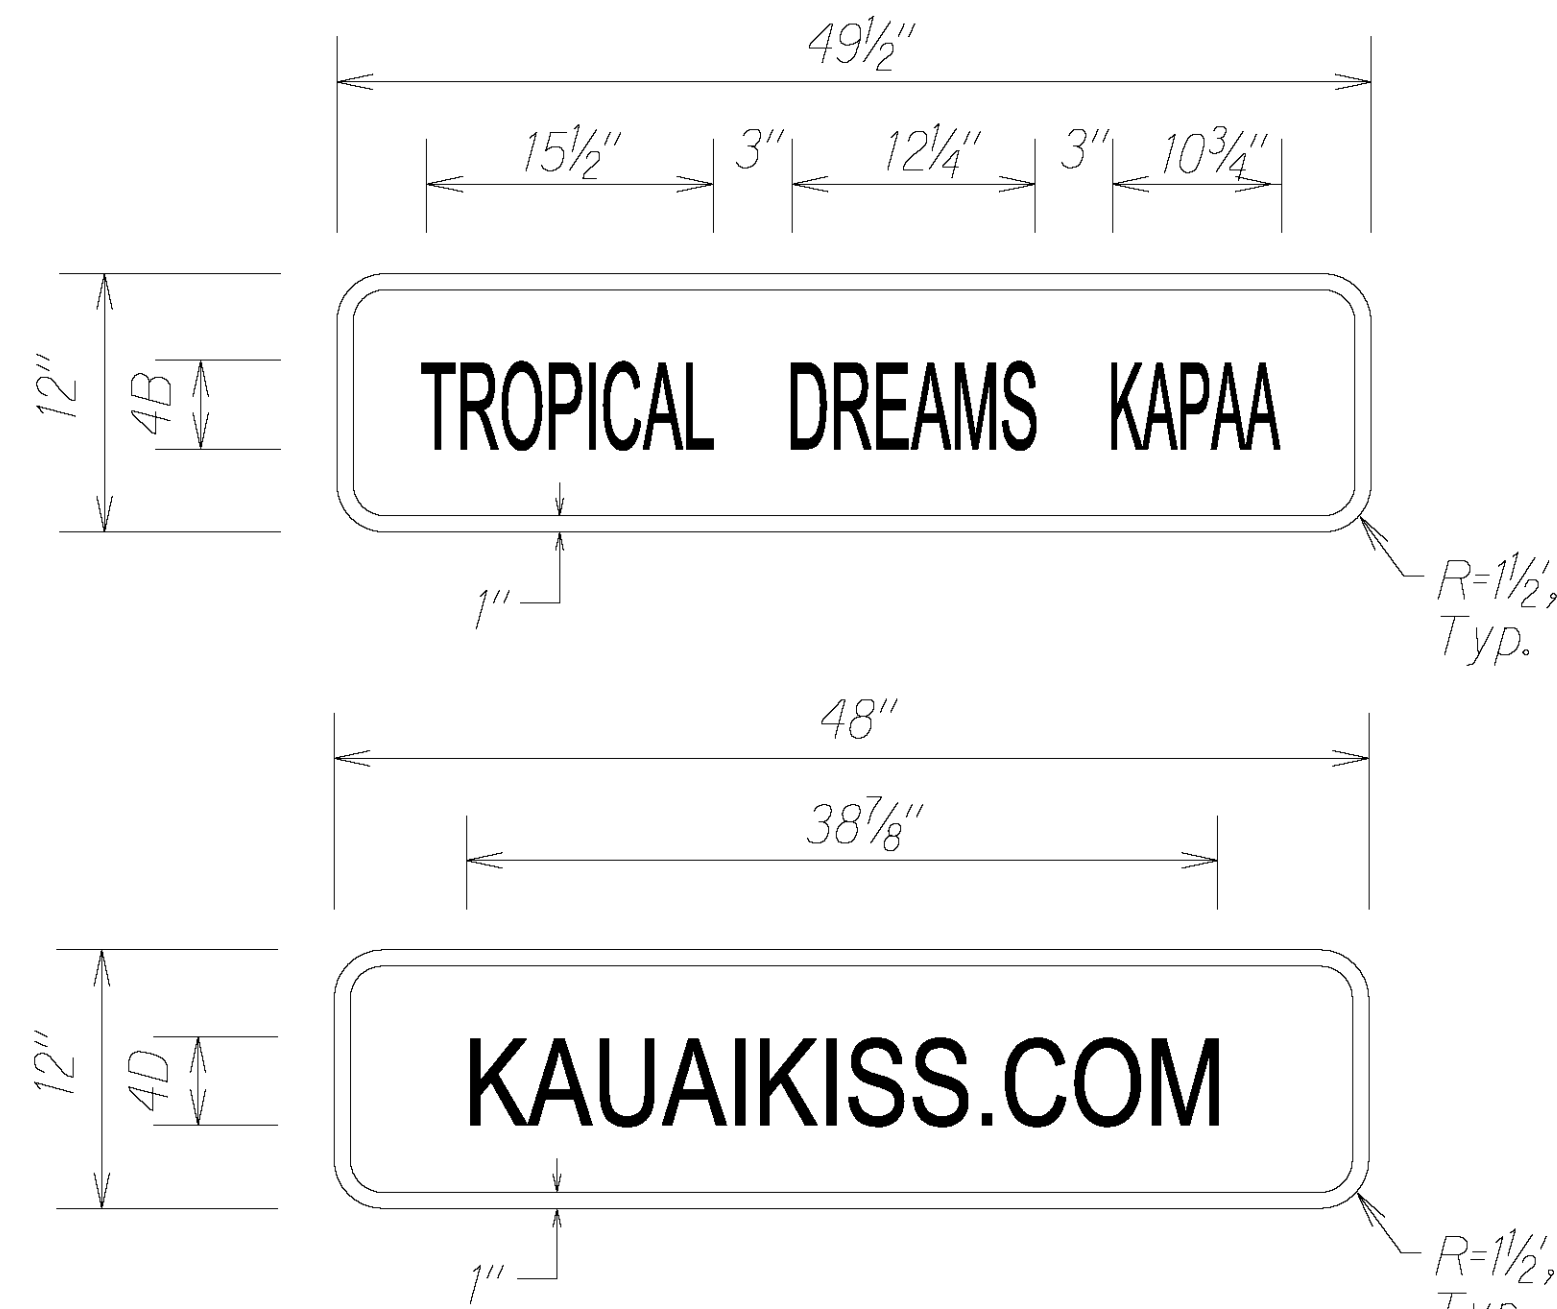


Flat Panel:
Legend: Blue (Retroreflective)
Background: White (Retroreflective)

ACKNOWLEDGEMENT NAME SIGN
Not to Scale

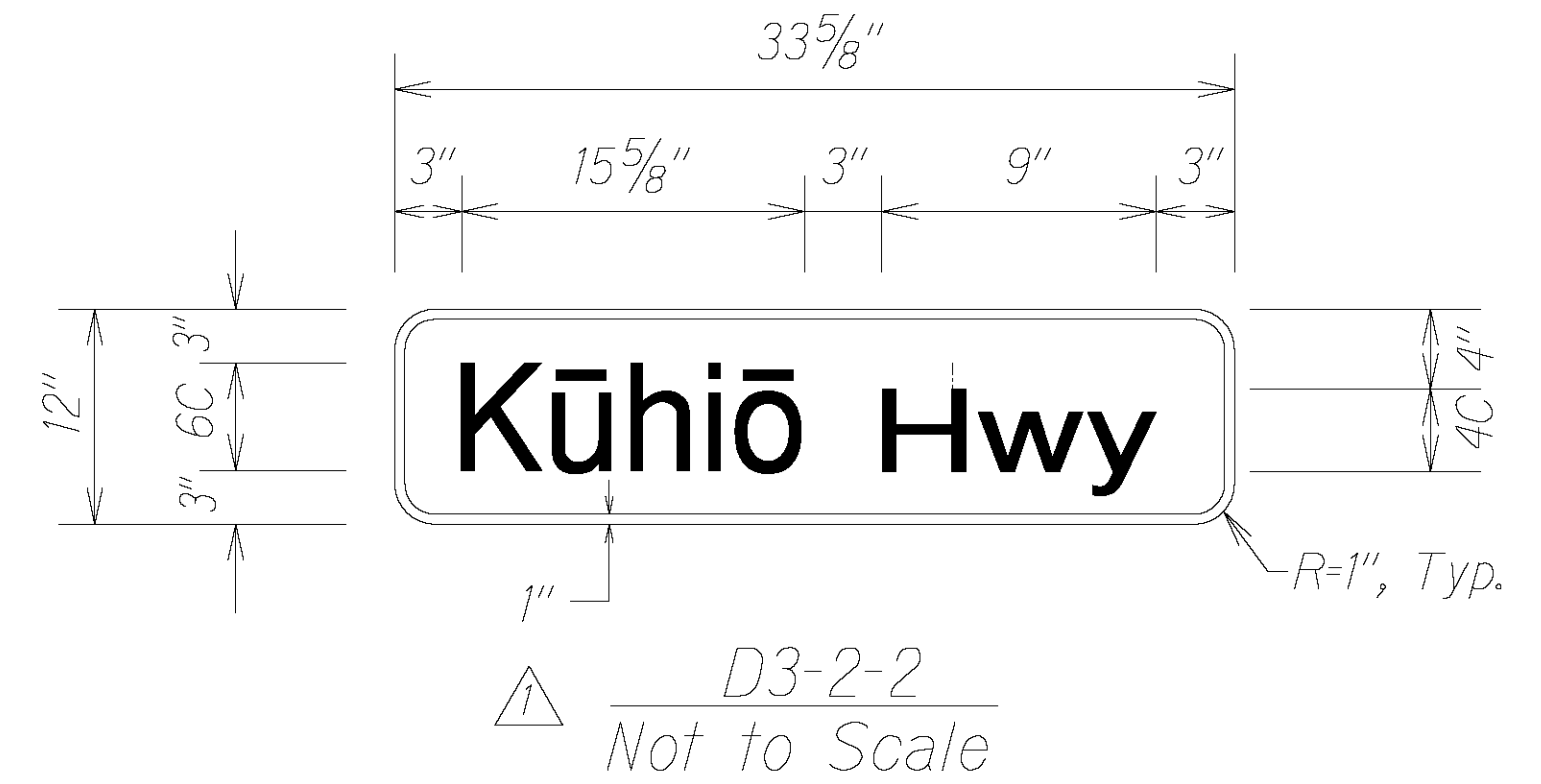

STREET NAME SIGN ON TRAFFIC SIGNAL POST
Not to Scale

Lettering — White
Background — Green


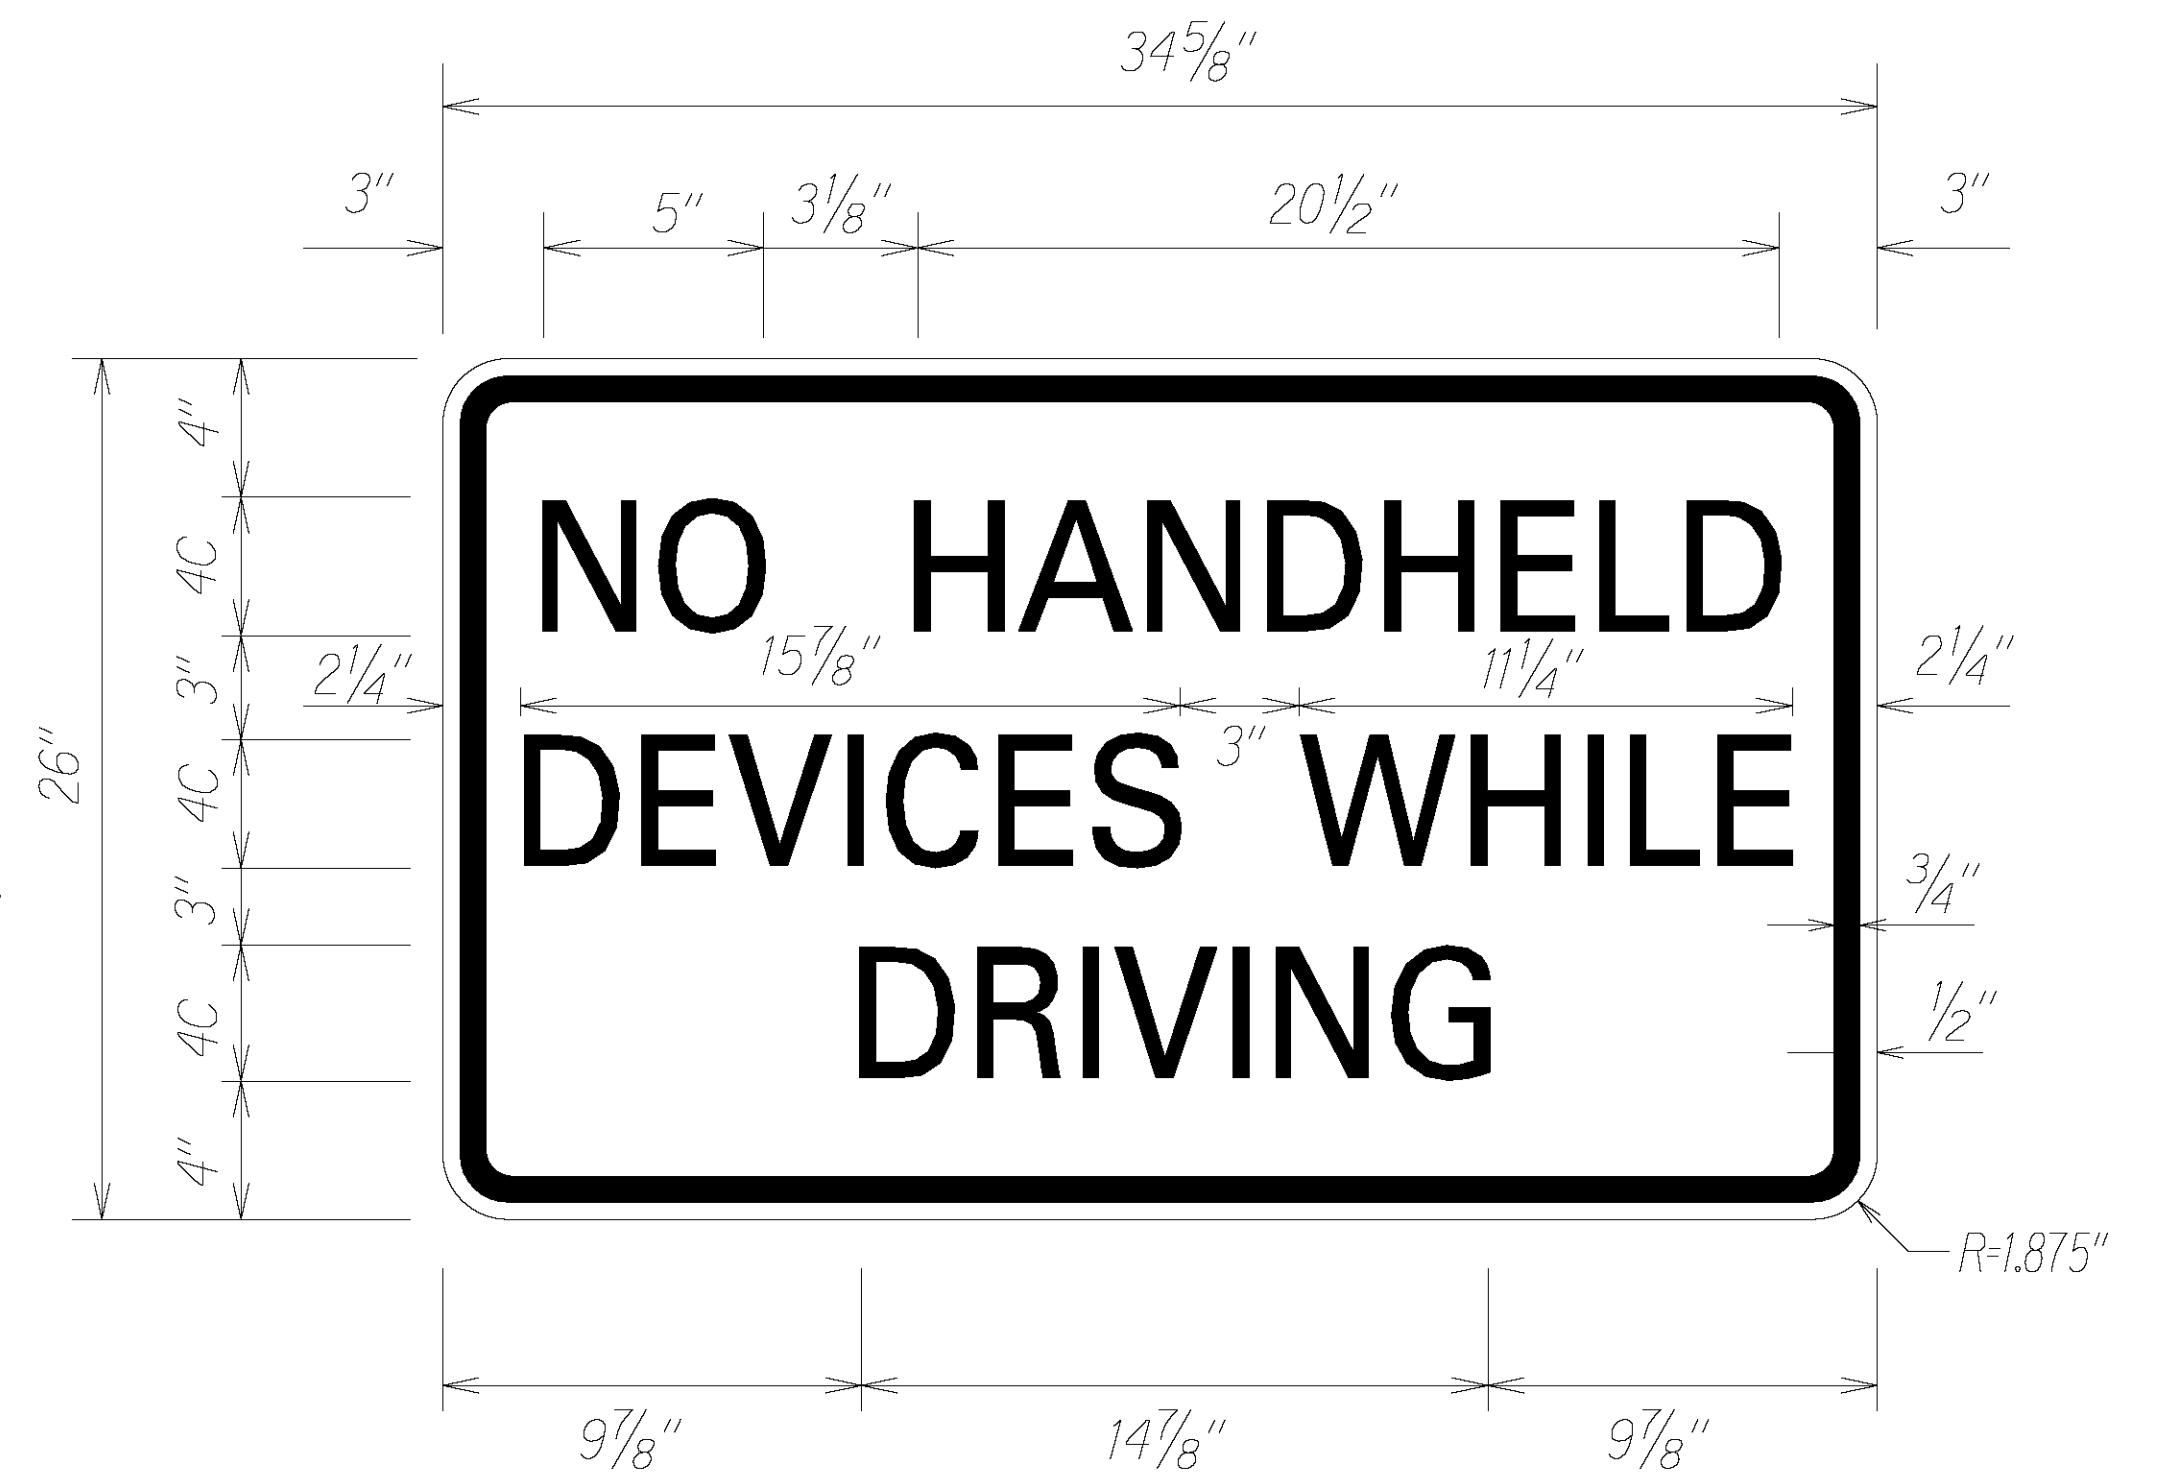


Border — Black
Lettering — Black
Background — White

D2-2
Not to Scale


4/21/23	1 - Revise D3-2-2
4/21/23	1 - Revise D3-2-1
DATE	REVISION
STATE OF HAWAII DEPARTMENT OF TRANSPORTATION HIGHWAYS DIVISION	
SIGN DETAIL	
KUHIO HIGHWAY RESURFACING Waikaea Bridge to Mailihuna Road Federal-Aid Project No. NH-056-1(063)	
Scale: As Noted	Date: April 2023
SHEET No. 2 OF 4 SHEETS	

FED. ROAD DIST. NO.	STATE	FED-AID PROJ. NO.	FISCAL YEAR	SHEET NO.	TOTAL SHEETS
HAWAII	HAW.	NH-056-1(063)	2023	36	43

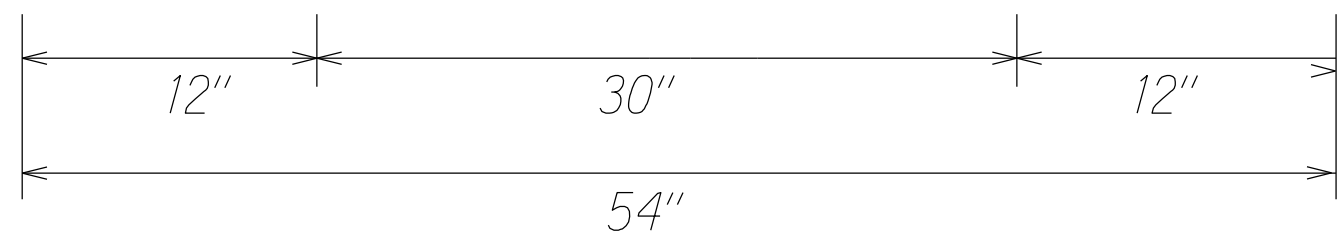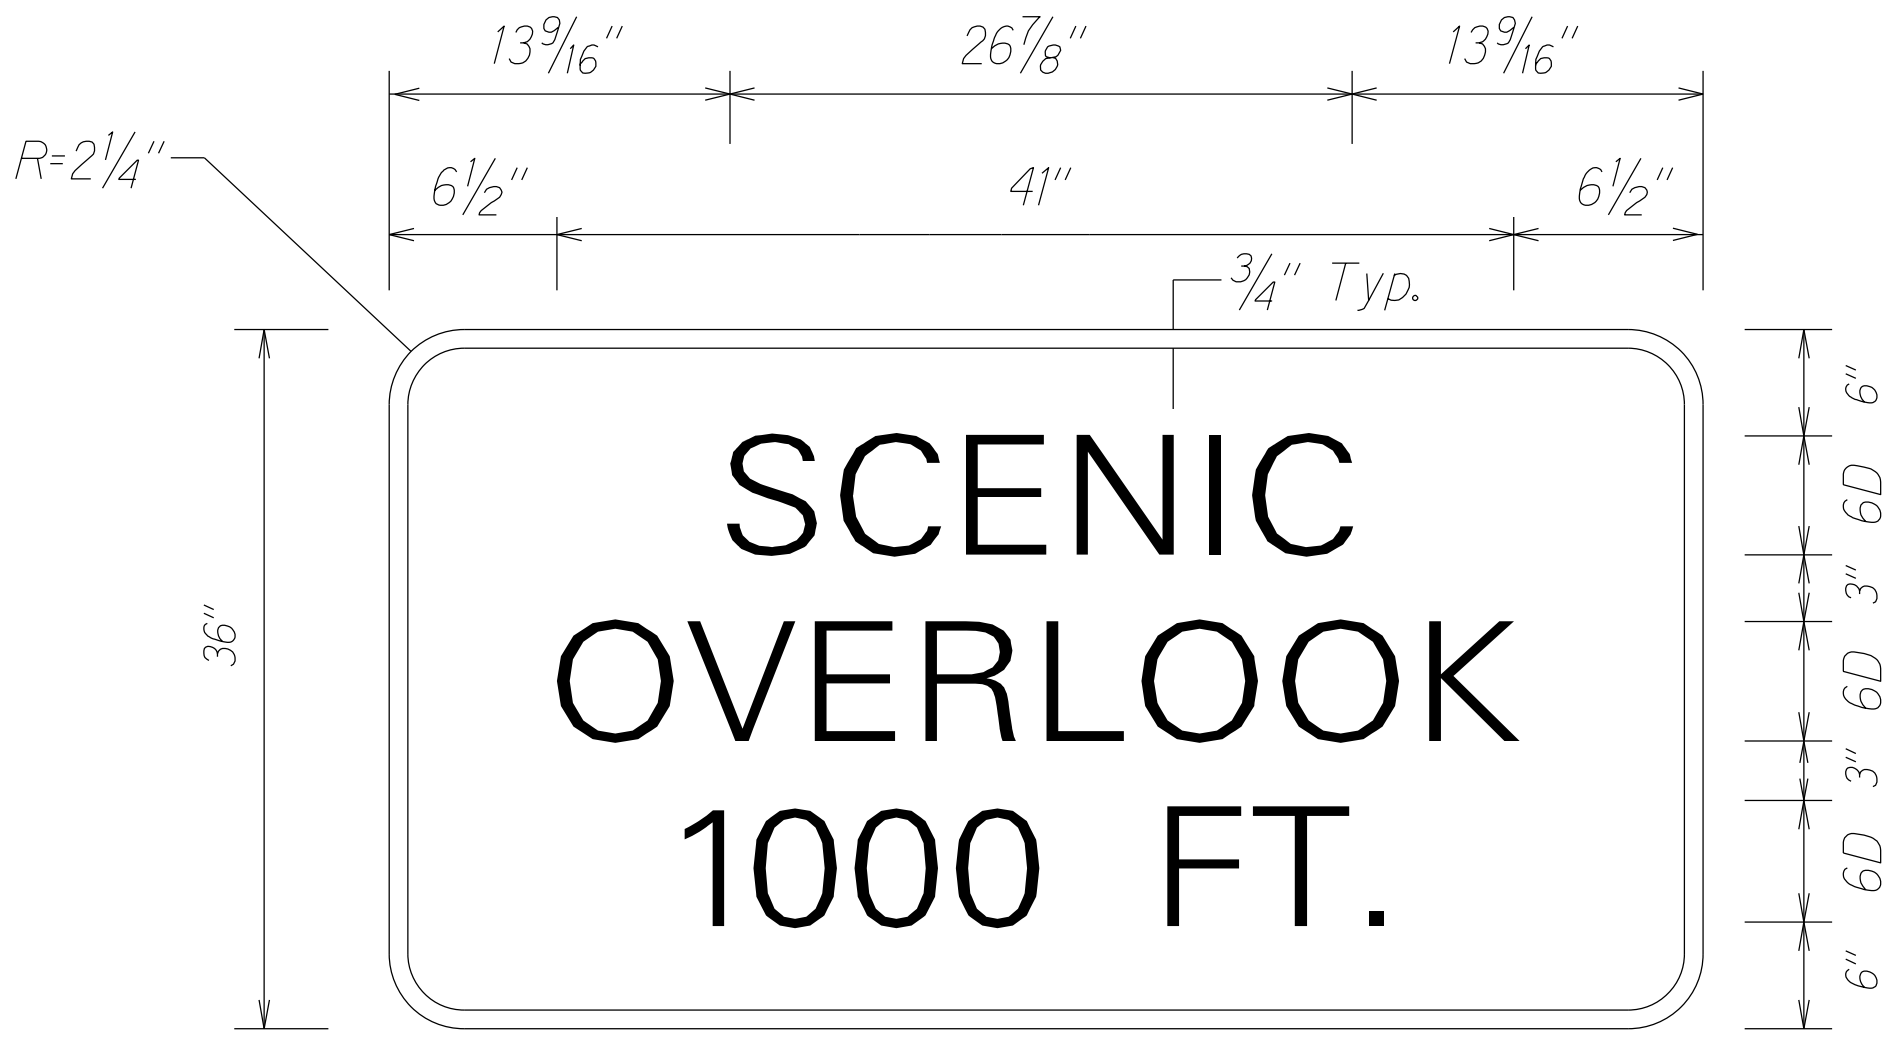


D2-3
Not to Scale


Flat Panel:
Legend: White Retroreflective
Background: Blue (Retroreflective)

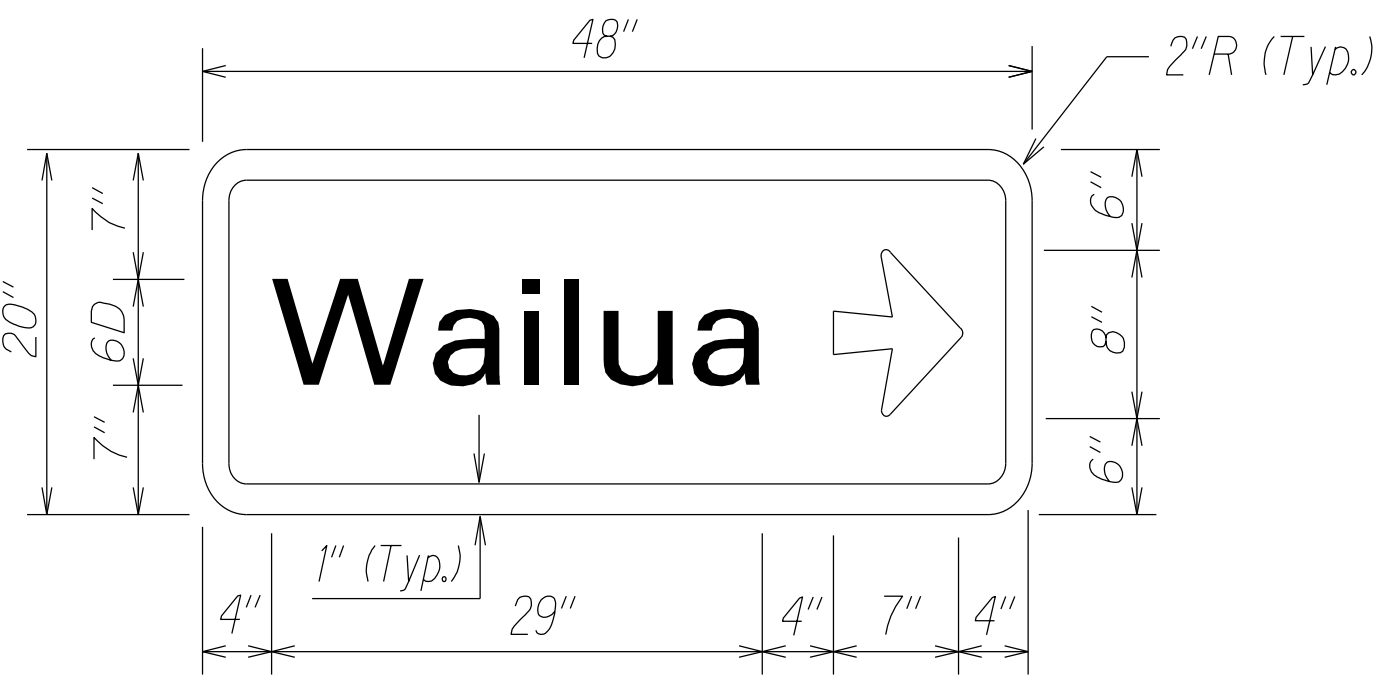


D1-1d-1
Not to Scale

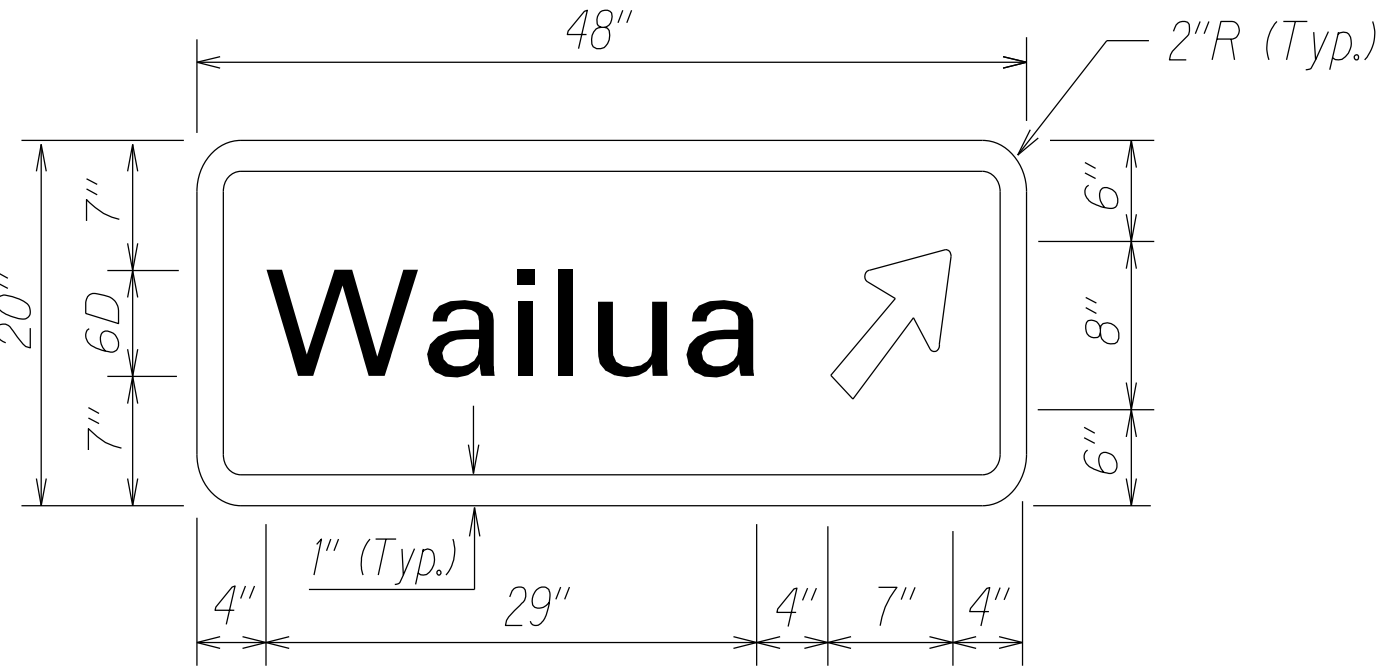


D1-1d-2
Not to Scale

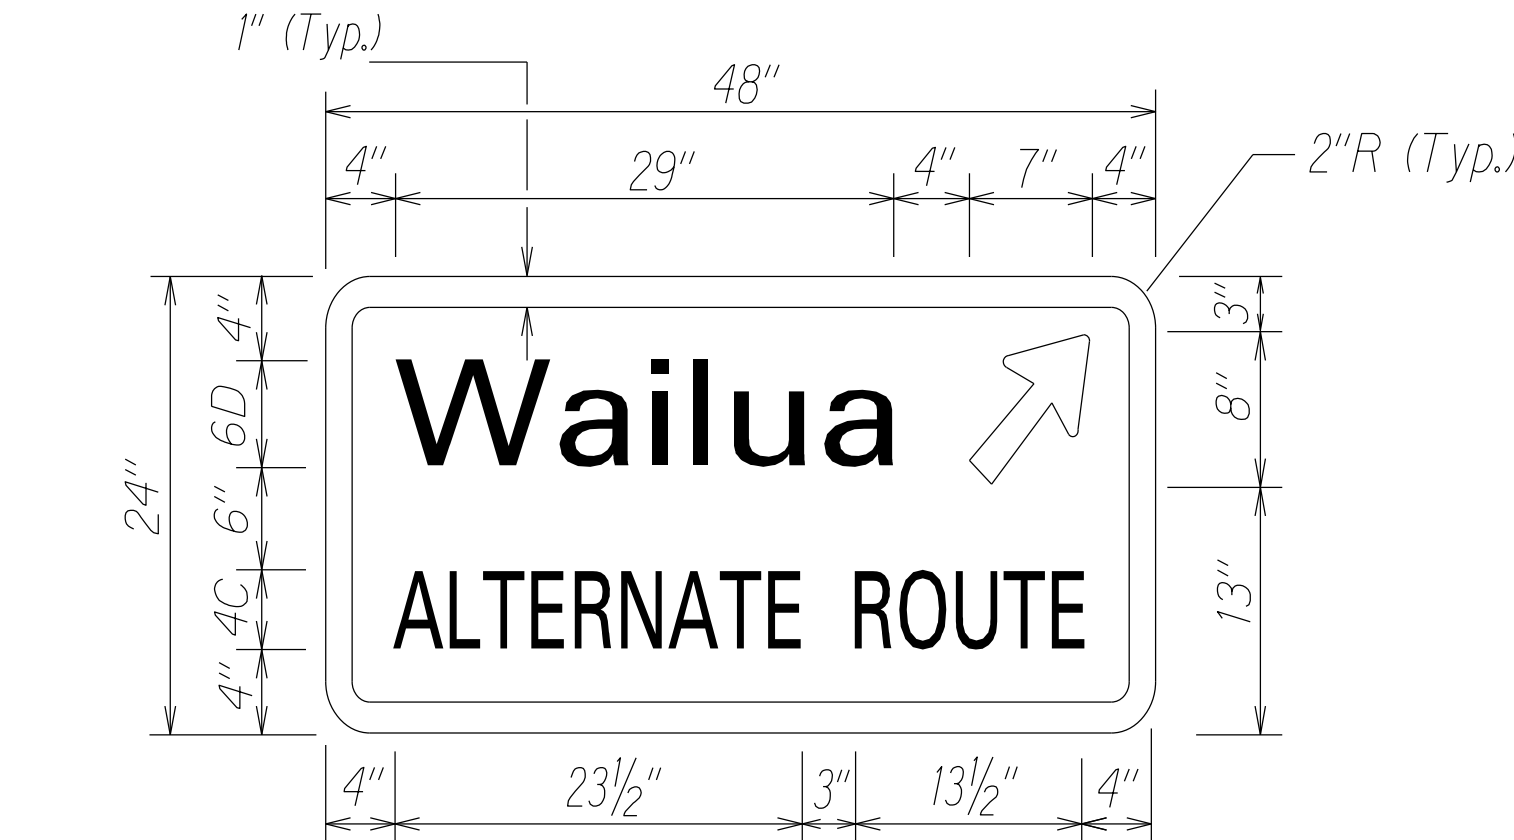

D1-1d-3
Not to Scale

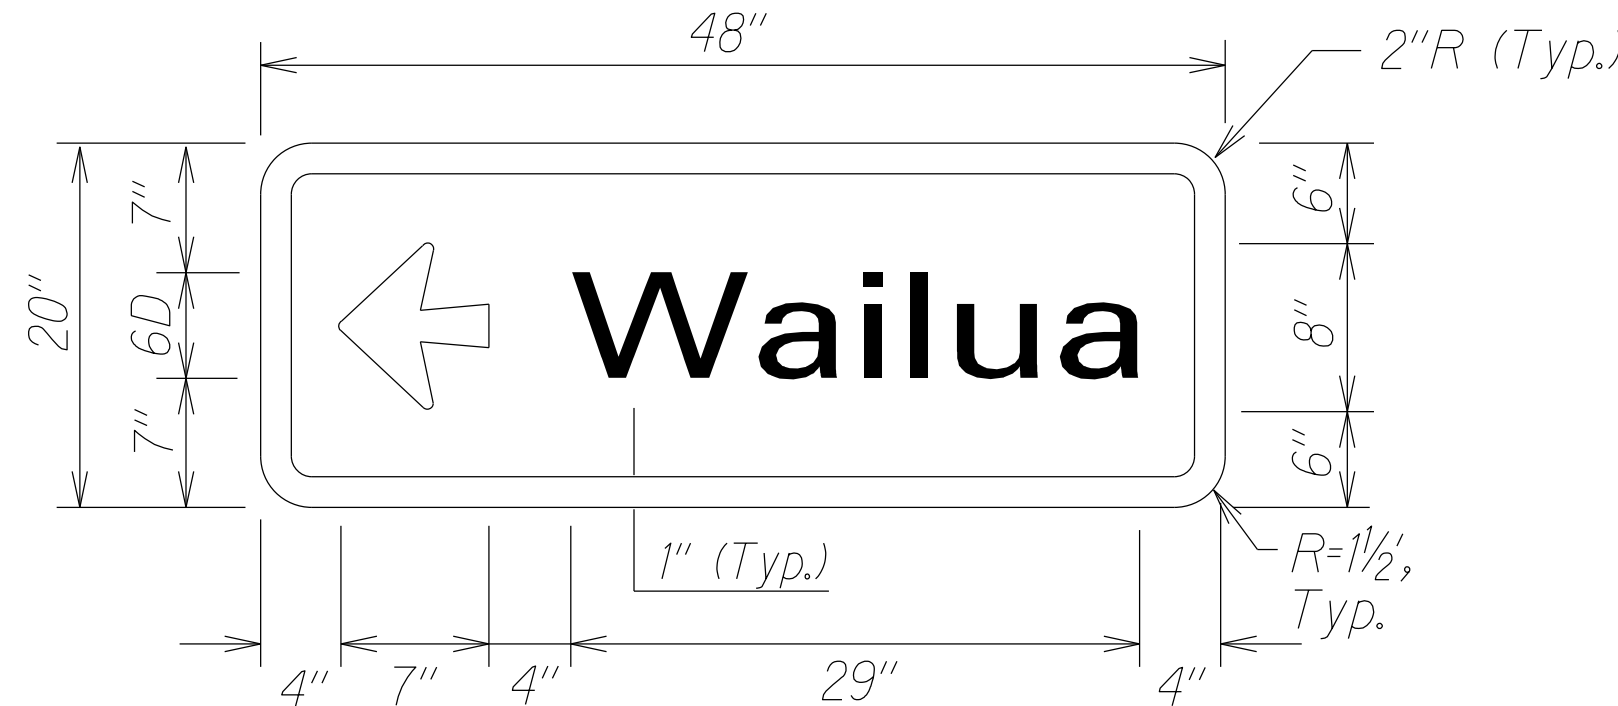


D1-1d-4
Not to Scale

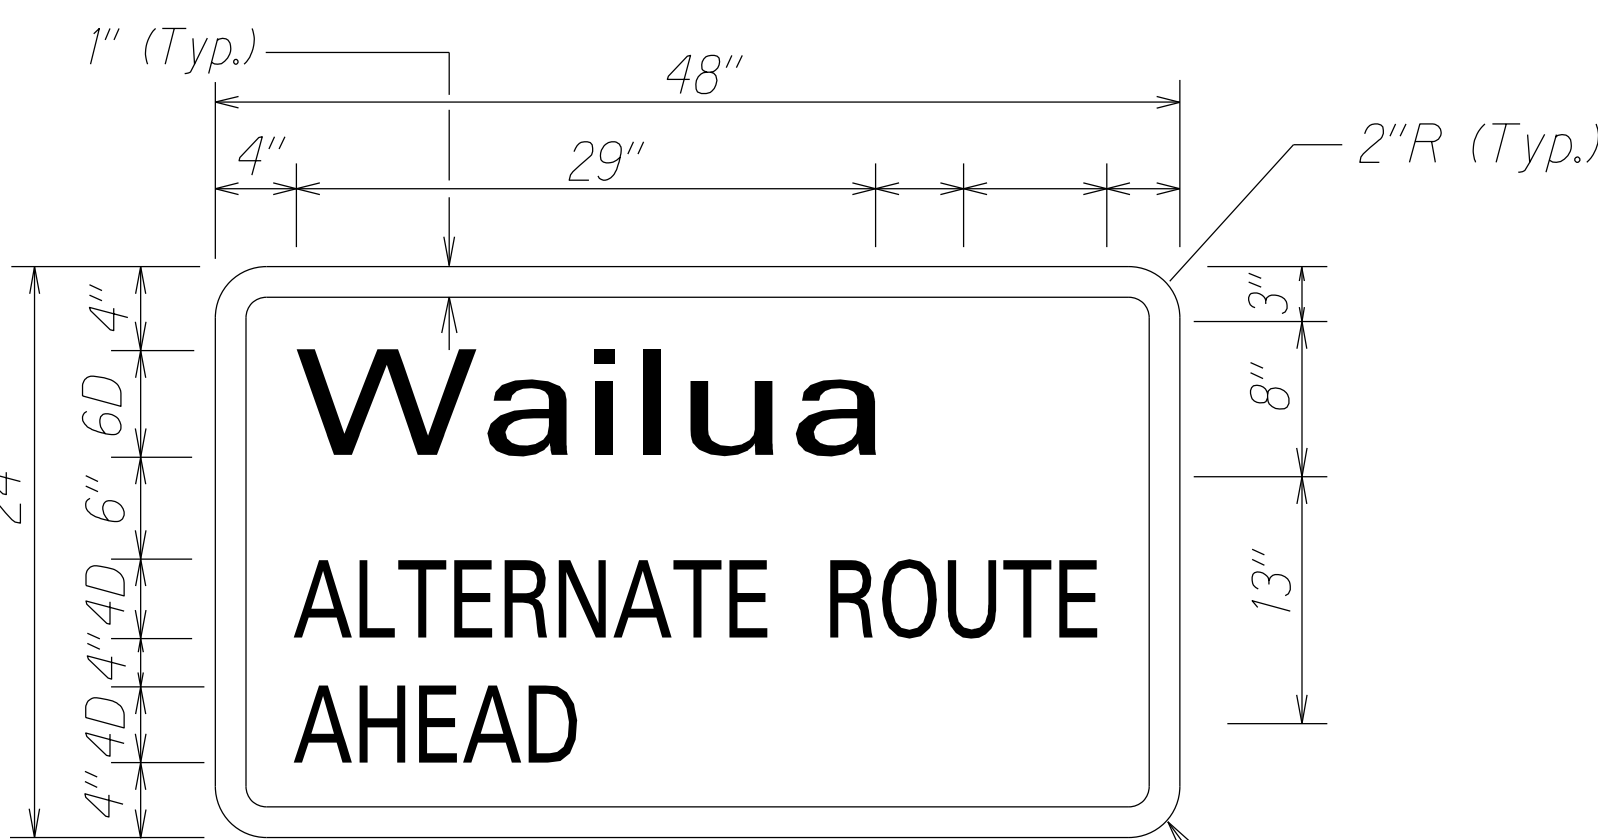

D1-1d-5
Not to Scale

Border — White
Lettering — White
Background — Green

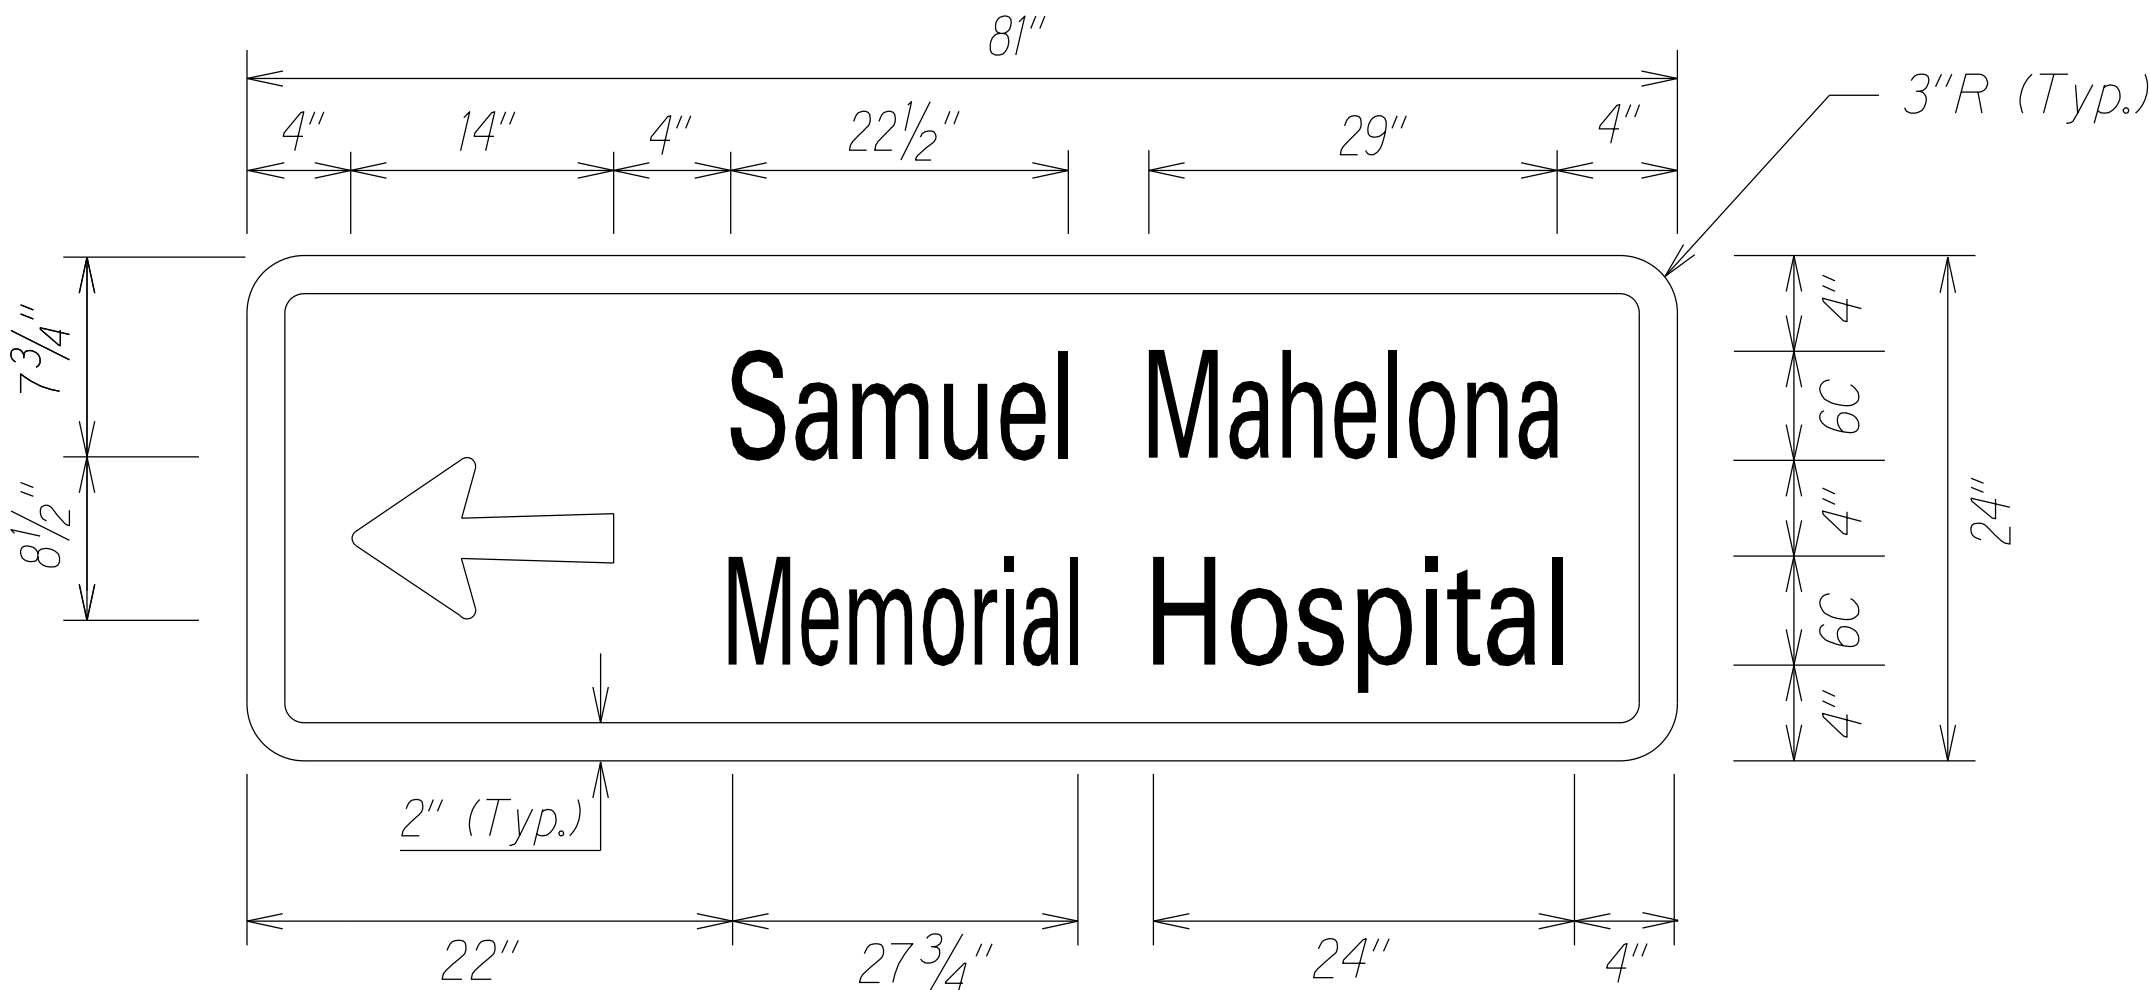

D1-1d-6
Not to Scale

Border — White
Lettering — White
Background — Green



M4-1
Not to Scale

See Page 3-15 of the Standard Highway Signs 2002 Edition for M4-1 Sign details.

STATE OF HAWAII
DEPARTMENT OF TRANSPORTATION
HIGHWAYS DIVISION


SIGN DETAIL

KUHIO HIGHWAY RESURFACING
Waikaea Bridge to Mailihuna Road
Federal-Aid Project No. NH-056-1(063)

Scale: As Noted Date: Mar. 2023

SHEET No. 3 OF 4 SHEETS

FED. ROAD DIST. NO.	STATE	FED-AID PROJ. NO.	FISCAL YEAR	SHEET NO.	TOTAL SHEETS
HAWAII	HAW.	NH-056-1(063)	2023	37	43

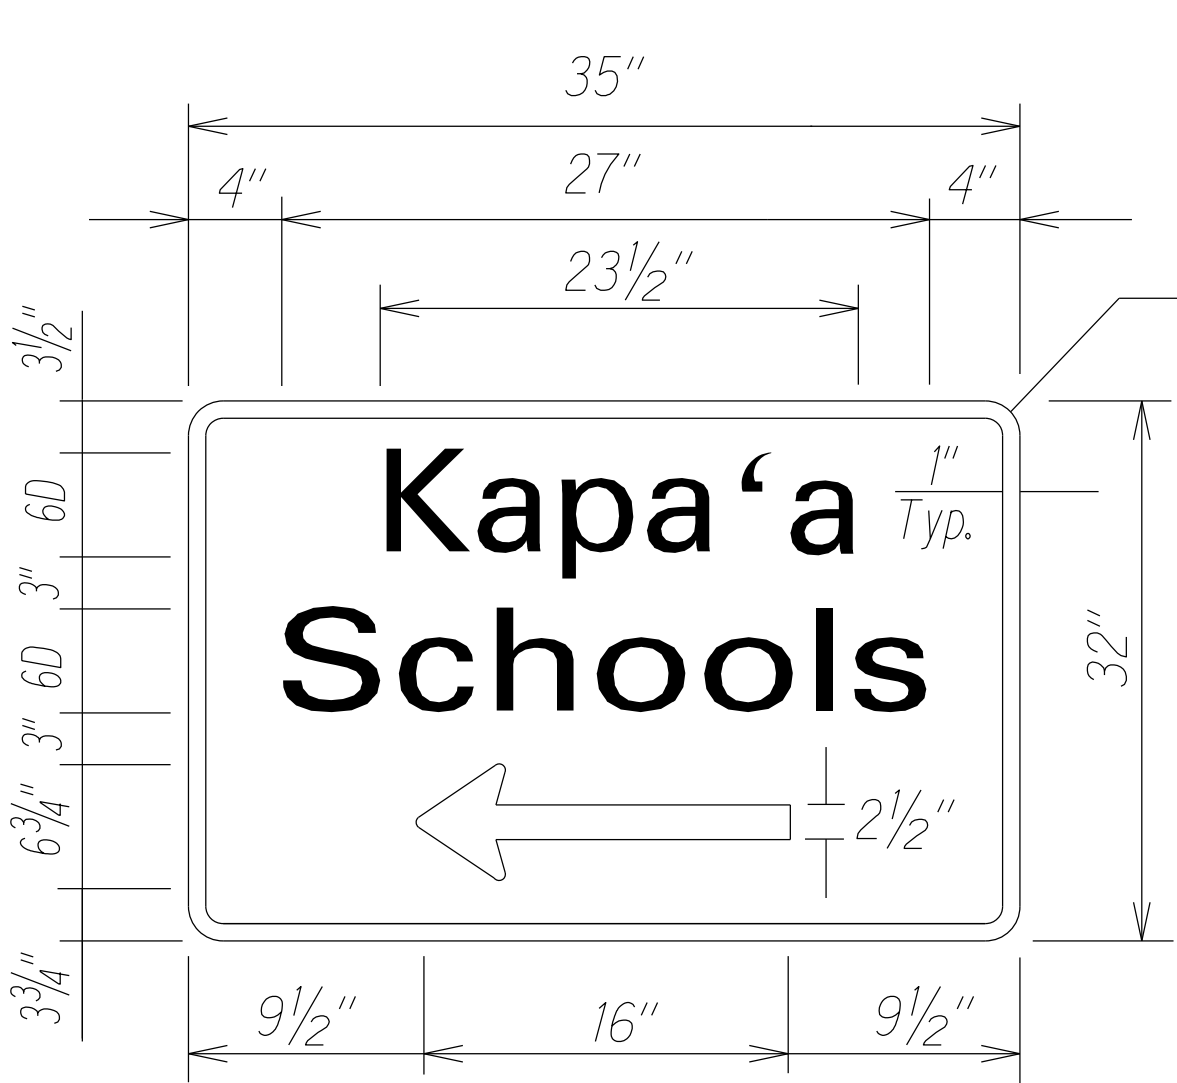


D1-2a
Not to Scale

A


LEGEND (For D1-2a):
Arrow - White
Border - White
Lettering - White
Background - Green

Note:
See Page 6-2 of the Standard
Highway Signs 2002 Edition
for arrow details.

LEGEND (For RG-301):
Background - Brown
Lettering - White
Border - White
Arrow - White

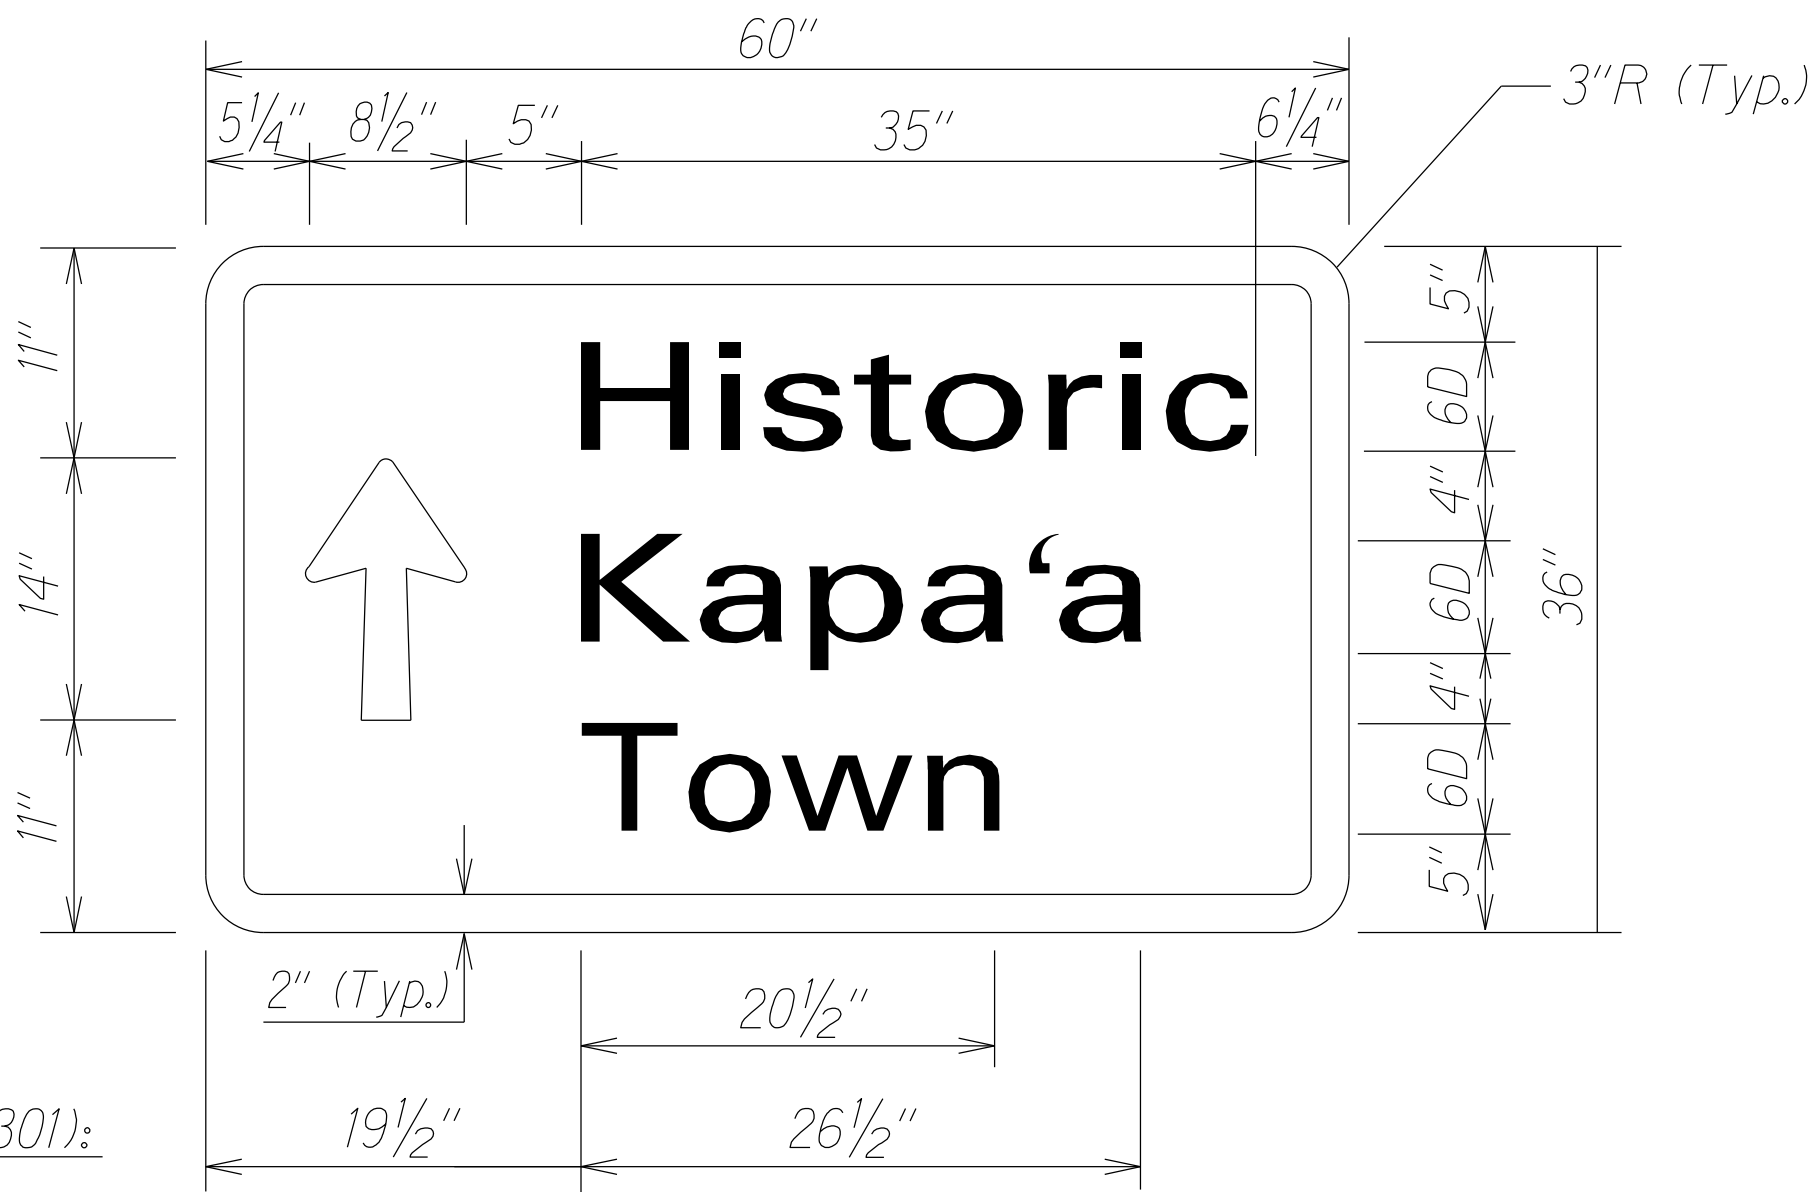

RG-301
(with 3 - 4.0 Lbs./Ft. Flanged Channel Posts)
Not to Scale

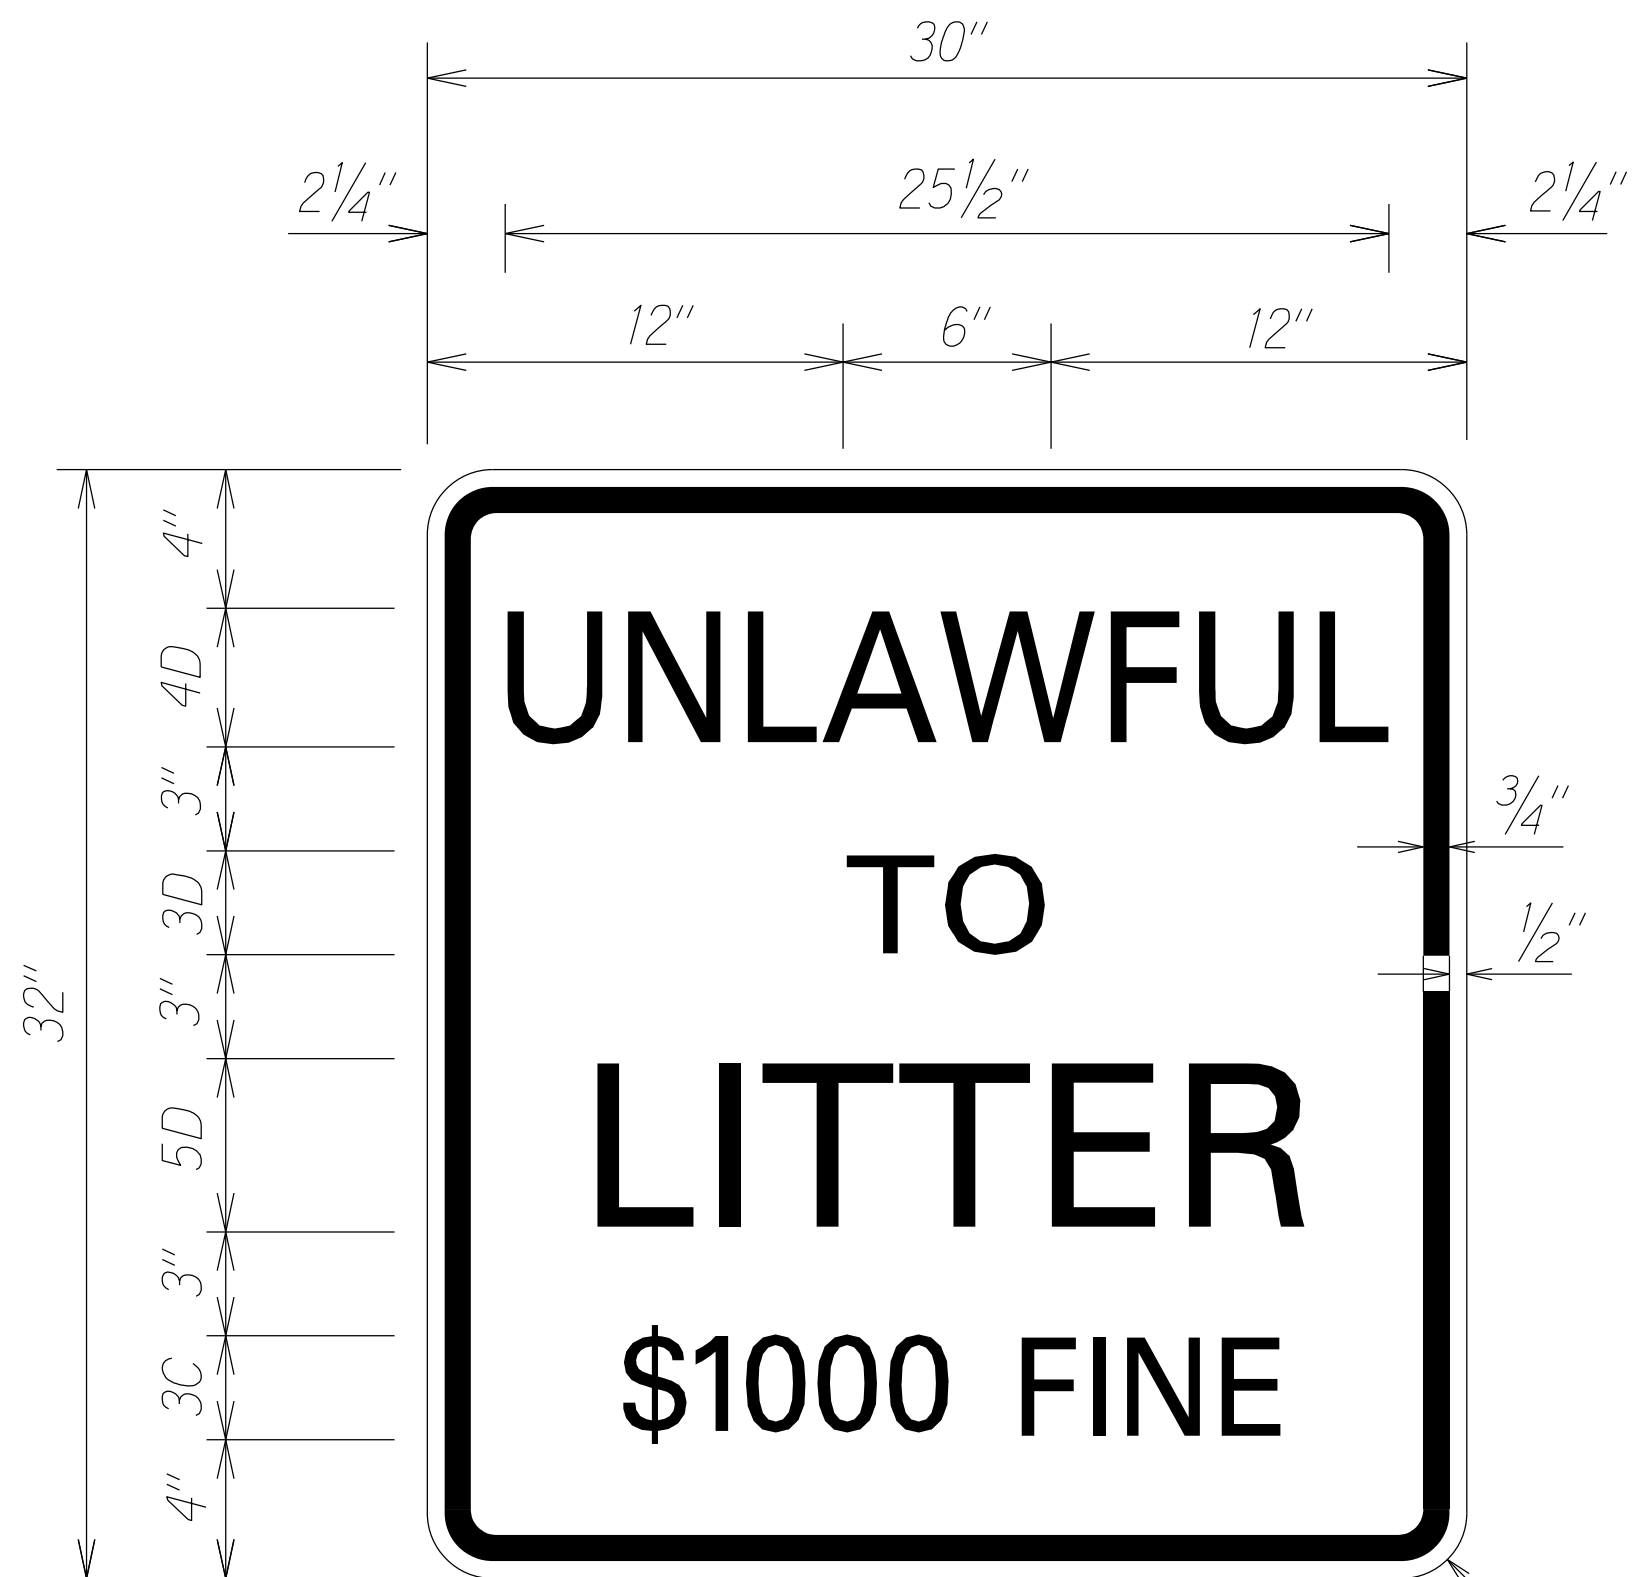

Border — Black
Lettering — Black
Background — White

R15-1
Not to Scale

ORIGINAL PLAN	SURVEY PLOTTED BY	DATE
NOTE BOOK	DRAWN BY	
DESIGNED BY	CHECKED BY	
QUANTITIES BY		
CHECKED BY		

STATE OF HAWAII
DEPARTMENT OF TRANSPORTATION
HIGHWAYS DIVISION

SIGN DETAIL

KUHIO HIGHWAY RESURFACING
Waikaea Bridge to Mailihuna Road
Federal-Aid Project No. NH-056-1(063)

Scale: As Noted Date: Mar. 2023

SHEET No. 4 OF 4 SHEETS