




FED. ROAD DIST. NO.	STATE	PROJ. NO.	FISCAL YEAR	SHEET NO.	TOTAL SHEETS
HAWAII	HAW.	564-01-24M	2025	4009	15

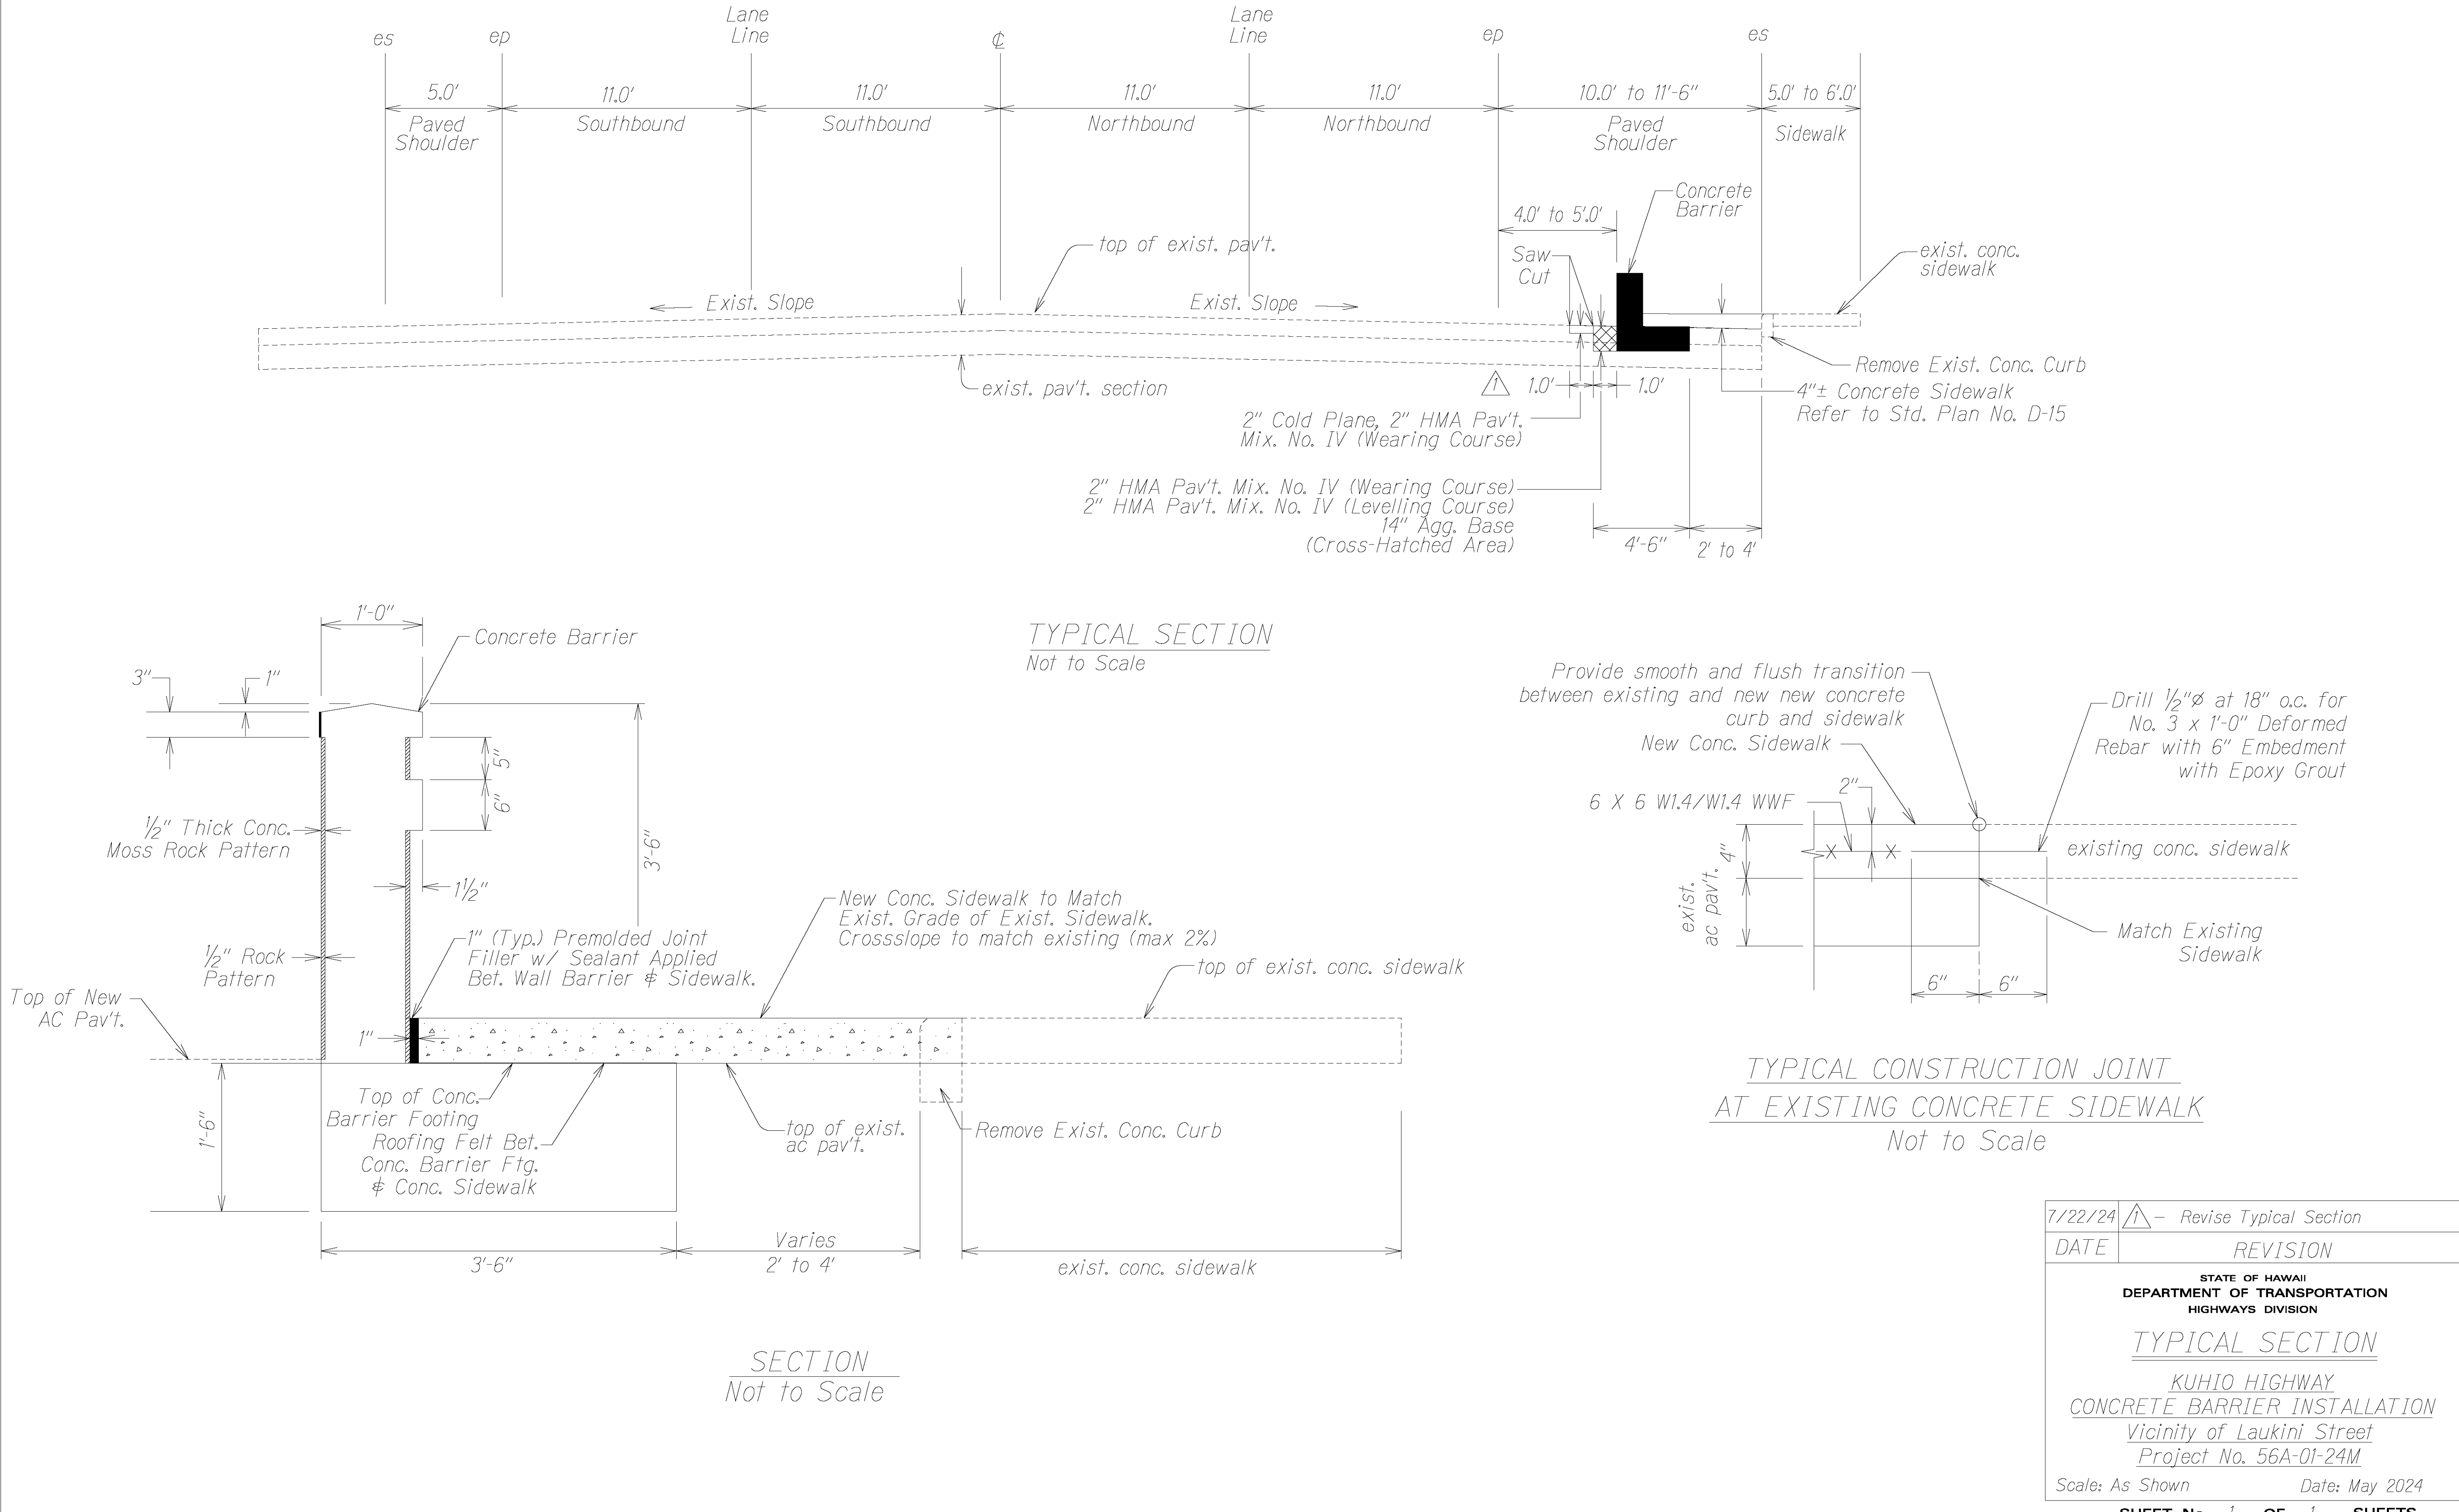


FED. ROAD DIST. NO.	STATE	PROJ. NO.	FISCAL YEAR	SHEET NO.	TOTAL SHEETS
HAWAII	HAW.	56A-01-24M	2025	ADDJ.11	15

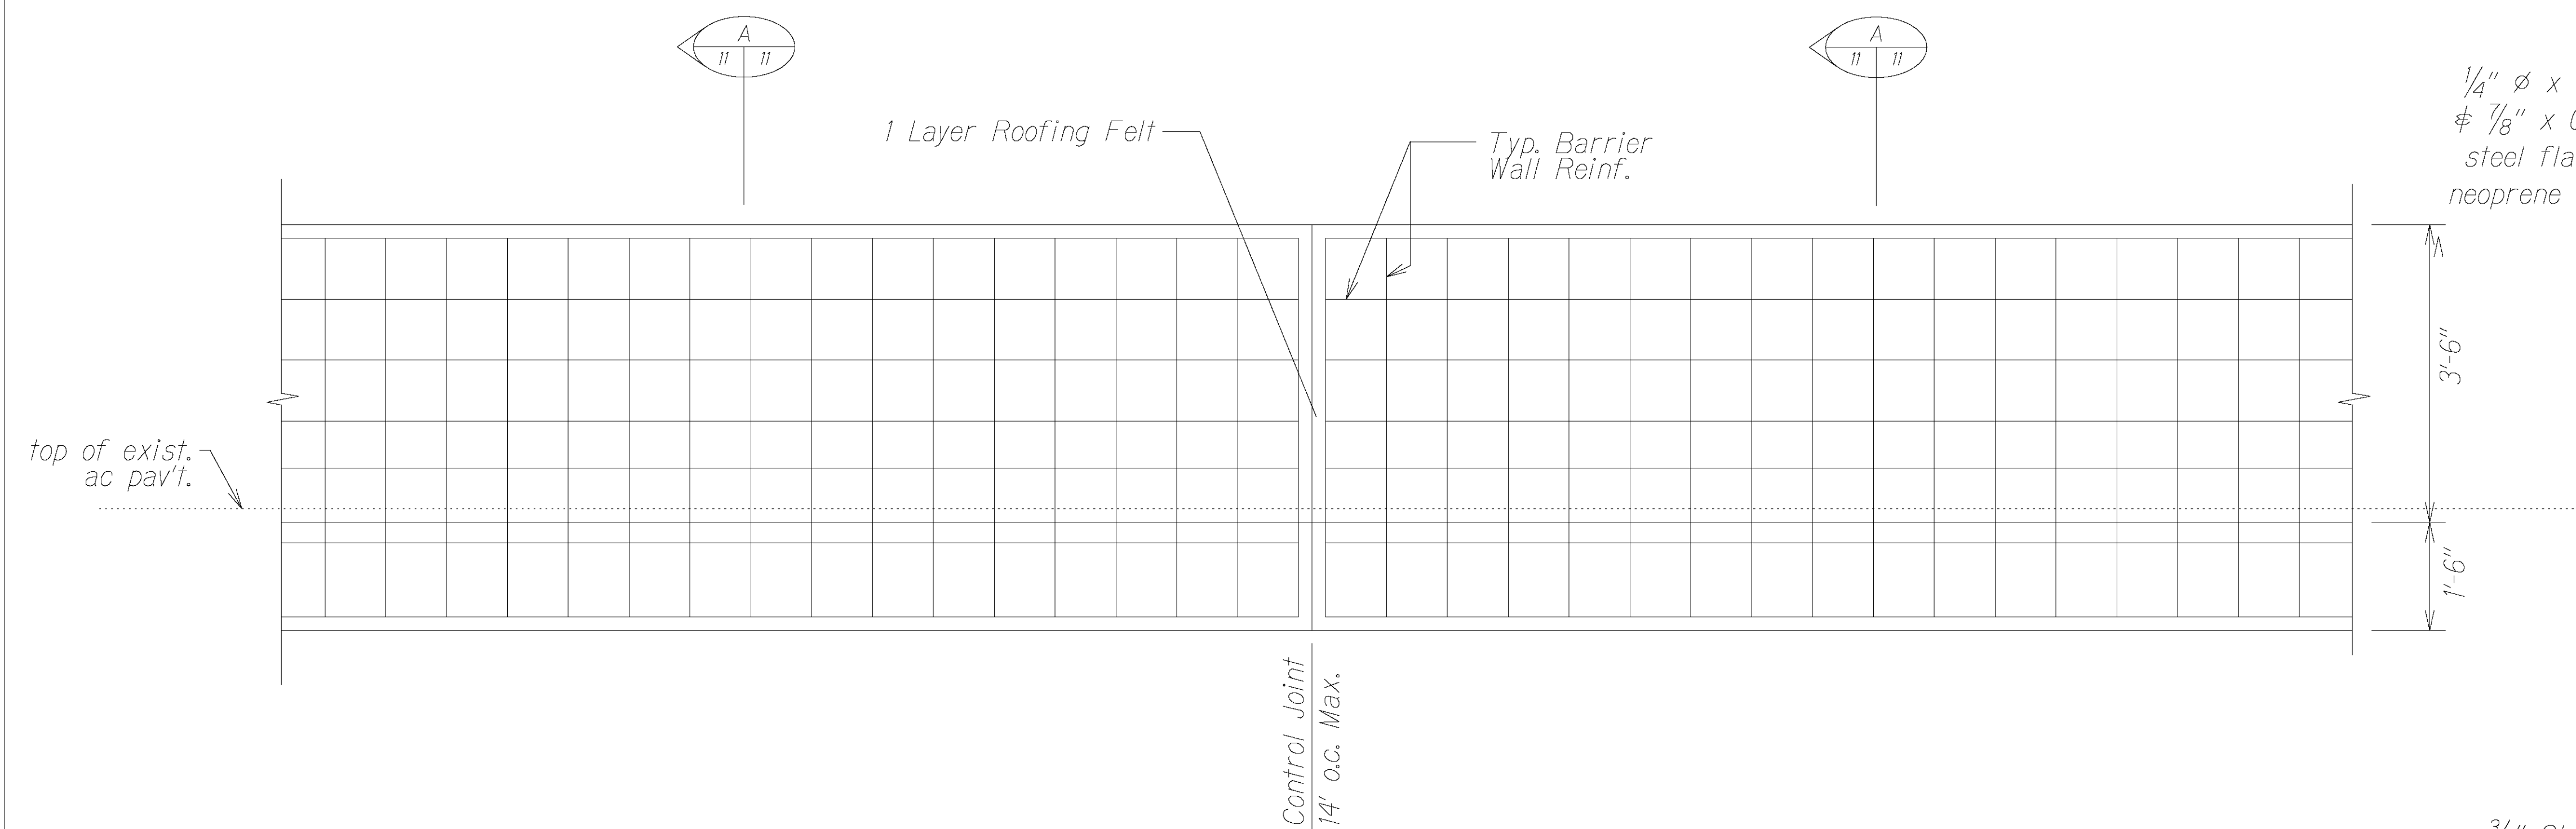

TYPICAL BARRIER WALL REINFORCEMENTS - ELEVATION
Not to Scale

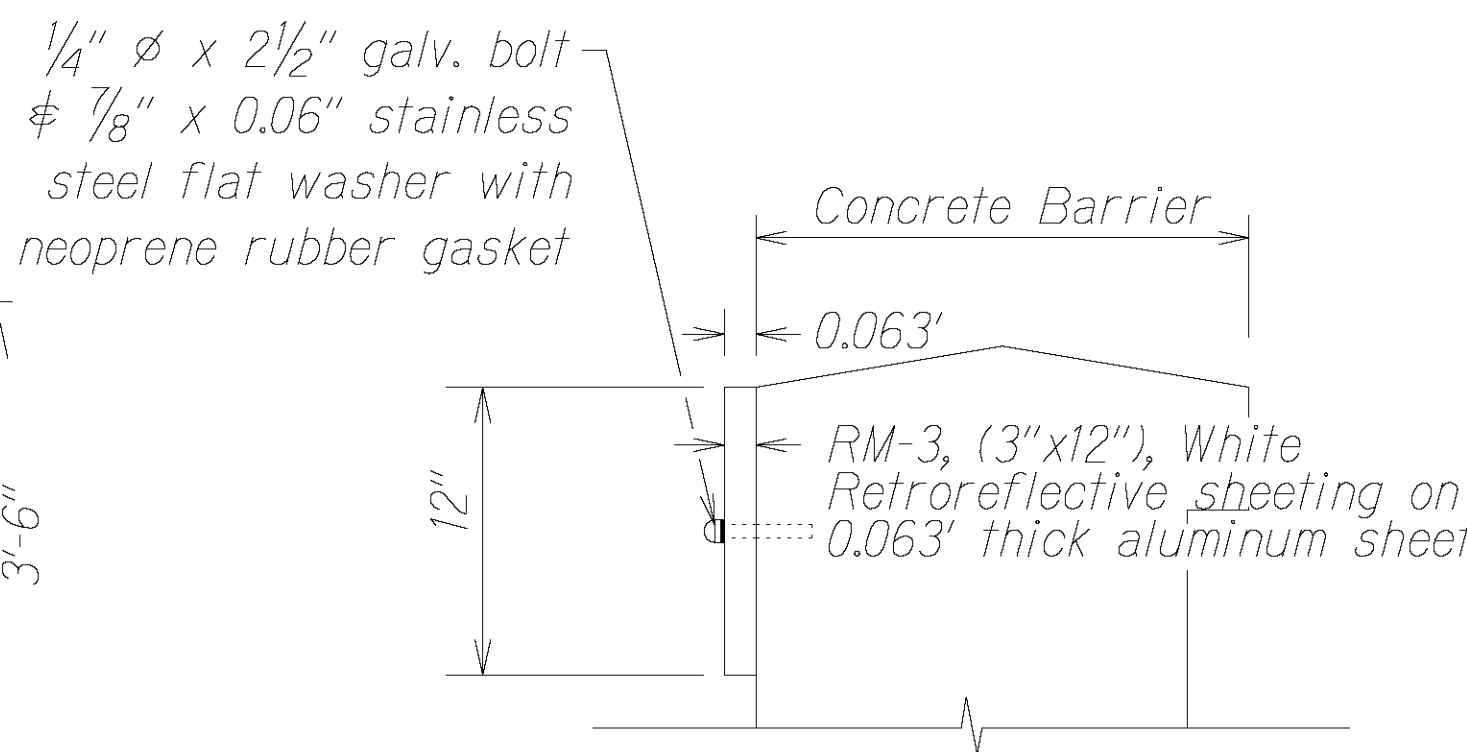


REFLECTOR MARKER MOUNTING DETAIL
Not to Scale

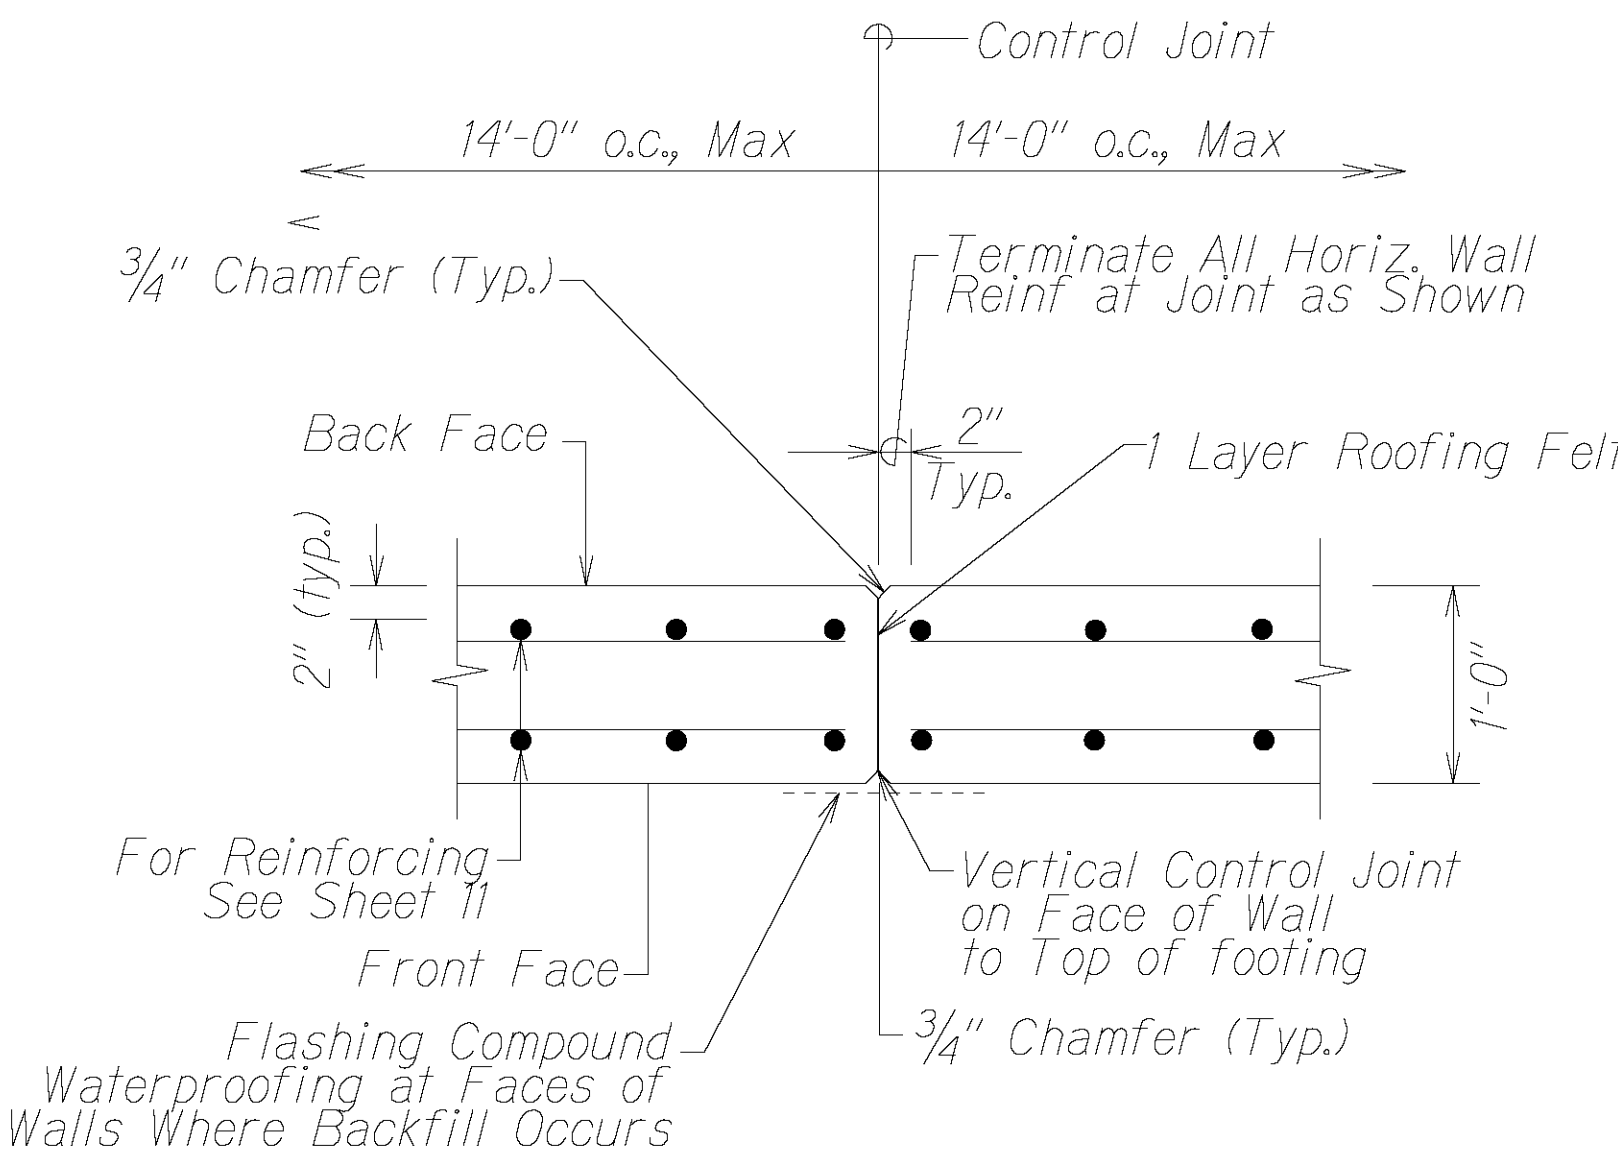


Note: Waterproofing shall be installed on exterior faces of wall at all joints.

CONTROL JOINT AT WALLS - PLAN
Not to Scale

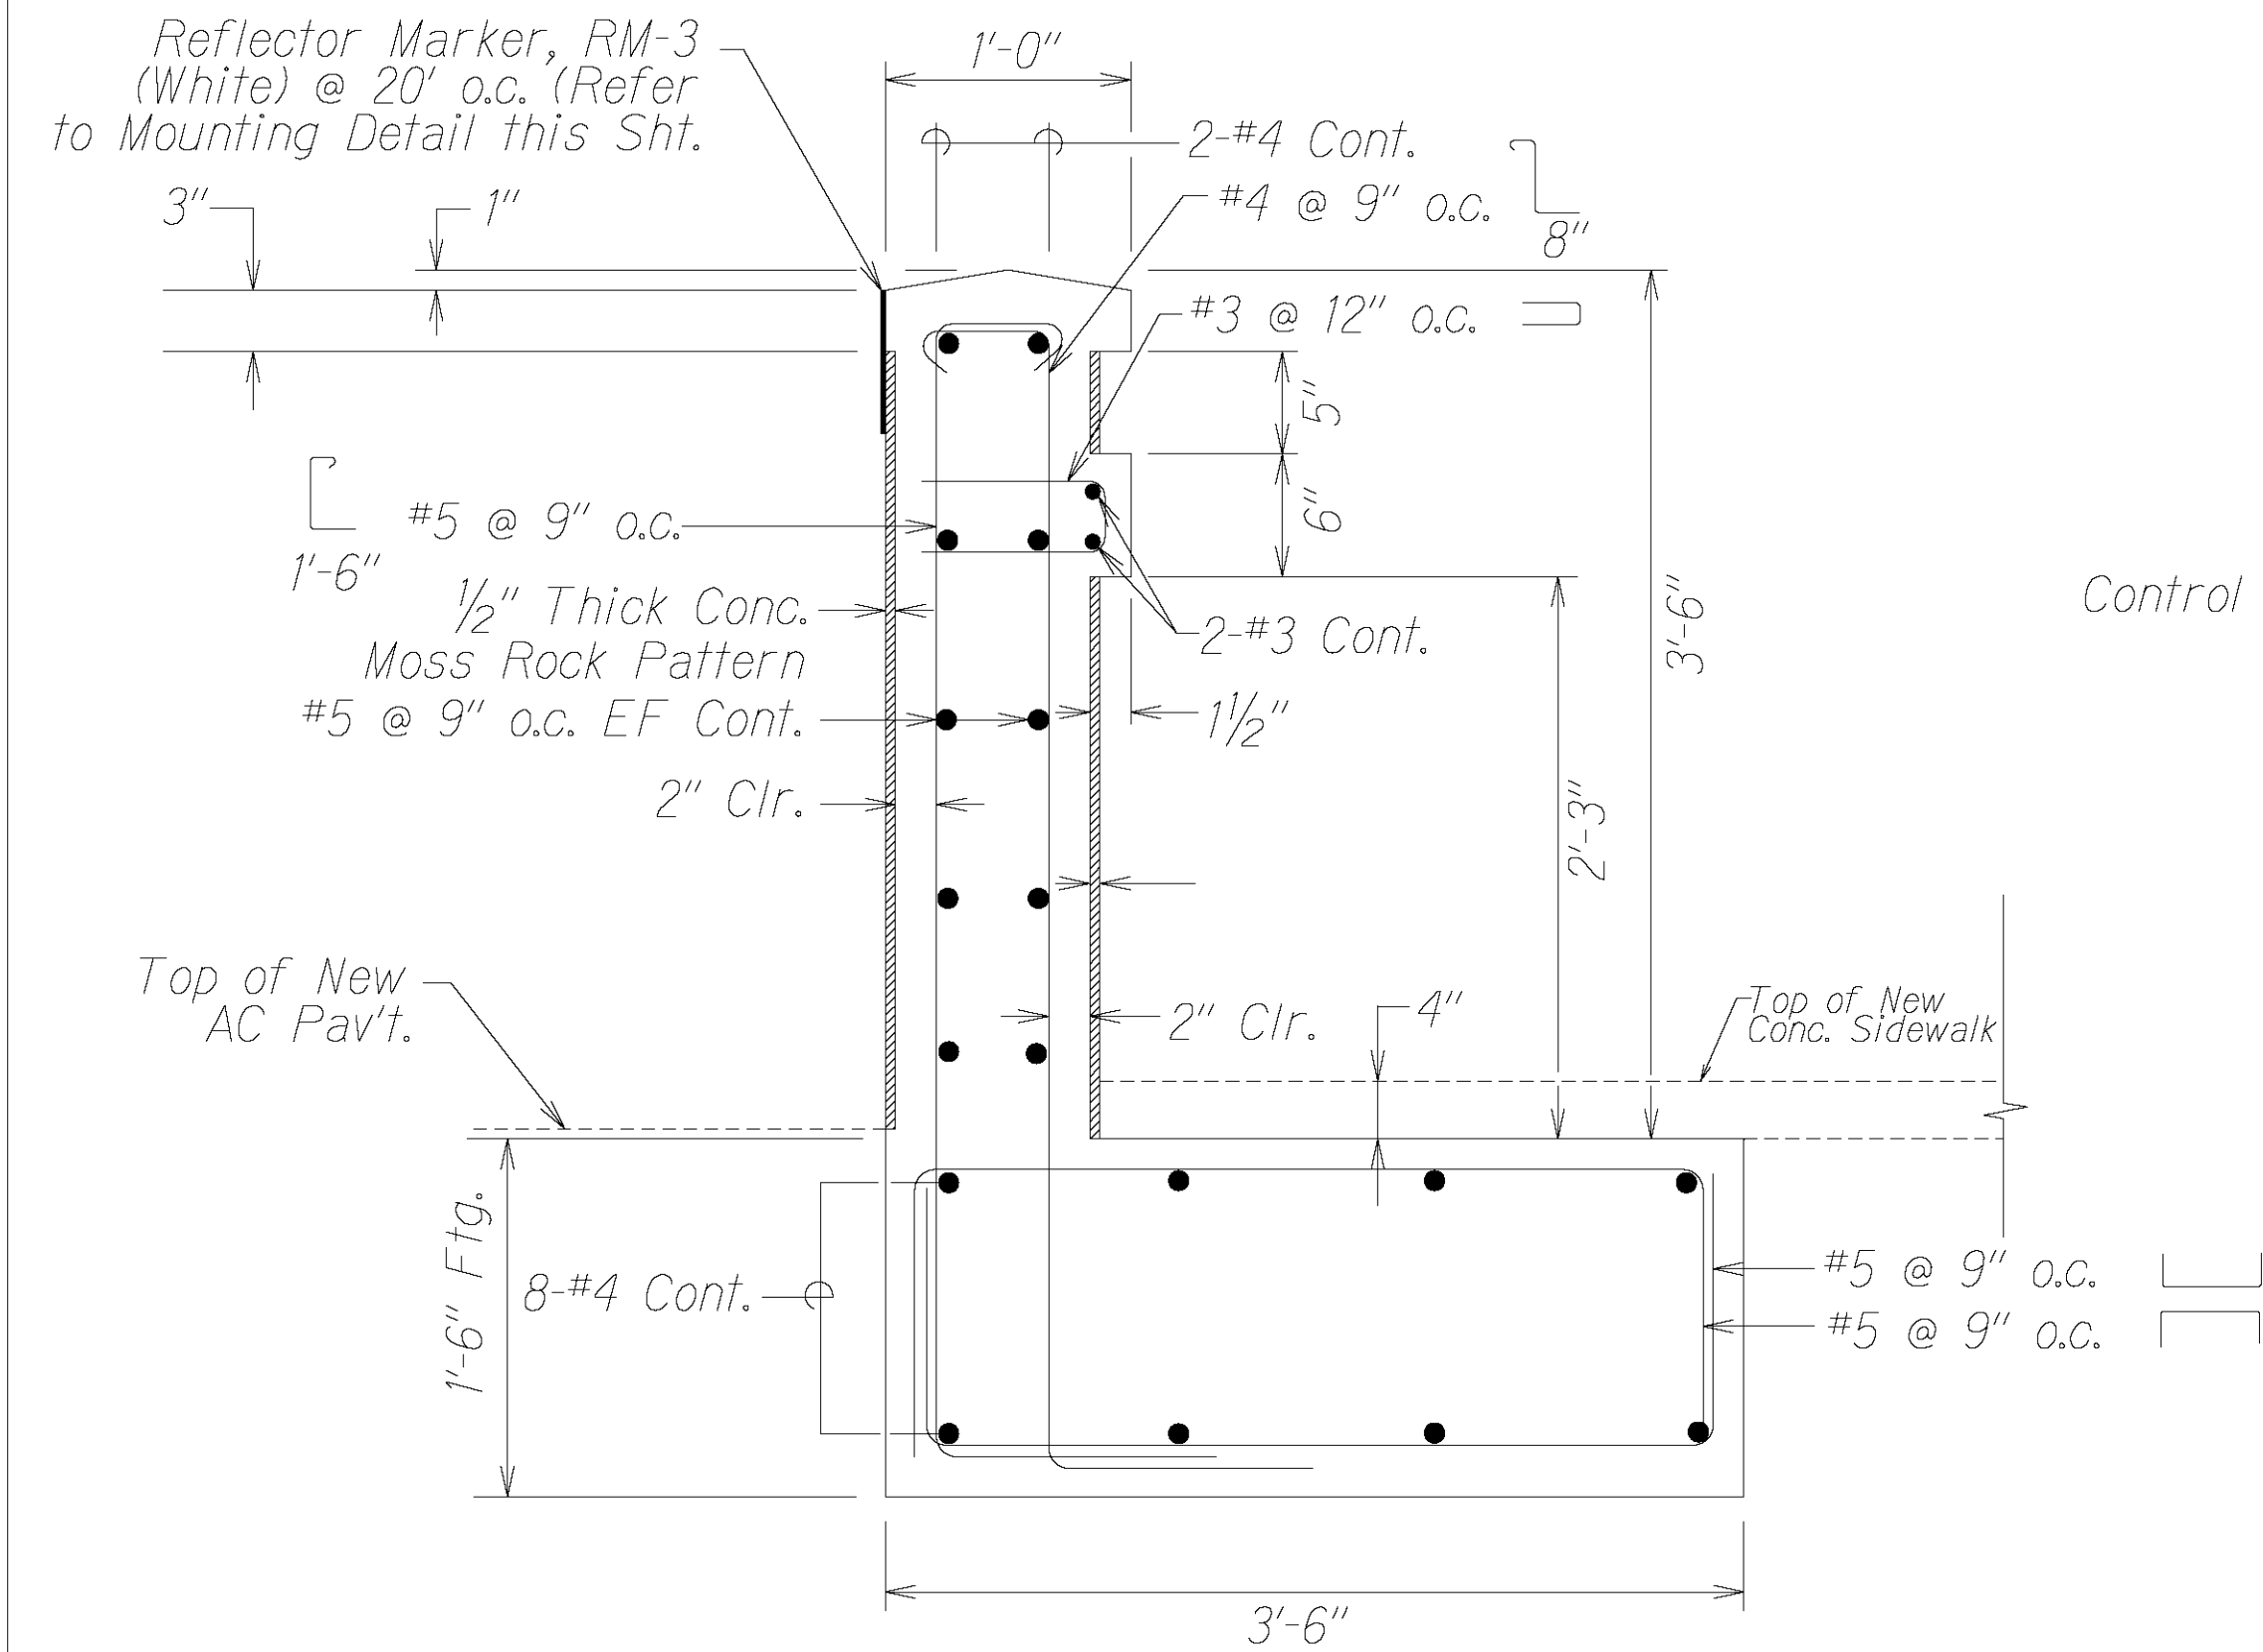

SECTION
Not to Scale

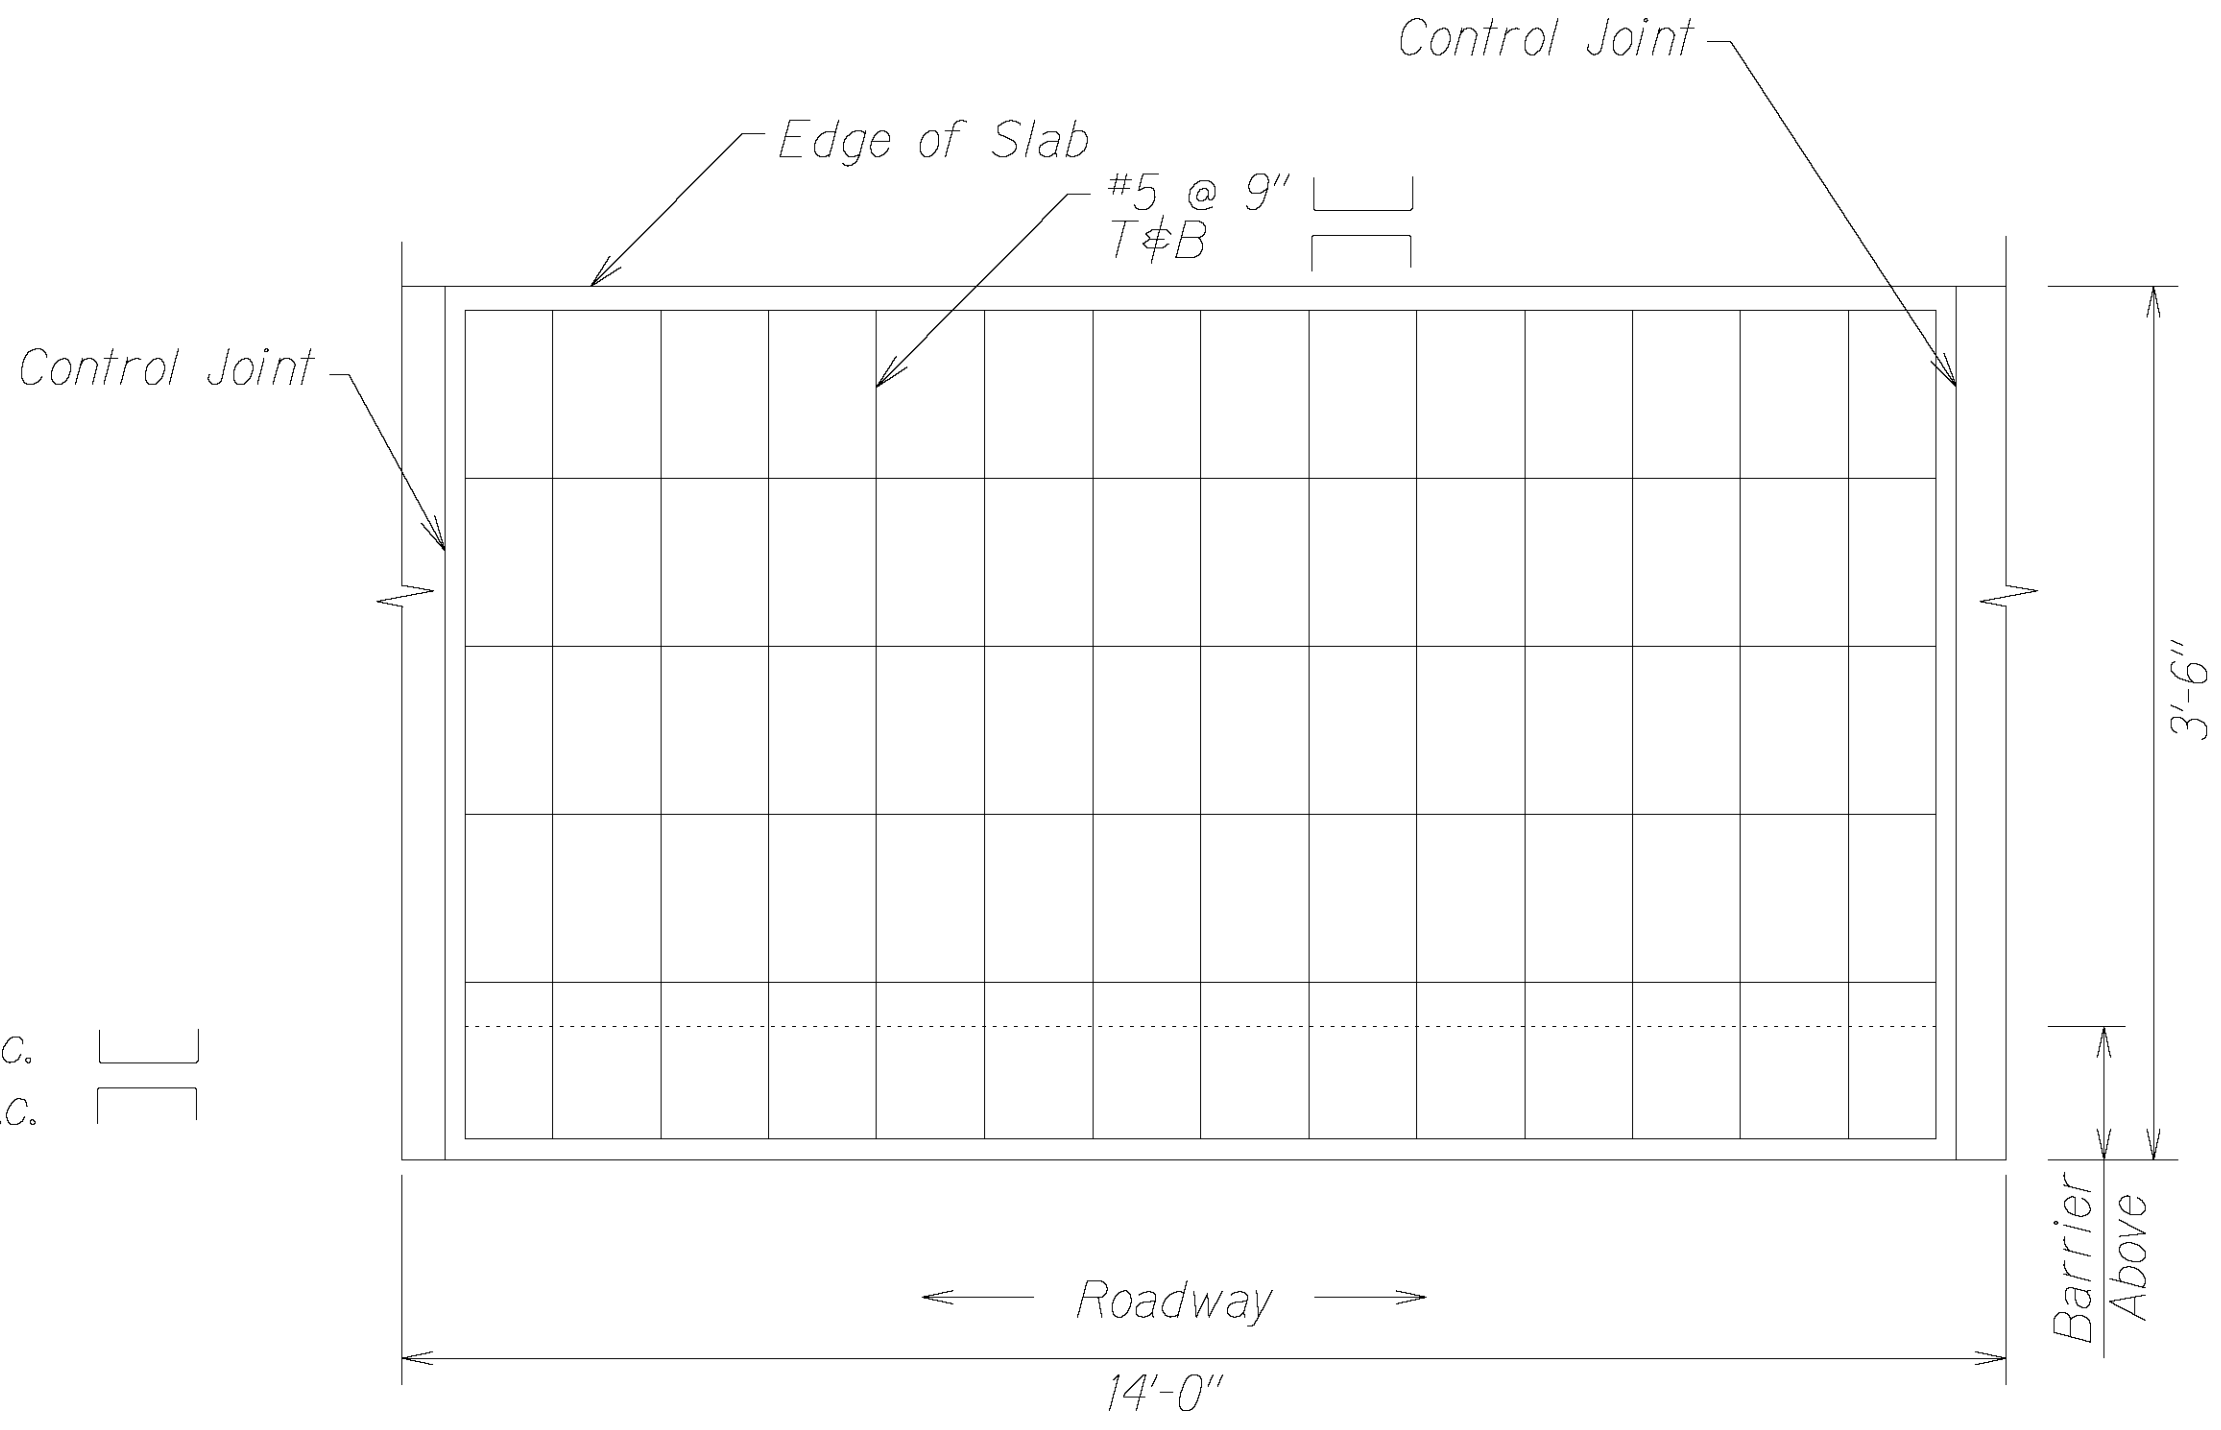


TYPICAL SLAB LAYOUT
Not to Scale


SURVEY PLOTTED BY	DATE
DRAWN BY	5/08
DESIGNED BY	
QUANTITIES BY	
CHECKED BY	

7/22/24	1 - RM-3 Mounting Detail
DATE	REVISION
STATE OF HAWAII DEPARTMENT OF TRANSPORTATION HIGHWAYS DIVISION	
MISCELLANEOUS DETAILS	
KUHIO HIGHWAY	
CONCRETE BARRIER INSTALLATION	
Vicinity of Lanikai Street	
Project No. 56A-01-24M	
Not to Scale	Date: May 2024
SHEET No. 1 OF 3 SHEETS	


FED. ROAD DIST. NO.	STATE	PROJ. NO.	FISCAL YEAR	SHEET NO.	TOTAL SHEETS
HAWAII	HAW.	56A-01-24M	2025	ADD.12	15

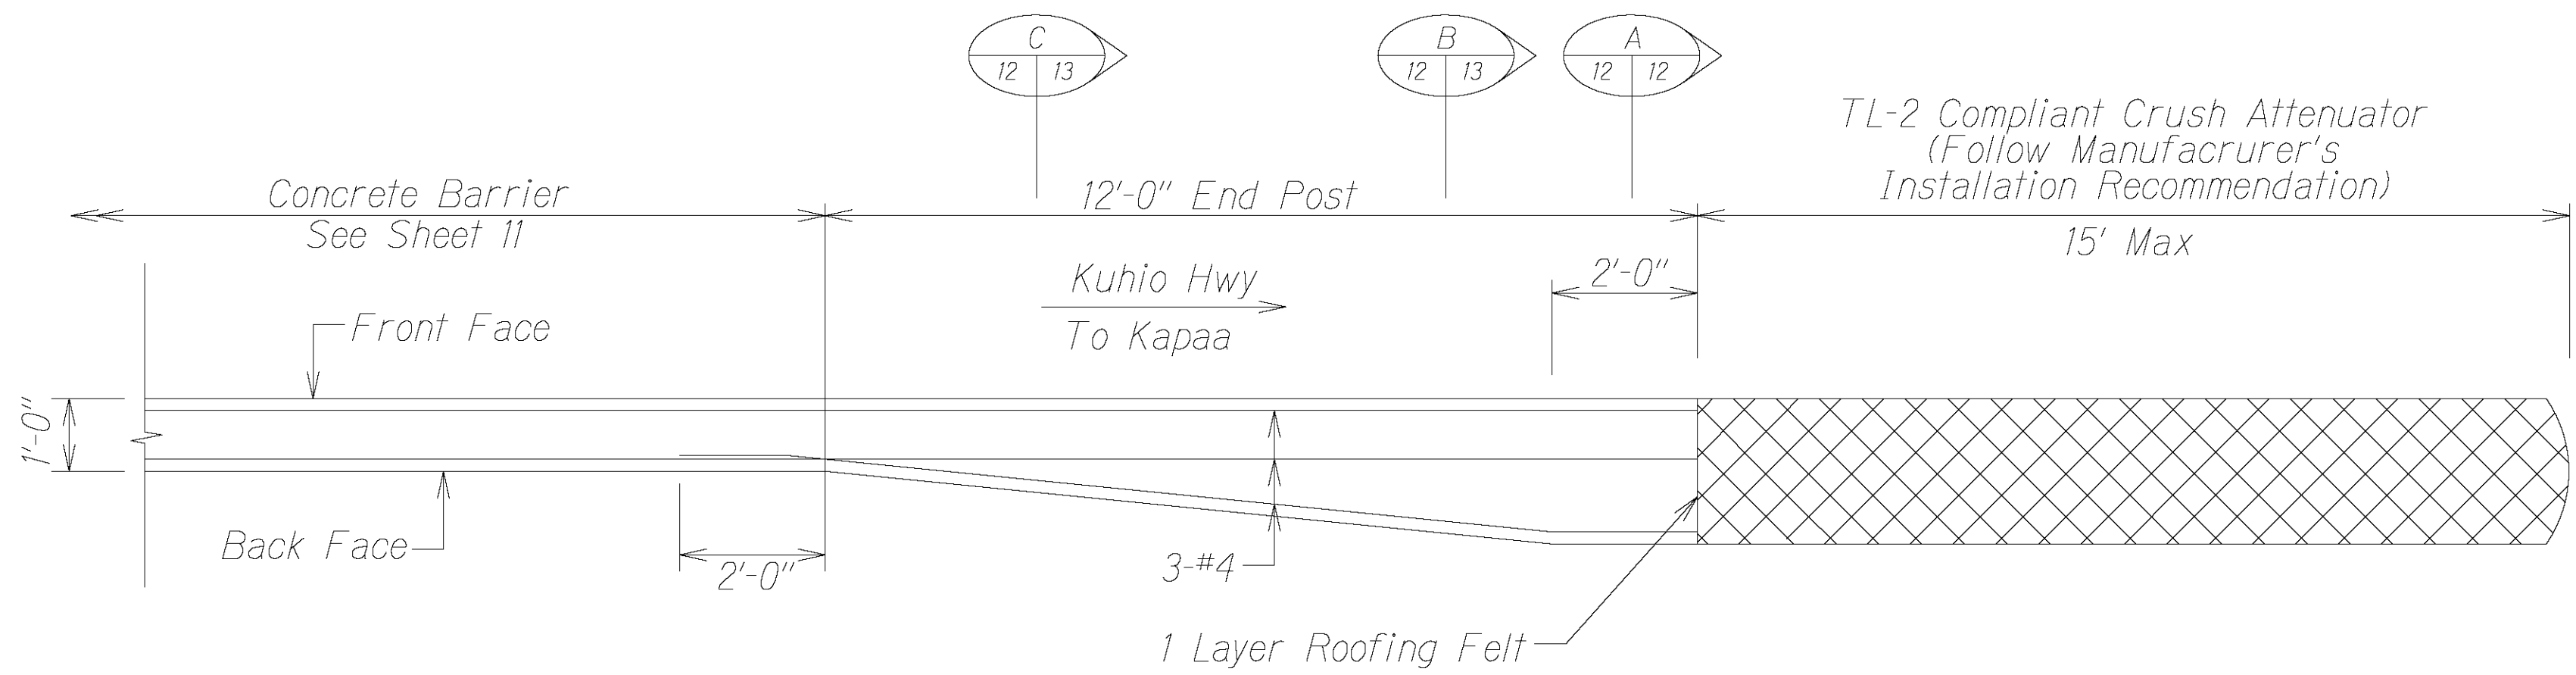

END POST PLAN
Not to Scale

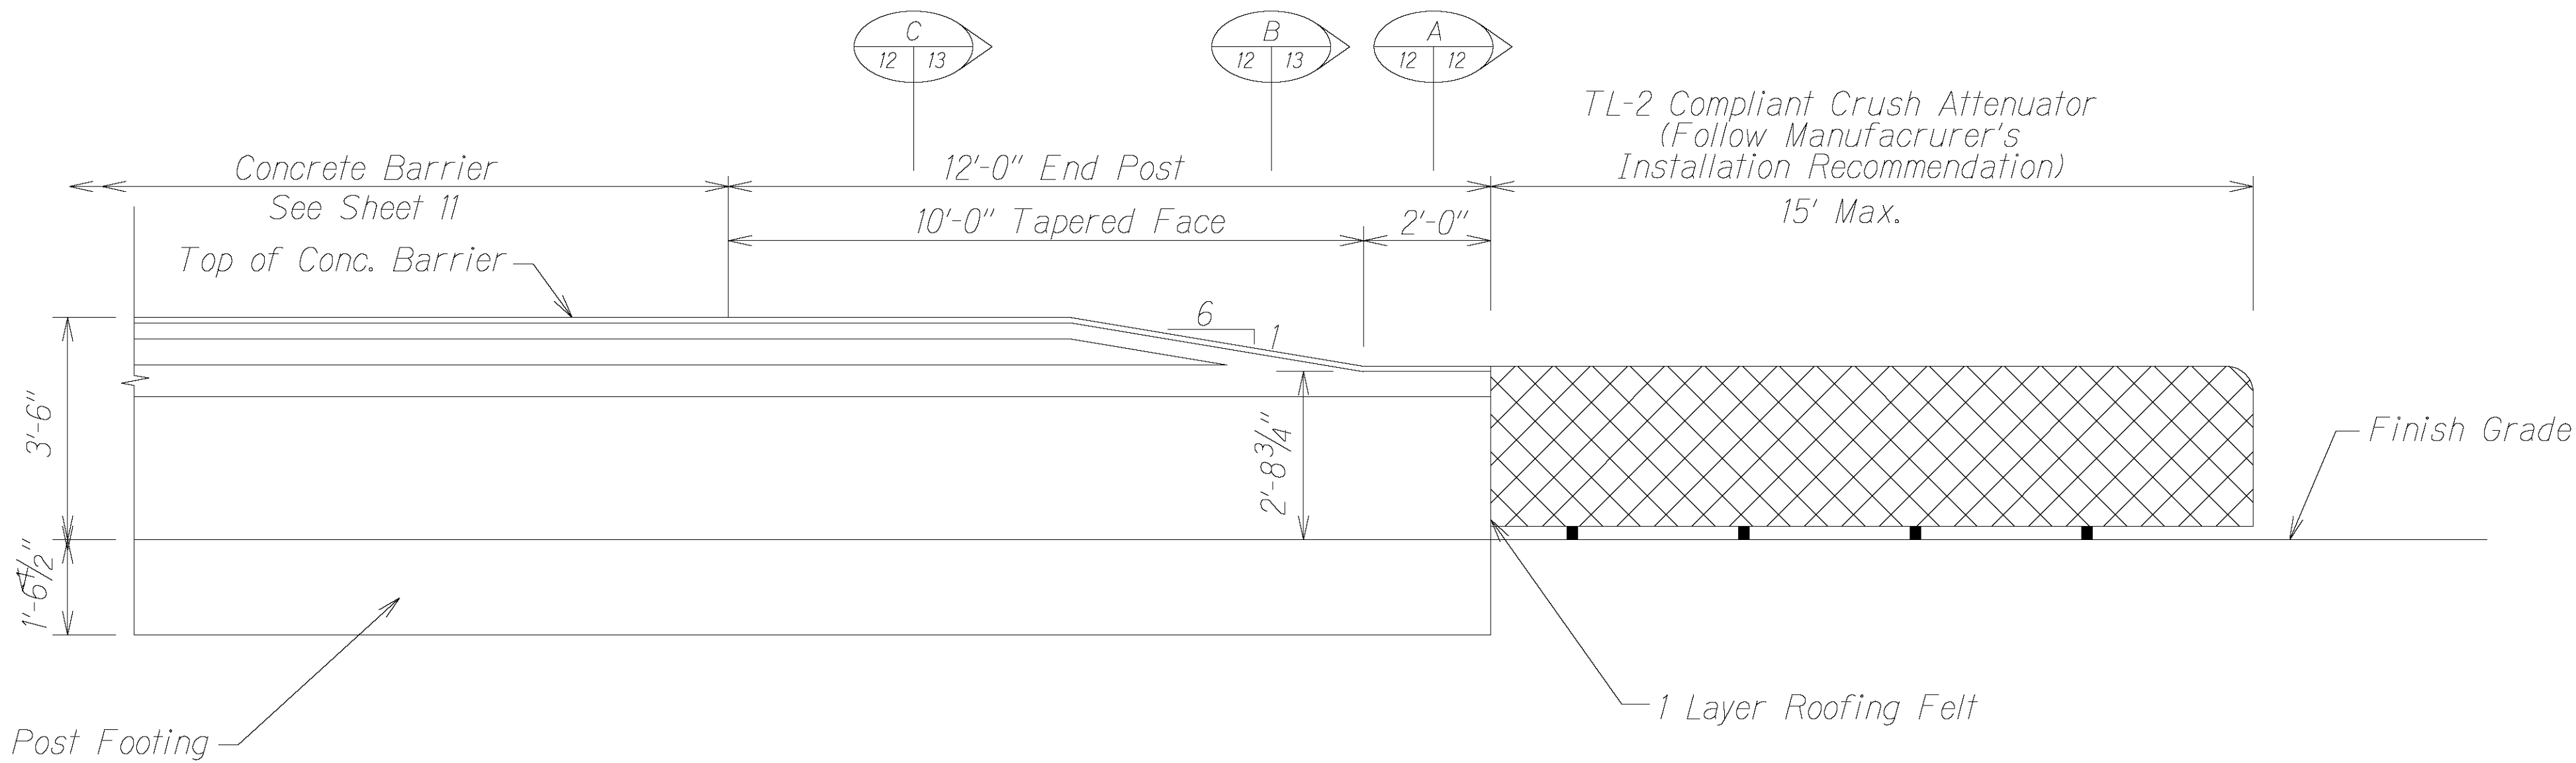

END POST ELEVATION
Not to Scale

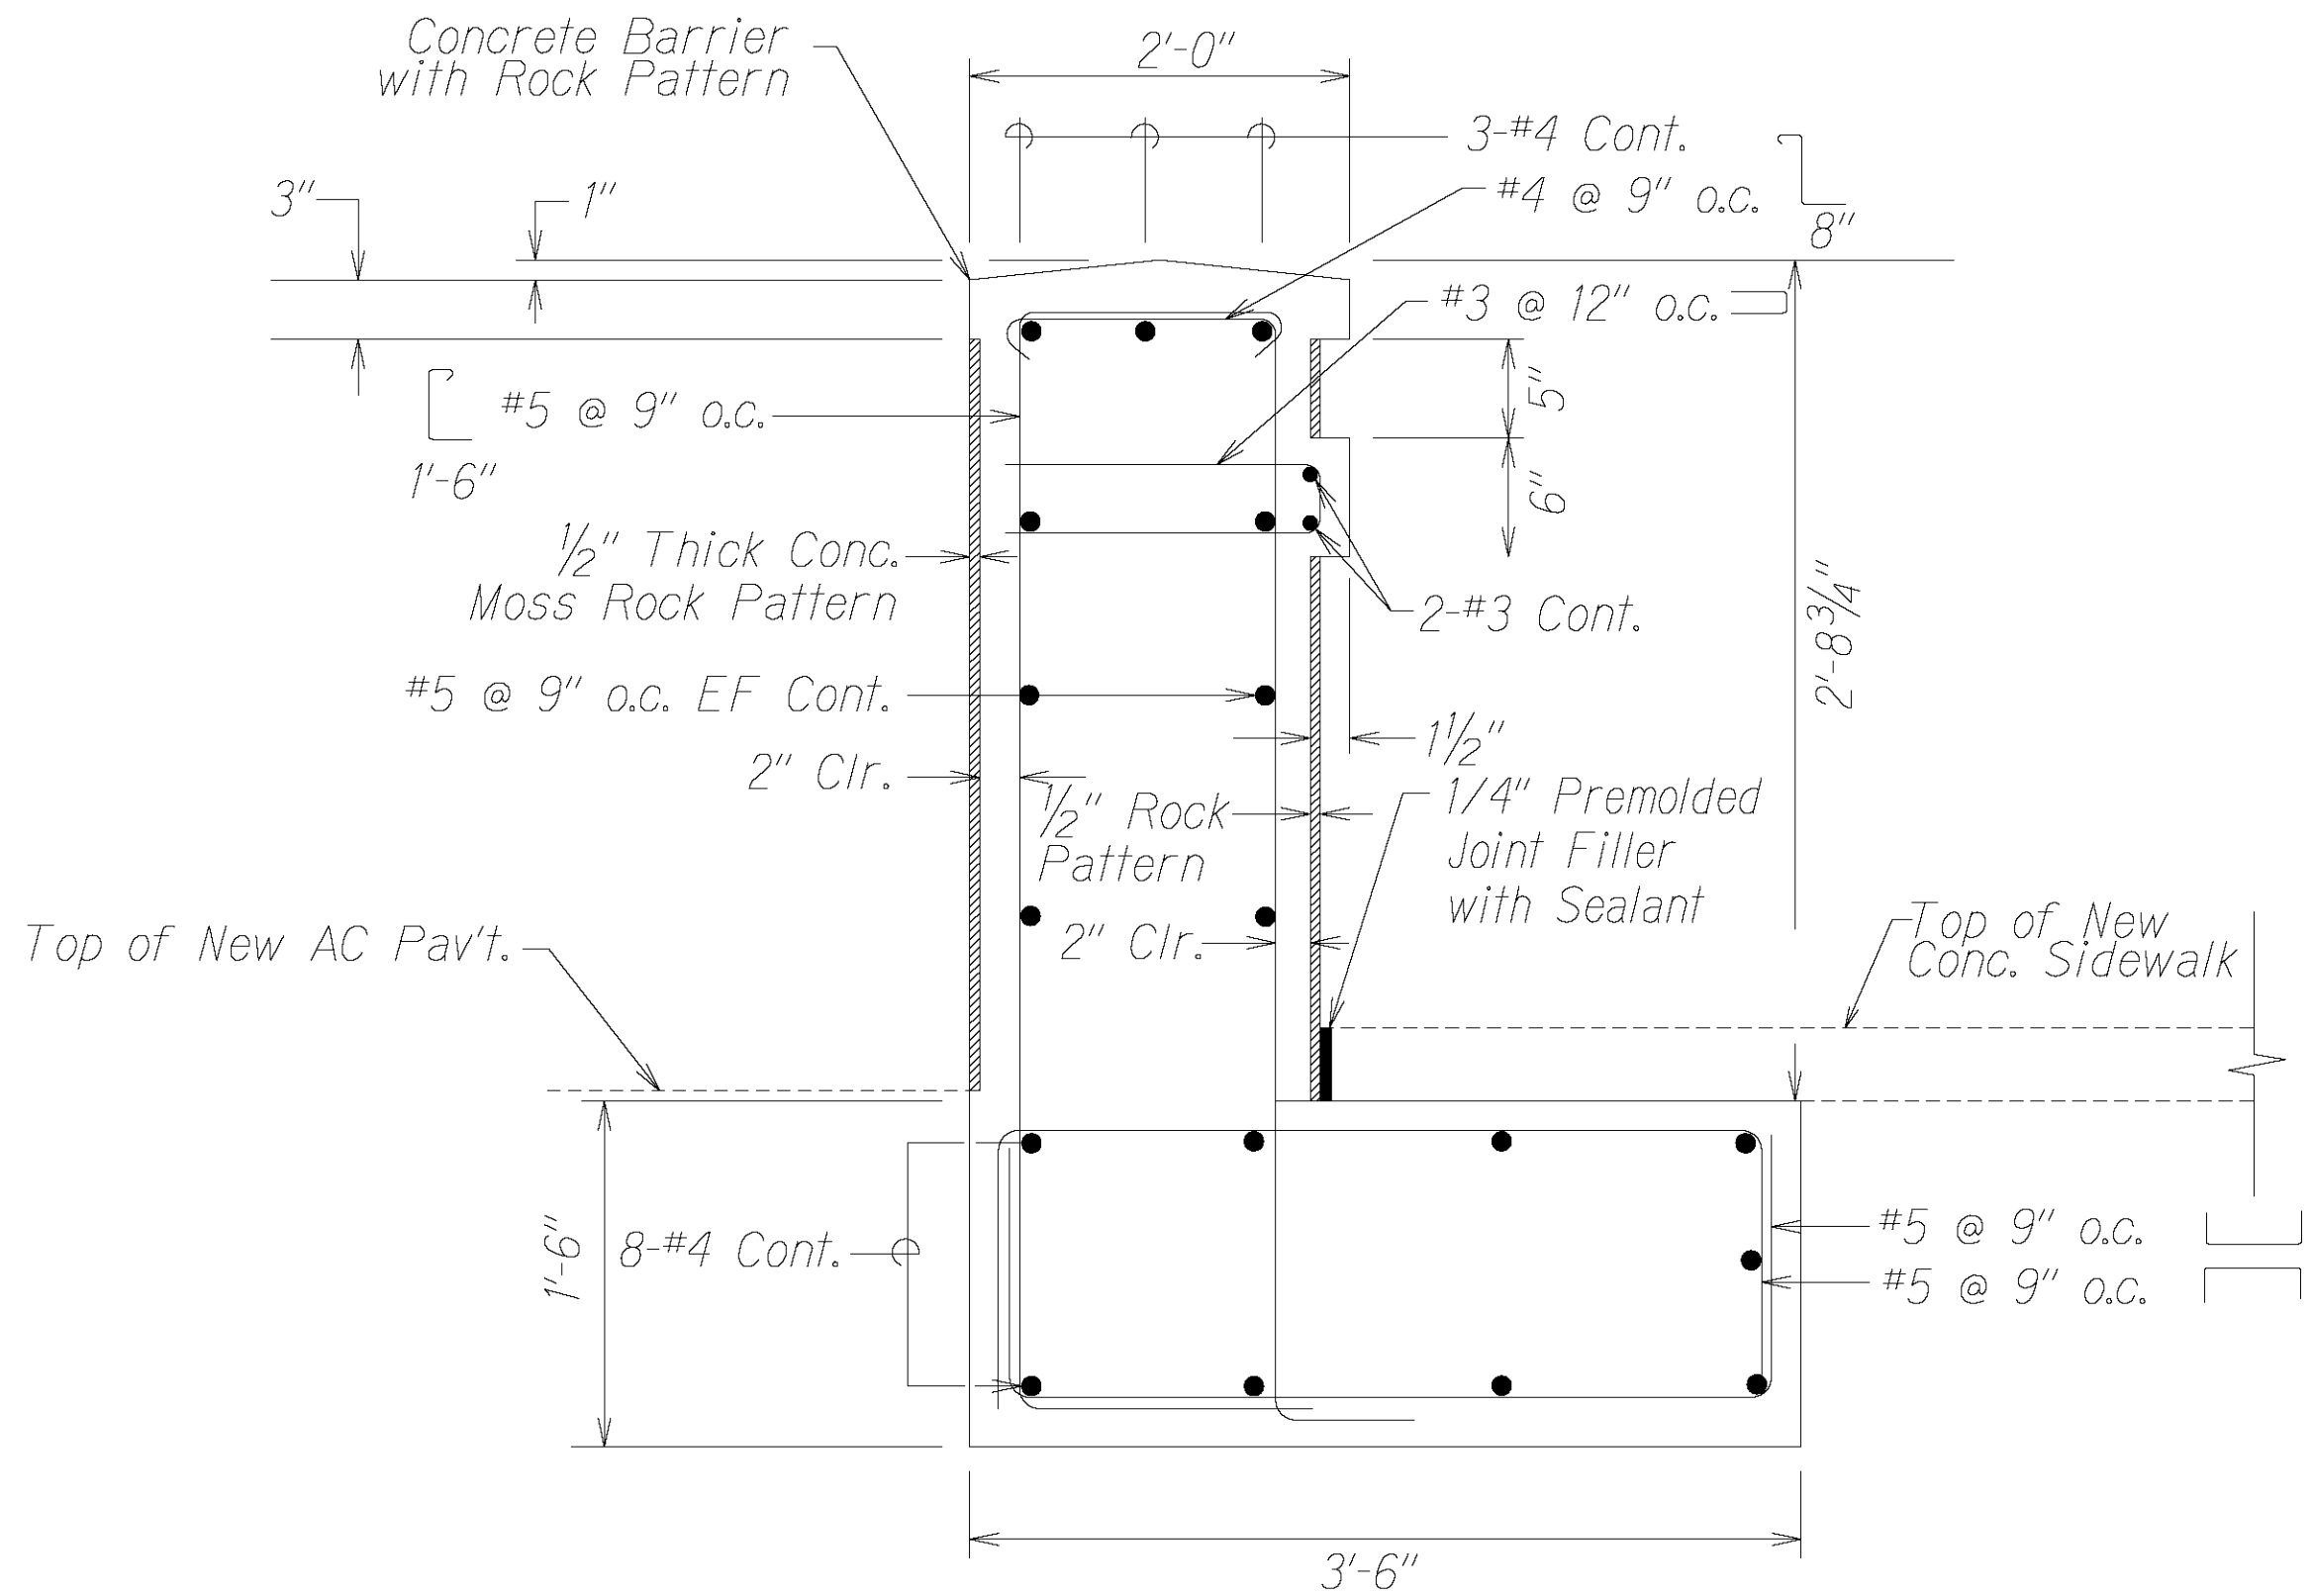


SECTION
Not to Scale

SURVEY PLOTTED BY	DATE
DRAWN BY	5/09
DESIGNED BY	
QUANTITIES BY	
CHECKED BY	
ORIGINAL PLAN	
NOTE BOOK	
6/1/2009	
N.	

7/22/24	1 - Revise End Post Plan & Elevation
DATE	REVISION
STATE OF HAWAII DEPARTMENT OF TRANSPORTATION HIGHWAYS DIVISION	
MISCELLANEOUS DETAILS KUHIO HIGHWAY CONCRETE BARRIER INSTALLATION Vicinity of Lanikai Street Project No. 56A-01-24M	
Not to Scale Date: May 2024	
SHEET No. 2 OF 3 SHEETS	

FED. ROAD DIST. NO.	STATE	PROJ. NO.	FISCAL YEAR	SHEET NO.	TOTAL SHEETS
HAWAII	HAW.	56A-01-24M	2025	ADD.14	15

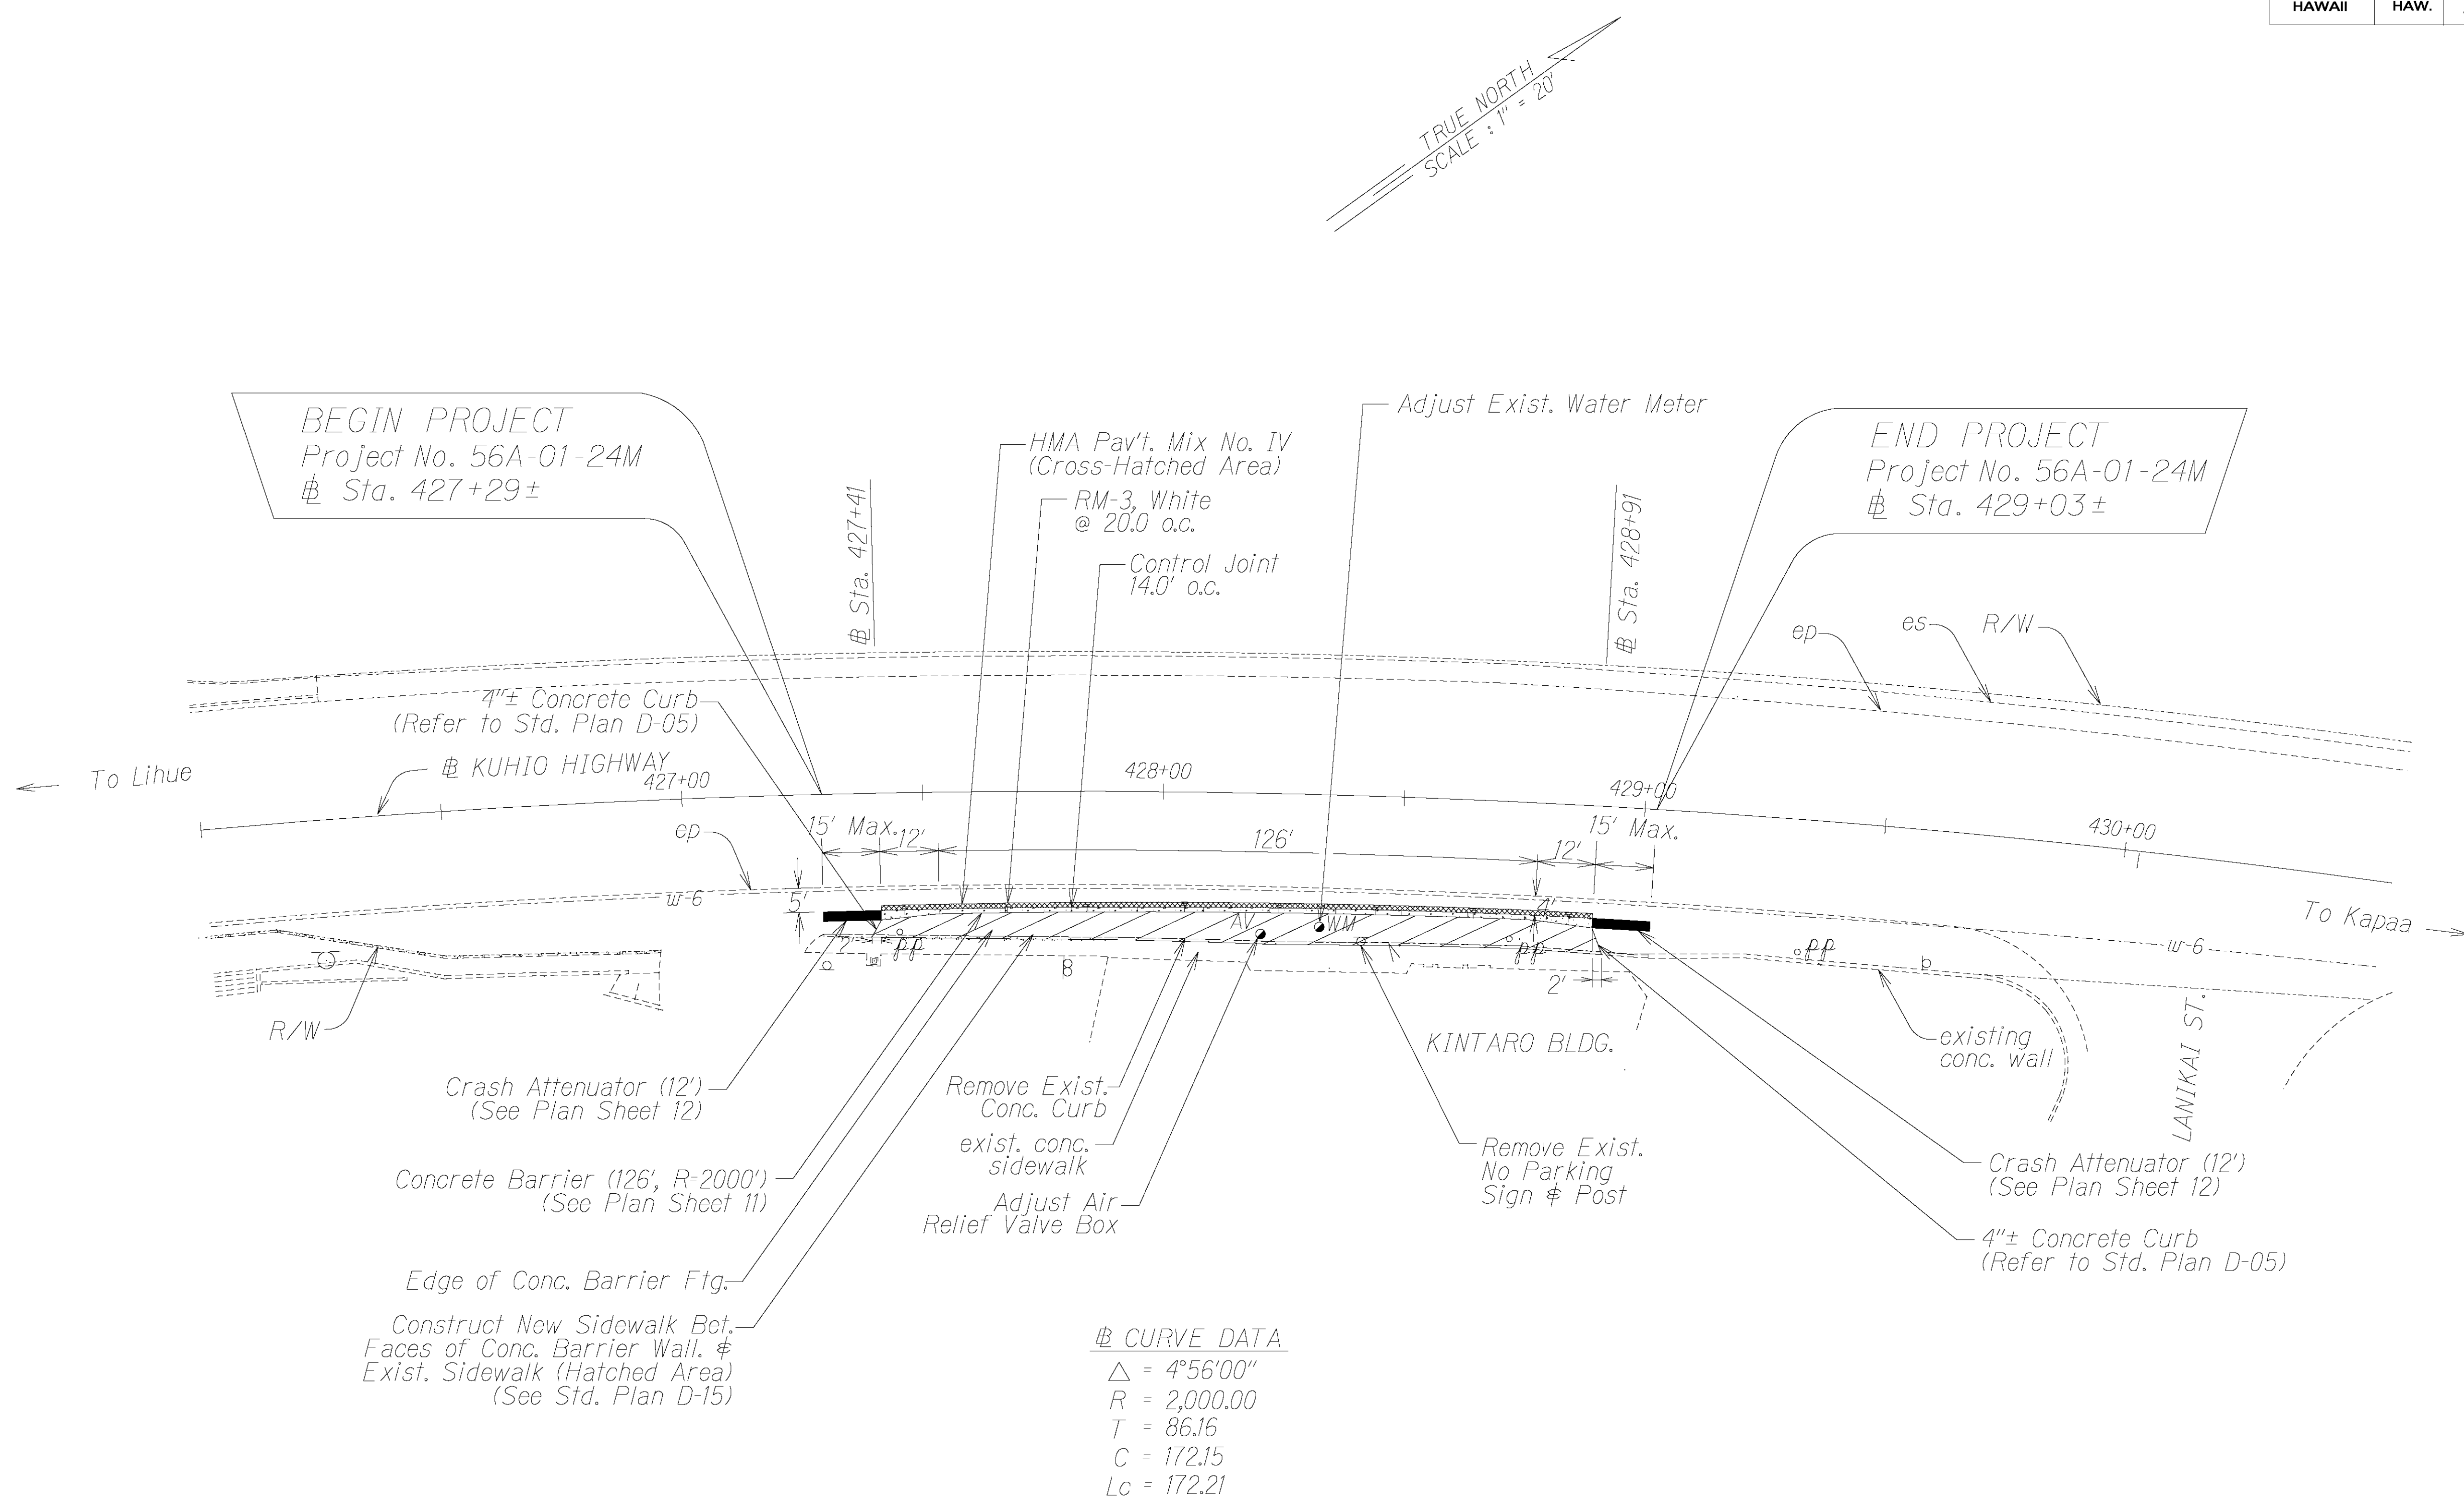

7/22/24	1 - Revise Roadway Plan
DATE	REVISION
STATE OF HAWAII DEPARTMENT OF TRANSPORTATION HIGHWAYS DIVISION	
ROADWAY PLAN KUHIO HIGHWAY CONCRETE BARRIER INSTALLATION Vicinity of Lanikai Street Project No. 56A-01-24M Scale: 1" = 20' Date: May 2024	
SHEET No. 1 OF 1 SHEETS	

ORIGINAL PLAN	SURVEY PLOTTED BY	DATE
NOTE BOOK	DRAWN BY	
DESIGNED BY		
QUANTITIES BY		
CHECKED BY		