



FED. ROAD DIST. NO.	STATE	PROJ. NO.	FISCAL YEAR	SHEET NO.	TOTAL SHEETS
HAWAII	HAW.	HWY-K-01-96M	1996	5	9

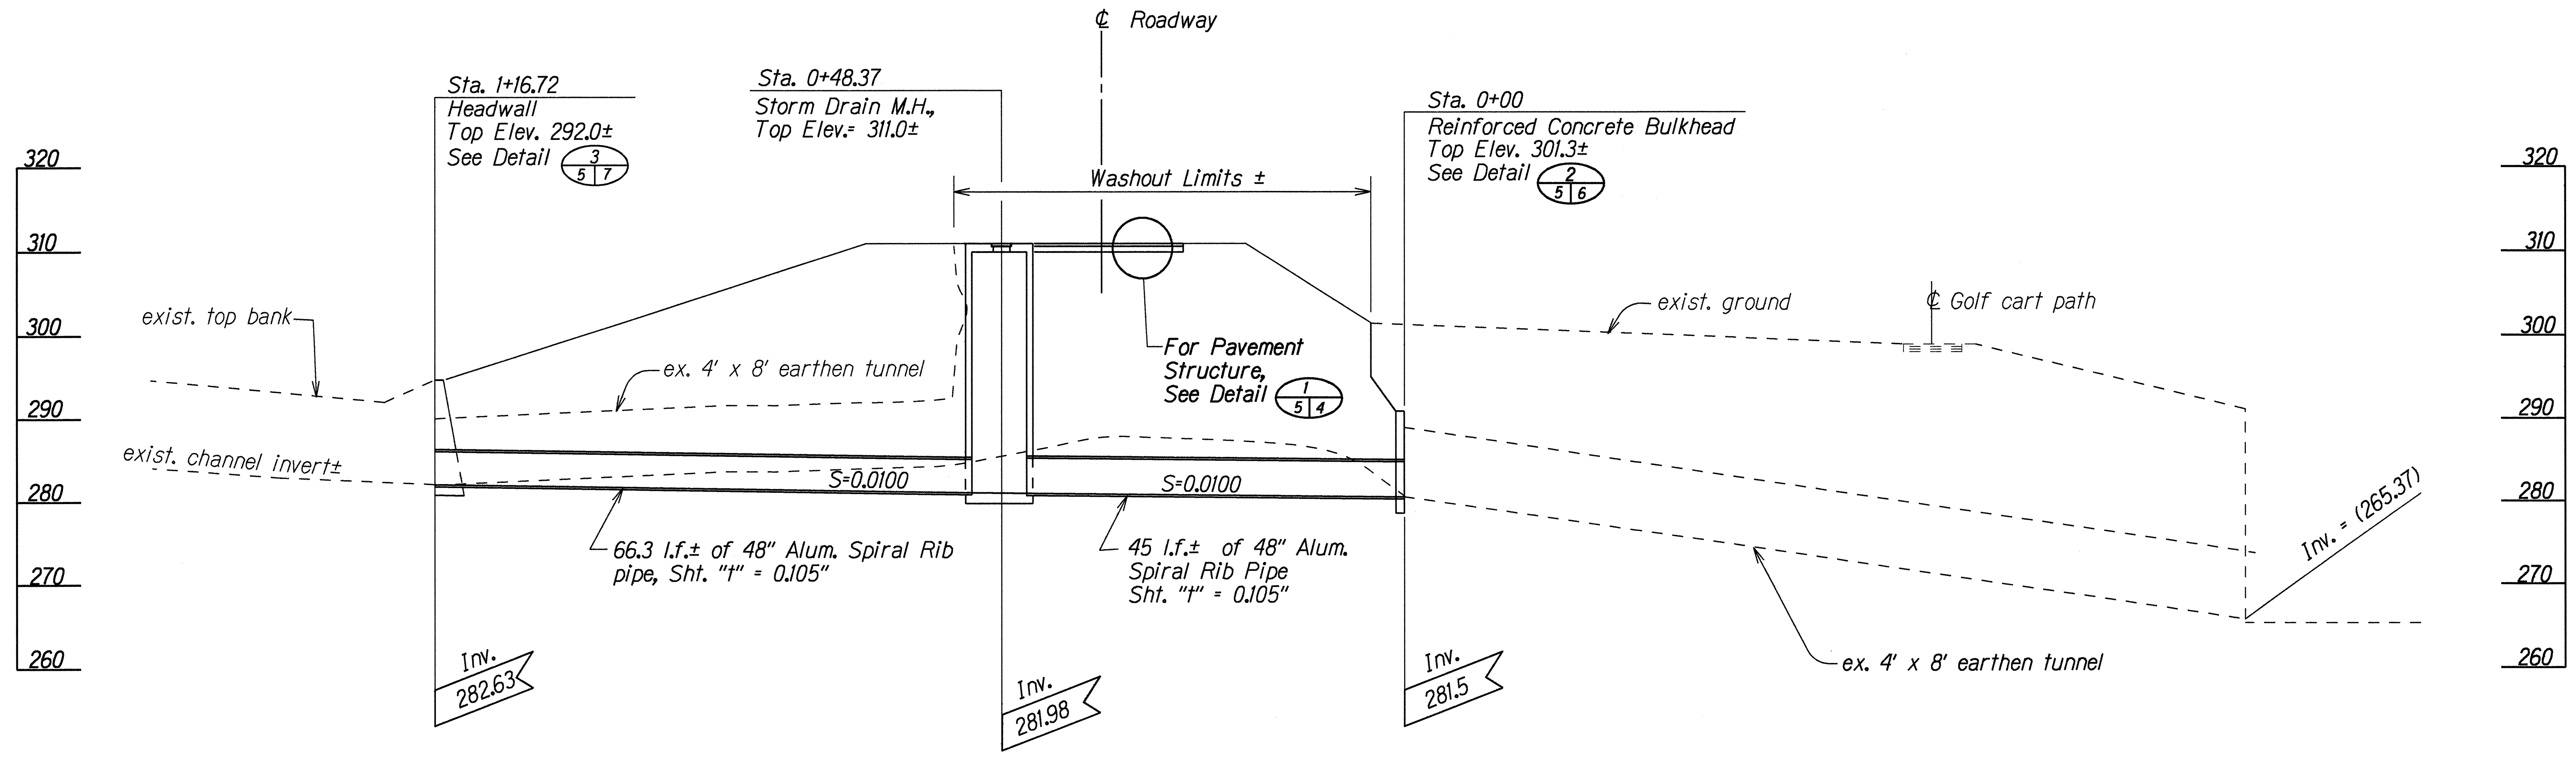

DRAINLINE PROFILE
Scale: 1" = 10'

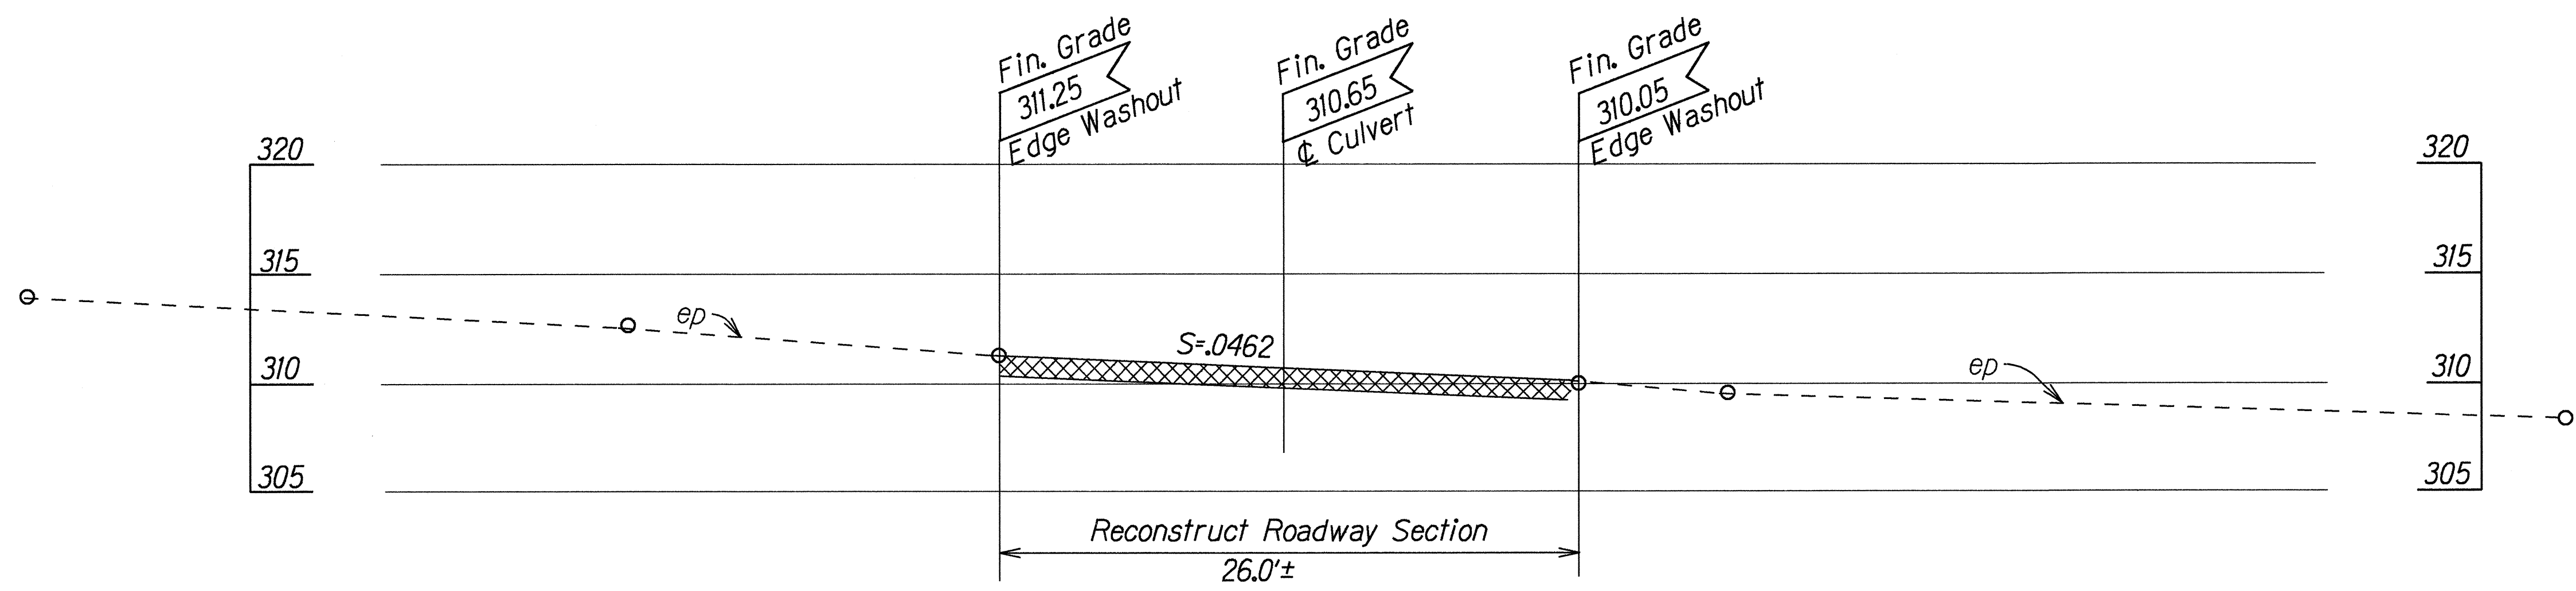

ROADWAY PROFILE
Scale: Horiz.: 1" = 5'
Vert.: 1" = 10'

Note: Width of paved roadway section shall match existing pavement width (± 20.0').

STATE OF HAWAII
DEPARTMENT OF TRANSPORTATION
HIGHWAYS DIVISION
DRAINLINE & ROADWAY PROFILE
(Old) Kuhio Highway
Storm Damage Repairs at Princeville
and
Kuhio Highway (24.8±)
Debris Removal at Kalihiwai
PROJECT NO. HWY-K-01-96M
Scale: As Shown Date: April, 1996
SHEET No. 1 OF 1 SHEETS

ORIGINAL PLAN	DATE	1/96
SURVEY PLOTTED BY	DATE	1/96
DRAWN BY	DATE	1/96
NOTED BY	DATE	1/96
CHECKED BY	DATE	1/96