
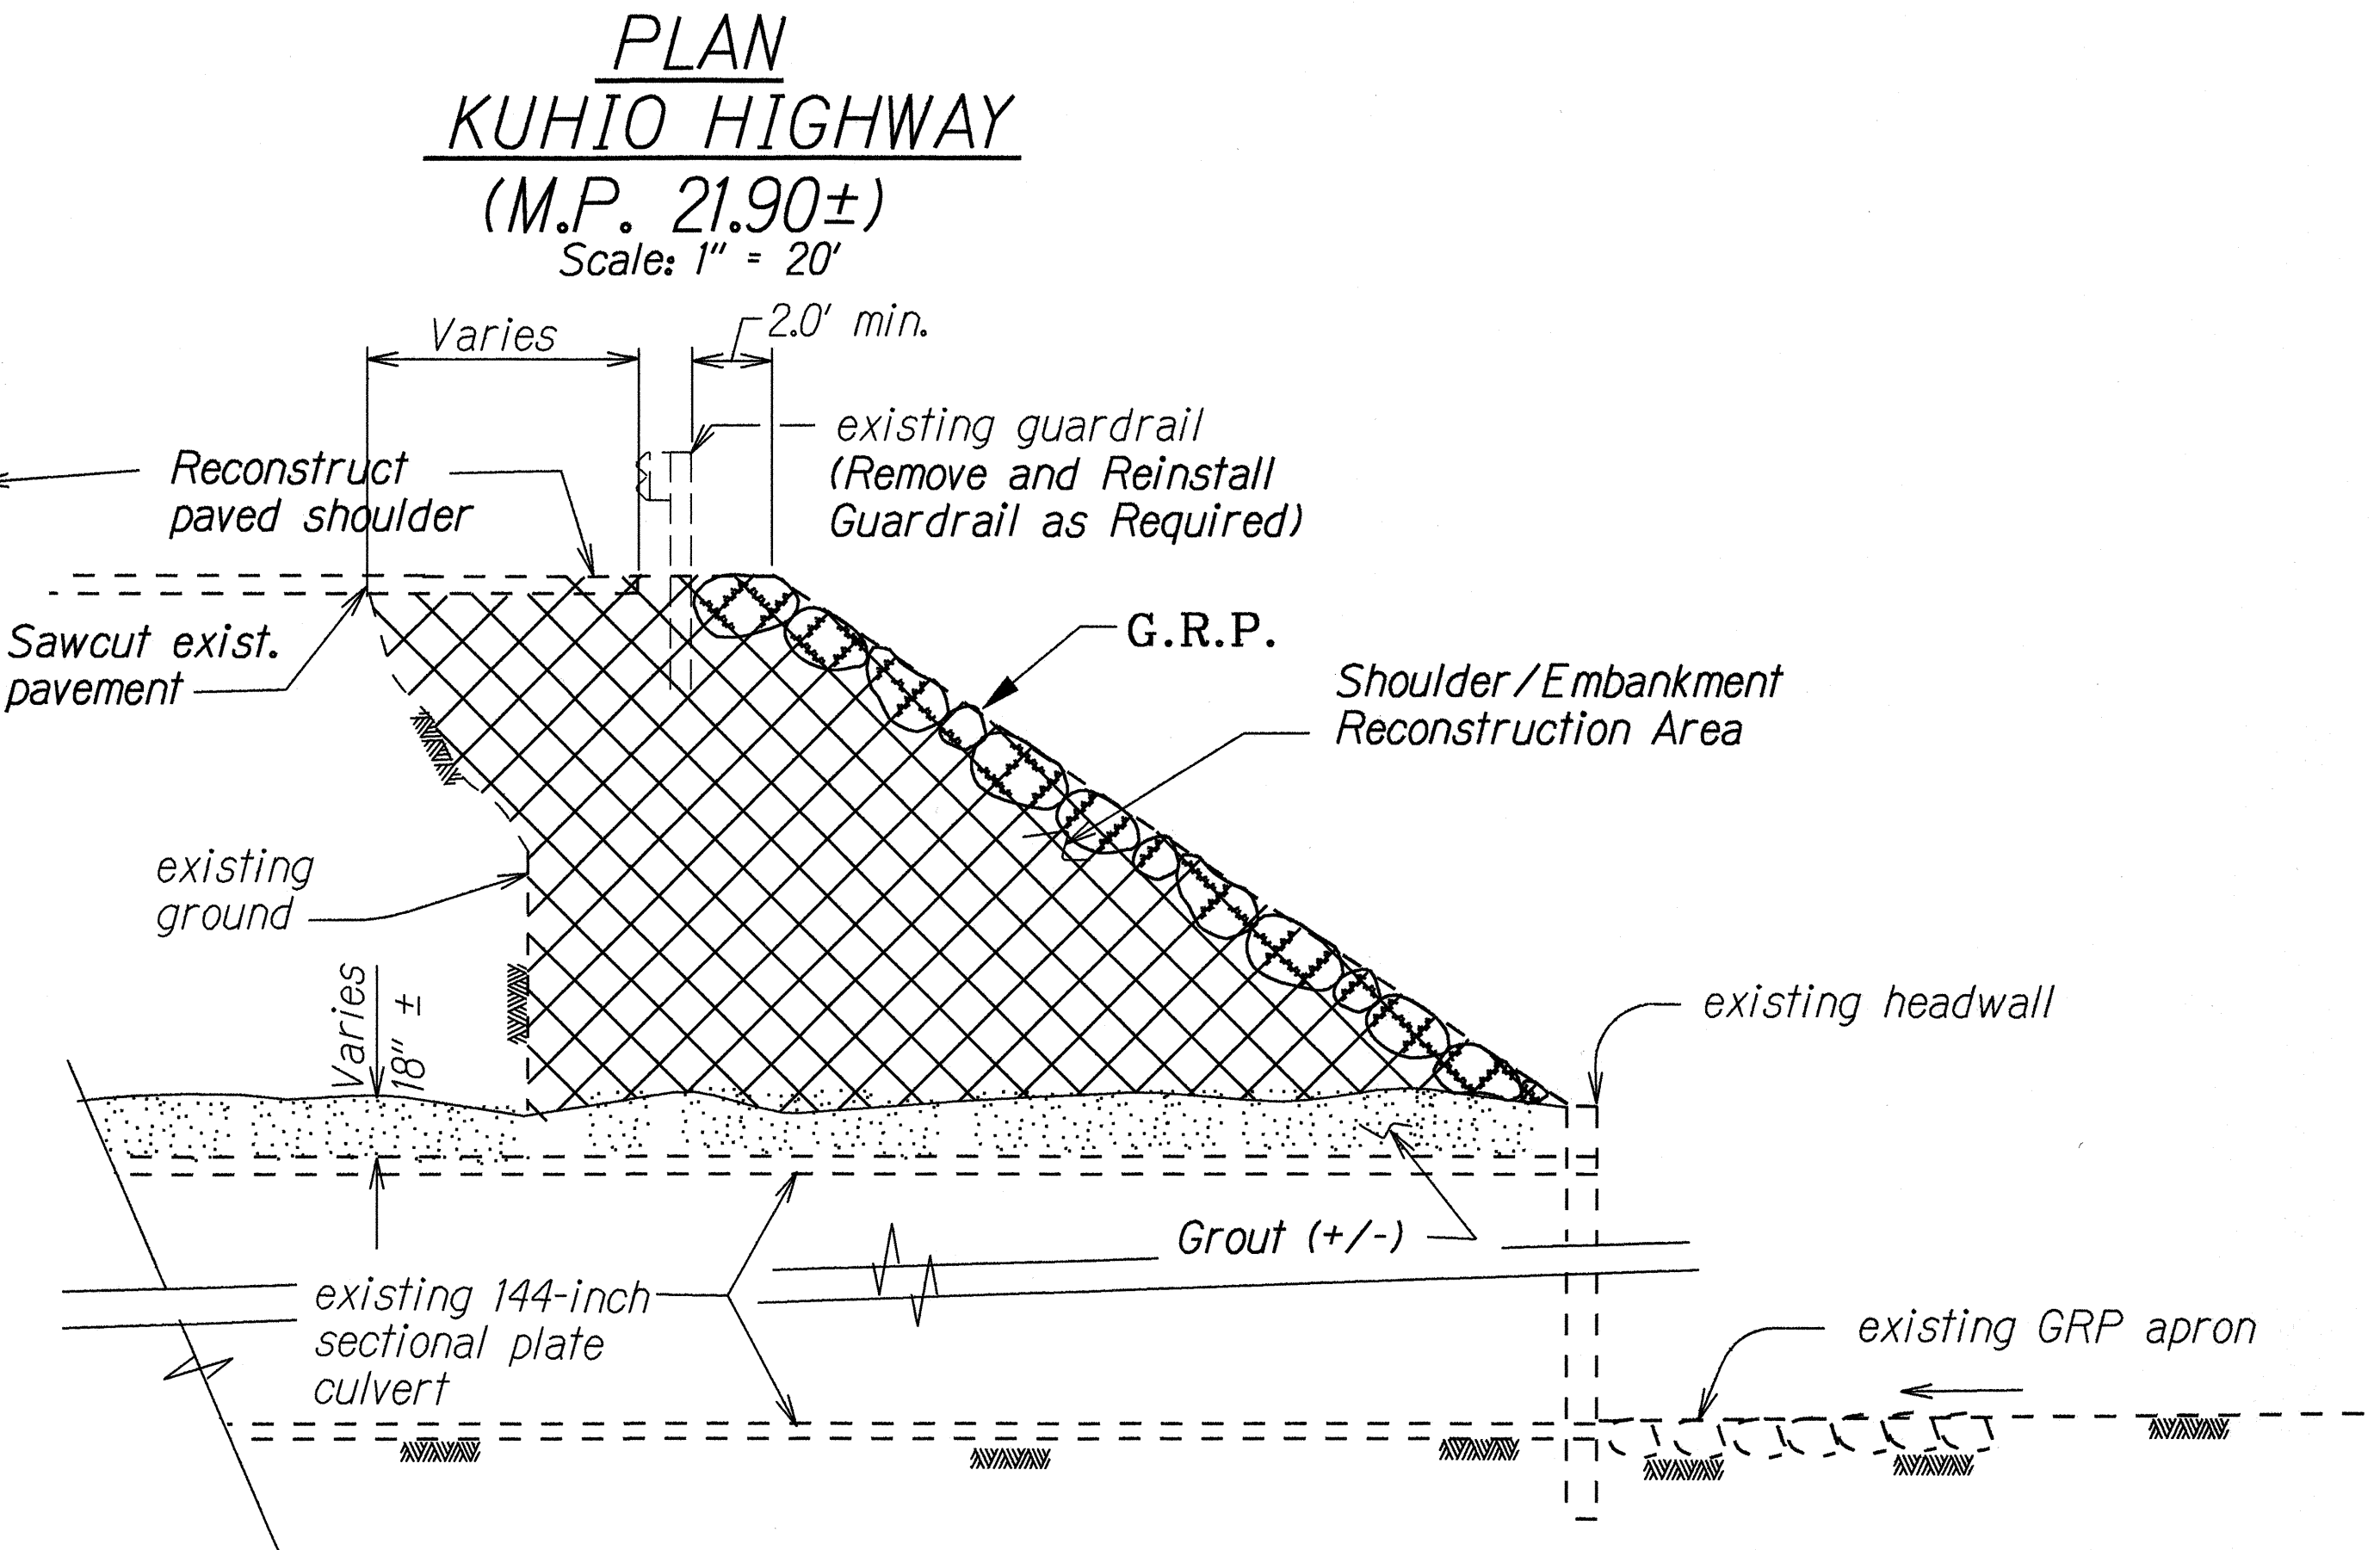
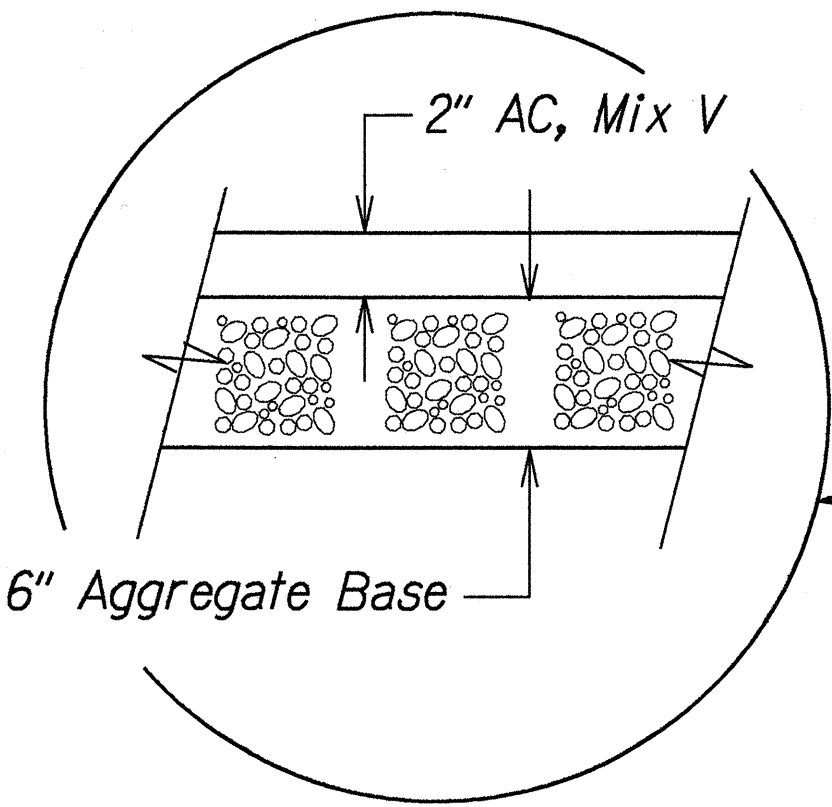


FED. ROAD DIST. NO.	STATE	PROJ. NO.	FISCAL YEAR	SHEET NO.	TOTAL SHEETS
HAWAII	HAW.	56C-01-96M	1996	3	4

GENERAL NOTES

- The scope of work for this project includes repairs to existing 144-inch sectional plate culvert and restoration of shoulder areas above the culvert.
- The Contractor is reminded of the requirements of Subsection 108.01 -Subletting of Contract, which requires the successful bidder to perform work amounting to not less than 50 percent of the total contract cost. Non-compliance with this Subsection may be grounds for rejection of bid.
- The Contractor's attention is directed to the following Sections of the Special Provisions: Subsection 107.13 - Public Convenience and Safety, Subsection 107.21 - Contractor's Responsibility for Utility Property and Services, Section 645 - Traffic Control.
- At the end of each day's work, the Contractor shall remove all equipment and other obstructions to permit free and safe passage of public traffic.
- The existence and location of underground utilities, manholes, monuments and structures as shown on the plans are from the latest available data but the accuracy is not guaranteed. The encountering of other obstacles during the course of the work is possible. The Contractor shall be held liable for any damages incurred to the existing facilities and/or improvements as a result of his operations.
- Existing drainage system will be functional at all times during construction. Contractor is to furnish materials, equipment, labor, tools and incidentals necessary to maintain flow. This work shall be considered incidental to the various contract items.
- All lanes shall be opened to traffic during the morning peak hours from 6:30 AM to 8:30 AM and during the afternoon peak hours from 3:30 PM to 6:00PM and during off-work hours. Only one lane of traffic shall be closed at any other time.
- Prior to bidding, the Contractor shall conduct field investigations to examine the project site. All incidental work required to complete the work called for on the plans shall be included in his bid price for Item No.653.0100 - Repair Existing 144-Inch Sectional Plate Culvert.
- The Contractor shall erect, at the beginning of the project and at the end of the project, advance construction warning signs as indicated on the plans or as directed by the Engineer for the duration of the highway project and shall be maintained by the Contractor. These signs shall be placed in addition to the required traffic control signs called for in Section 645-Traffic Control. The advance construction warning signs shall be new and become the property of the State. The Contractor shall remove, clean, and deliver the signs and posts to the Kauai District Baseyard or as directed by the Engineer at the end of the project. The advance construction warning signs shall be paid under Item No.621.7100 - Construction Sign with Posts.

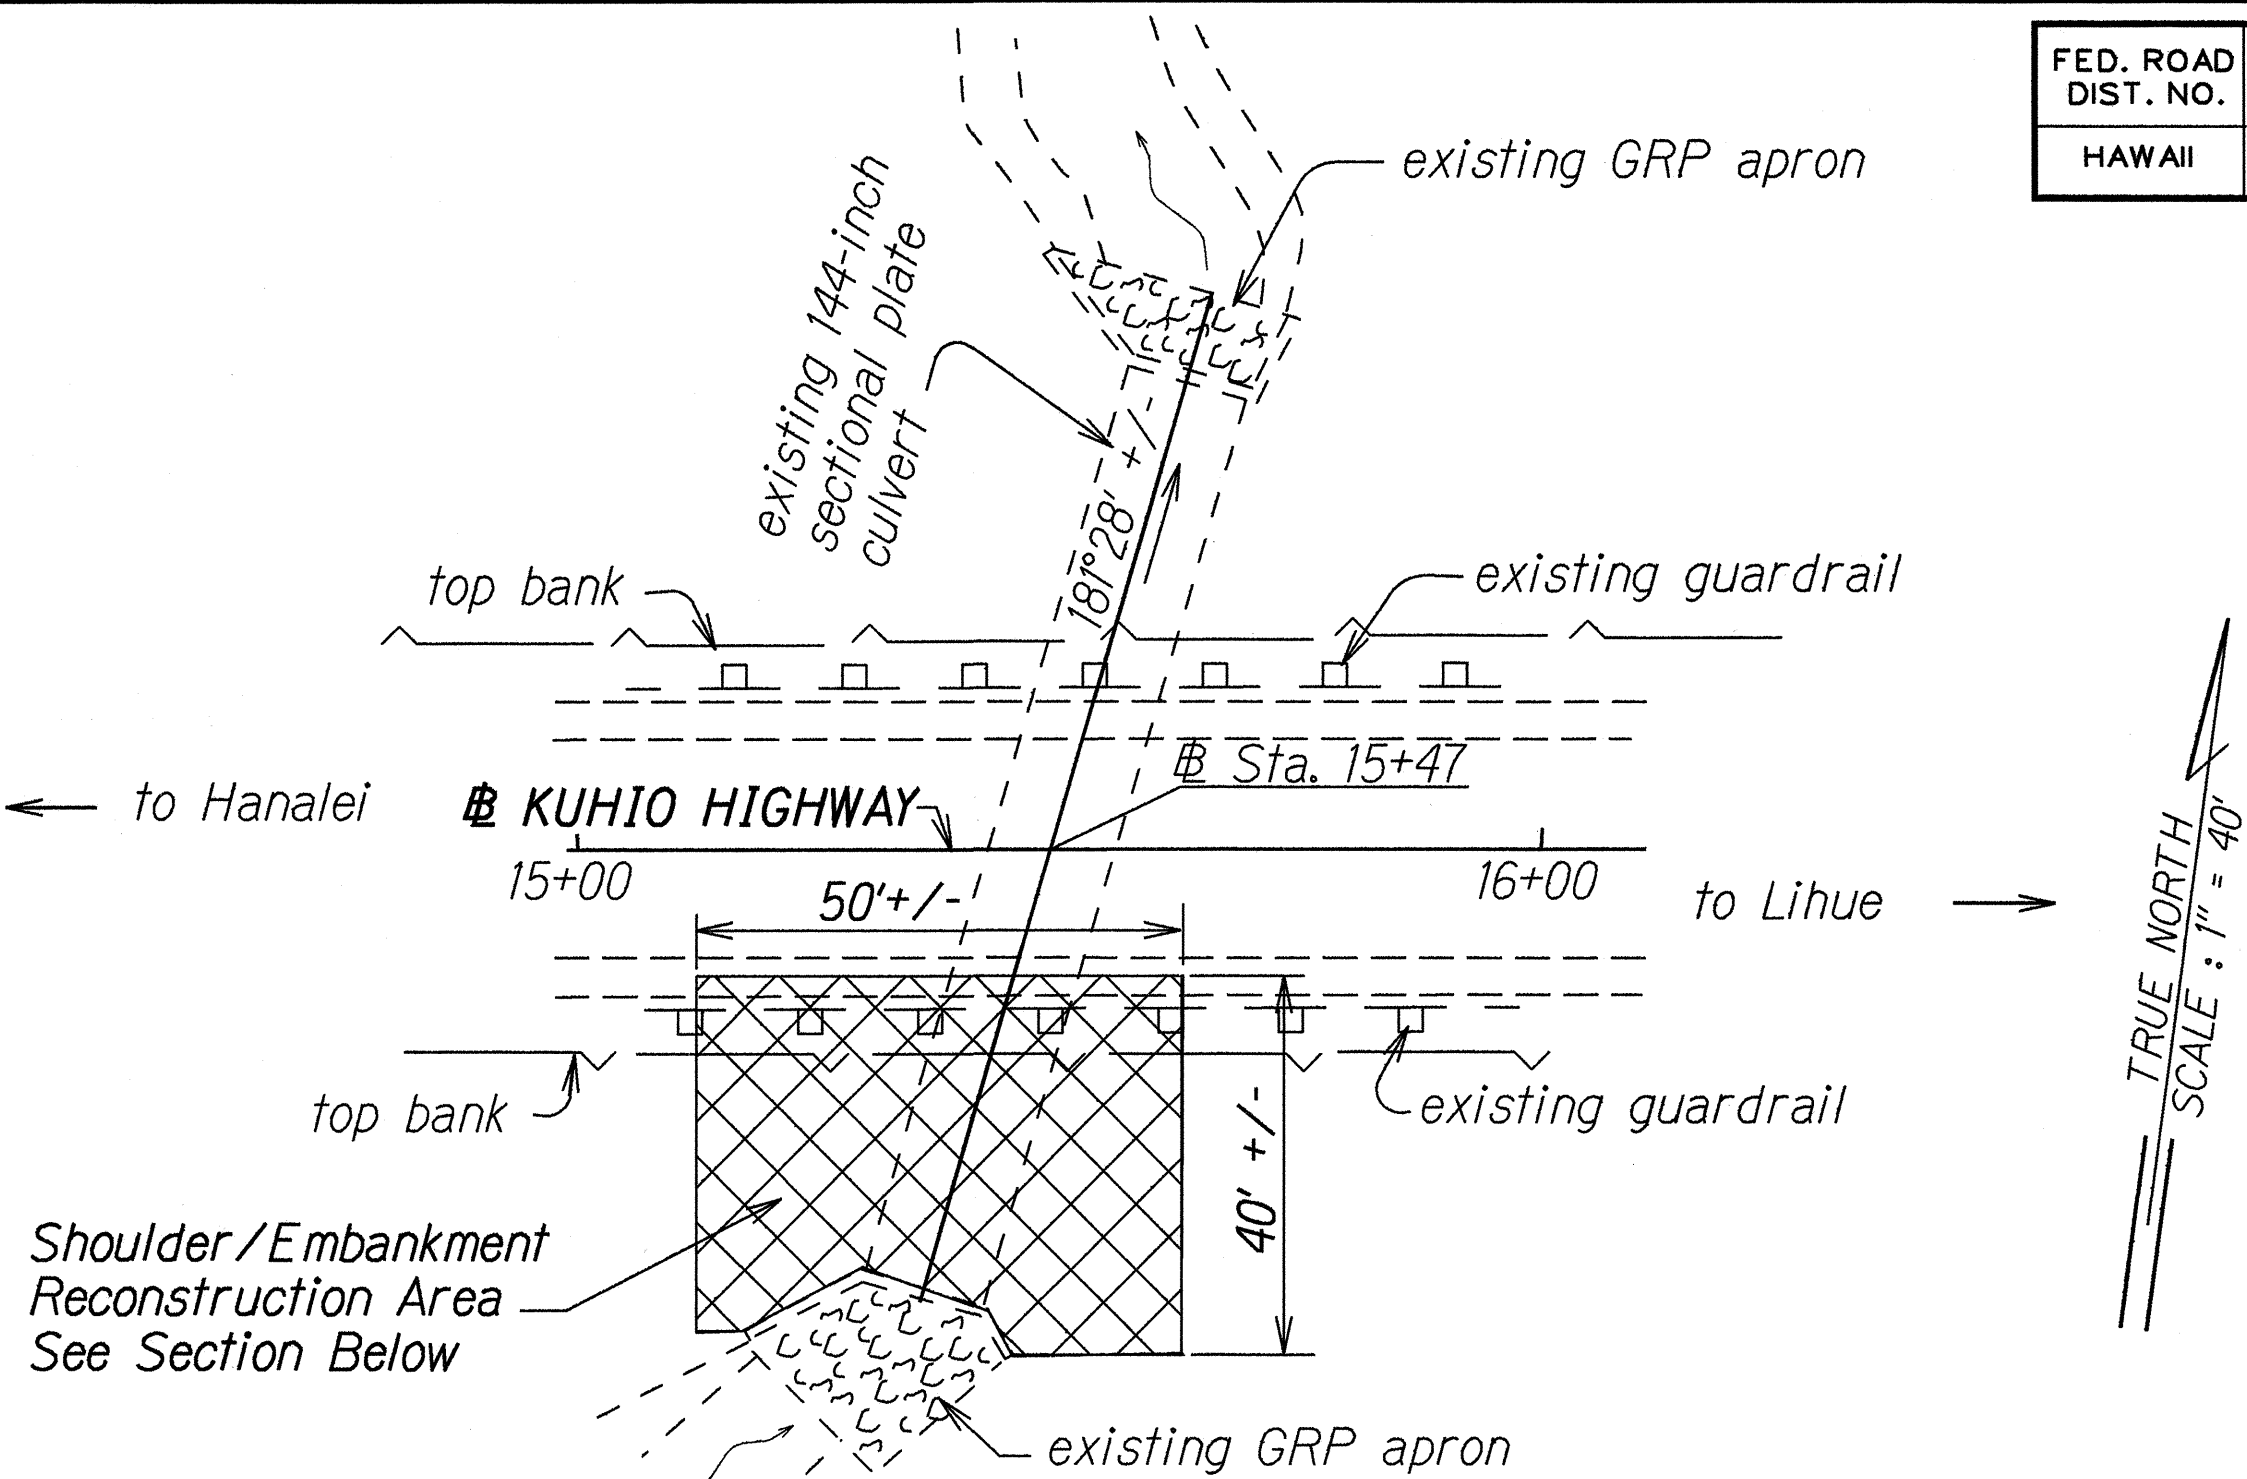

LEGEND FOR AS-BUILT POSTINGS	
	Squiggly line for as-built deletion
	Double line for as-built deletion
Roadway	Text for as-built posting

SHOULDER/EMBANKMENT RECONSTRUCTION

Scale: 1/4" = 1'-0"

STATE OF HAWAII DEPARTMENT OF TRANSPORTATION HIGHWAYS DIVISION	
GENERAL NOTES AND DETAILS	
KUHIO HIGHWAY	
STORM DAMAGE REPAIRS	
AT	
KILAUEA	
Project No. 56C-01-96M	
Scale: None	Date: May, 1996
SHEET No. 1 OF 1 SHEETS	

ORIGINAL PLAN	DATE: 1/96
SURVEY PLOTTED BY: S.M.H.	
DRAWN BY: S.M.H.	
DESIGNED BY: S.M.H.	
CHECKED BY: S.M.H.	

"AS-BUILT"