	INDEX TO DRAWINGS
SHEET NO.	DESCRIPTION
1	TITLE SHEET
2	STANDARD PLANS SUMMARY
3	GENERAL NOTES AND DETAILS
4	CULVERT REPAIR SECTION

STATE OF HAWAII

DEPARTMENT OF TRANSPORTATION


HIGHWAYS DIVISION
HONOLULU, HAWAII

"AS-BUILT"
PLANS FOR


KUHIO HIGHWAY

STORM DAMAGE REPAIRS AT KILAUEA PROJECT NO. 56C-01-96M

DISTRICT OF HANALEI ISLAND OF KAUAI

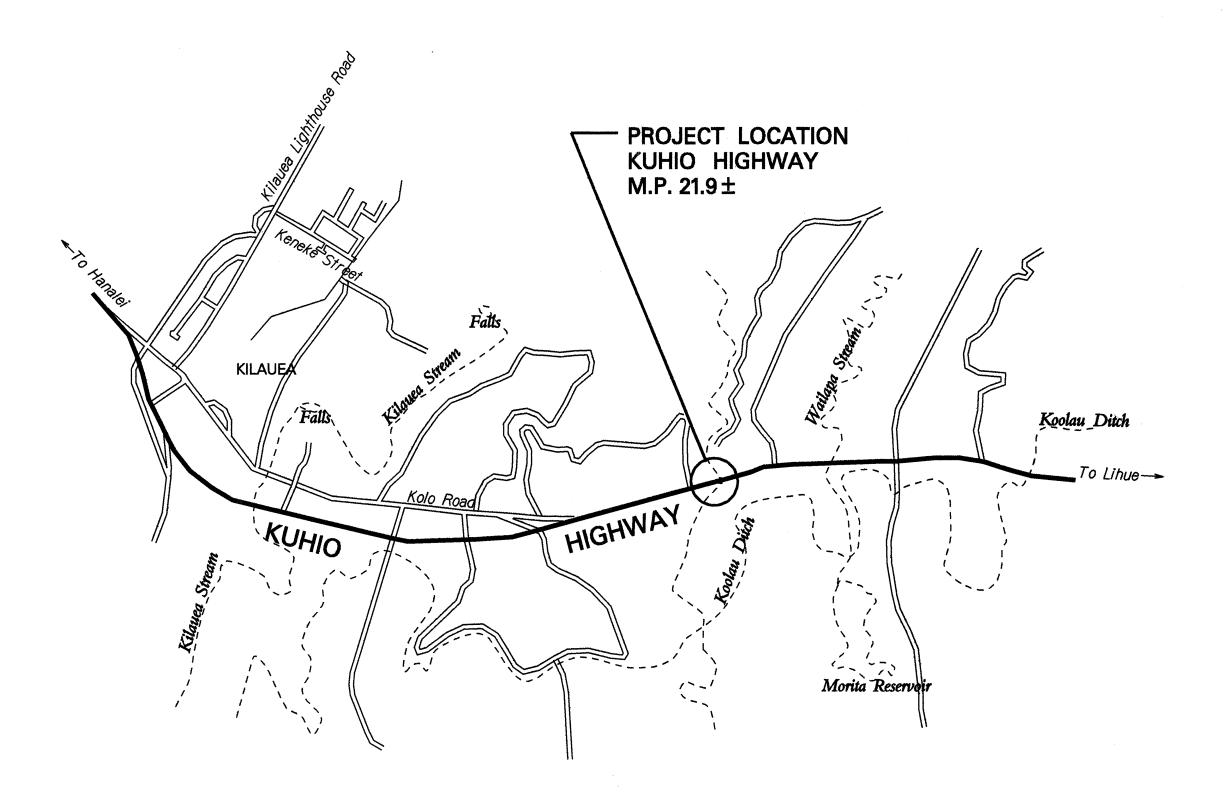

LAYOUT PLAN

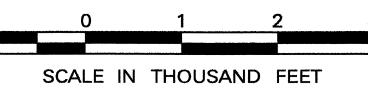





FED. ROAD DIST. NO. STATE FED. AID PROJ. NO. FISCAL SHEET NO. SHEETS

HAWAII HAW. 56C-01-96M 1996 1 4



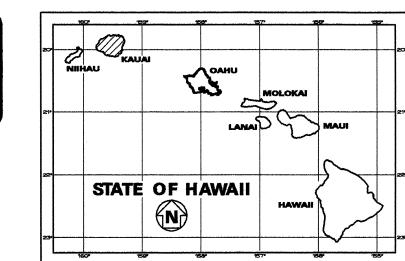

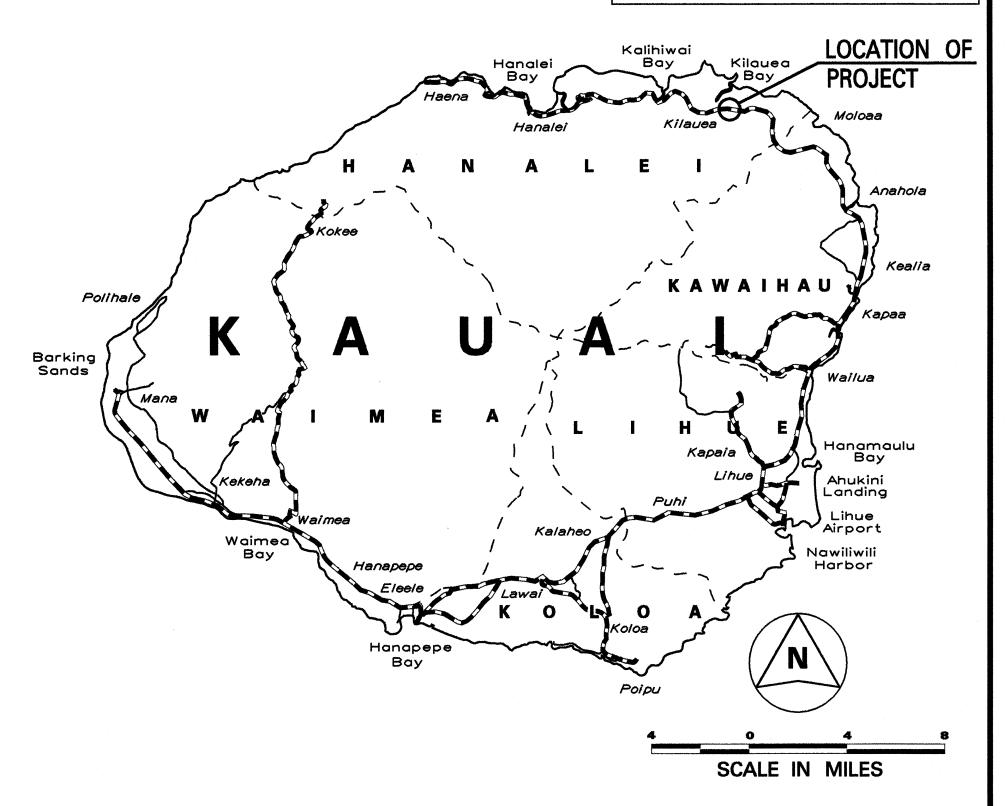

FEDERAL AID PROJECTS PREVIOUSLY CONSTRUCTED OR UNDER CONSTRUCTION

MILE POST 21.90±

CHANGES MADE DURING CONSTRUCTION HAVE BEEN NOTED ON THESE PLANS AND CHECKED BY:

RESIDENT ENGINEER

DATE

DEPARTMENT OF TRANSPORTATION STATE OF HAWAII

APPROVED:

DIR. OF TRANSPORTATION DATE

1