
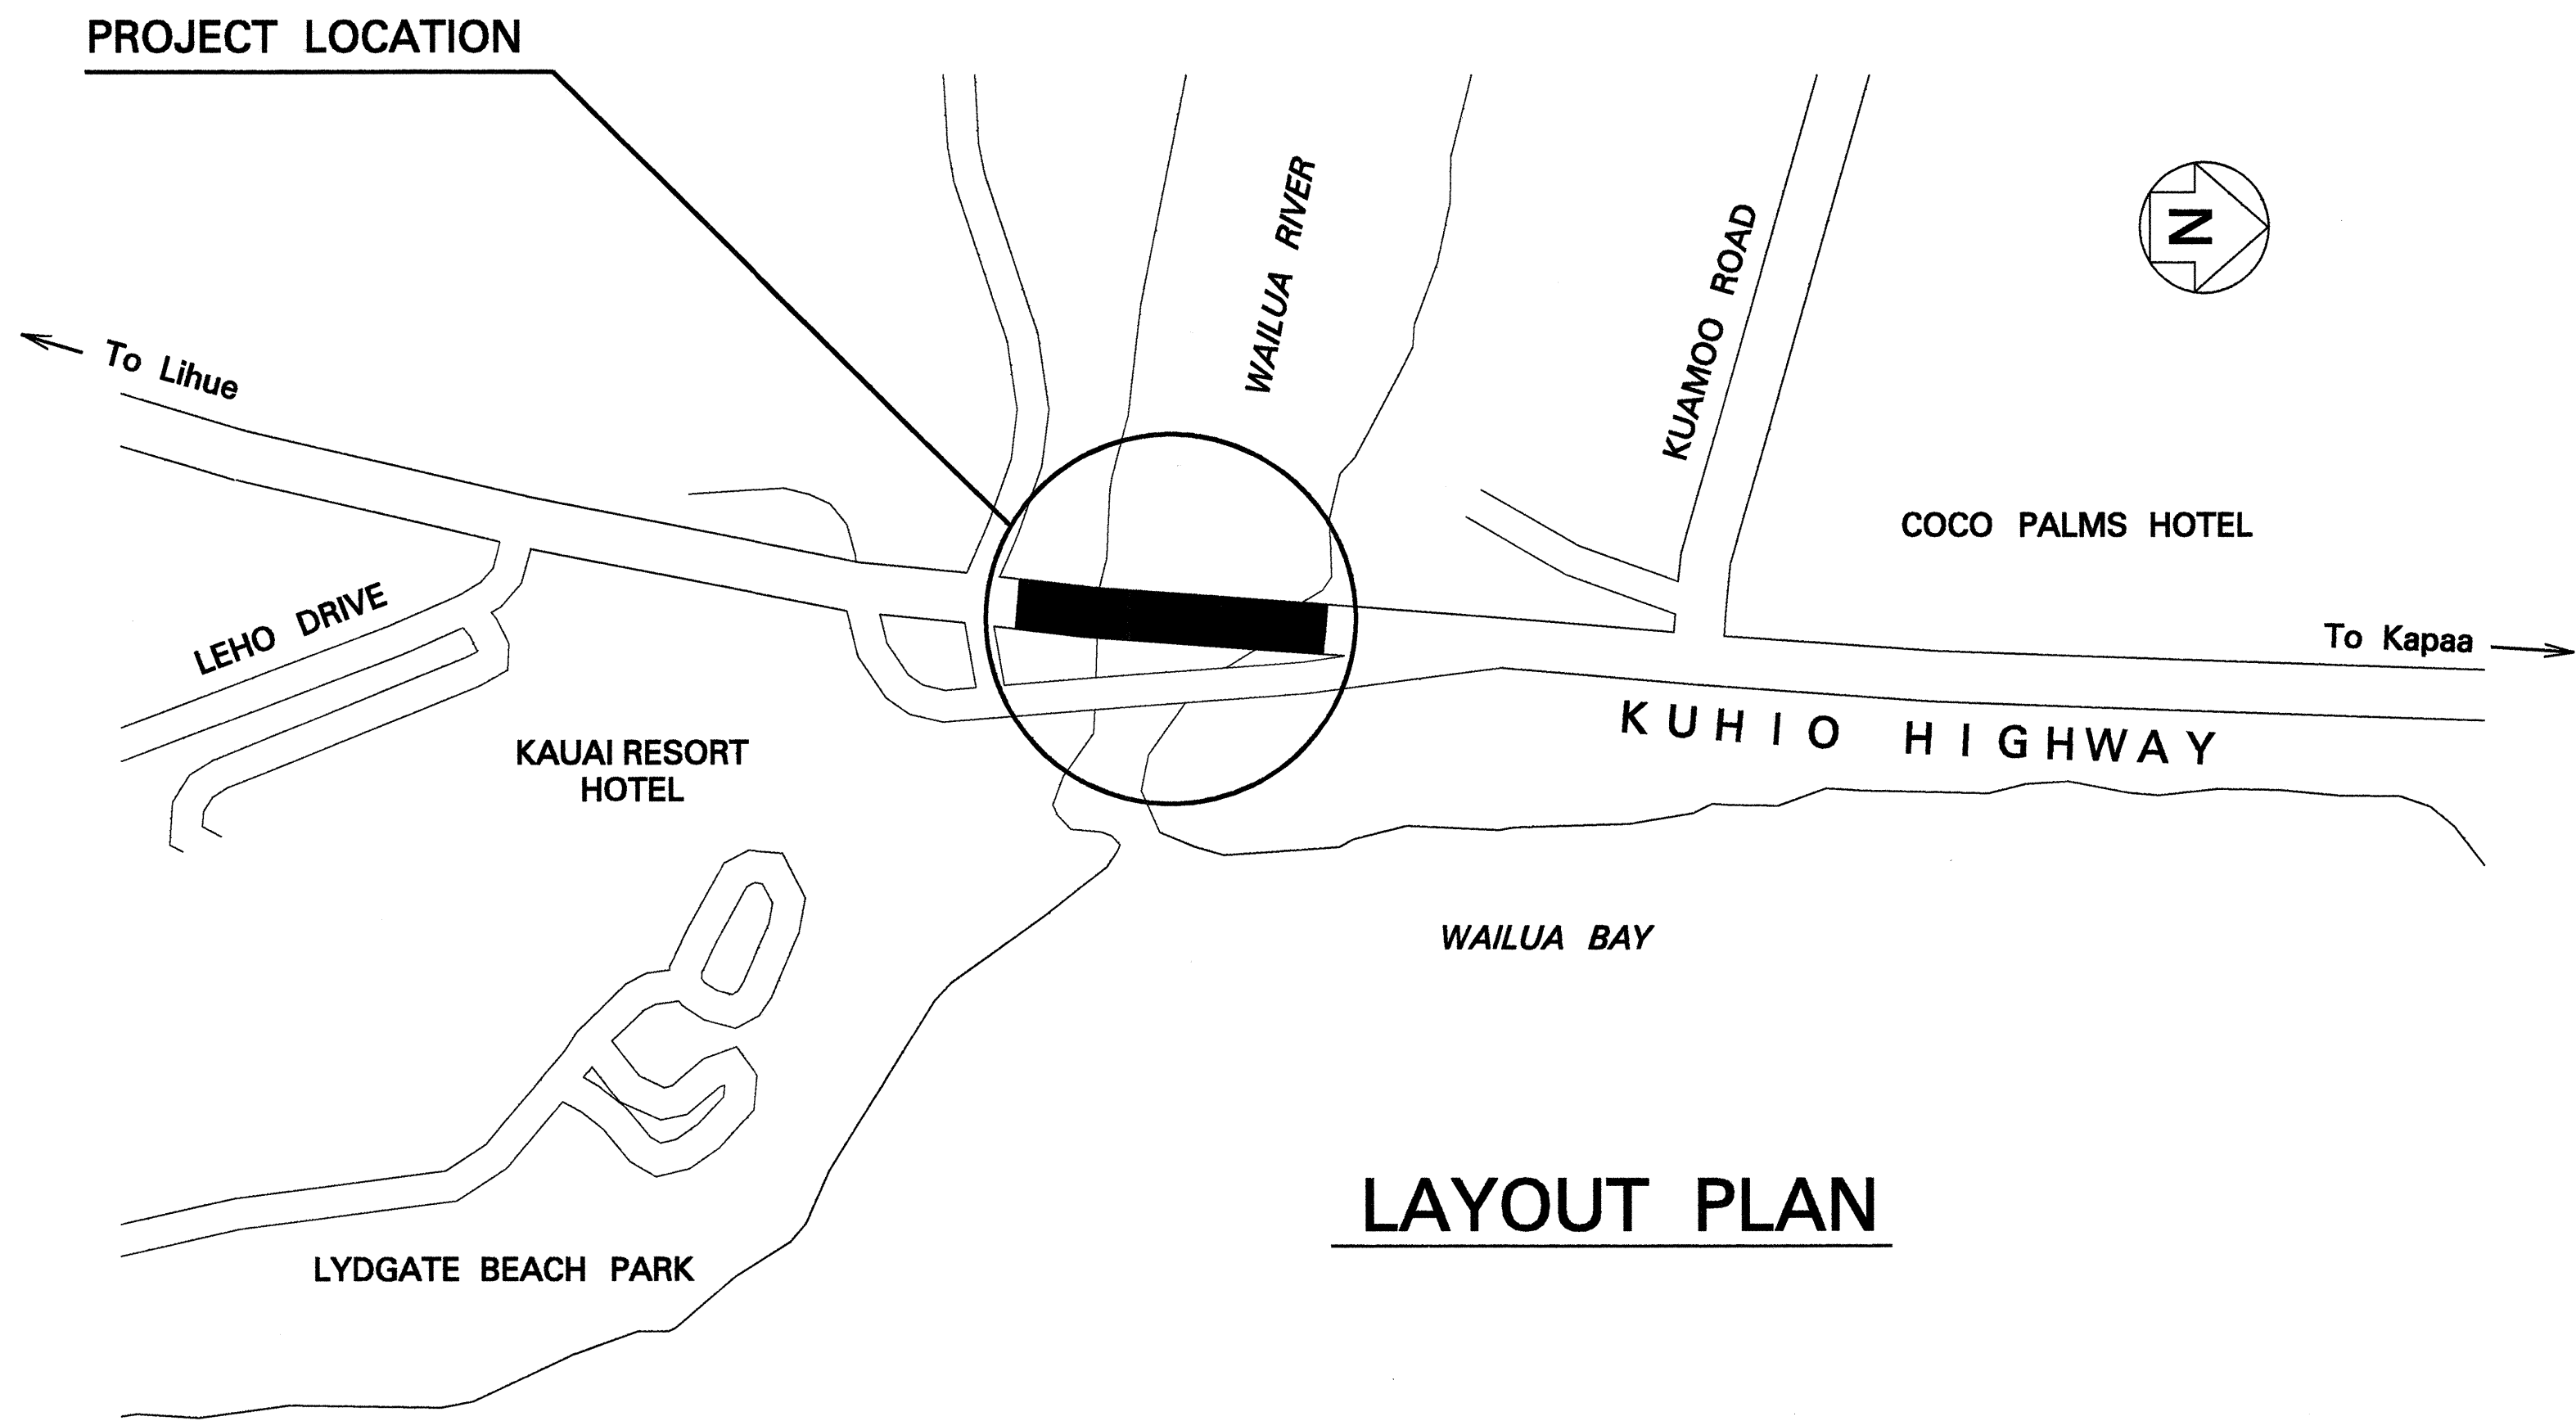
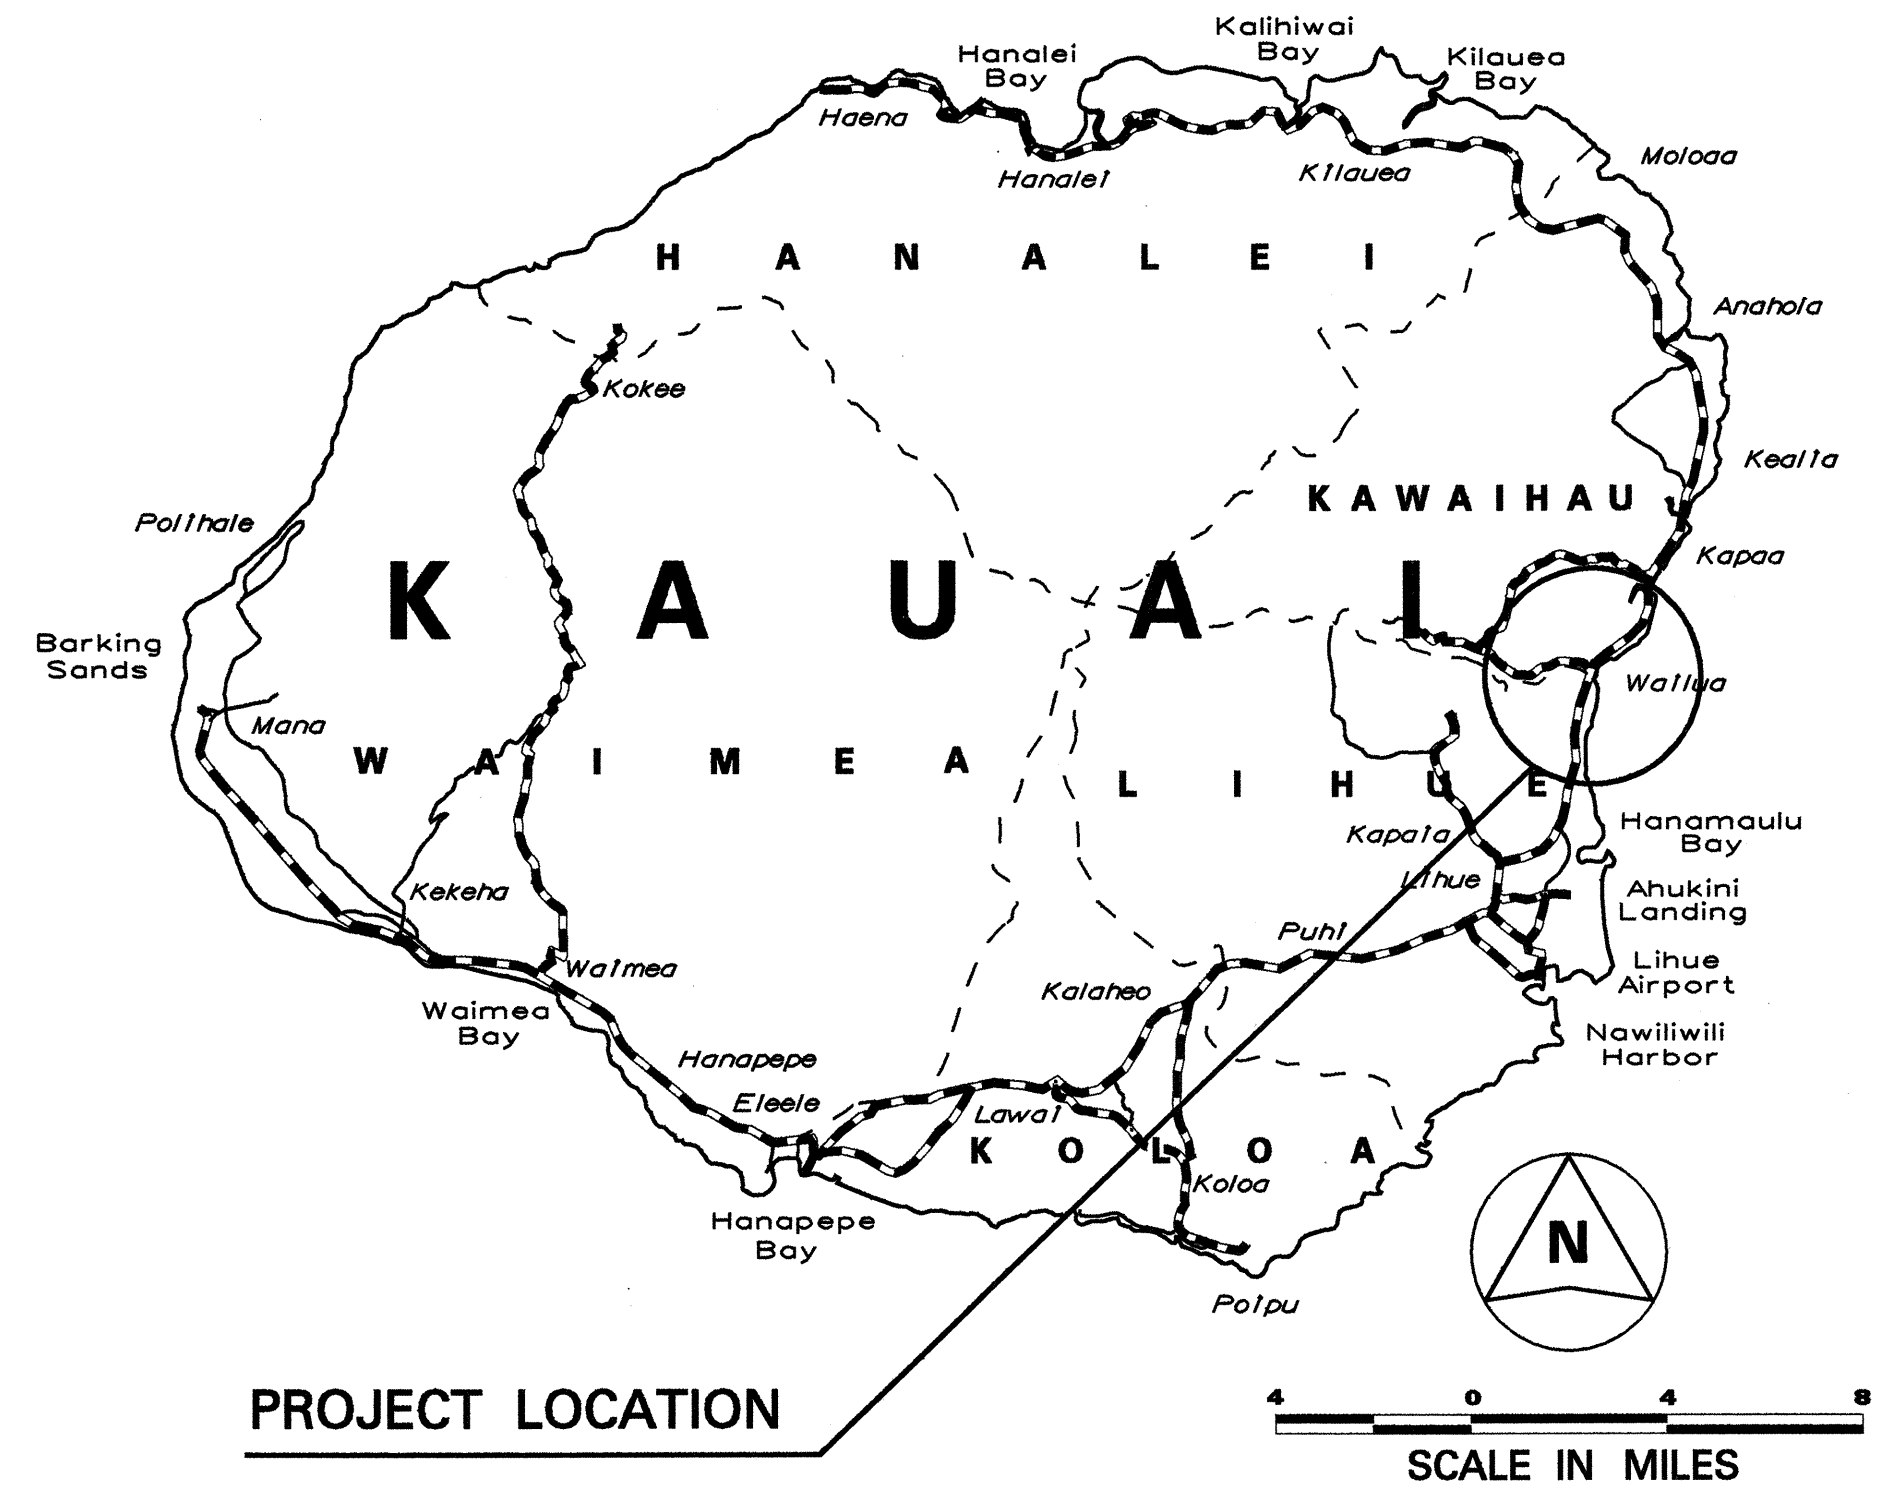
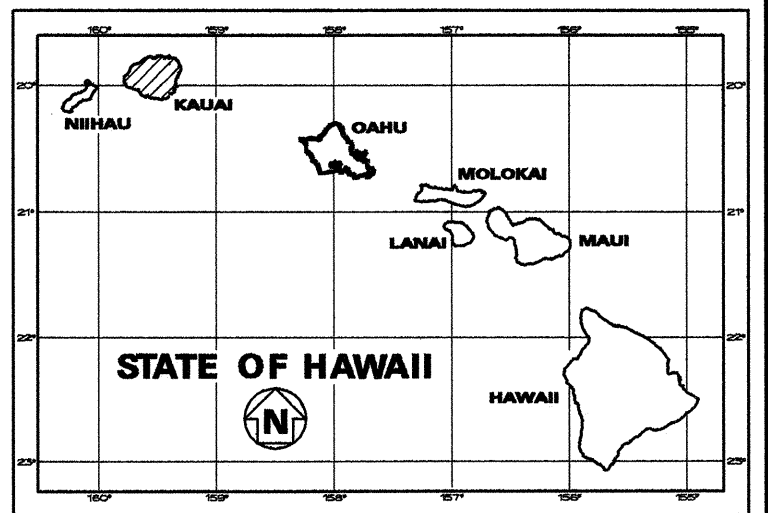


INDEX TO DRAWINGS	
SHEET NO.	DESCRIPTION
1	TITLE SHEET
2	STANDARD PLAN SUMMARY
3	GENERAL NOTES
4	BRIDGE PLAN & SECTION
5	METAL FRAMING PLAN AND SECTIONS
6	STRUCTURE SECTIONS
7	NEW CONCRETE PEDESTAL AND COLUMN DETAILS AT PIER NO.1

STATE OF HAWAII  
DEPARTMENT OF TRANSPORTATION  
HIGHWAYS DIVISION  
HONOLULU, HAWAII  
"AS-BUILT"

PLANS FOR  
KUHIO HIGHWAY  
WAILUA BRIDGE - REINFORCE, CLEAN  
AND PAINT METAL MEMBERS  
PROJECT NO. 56A-02-96M  
DISTRICT OF KAWAIIHAU  
ISLAND OF KAUAI

FED. ROAD DIST. NO.	STATE	PROJ. NO.	FISCAL YEAR	SHEET NO.	TOTAL SHEETS
HAWAII	HAW.	56A-02-96M	1996	1	7

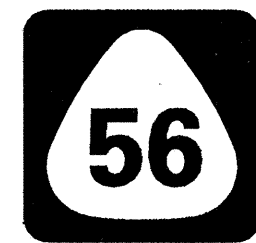

----- FEDERAL AID PROJECTS PREVIOUSLY CONSTRUCTED OR UNDER CONSTRUCTION

MILE POST 5.72

CHANGES MADE DURING CONSTRUCTION HAVE BEEN INCORPORATED ON THESE PLANS EXCEPT CHANGES IN THE ORIGINAL THEORETICAL QUANTITIES. FOR ACTUAL QUANTITIES, REFER TO PROJECT LEDGER AND/OR COMPUTATION BOOK.

For [Signature] 2/06/02  
RESIDENT ENGINEER DATE

DEPARTMENT OF TRANSPORTATION STATE OF HAWAII	
APPROVED: <u>[Signature]</u> DIR. OF TRANSPORTATION	5/20/96 DATE

Jan 95  
DATE  
587-2250  
PHONE  
R. HIRONAKA  
P. S. & E. BY  
HYW-K  
DESIGNED BY