


FED. ROAD DIST. NO.	STATE	FED. AID PROJ. NO.	FISCAL YEAR	SHEET NO.	TOTAL SHEETS
HAWAII	HAW.	STP-056-1(36)	1997	17	22

Sta. 608+00± to # Sta. 611+10± Lt.

Install Reflector Markers (RM-1) w/Steel Post Behind Guardrail @ 100' O.C. (4 Ea.)

Remove and Dispose Exist. Reflector Markers

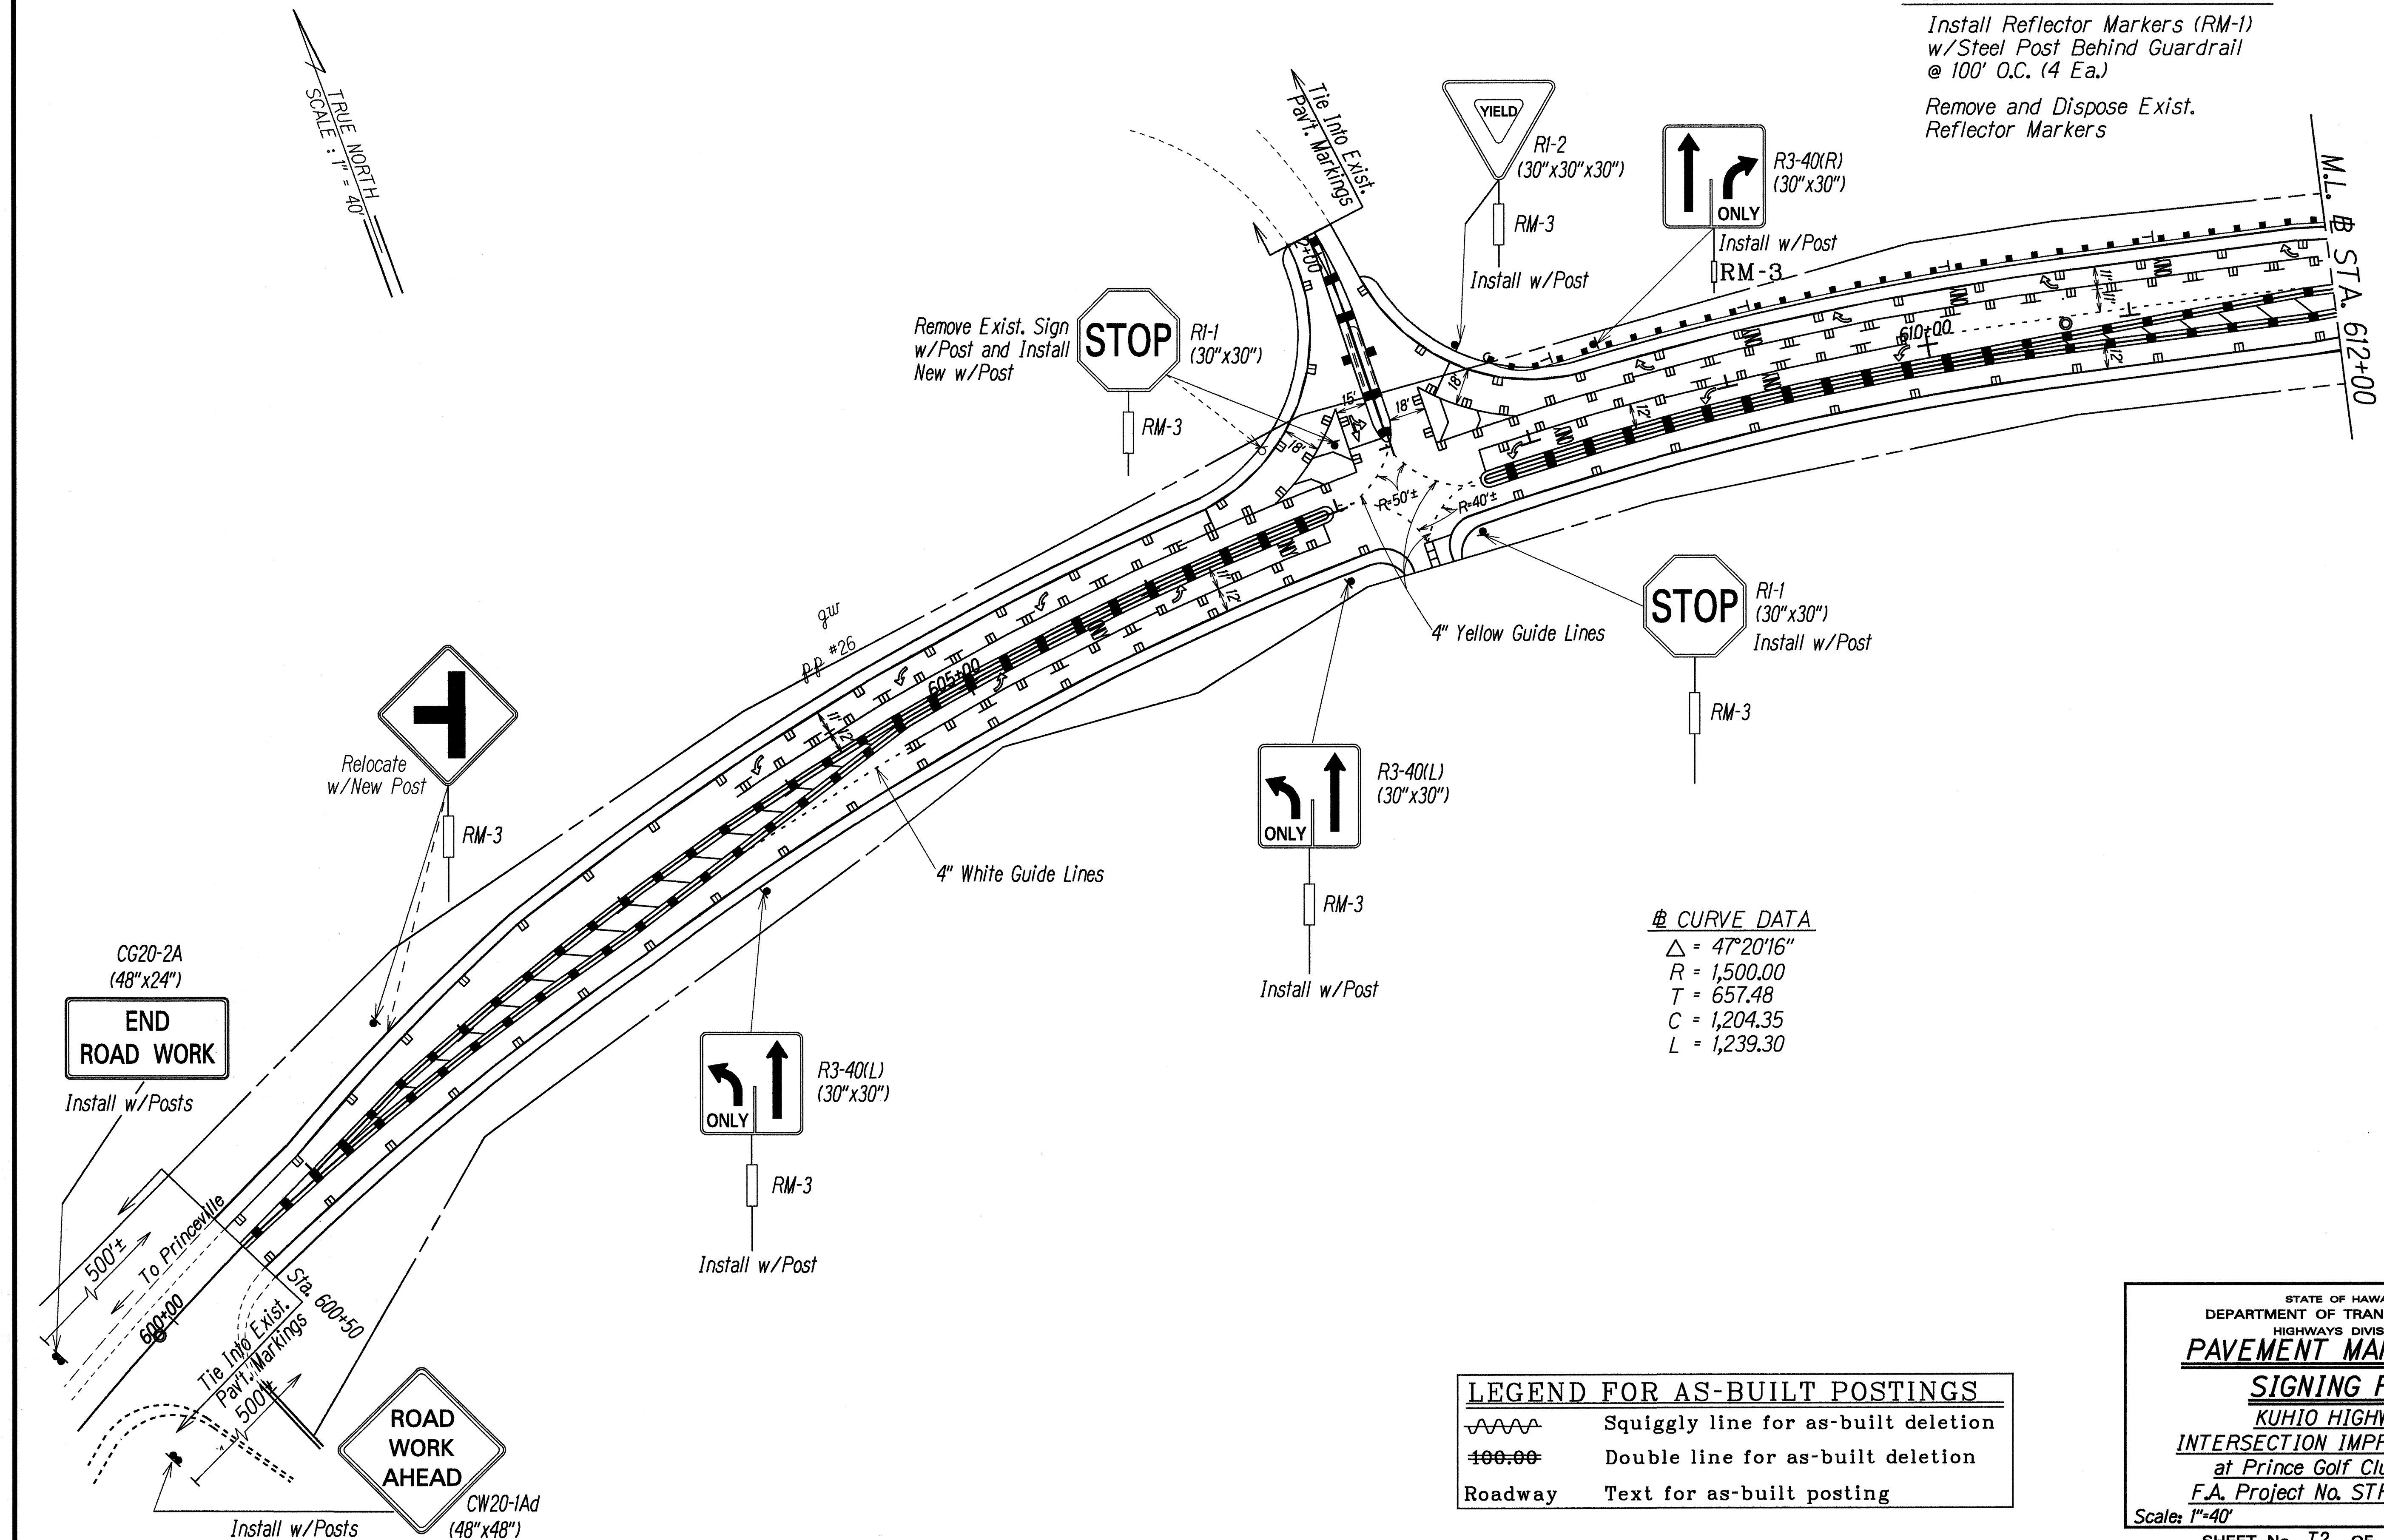

CURVE DATA
 $\Delta = 47^{\circ}20'16''$
 $R = 1,500.00$
 $T = 657.48$
 $C = 1,204.35$
 $L = 1,239.30$

	Squiggly line for as-built deletion
	Double line for as-built deletion
Roadway	Text for as-built posting


STATE OF HAWAII
DEPARTMENT OF TRANSPORTATION
HIGHWAYS DIVISION
PAVEMENT MARKING & SIGNING PLAN
KUHIO HIGHWAY
INTERSECTION IMPROVEMENTS
at Prince Golf Club Road
F.A. Project No. STP-056-1(36)
Scale: 1"=40' Date: Feb., 1997
SHEET No. T2 OF 4 SHEETS

DATE	2/28/96
SURVEY PLOTTED BY	M. Fifer/BJ
DRAWN BY	M. Fifer/BJ
NOTES BOOK	102
DESIGNED BY	G. Egan
CHECKED BY	N. G. G. G.
ORIGINAL PLAN	

FED. ROAD DIST. NO.	STATE	FED. AID PROJ. NO.	FISCAL YEAR	SHEET NO.	TOTAL SHEETS
HAWAII	HAW.	STP-056-1(36)	1997	18	22

STA. 612+20± TO # STA. 613+20± LT.
 Install Reflector Markers (RM-1)
 w/Steel Post Behind Guardrail
 @ 100' O.C. (2 Ea.)

TRUE NORTH
 SCALE: 1" = 40'

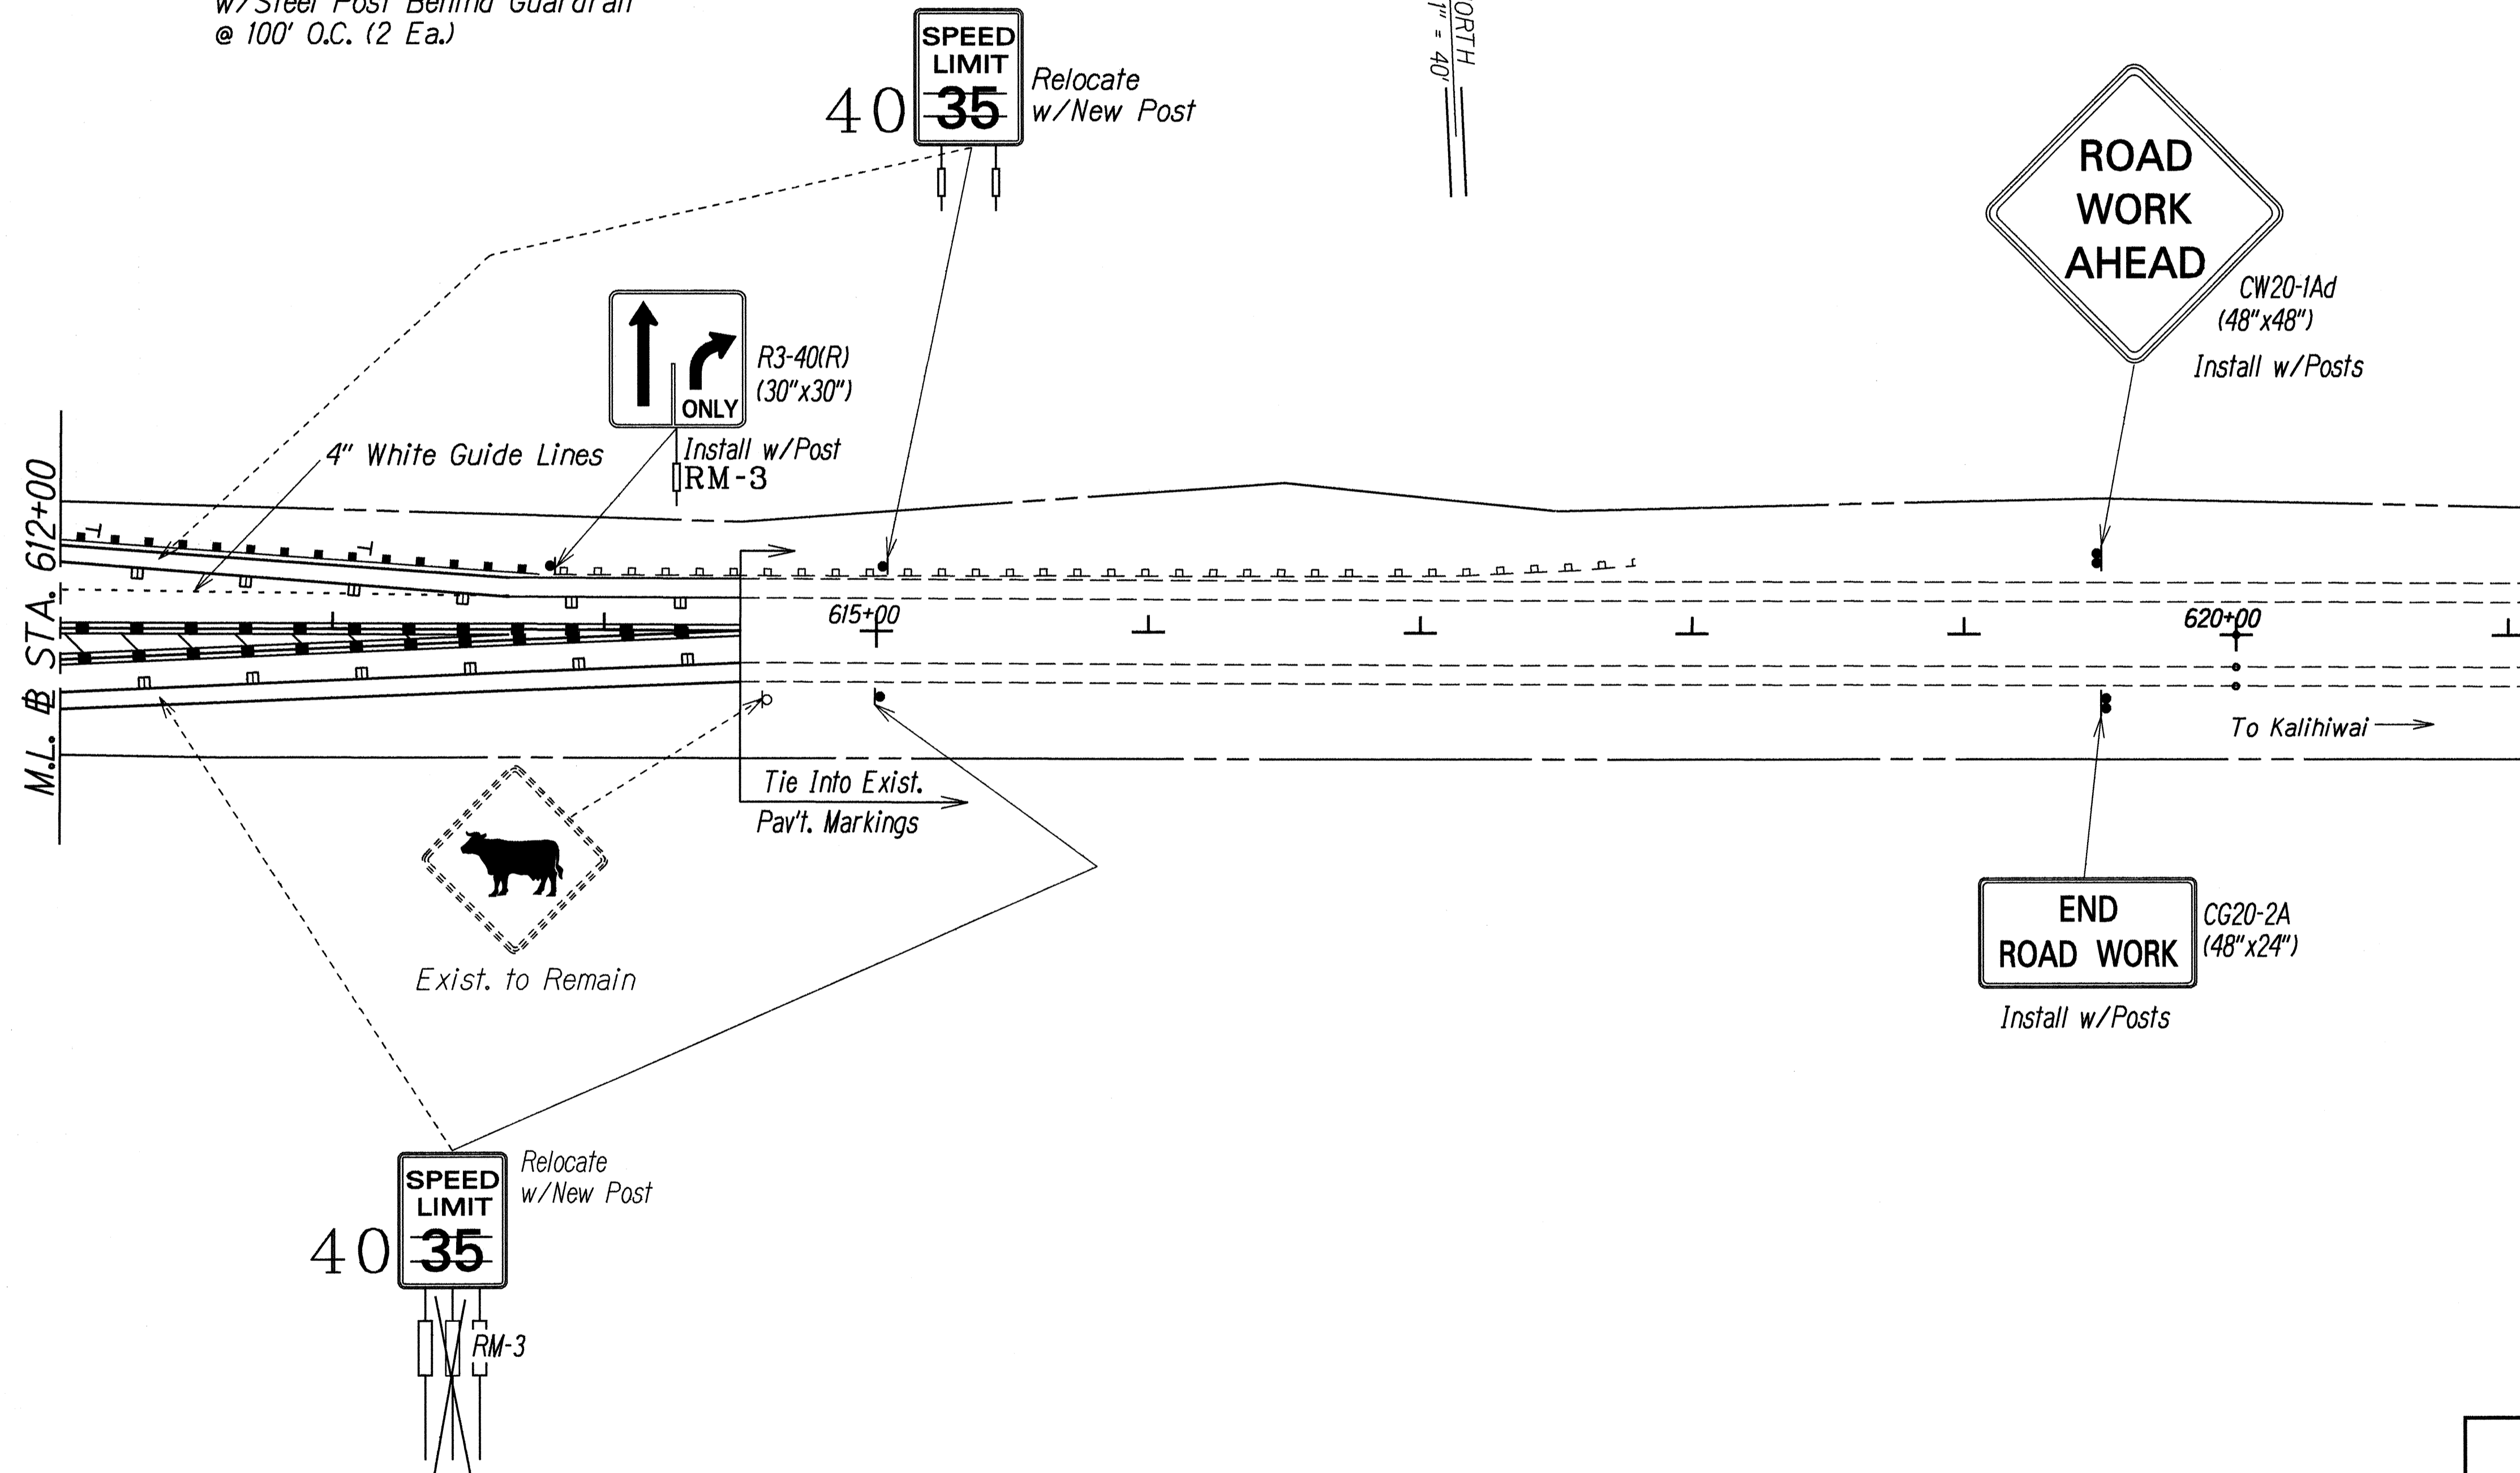

ORIGINAL PLAN	SURVEY PLOTTED BY	DATE
NOTES BOOK	DRAWN BY	2-23-97
DESIGNED BY		
CHECKED BY		

LEGEND FOR AS-BUILT POSTINGS	
	Squiggly line for as-built deletion
	Double line for as-built deletion
Roadway	Text for as-built posting

STATE OF HAWAII
 DEPARTMENT OF TRANSPORTATION
 HIGHWAYS DIVISION
PAVEMENT MARKING &
SIGNING PLAN
 KUHIO HIGHWAY
 INTERSECTION IMPROVEMENTS
 at Prince Golf Club Road
 F.A. Project No. STP-056-1(36)
 Scale: 1"=40' Date: Feb., 1997
 SHEET No. T3 OF 4 SHEETS