	INDEX TO DRAWINGS			
SHEET NO.	DESCRIPTION			
1	TITLE SHEET			
2	STANDARD PLANS SUMMARY			
3	GENERAL NOTES			
4	DETAILS			
5 – 8	STRUCTURE REPAIR			
9	TYPICAL SECTION			
10	SPALL REPAIR SUMMARY			

STATE OF HAWAII


DEPARTMENT OF TRANSPORTATION

HIGHWAYS DIVISION
HONOLULU, HAWAII
"AS-BUILT"
PLANS FOR

KUHIO HIGHWAY


REPAIR SPALLS ON WAILUA (PLANTATION) BRIDGE, PHASE II
PROJECT NO. 56A-01-97M


DISTRICT OF KAWAIHAU
ISLAND OF KAUAI

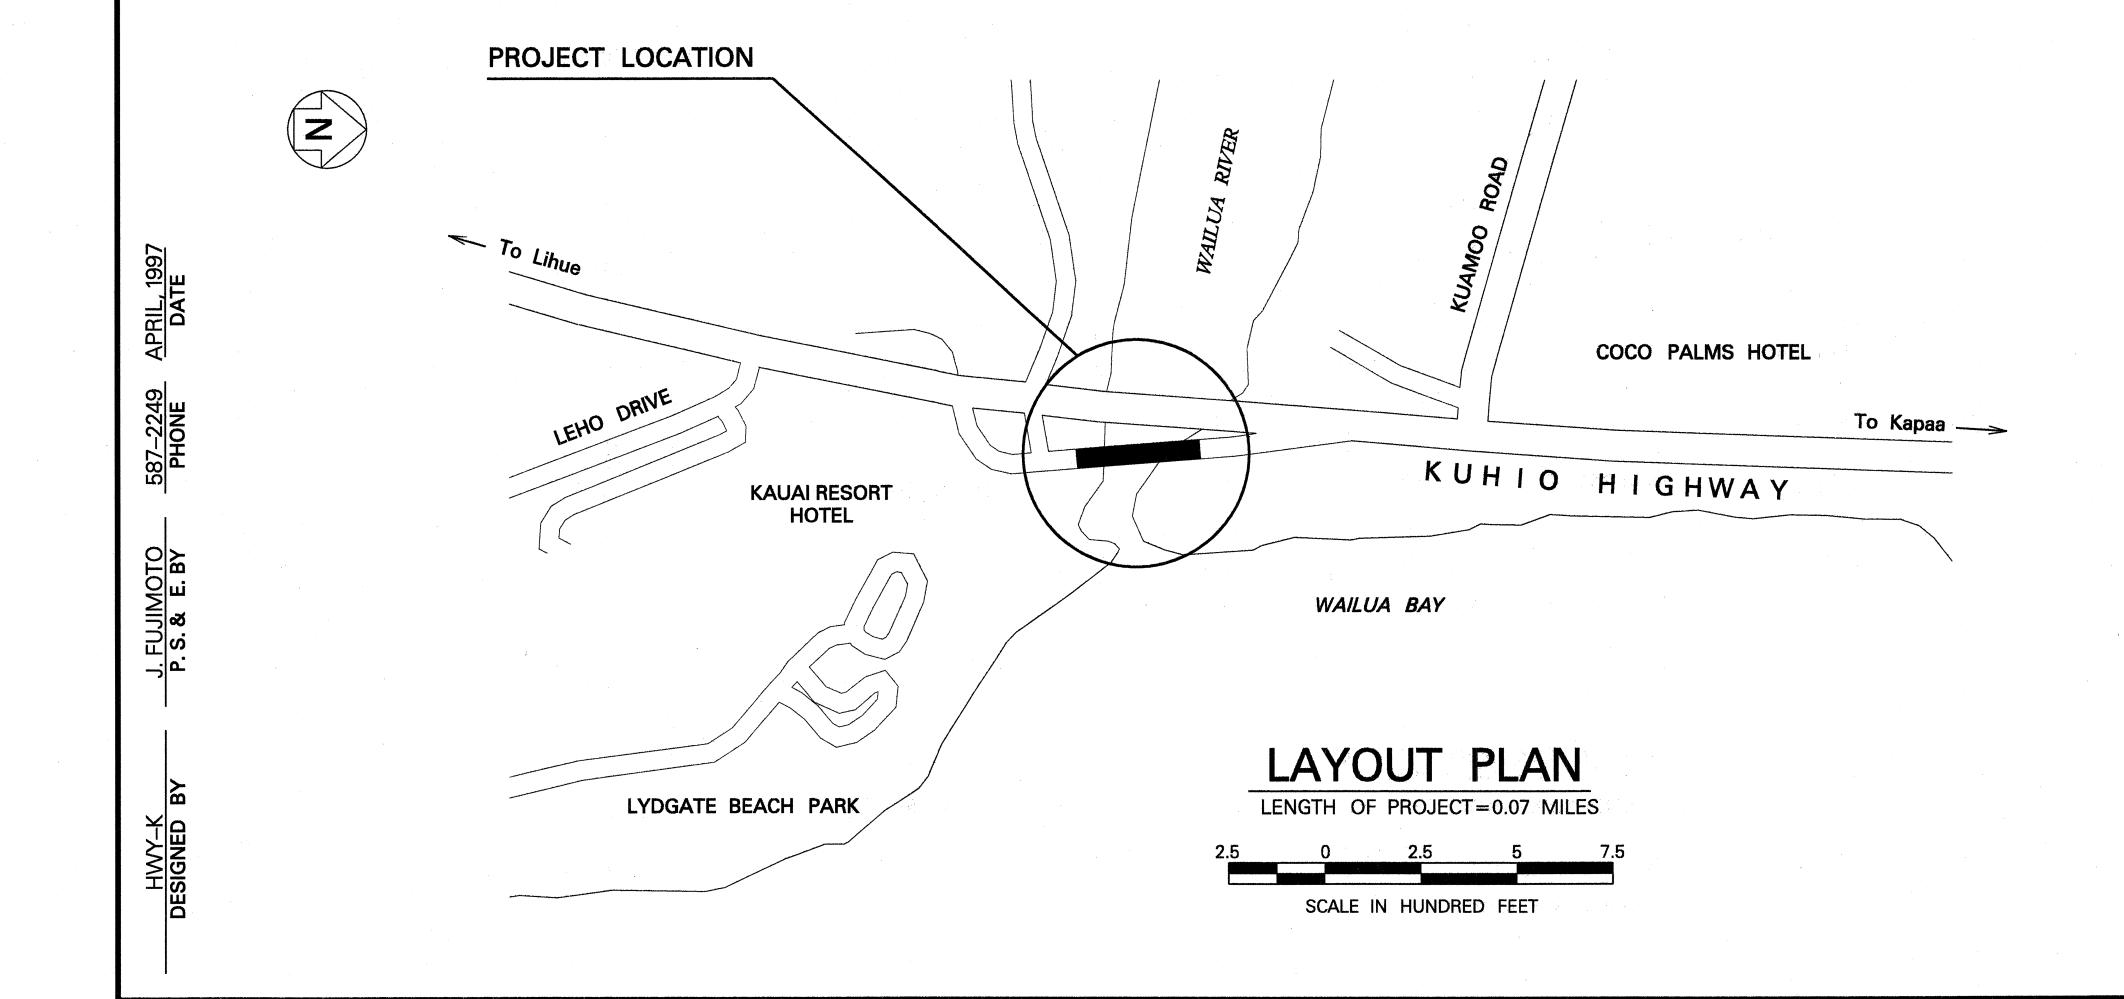

FED. ROAD DIST. NO.	STATE	PROJ. NO.	FISCAL YEAR	SHEET NO.	TOTAL SHEETS
HAWAII	HAW.	56A-01-97M	1997	1	10



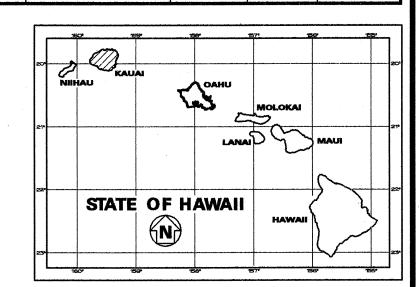

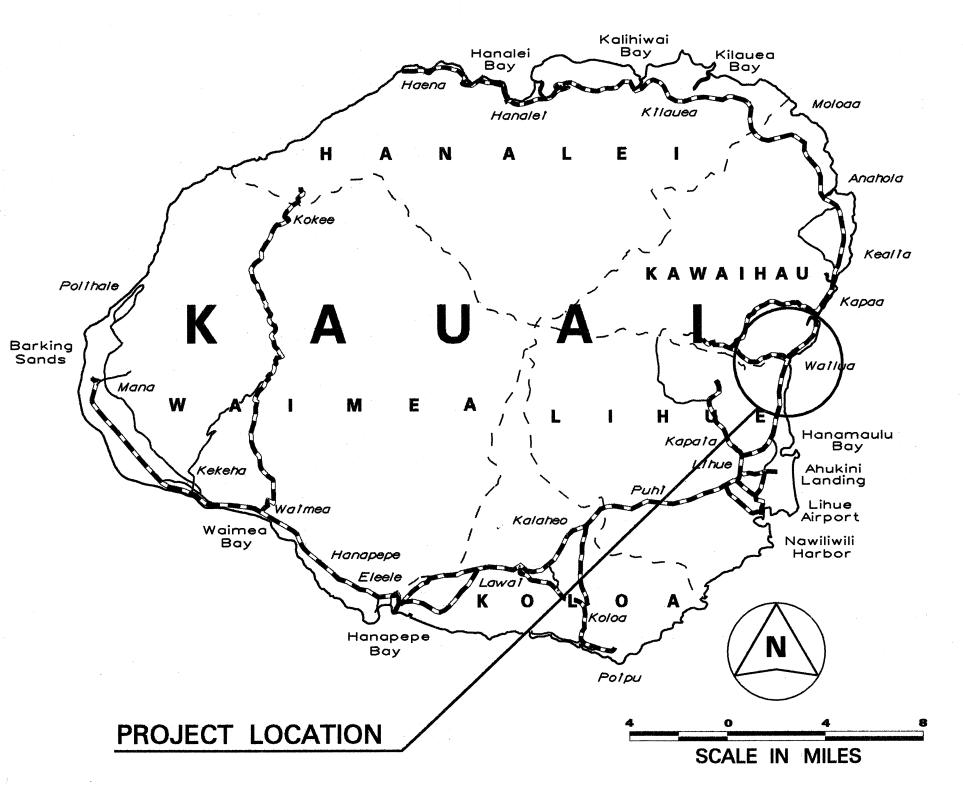

FEDERAL AID PROJECTS PREVIOUSLY CONSTRUCTED OR UNDER CONSTRUCTION

MILE POST 5.83 TO MILE POST 5.90

NO SIGNIFICANT CHANGES WERE MADE DURING CONSTRUCTION ON THESE PLANS EXCEPT CHANGES IN THE ORIGINAL THEORETICAL QUANTITIES. FOR ACTUAL QUANTITIES, REFER TO PROJECT LEDGER AND/OR COMPUTATION BOOK.

Leonard Cutenio RESIDENT ENGINEER

2/17/98 DATE

DEPARTMENT OF TRANSPORTATION STATE OF HAWAII

APPROVED:

Lam bayanlik 4/29/97

DIR. OF TRANSPORTATION

•

DATE