


INDEX TO DRAWINGS	
SHEET NO.	DESCRIPTION
1	TITLE SHEET
2	STANDARD PLANS SUMMARY
3	GENERAL NOTES & LEGEND
4	TYPICAL SECTIONS
5 - 11	ROADWAY PLAN
12	PAVEMENT MARKING LEGEND, DETAILS & NOTES

FED. ROAD DIST. NO.	STATE	FEDERAL-AID PROJ. NO.	FISCAL YEAR	SHEET NO.	TOTAL SHEETS
HAWAII	HAW.	STP-056-1(40)	1997	1	12

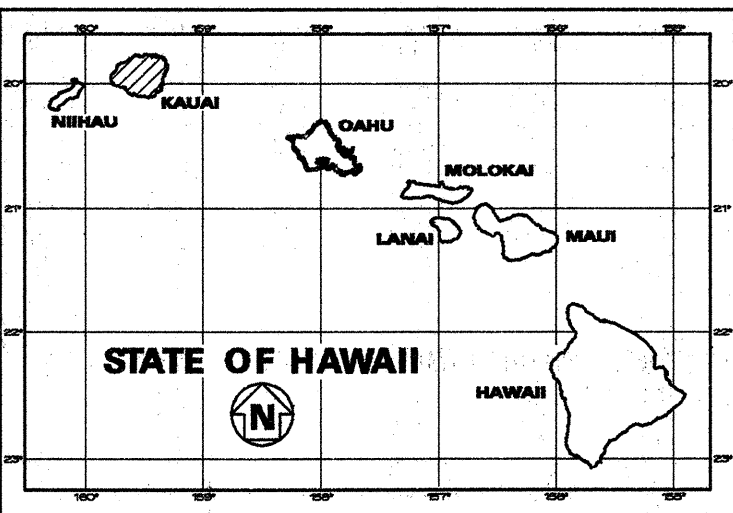

STATE OF HAWAII

DEPARTMENT OF TRANSPORTATION

HIGHWAYS DIVISION

HONOLULU, HAWAII

"AS-BUILT"

PLANS FOR

KUHIO HIGHWAY

SHOULDER IMPROVEMENTS FOR BICYCLE ROUTE,

LIHUE TO KAPAA

FEDERAL-AID PROJECT NO. STP-056-1(40)


DISTRICT OF LIHUE

ISLAND OF KAUAI

CHANGES MADE DURING CONSTRUCTION HAVE BEEN INCORPORATED ON THESE PLANS EXCEPT CHANGES IN THE ORIGINAL THEORETICAL QUANTITIES. FOR ACTUAL QUANTITIES, REFER TO PROJECT LEDGER AND/OR COMPUTATION BOOK.

Resub. Antonio
RESIDENT ENGINEER

4/26/99
DATE

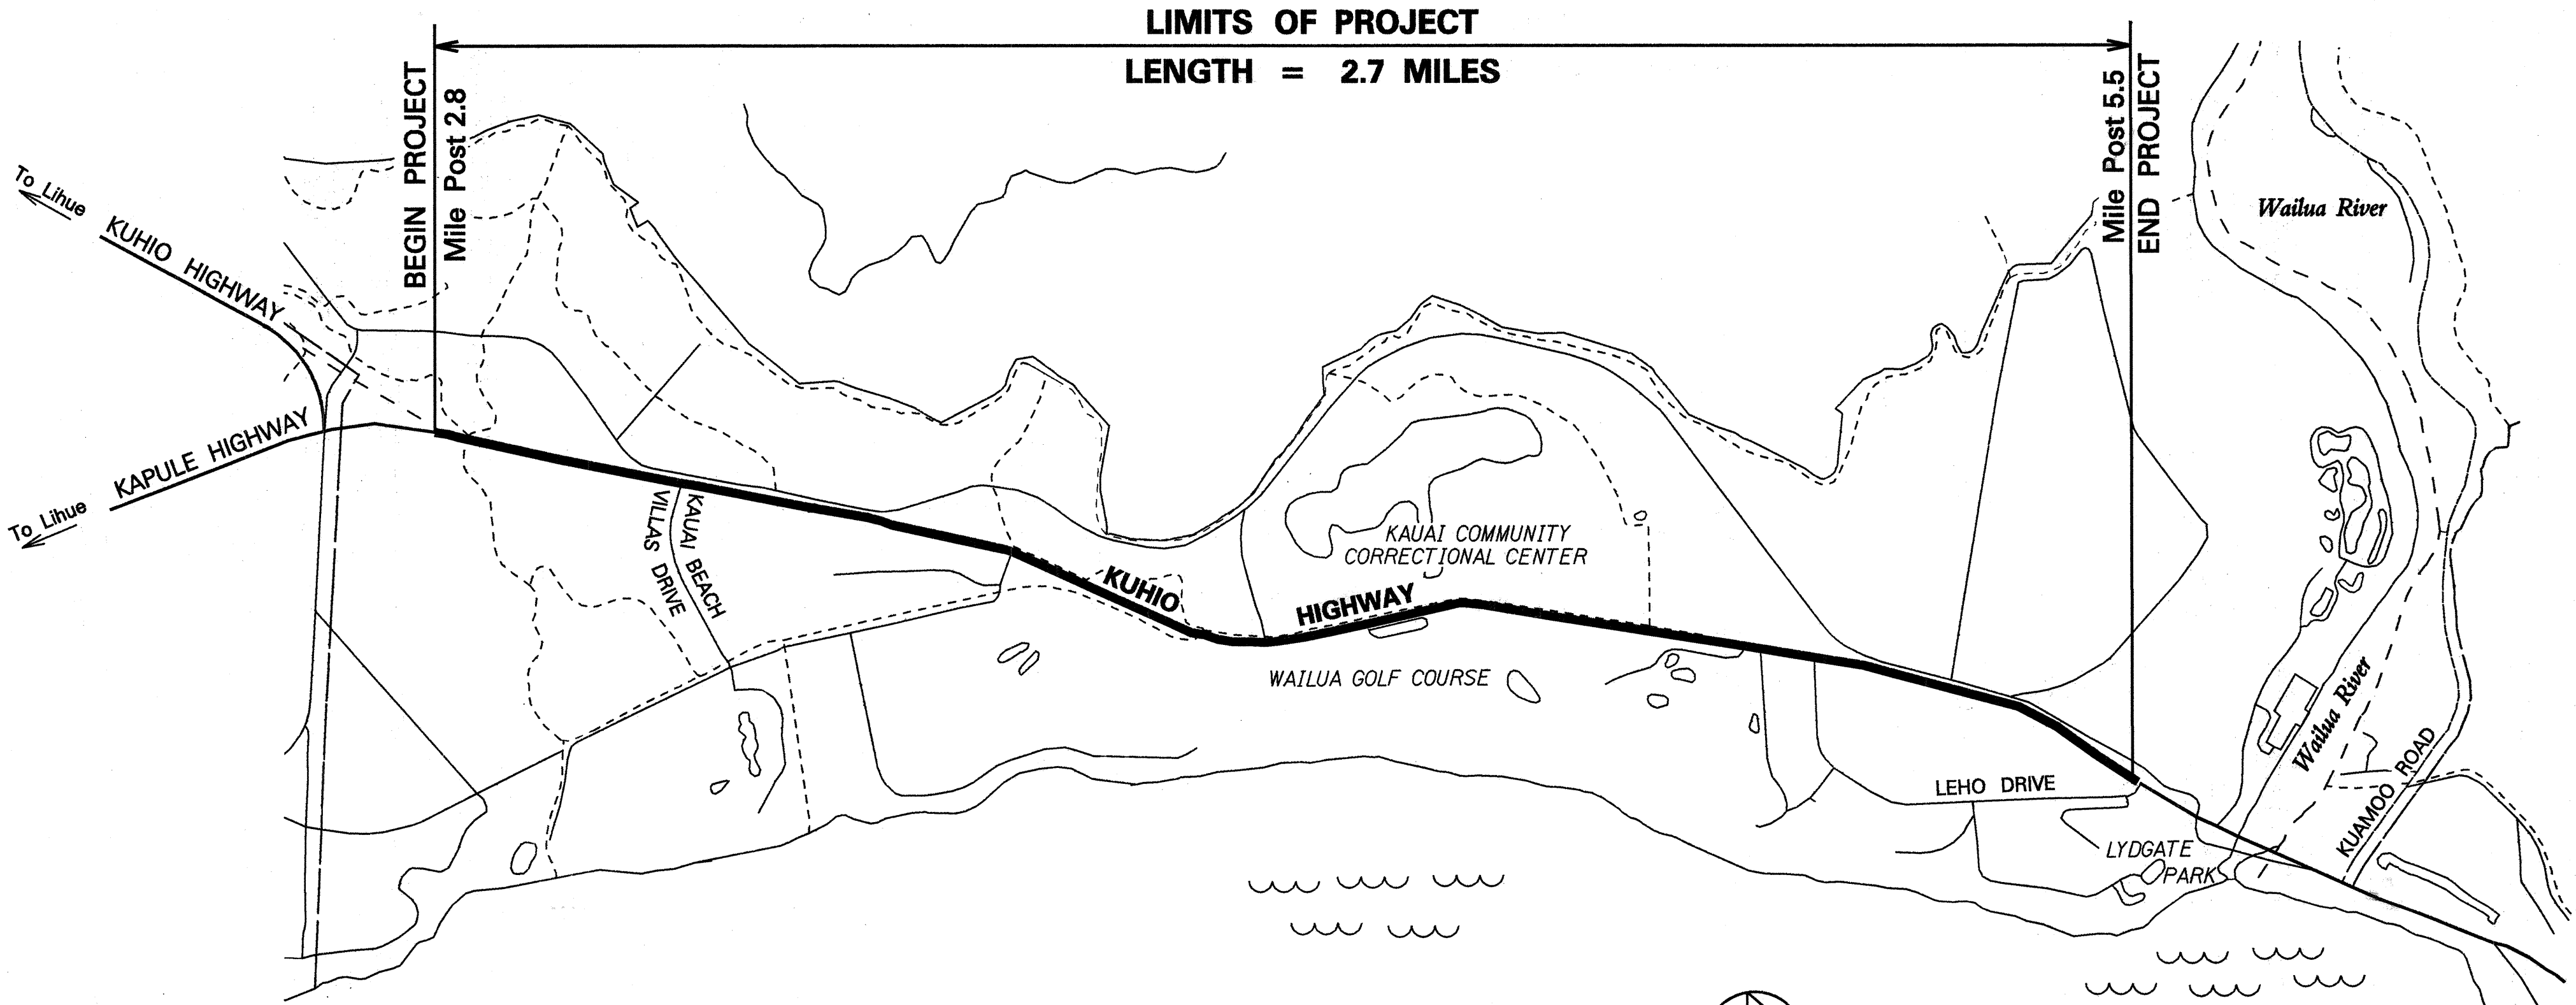

FEDERAL AID PROJECTS PREVIOUSLY CONSTRUCTED OR UNDER CONSTRUCTION

MILE POST 2.8 TO MILE POST 5.5

DESIGN DESIGNATION

ADT (1997)	27,860
ADT (2017)	36,530
DHV	2,920
D	60/40
T	3.0%
V	50 M.P.H.

DEPARTMENT OF TRANSPORTATION STATE OF HAWAII	
APPROVED:	
<i>Glen M. Okamoto</i>	5-16-97
DIR. OF TRANSPORTATION	DATE

DESIGNED BY
HWY-K
JULIUS B. FRONDA
P. S. & E. BY
587-2246
PHONE
APRIL, 1997
DATE

LAYOUT PLAN

GROSS LENGTH OF PROJECT.....2.7 MILES
NET LENGTH OF PROJECT.....2.7 MILES

