



FED. ROAD DIST. NO.	STATE	FEDERAL-AID PROJ. NO.	FISCAL YEAR	SHEET NO.	TOTAL SHEETS
HAWAII	HAW.	STP-056-1(40)	1997	4	12

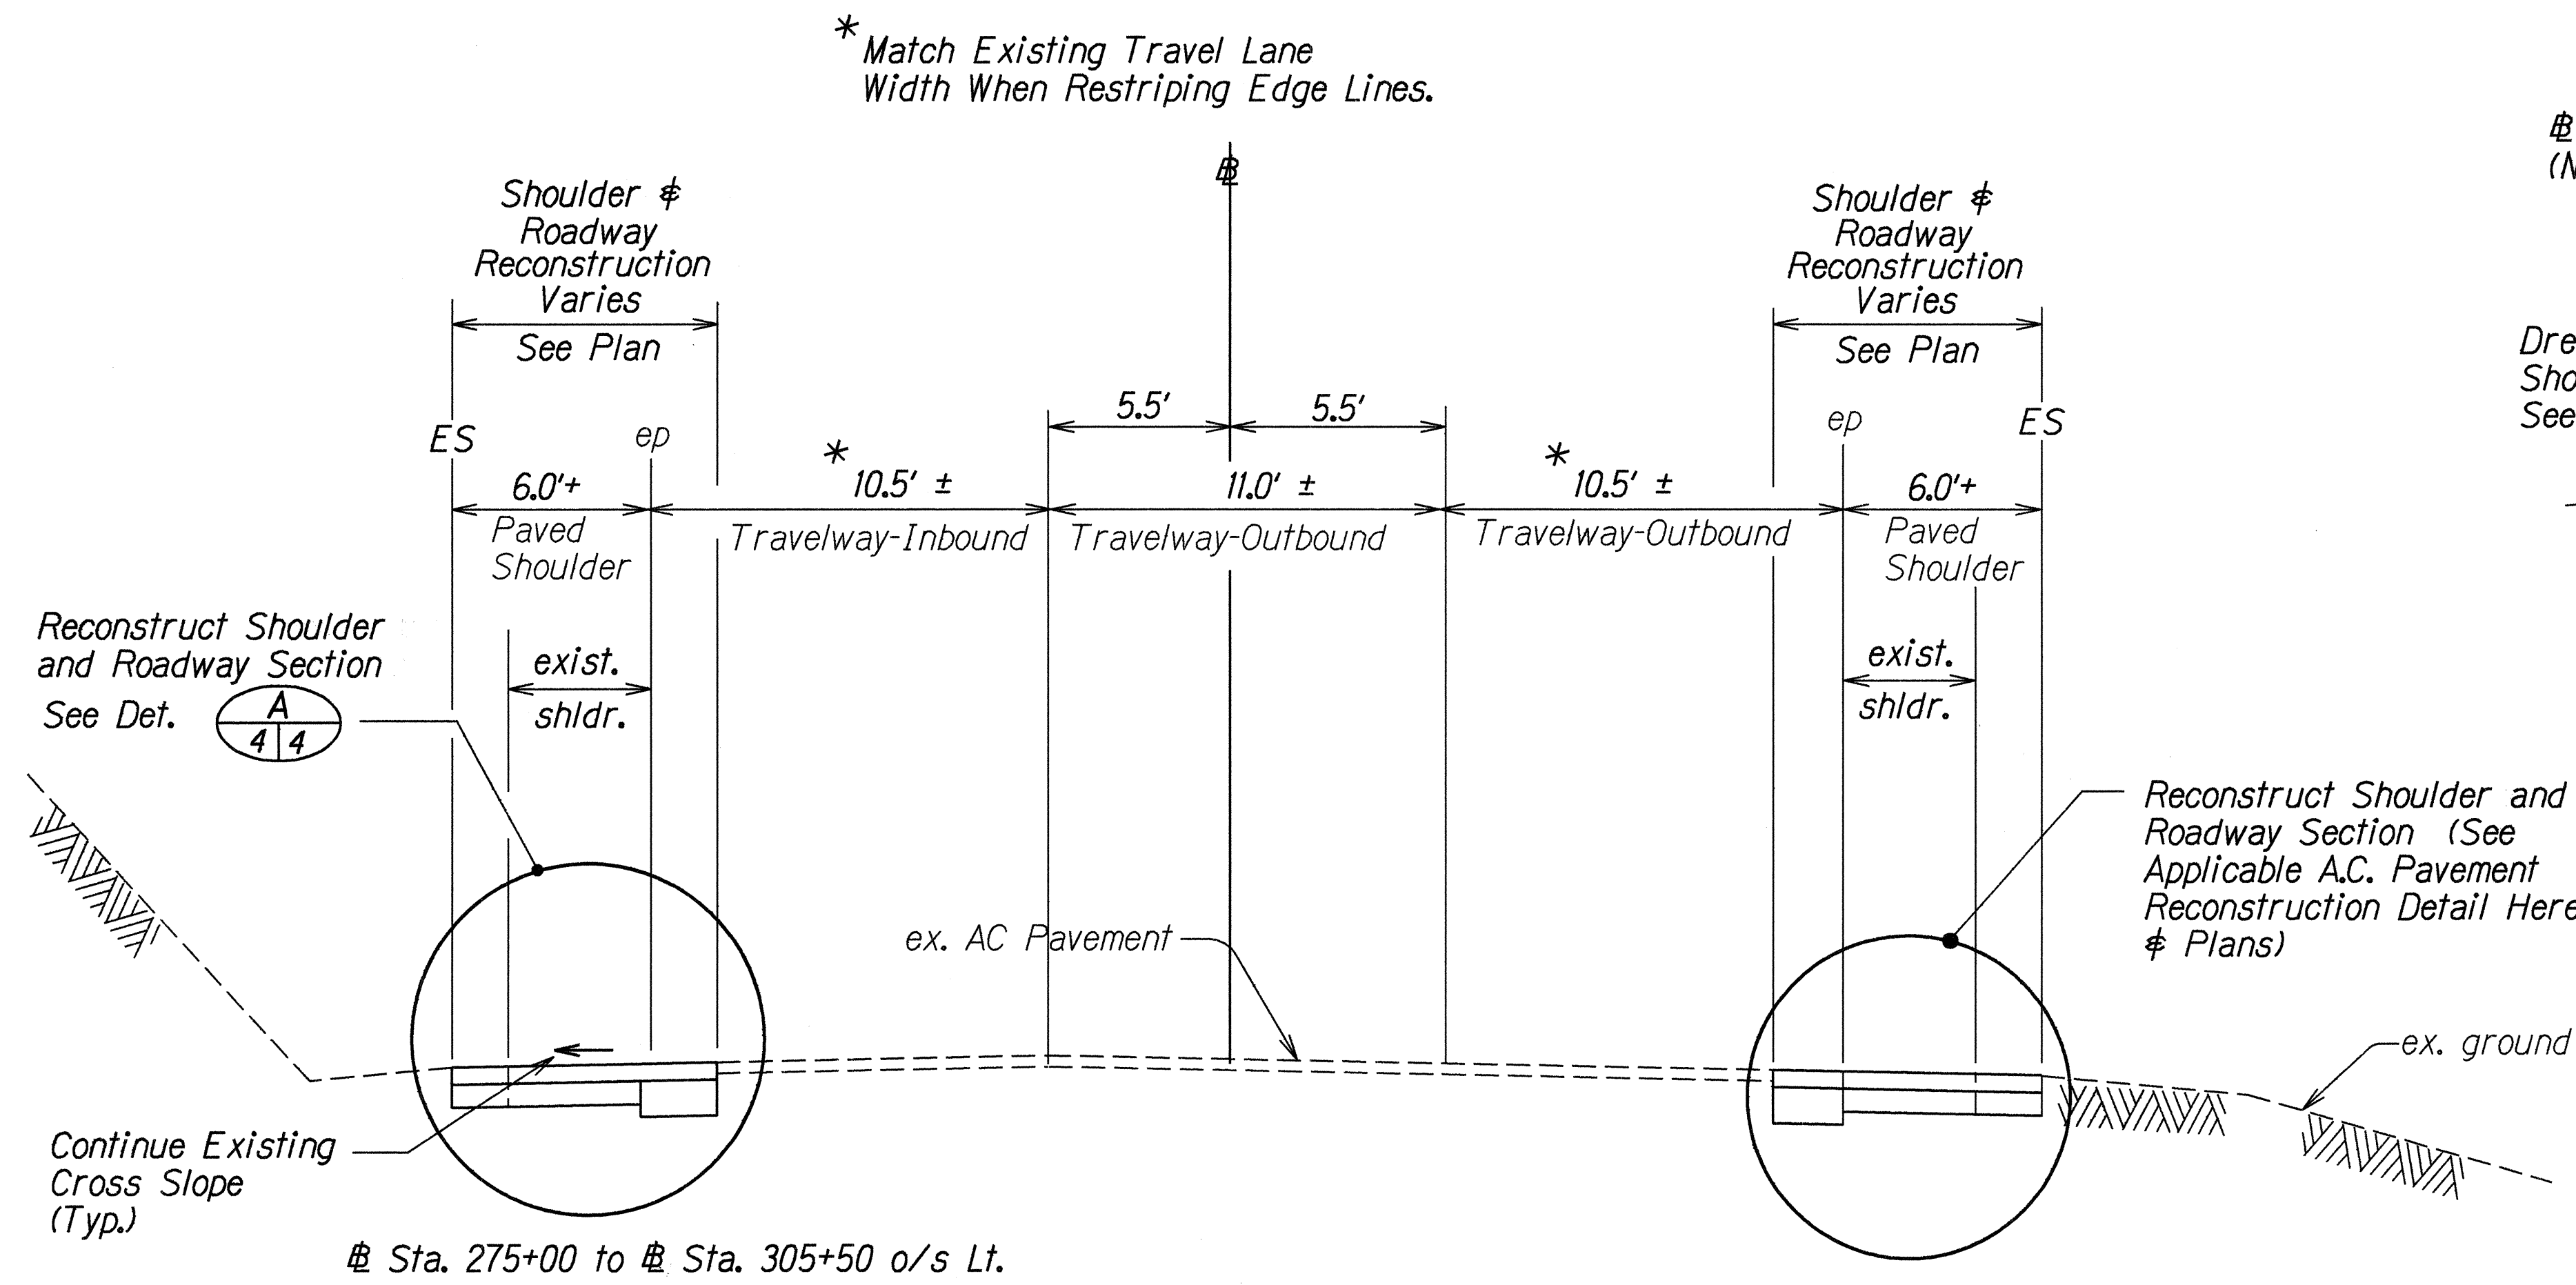


TYPICAL SECTION
SHOULDER & ROADWAY RECONSTRUCTION
 Scale: 1/4" = 1'-0"

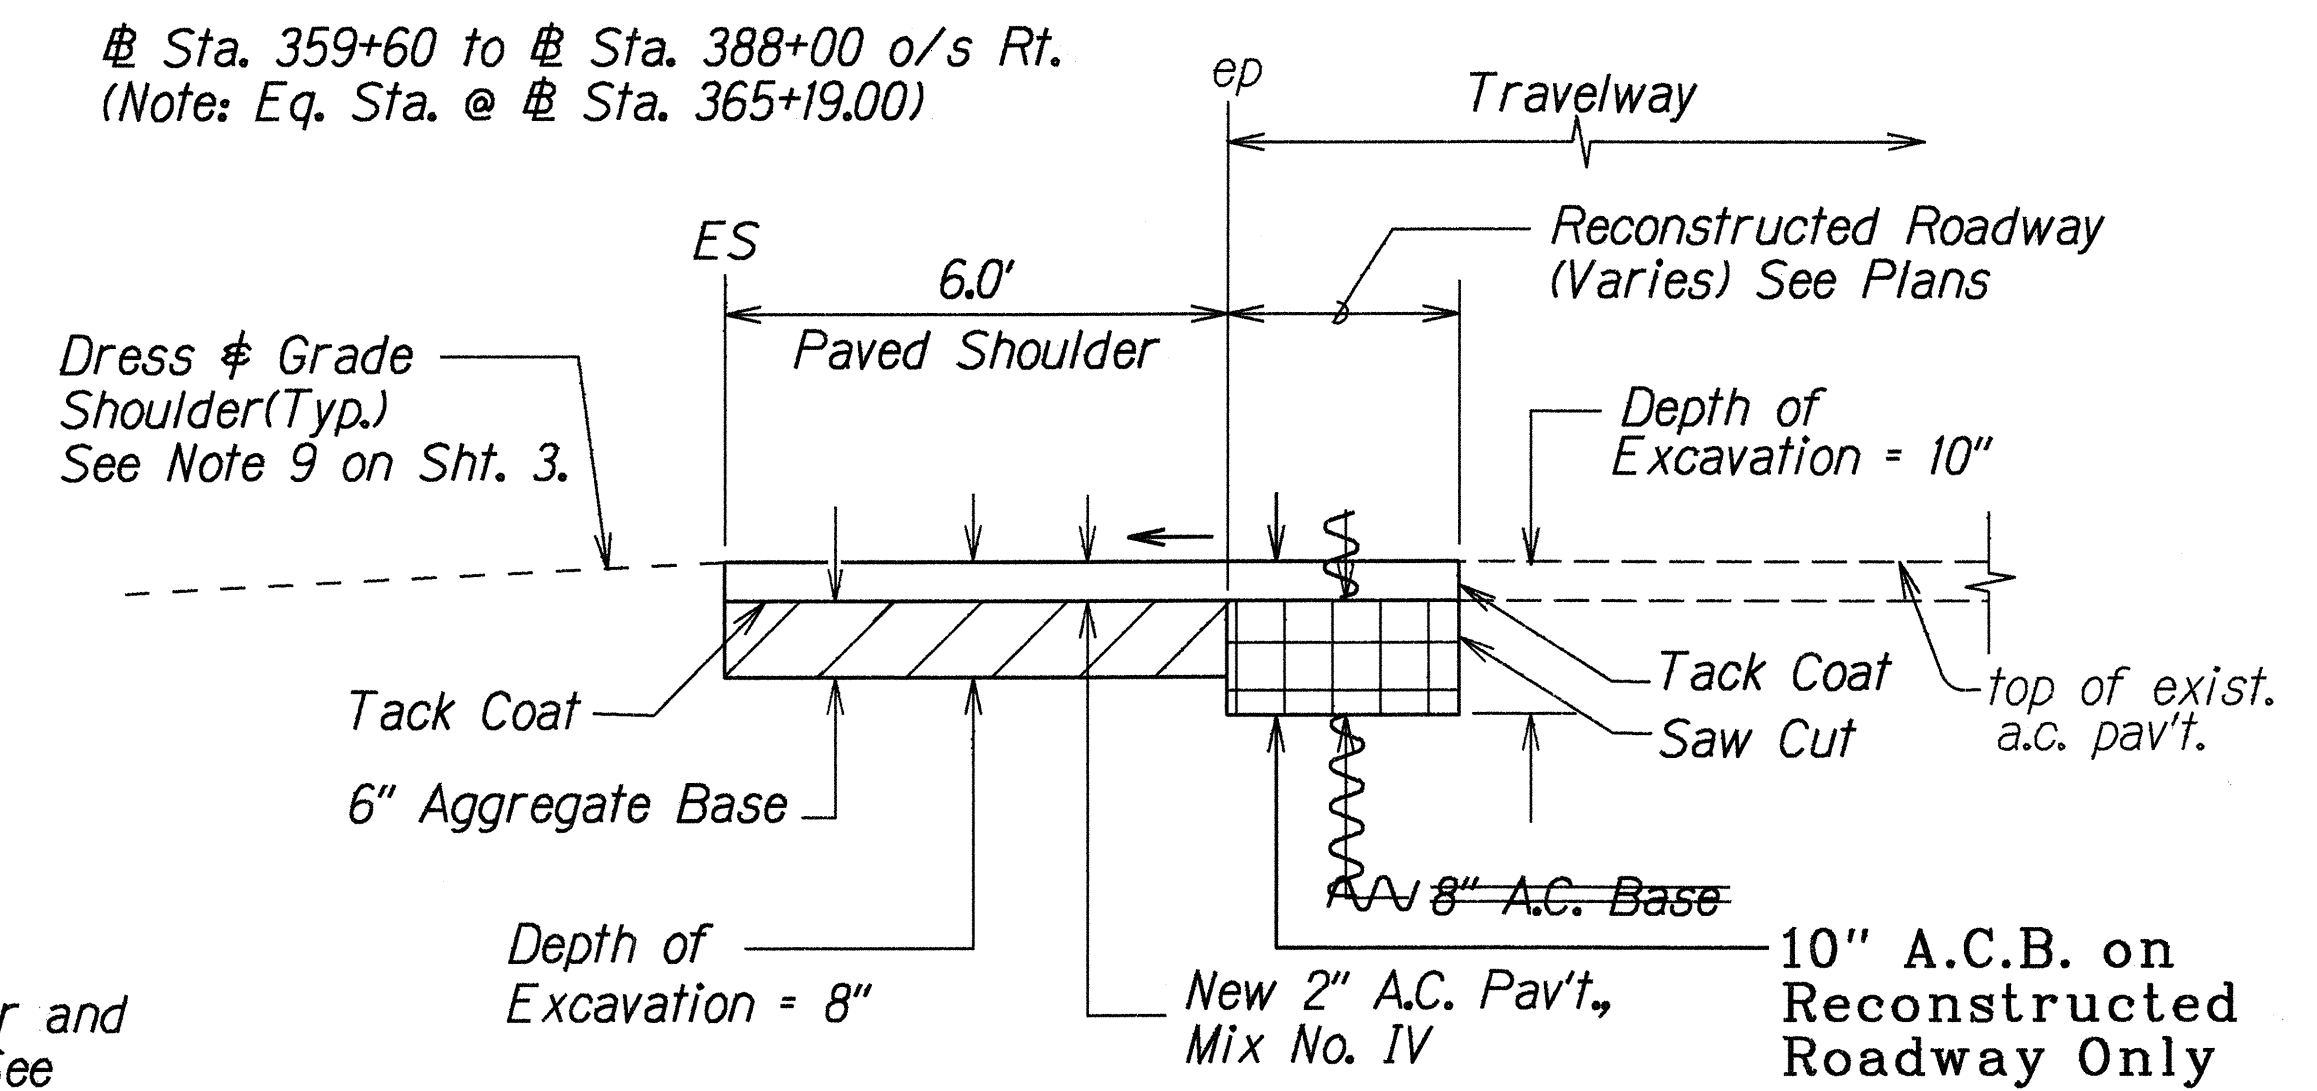


LEGEND FOR AS-BUILT POSTINGS



	Squiggly line for as-built deletion
	Double line for as-built deletion
	Text for as-built posting

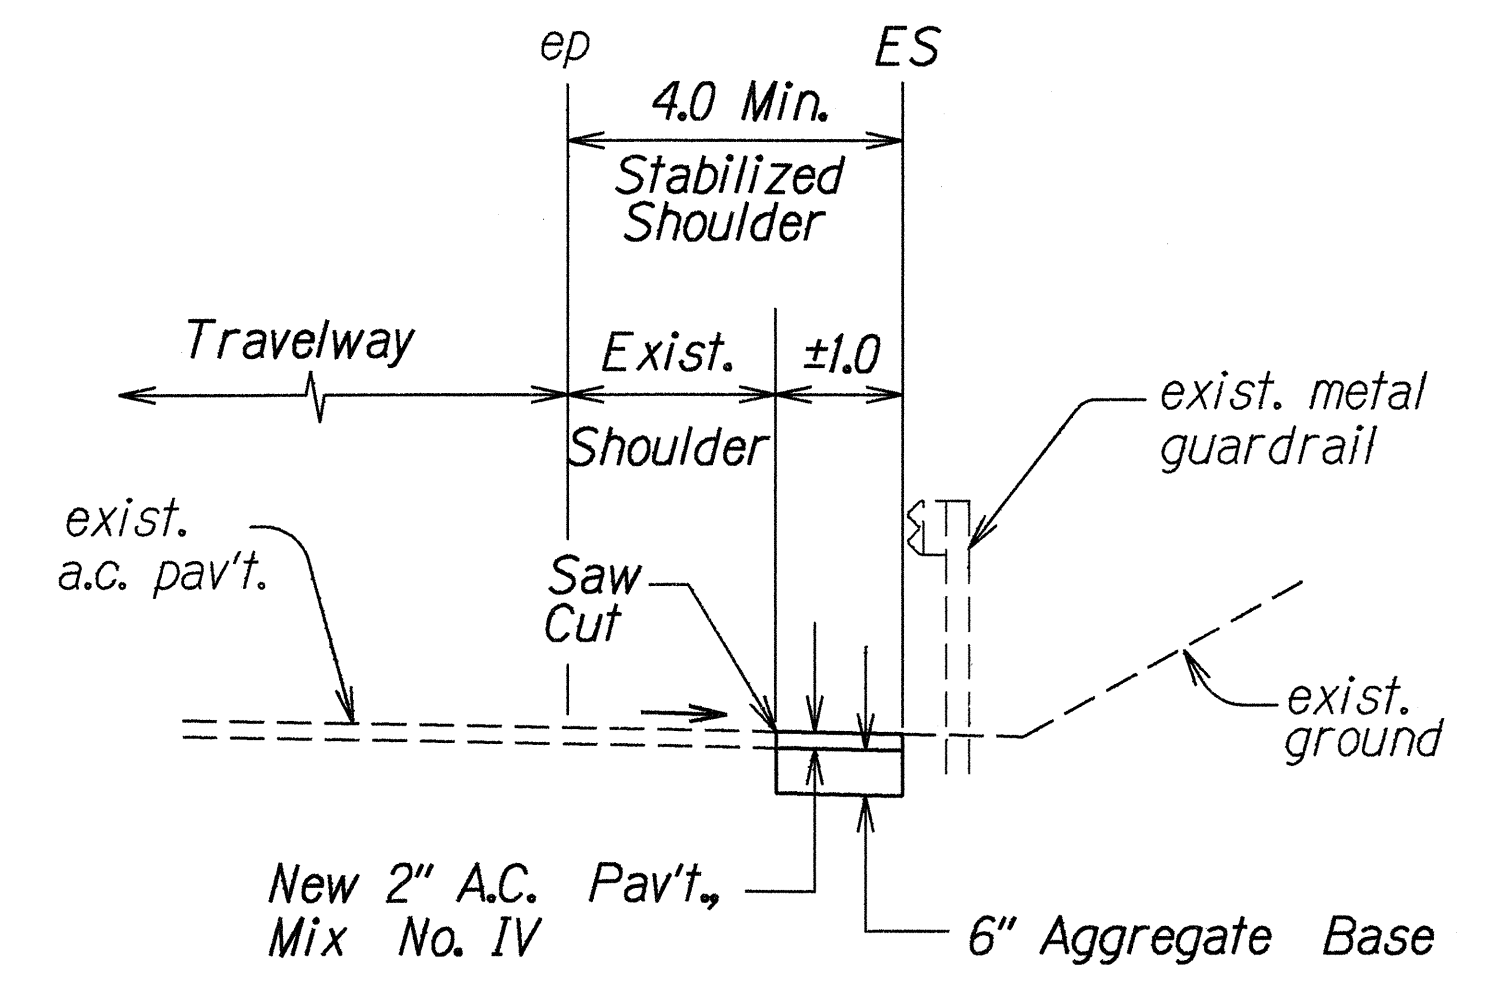

NOTE : Continue existing cross slopes on all roadway reconstruction, shoulder widening and/or reconstruction.

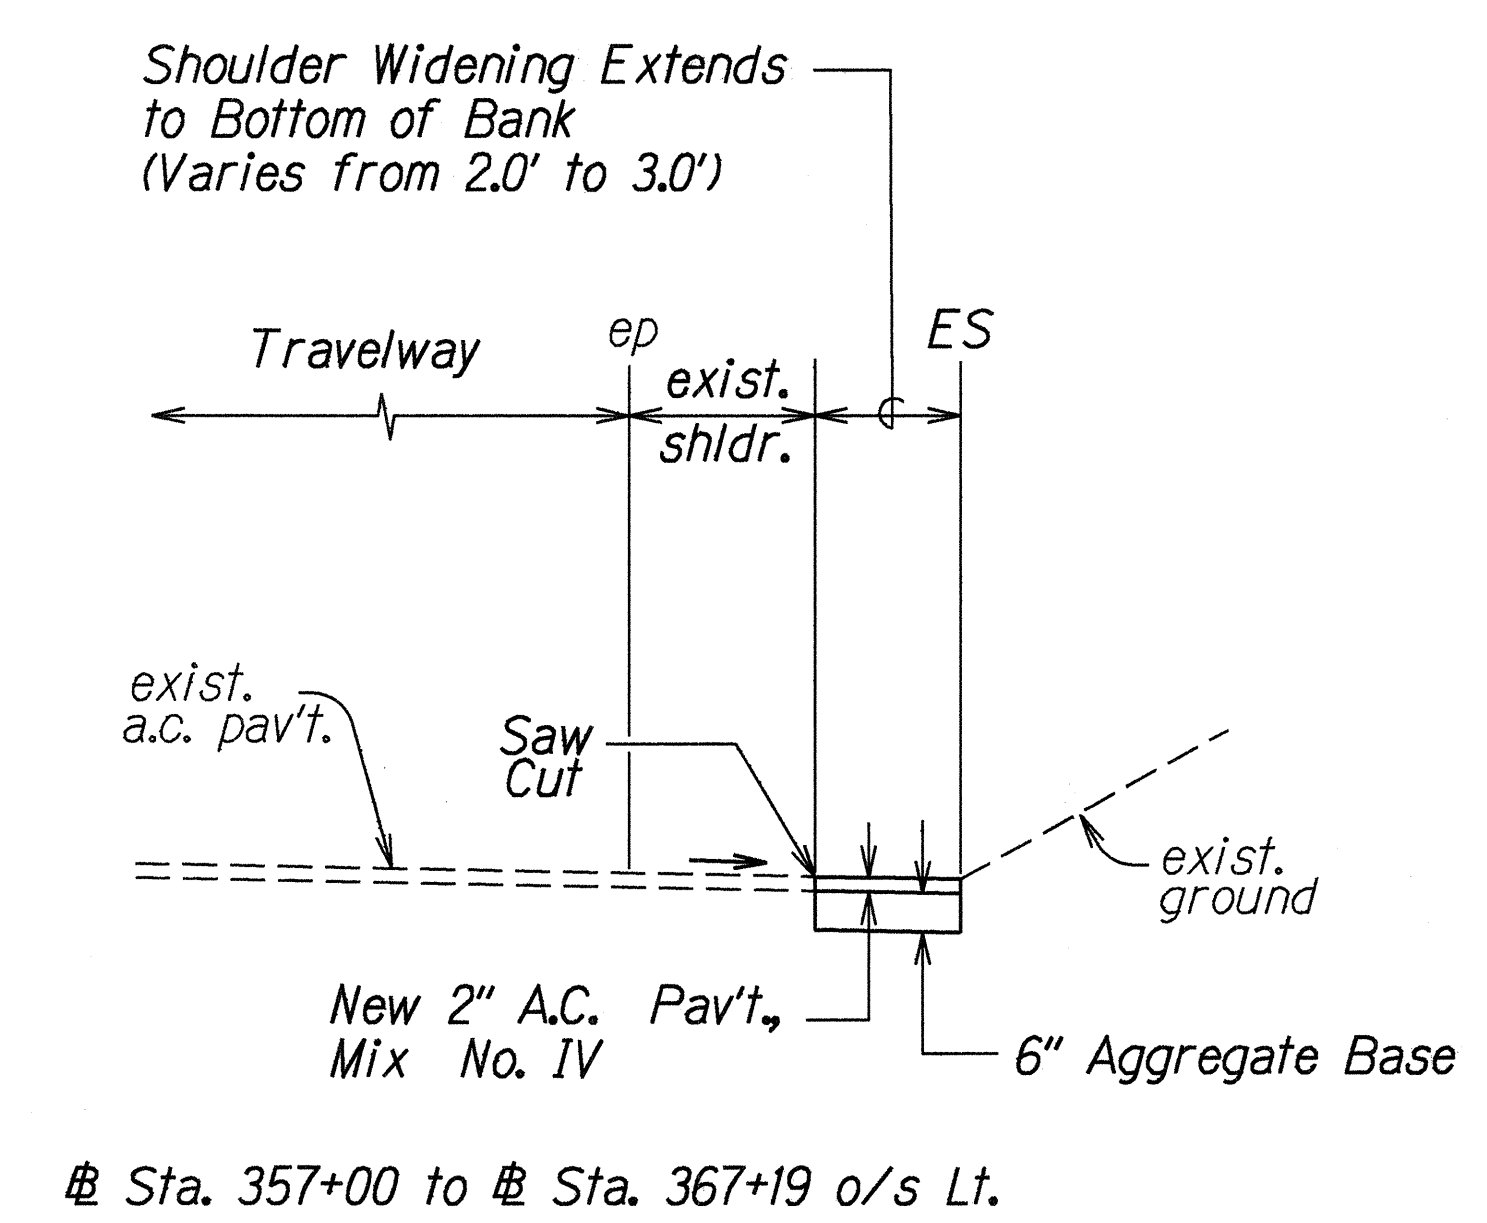

Sta. 357+00 to # Sta. 367+19 o/s Lt.

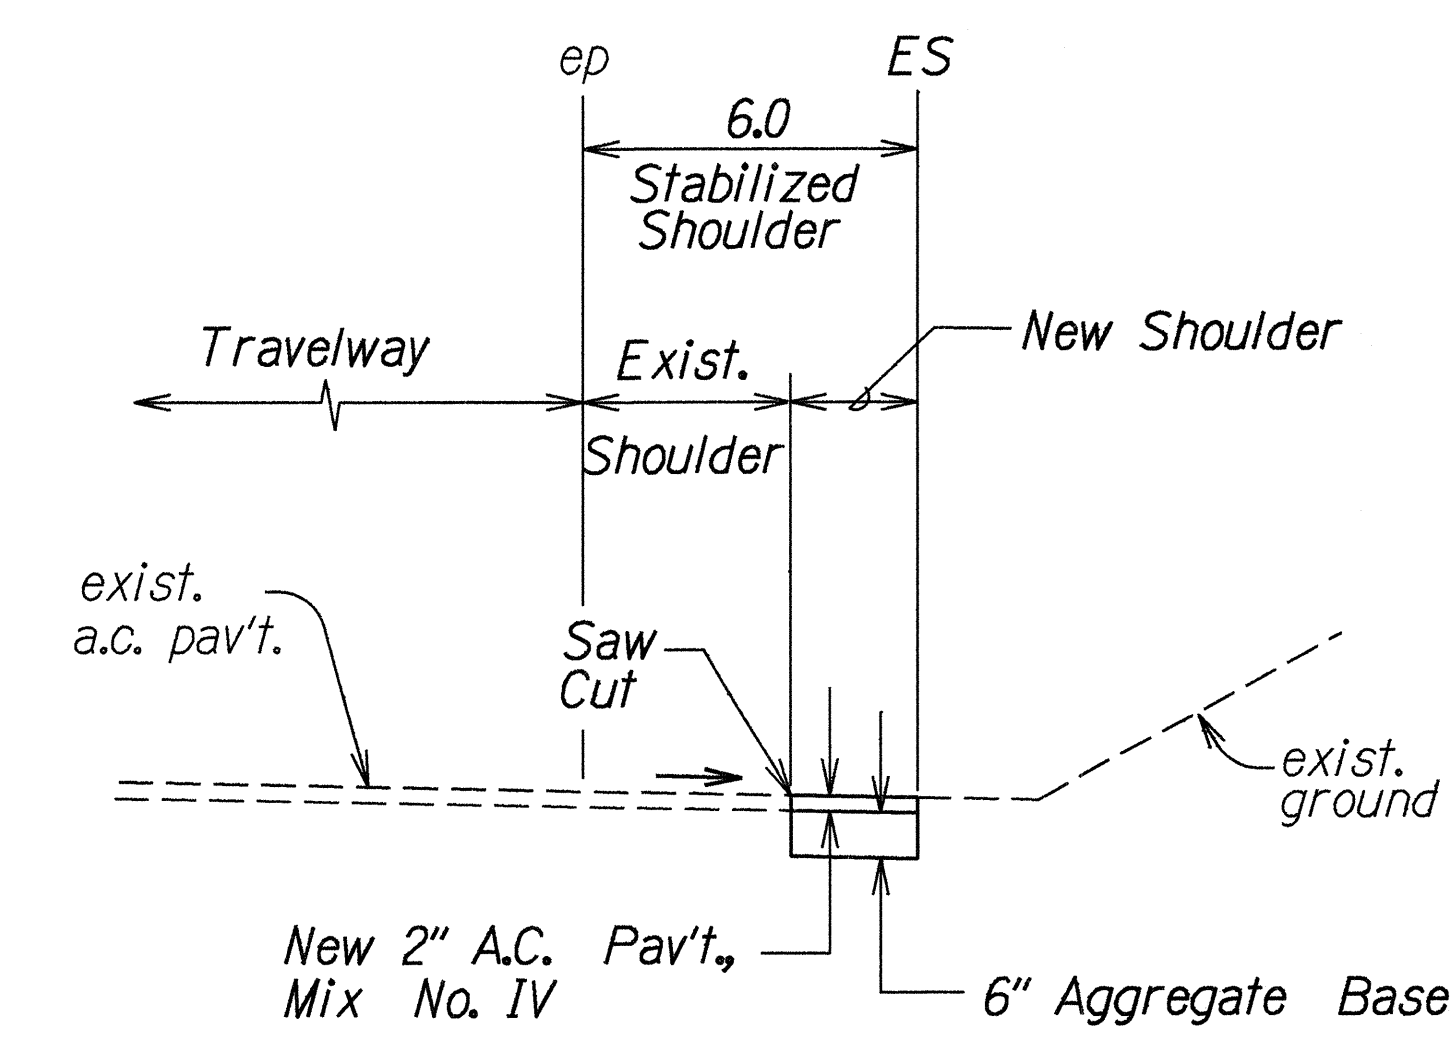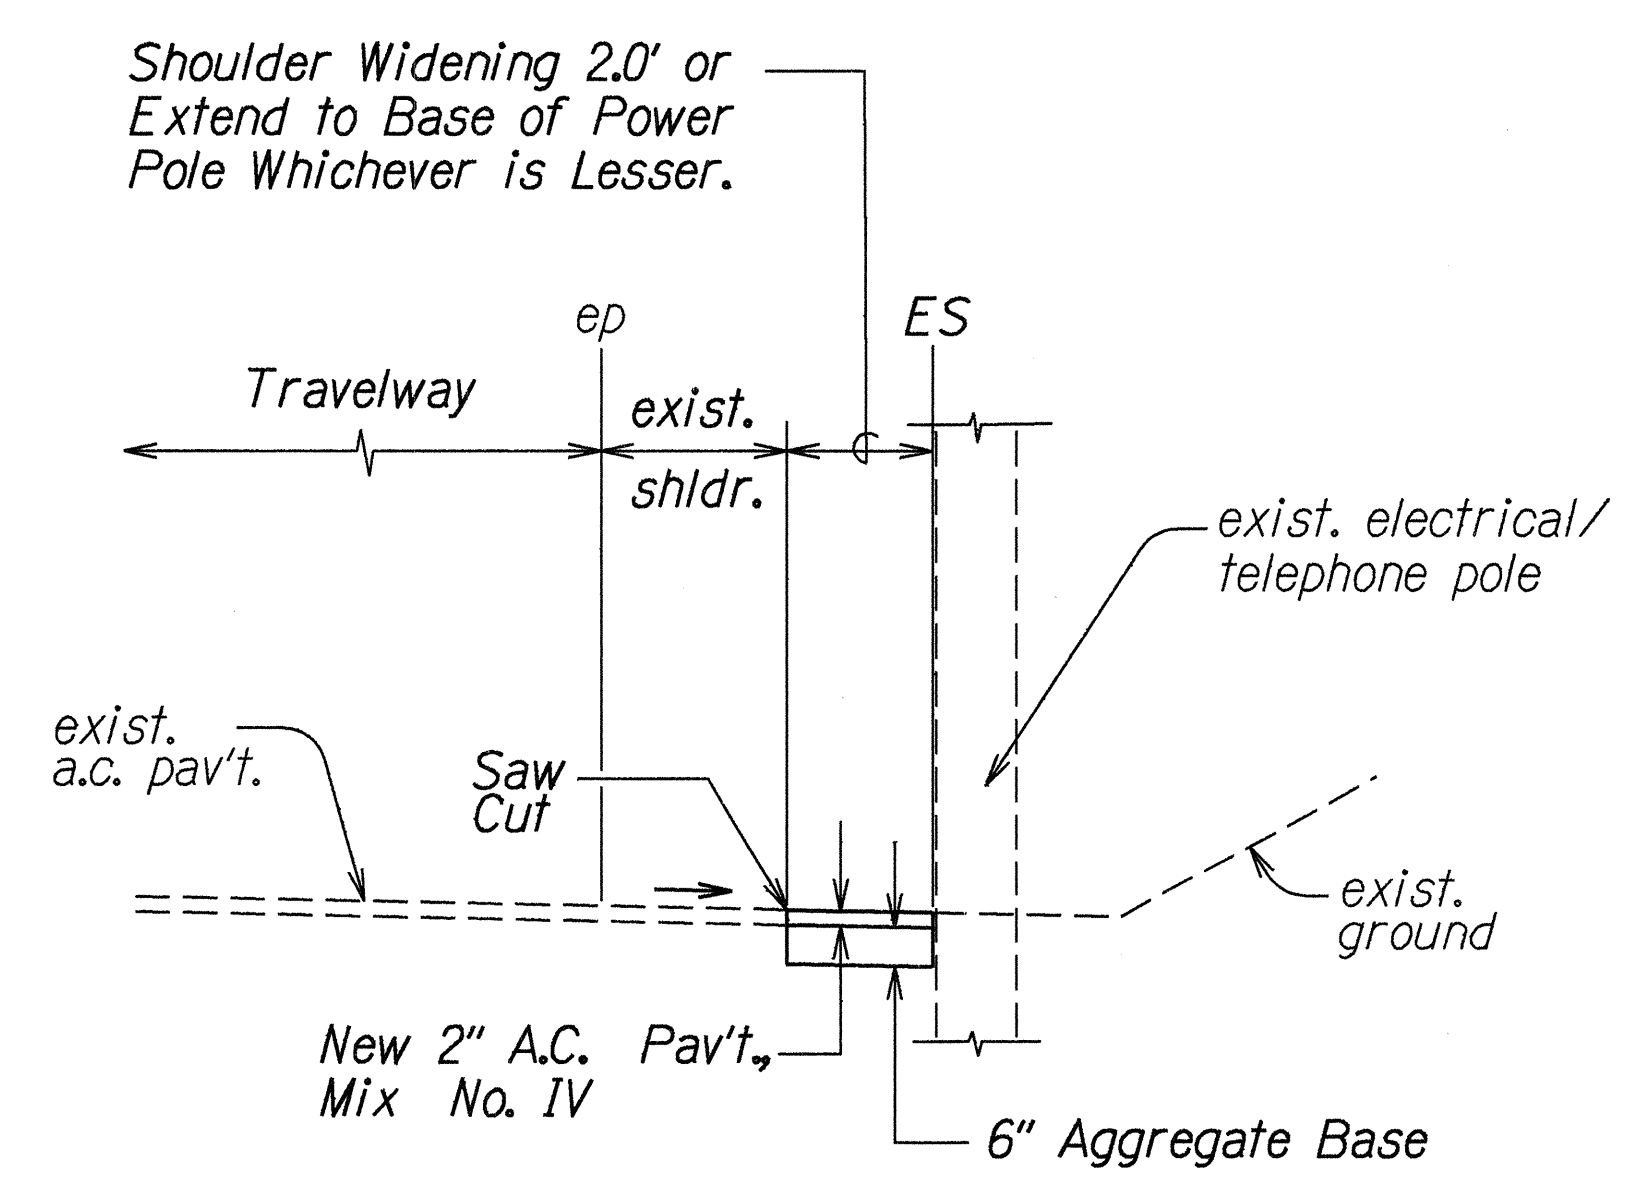

STATE OF HAWAII
 DEPARTMENT OF TRANSPORTATION
 HIGHWAYS DIVISION

TYPICAL SECTIONS
KUHIO HIGHWAY SHOULDER
IMPROVEMENTS FOR BICYCLE ROUTE
 Lihue to Kapaa
 Project No. STP-056-1(40)

Scale: 1/4"=1'-0" Date: April, 1997

SHEET No. 1 OF 1 SHEETS

DATE	12-24-96
DESIGNED BY	5-3-97
CHECKED BY	
NOTED BY	
DESIGNED BY	
CHECKED BY	
NOTED BY	
DESIGNED BY	
CHECKED BY	
NOTED BY	