	INDEX TO DRAWINGS
SHEET NO.	DESCRIPTION
	TITLE SHEET
2	STANDARD PLANS SUMMARY
3	NOTES & LEGEND
4 - 20	TRAFFIC SIGNAL PLAN
21	MARKING, STRIPING, & SIGNING PLAN
:	AT KUKUI ST.
22	INTERSECTION IMPROVEMENTS AT
	KUKUI ST.
23	DETAILS
24	LOOP DETECTOR DETAILS
25	SWING SIGN BRACKET DETAILS
26-28	CURB RAMP DETAIL
<u> </u>	
the control of the co	
	and the Control of th

STATE OF HAWAII

DEPARTMENT OF TRANSPORTATION

HIGHWAYS DIVISION HONOLULU, HAWAII

"AS-BUILT"
PLANS FOR

KUHIO HIGHWAY


TRAFFIC SIGNAL MODERNIZATION FEDERAL AID PROJECT NO. STP-056-I(39)


DISTRICTS OF LIHUE AND KAWAIHAU ISLAND OF KAUAI

FED. ROAD DIST. NO. STATE PROJ. NO. FISCAL SHEET TOTAL SHEETS

HAWAII HAW. STP-056-1(39) 1998 1 28




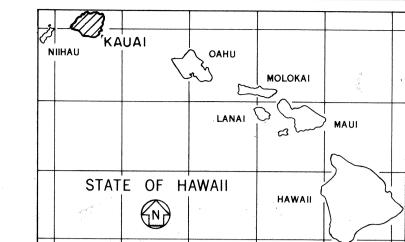

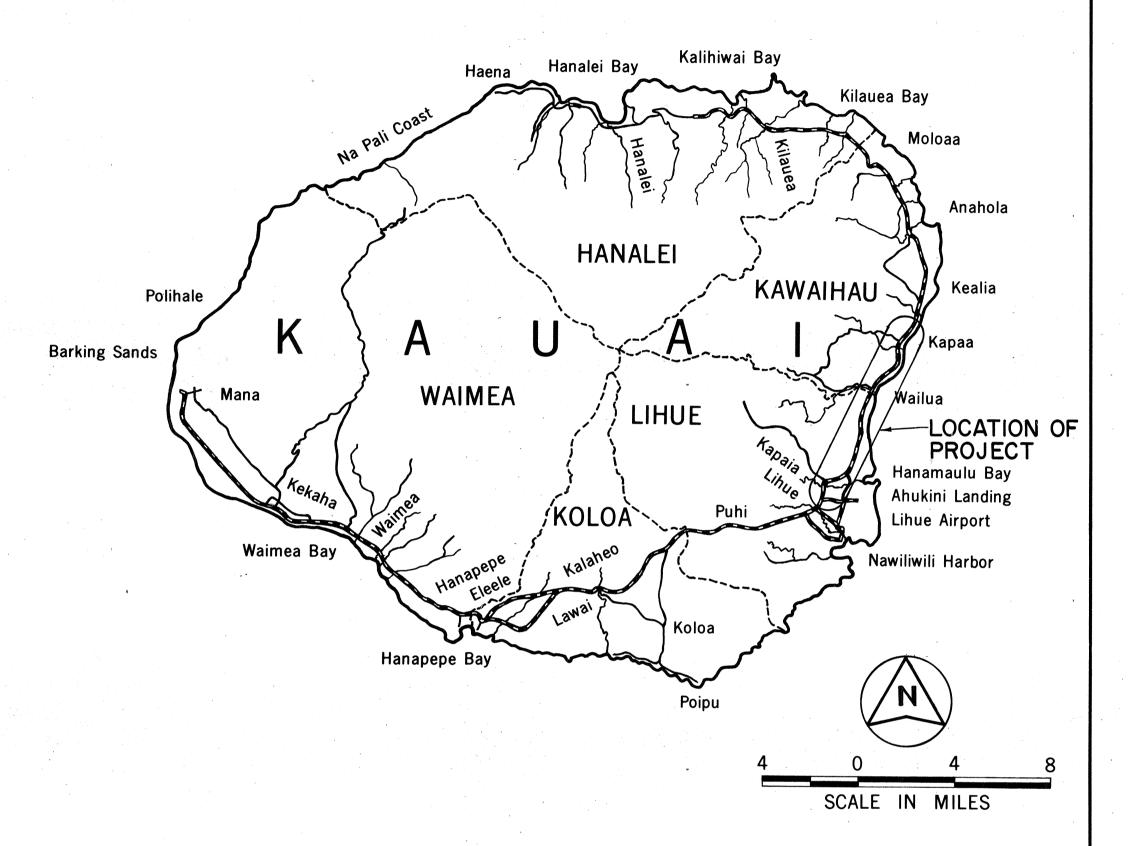

FEDERAL AID PROJECTS PREVIOUSLY CONSTRUCTED OR UNDER CONSTRUCTION

MILE POST 0.33 TO MILE POST 10.21

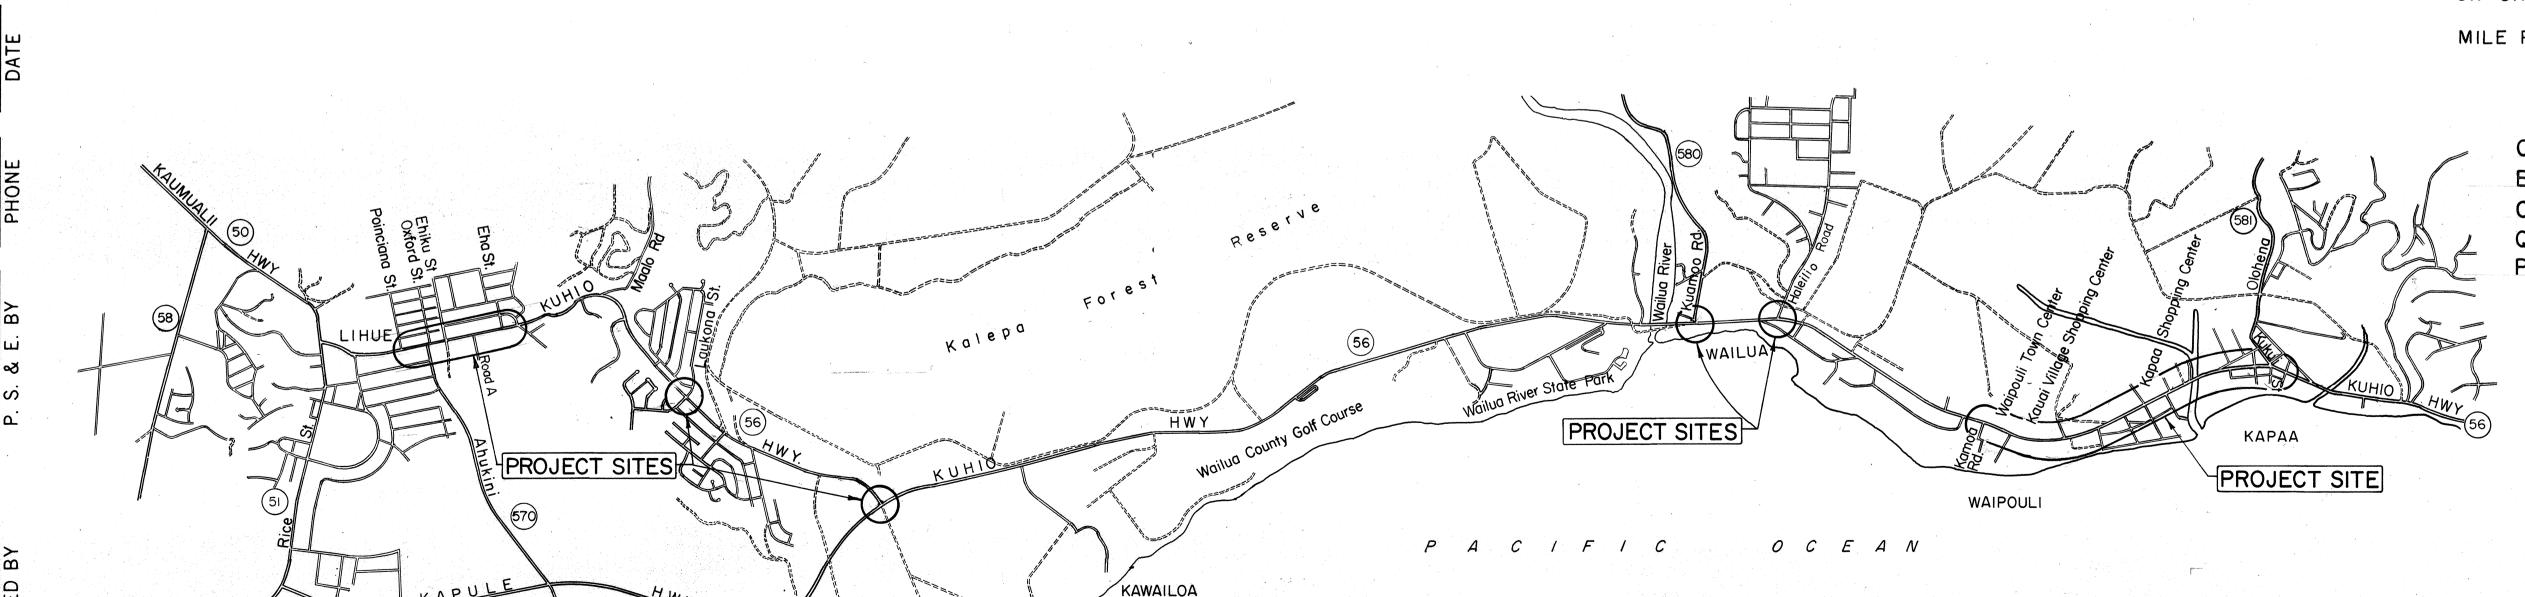

SCALE: 1"= 2000'

CHANGES MADE DURING CONSTRUCTION HAVE BEEN INCORPORATED ON THESE PLANS EXCEPT CHANGES IN THE ORIGINAL THEORETICAL QUANTITIES. FOR ACTUAL QUANTITIES, REFER TO PROJECT LEDGER AND/OR COMPUTATION BOOK.

RESIDENT ENGINEER

8/3/99 DATE

DEPARTMENT OF TRANSPORTATION
STATE OF HAWAII

APPROVED:

Layn Chyarlel 8/5/9

DIR. OF TRANSPORTATION DATE