

DESIGNED BY	DATE
DRAWN BY	DATE
CHECKED BY	DATE
NOTED BY	DATE
QUANTITIES BY	DATE
NO.	

TRAFFIC SIGN SUMMARY					
SIGN NO.	MESSAGE	QUANTITY			
		10 SQ. FT. OR LESS		GREATER THAN 10 SQ. FT.	
		W/ POST	W/O POST	W/ POSTS	W/O POSTS
R3-40(L)-A		2			
R7-1		2			
R7-1(R)		2			
R7-1(L)		1			
"Adopt a Highway" Sign Assembly (No Sign Number)				1 Assembly	
	TOTAL	7		1	

DESTINATION SIGN SUMMARY				
SIGN NO.	MESSAGE	SIZE	NEW PANEL AREA (SQ. FT.)	
			* W/ POSTS	W/O POSTS
D-1		8'0" x 4'-0"	2432	
	TOTAL		2432	


NOTES: * Posts for Sign Shall Be S3x5.7 with Break-Away Sign Supports.

REFLECTOR MARKER SUMMARY						
TYPE	QUANTITY					
	W/O POST		W/ FLEXIBLE POST		W/ STEEL POST	
	YELLOW	WHITE	YELLOW	WHITE	YELLOW	WHITE
* RM-3	29	—	—	—	1	—
** OM, Type II	6	—	—	—	—	—

NOTES:
* Install RM-3 w/o steel post on new and relocated permanent signs (to be installed on posts of signs).
** Install Object Marker (OM-II) w/o steel post on all utility poles that are located within 30 feet of the edge of paved shoulder.

PAVEMENT MARKING SUMMARY		
DESCRIPTION		QUANTITY
PAVEMENT MARKERS		
TYPE A		8 EA
TYPE C		34 EA
TYPE D		11 EA
TYPE H		29 EA
* TAPE - TYPE I OR THERMOPLASTIC EXTRUSION		
4-INCH PAVEMENT STRIPE (WHITE)		80 L.F.
8-INCH PAVEMENT STRIPE (WHITE)		90 L.F.
DOUBLE 4-INCH PAVEMENT STRIPE (YELLOW)		171 L.F.
** TAPE - TYPE II OR THERMOPLASTIC EXTRUSION		
4-INCH PAVEMENT STRIPE (WHITE)		838 L.F.
12-INCH PAVEMENT STRIPE (WHITE)		58 L.F.
12-INCH PAVEMENT STRIPE (YELLOW)		105 L.F.
DOUBLE 4-INCH PAVEMENT STRIPE (YELLOW)		622 L.F.
*** TAPE - TYPE III OR THERMOPLASTIC EXTRUSION		
4-INCH PAVEMENT STRIPE (WHITE)		90 L.F.
4-INCH PAVEMENT STRIPE (YELLOW)		134 L.F.
12-INCH PAVEMENT STRIPE (WHITE)		52 L.F.
CROSSWALK MARKINGS		4 LANES
PAVEMENT ARROW		3 EA
PAVEMENT WORD		2 EA

NOTES:
* Tape, Type I or Thermoplastic Extrusion (No Passing Zones, Channelizing Lines or Solid Lines)
** Tape, Type II or Thermoplastic Extrusion (Transverse Median Markings, Transverse Shoulder Markings, Channelizing Islands or Edge Striping)
*** Tape, Type III, or Thermoplastic Extrusion (Guide Lines, Pavement Words or Pavement Arrows)

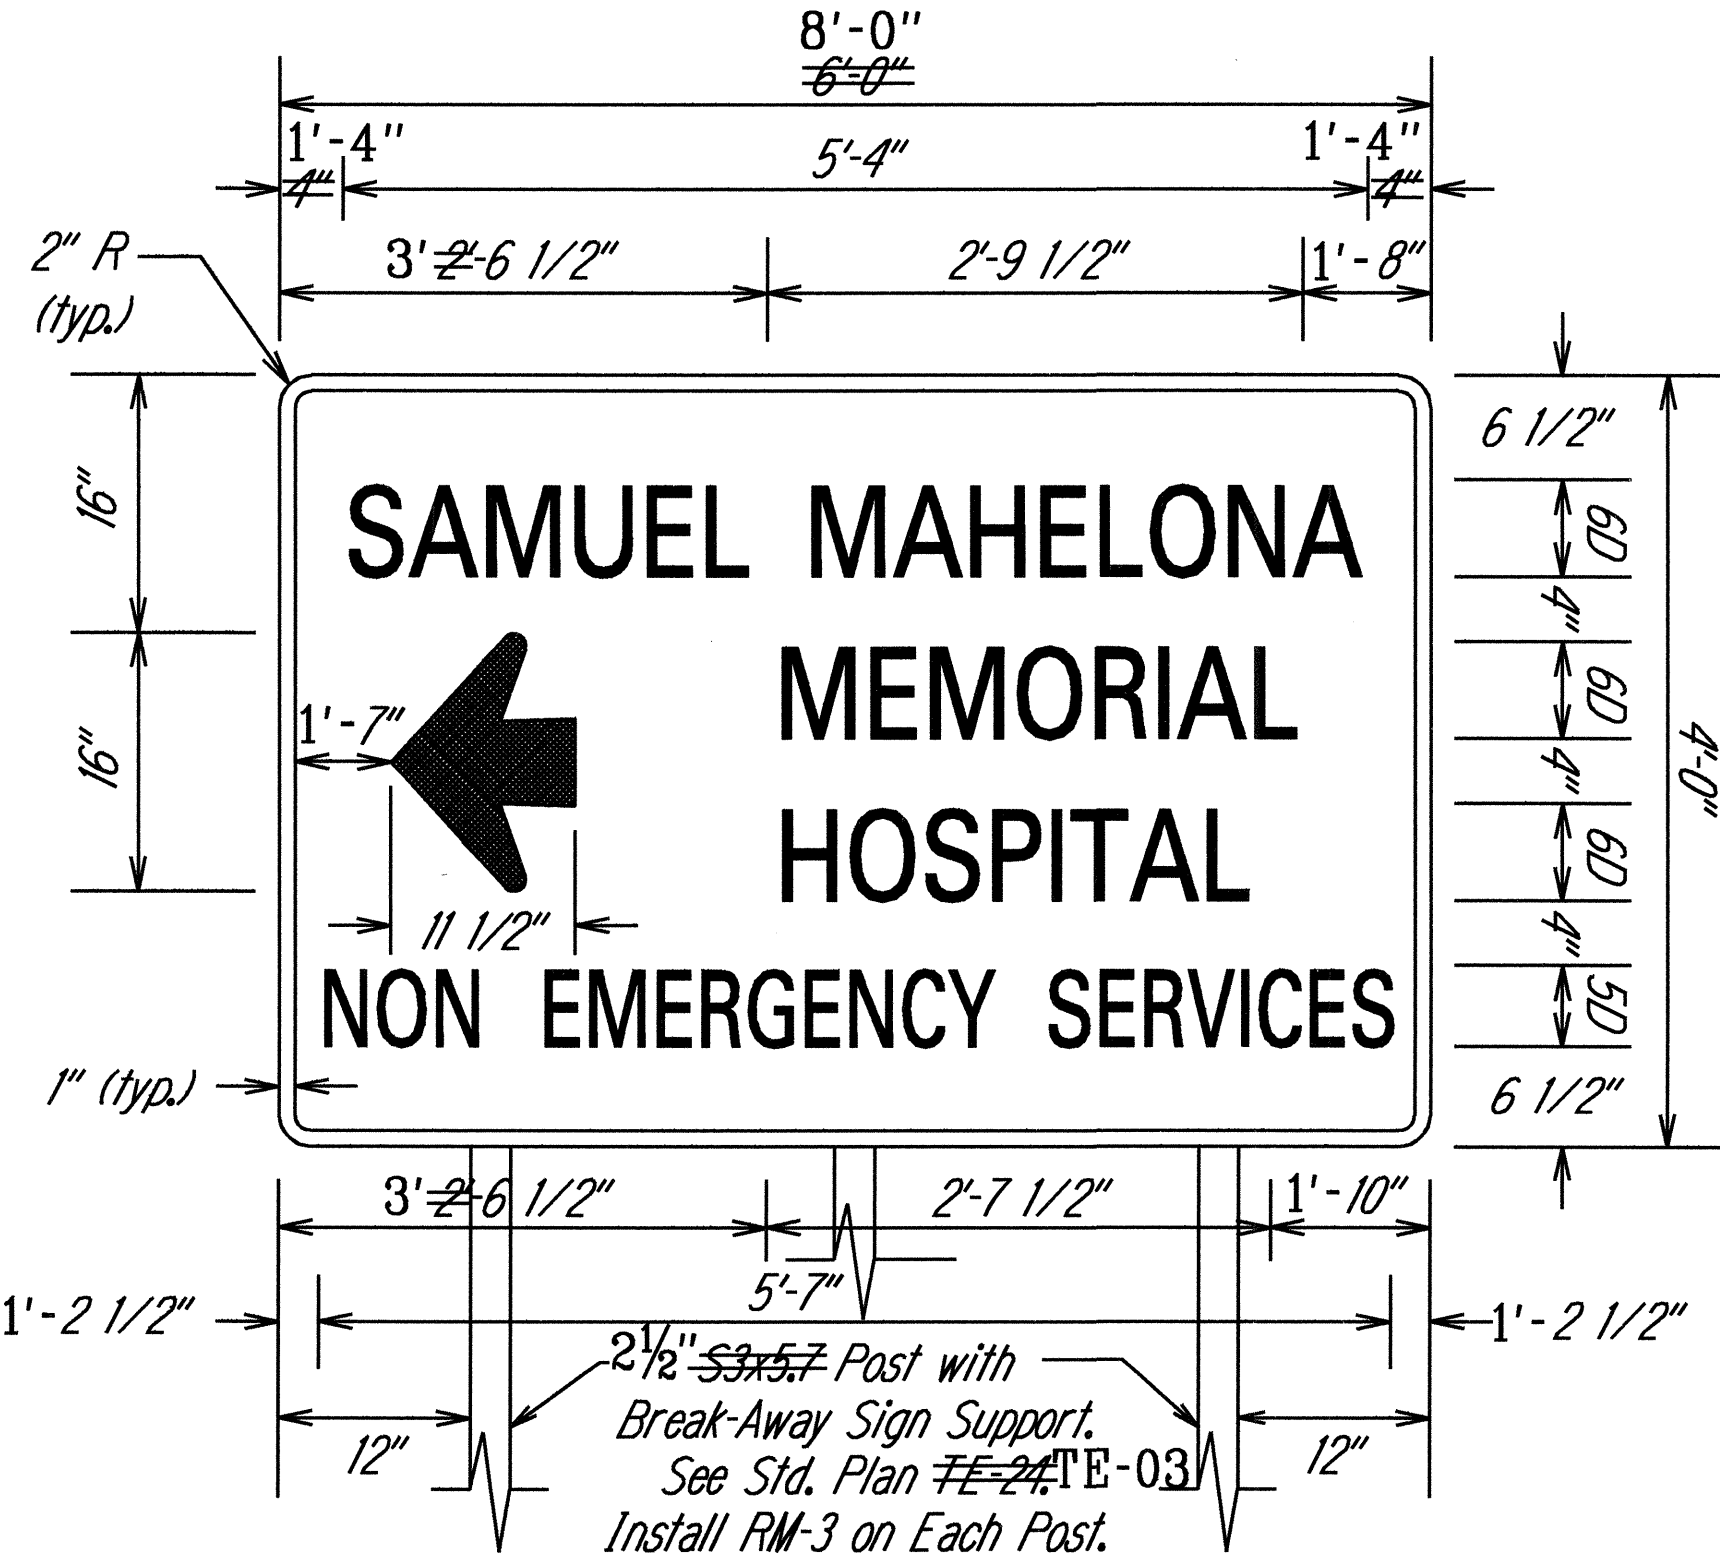

SIGN DETAIL D-1
Scale: 1" = 1'

FED. ROAD DIST. NO.	STATE	PROJ. NO.	FISCAL YEAR	SHEET NO.	TOTAL SHEETS
HAWAII	HAW.	56A-01-97	1998	8	8

LEGEND FOR AS-BUILT POSTINGS	
	Squiggly line for as-built deletion
	Double line for as-built deletion
Roadway	Text for as-built posting

CONSTRUCTION SIGN SUMMARY			
SIGN NO.	MESSAGE	W/ POSTS	W/O POSTS
CW20-1A(d)	ROAD WORK AHEAD	4	—
CG20-2A	END ROAD WORK	4	—
	TOTAL	8	0

Legend: Color
Border — White
Lettering — White
Background — Green
Arrow — White

STATE OF HAWAII DEPARTMENT OF TRANSPORTATION HIGHWAYS DIVISION	
TRAFFIC SIGN SUMMARY AND PAVEMENT MARKING SUMMARY	
KUHIU HIGHWAY, LEFT TURN STORAGE LANE TO HAUAALA ROAD AND KAWAIHAU ROAD Proj. No. 56A-01-97	
Scale: As Shown	Date: May, 1998

SHEET No. / OF / SHEETS