
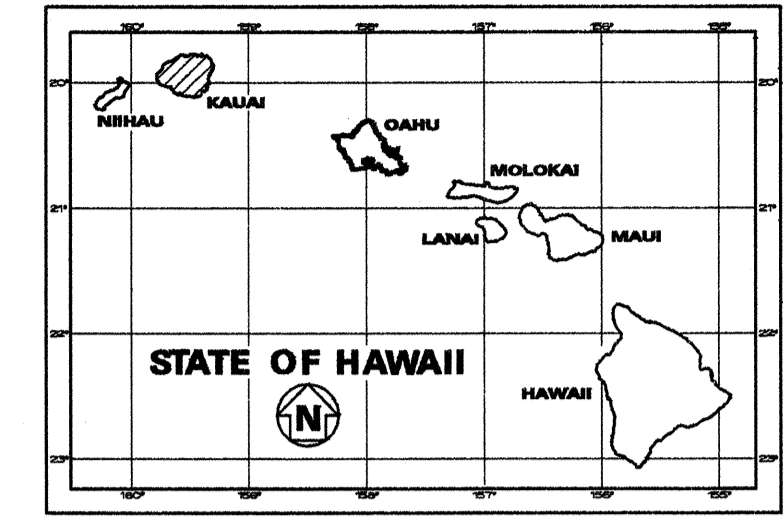


INDEX TO DRAWINGS	
SHEET NO.	DESCRIPTION
1	TITLE SHEET
2	STANDARD PLANS SUMMARY
3	GENERAL NOTES & LEGEND
4	TYPICAL SECTIONS AND DETAILS
5 - 12	ROADWAY PLAN
13	PORTABLE PHYSICAL BARRIER
14	FLEAT 350-FLARED ENERGY ABSORBING TERMINAL
15	GUARDRAIL DETAILS & NOTES
16	GUARDRAIL DETAILS-TYPE "G" FLARE
17 - 19	TYPE 'A' FLARE
20	QUANTITY SUMMARIES
21 - 42	BRIDGE INDEX, GENERAL NOTES, ABBREVIATION, ESTIMATED QUANTITIES AND DETAILS

FED. ROAD DIST. NO.	STATE	FED. AID PROJ. NO.	FISCAL YEAR	SHEET NO.	TOTAL SHEETS
HAWAII	HAW.	STP-056-1(43)	2000	1	42


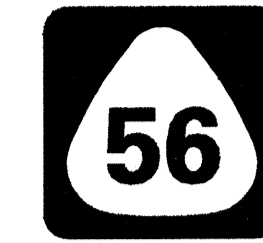


STATE OF HAWAII
 DEPARTMENT OF TRANSPORTATION
 HIGHWAYS DIVISION
 HONOLULU, HAWAII
 "AS BUILT"
 PLANS FOR
KUHIO HIGHWAY

GUARDRAIL AND SHOULDER IMPROVEMENTS AT VARIOUS LOCATIONS
FEDERAL AID PROJECT NO. STP-056-1(43)

DISTRICTS OF LIHUE, KAWAIHAU AND HANAIEI
 ISLAND OF KAUAI

LOCATIONS OF PROJECT

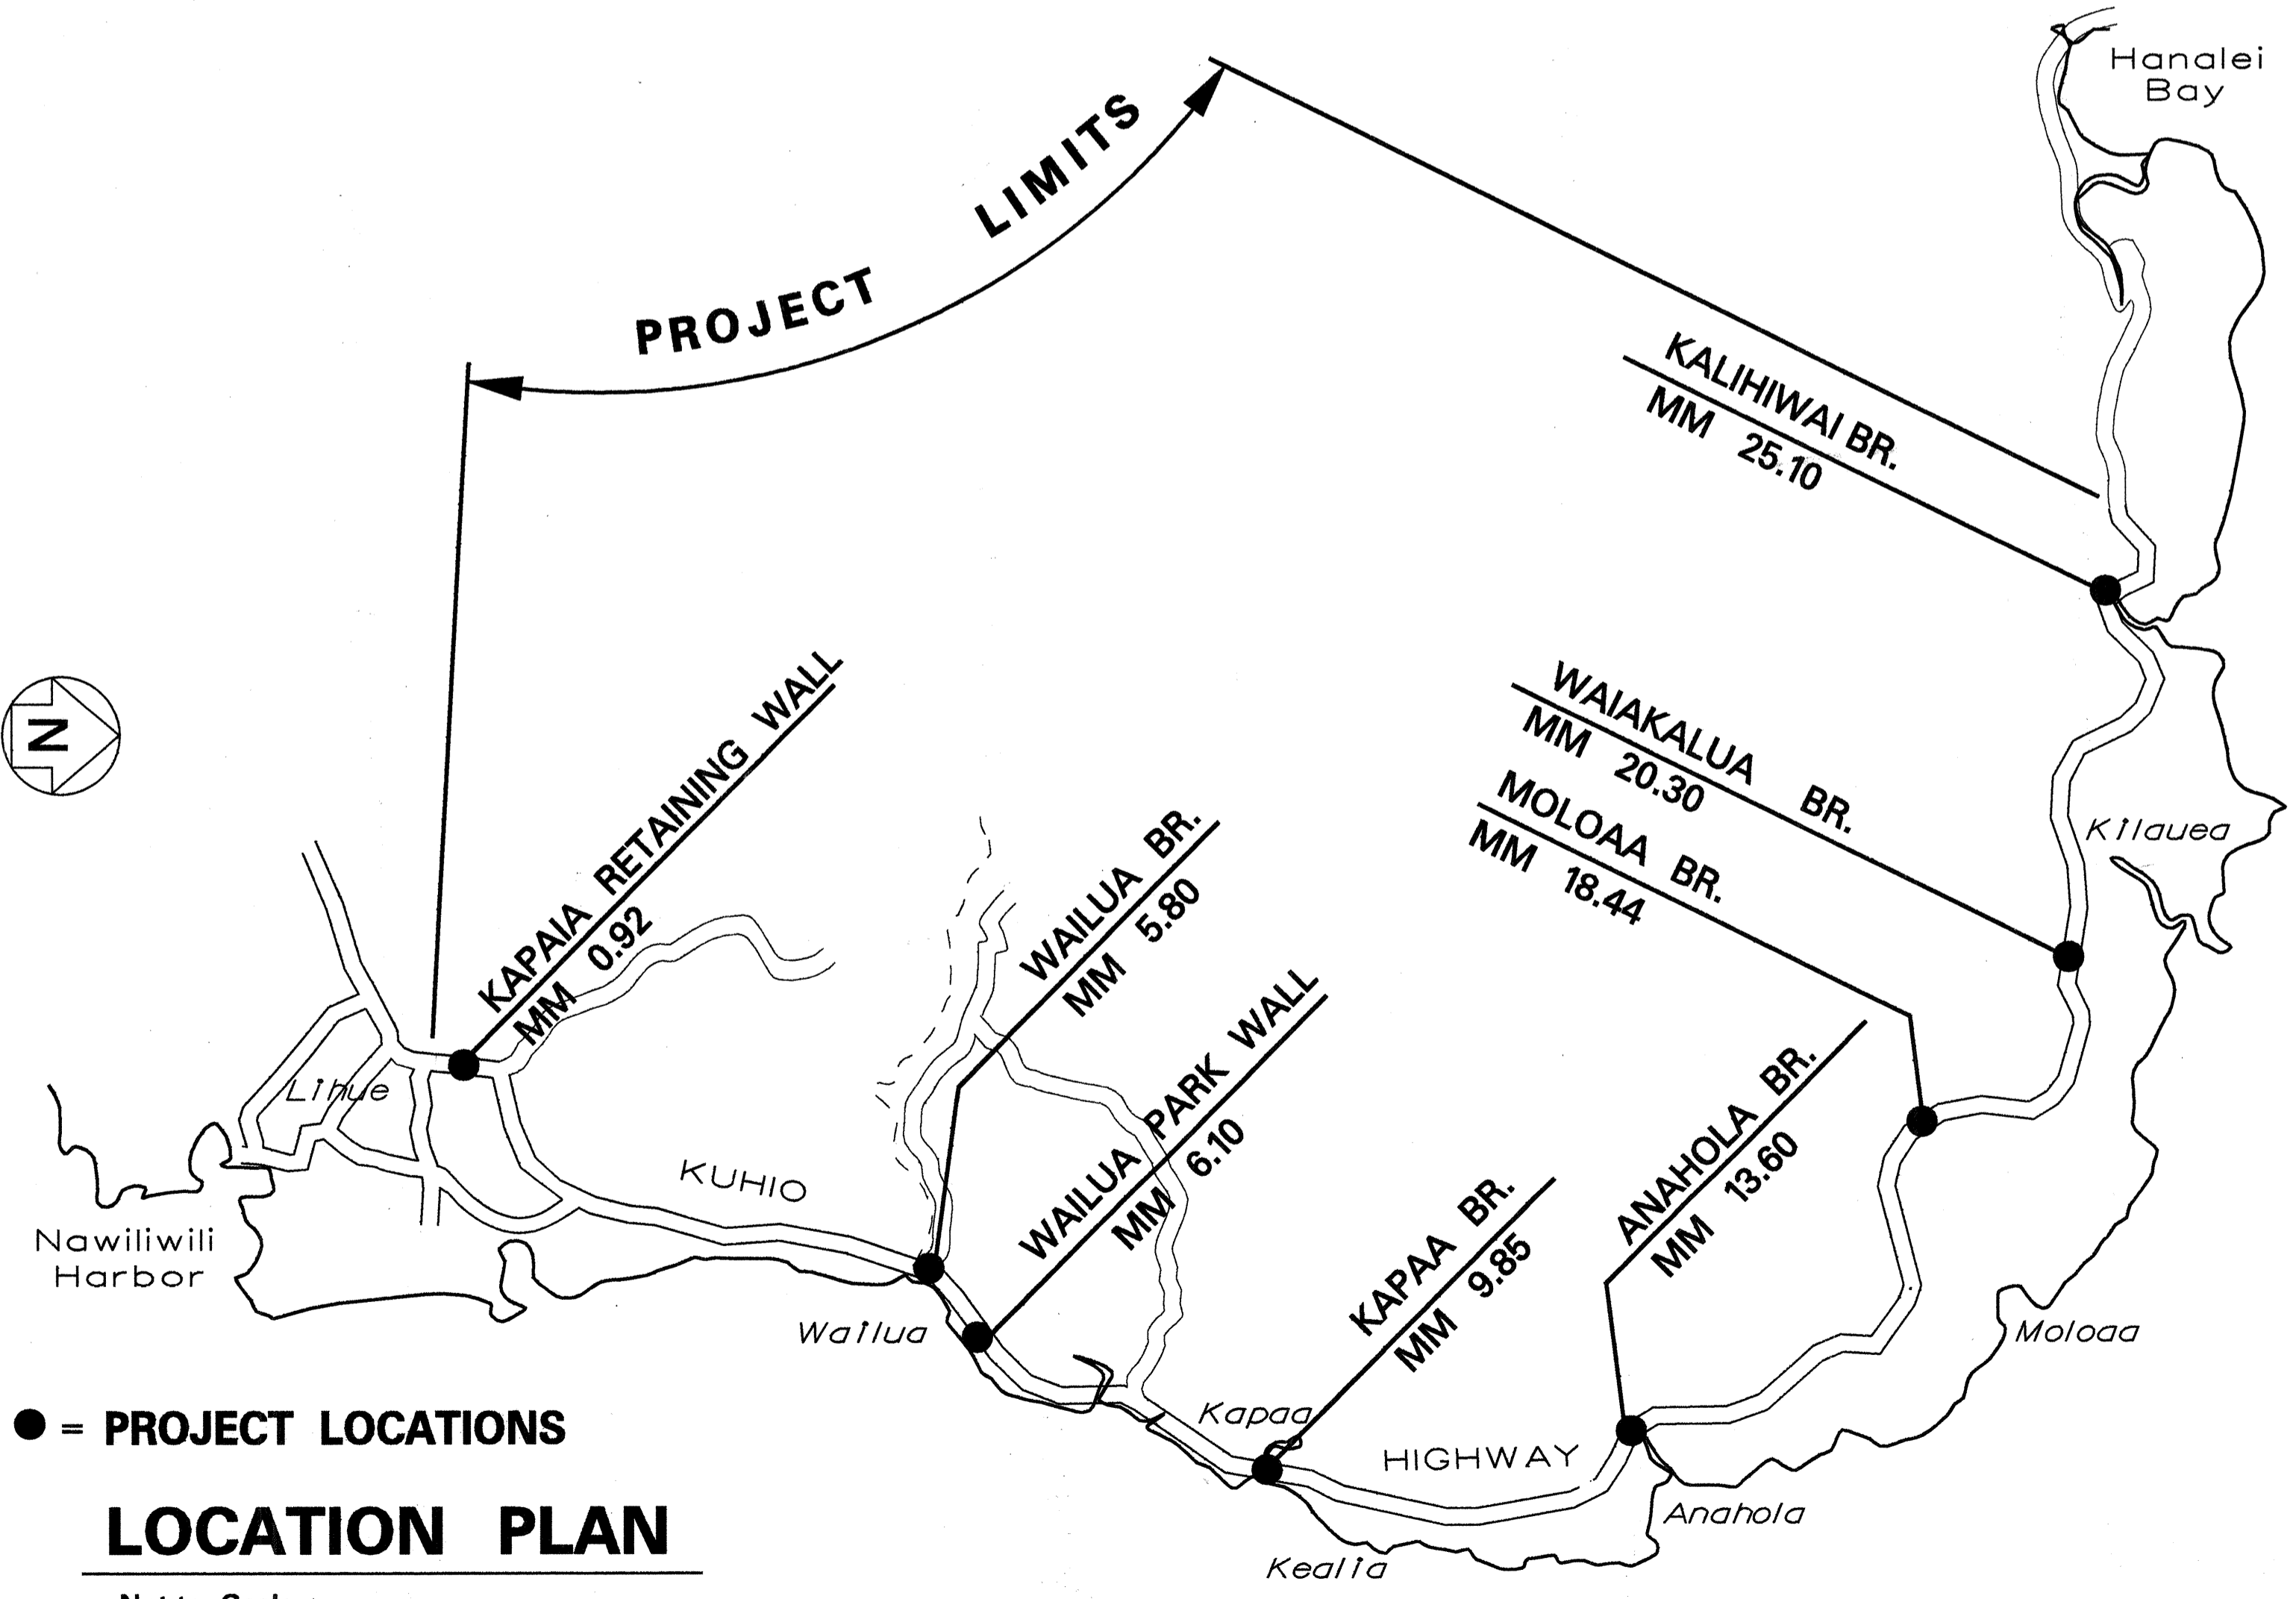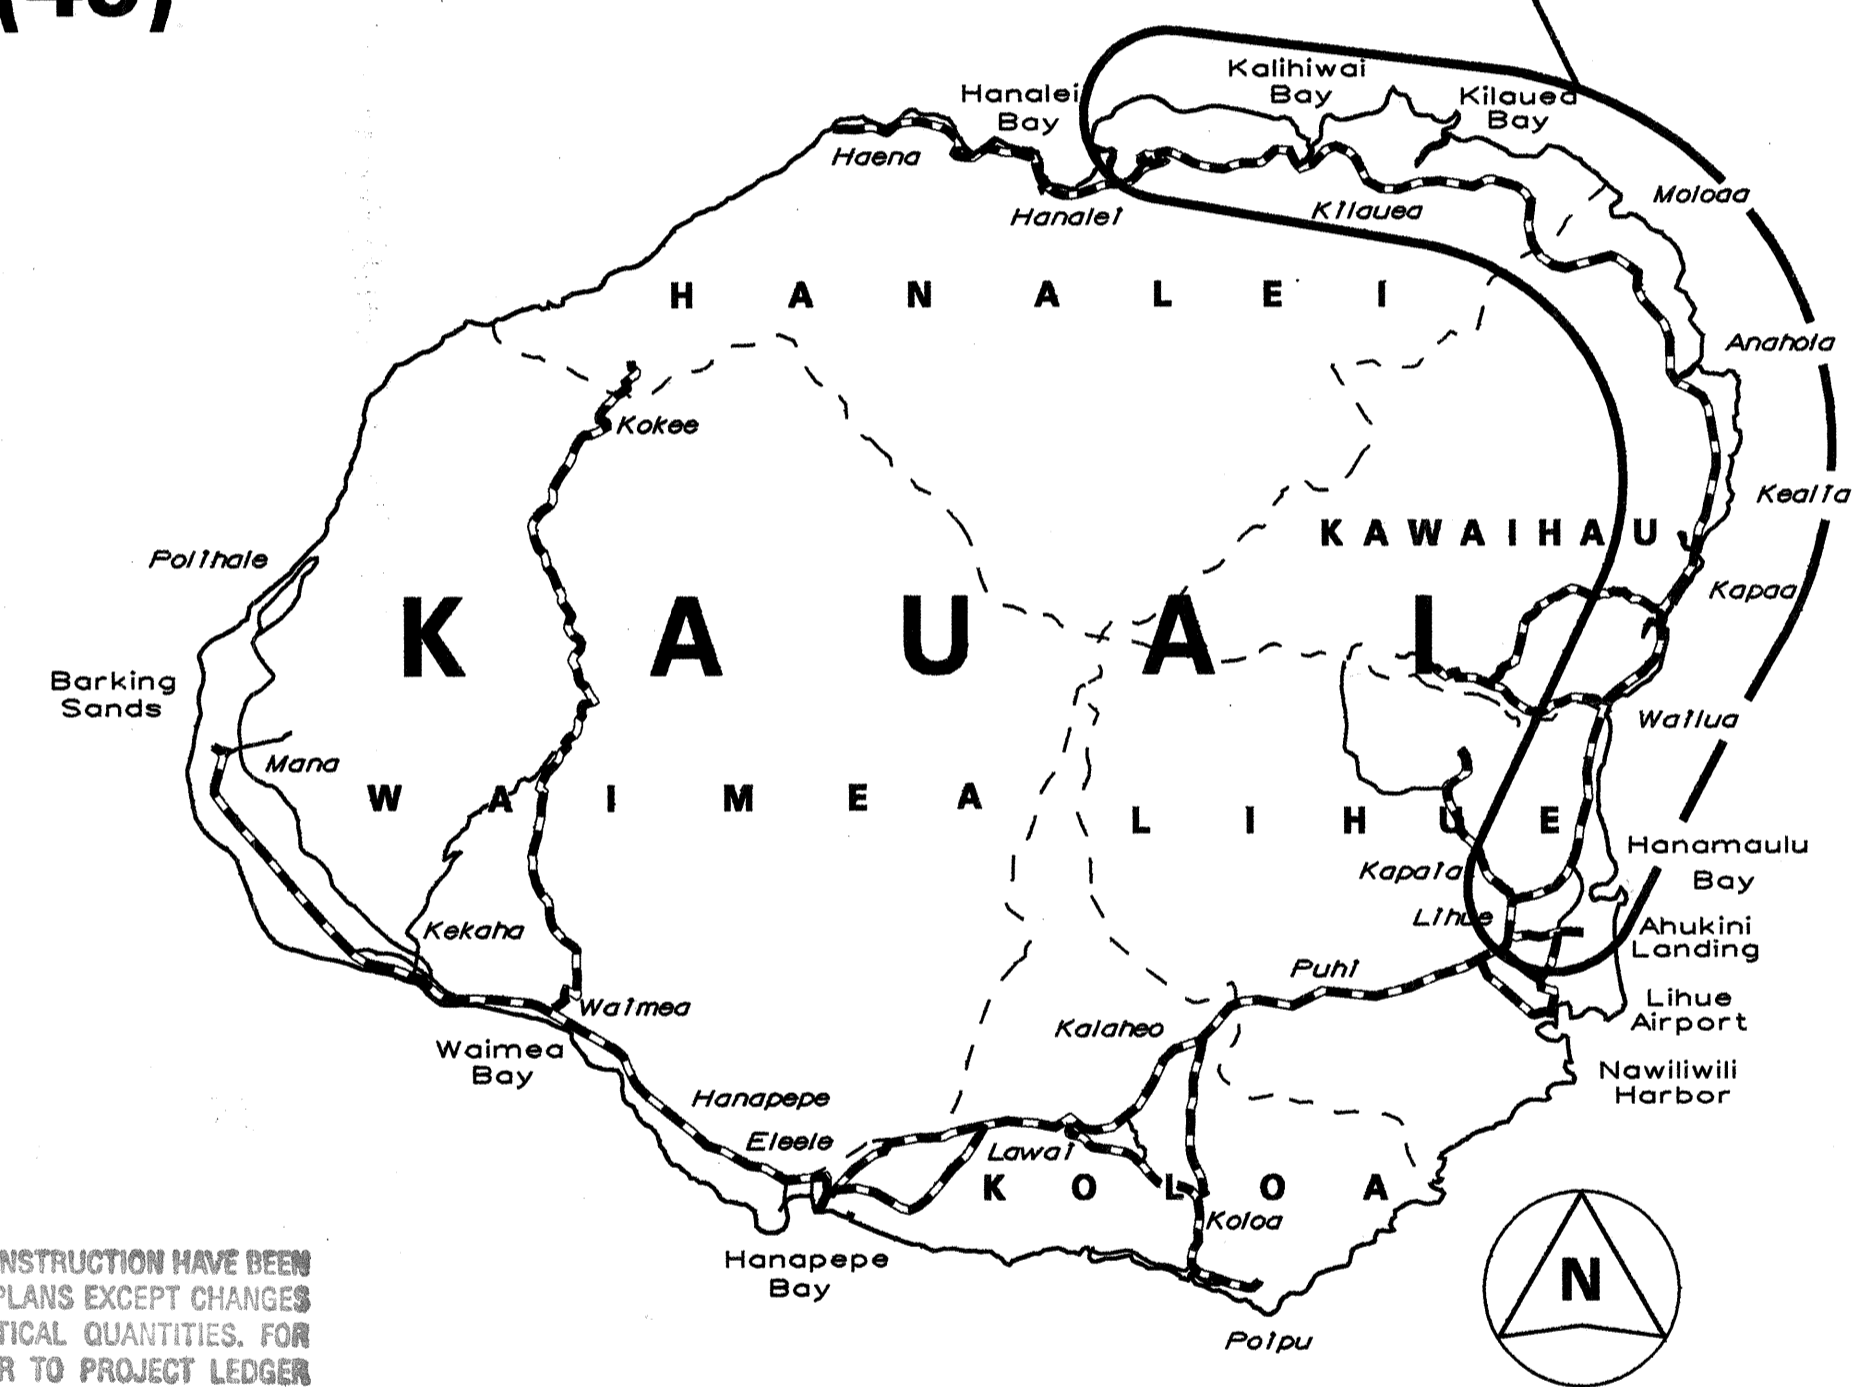

● = PROJECT LOCATIONS
LOCATION PLAN
 Not to Scale

CHANGES MADE DURING CONSTRUCTION HAVE BEEN INCORPORATED ON THESE PLANS EXCEPT CHANGES IN THE ORIGINAL THEORETICAL QUANTITIES. FOR ACTUAL QUANTITIES, REFER TO PROJECT LEDGER AND/OR COMPUTATION BOOK.
 [Signature] 2/14/02
 RESIDENT ENGINEER DATE

----- FEDERAL AID PROJECTS PREVIOUSLY CONSTRUCTED OR UNDER CONSTRUCTION
 MILE POST 0.92 TO MILE POST 25.1

KUHIO HIGHWAY AT WAILUA SCREENLINE DESIGN DESIGNATION

ADT (1998)	30,910
ADT (2008)	39,560
DHV	3,165
D	55/45
T	2.0%
T ₂₄	3.5
K	8.0
V	50 MPH

DEPARTMENT OF TRANSPORTATION
 STATE OF HAWAII
 APPROVED:
 [Signature] 7/27/99
 DIR. OF TRANSPORTATION DATE

HWY-K CHRISTINE YAMASAKI 692-7576 AUG. 1999
 DESIGNED BY P.S. & E. BY PHONE DATE