



\_\_\_\_


"AS-BUILT"

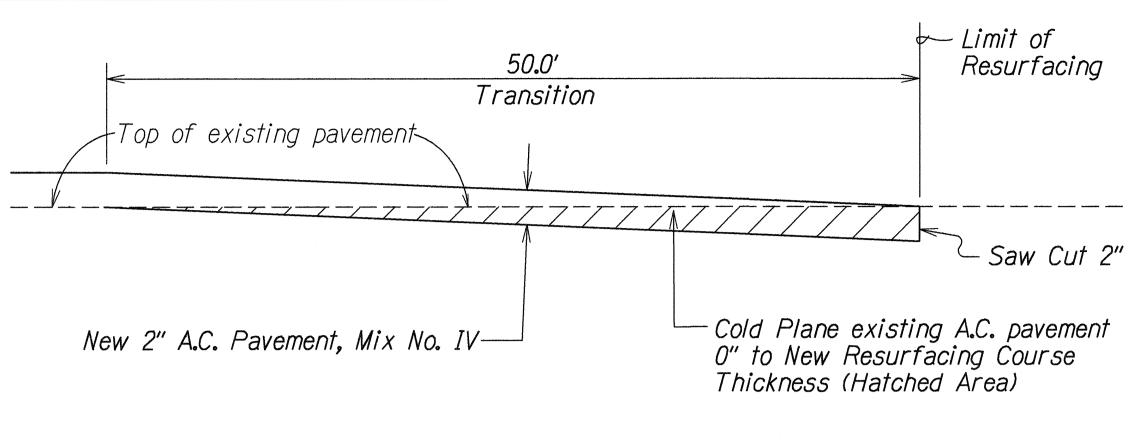


### LONGITUDINAL COLD PLANED TRANSITION AT BEGINING OF PROJECT Not To Scale

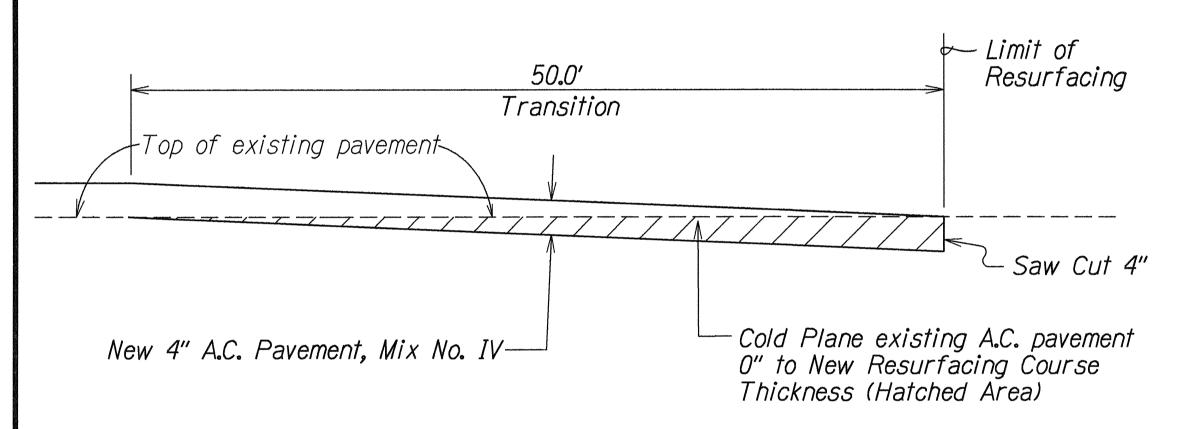

#### LONGITUDINAL COLD PLANED TRANSITION AT END OF PROJECT Not To Scale

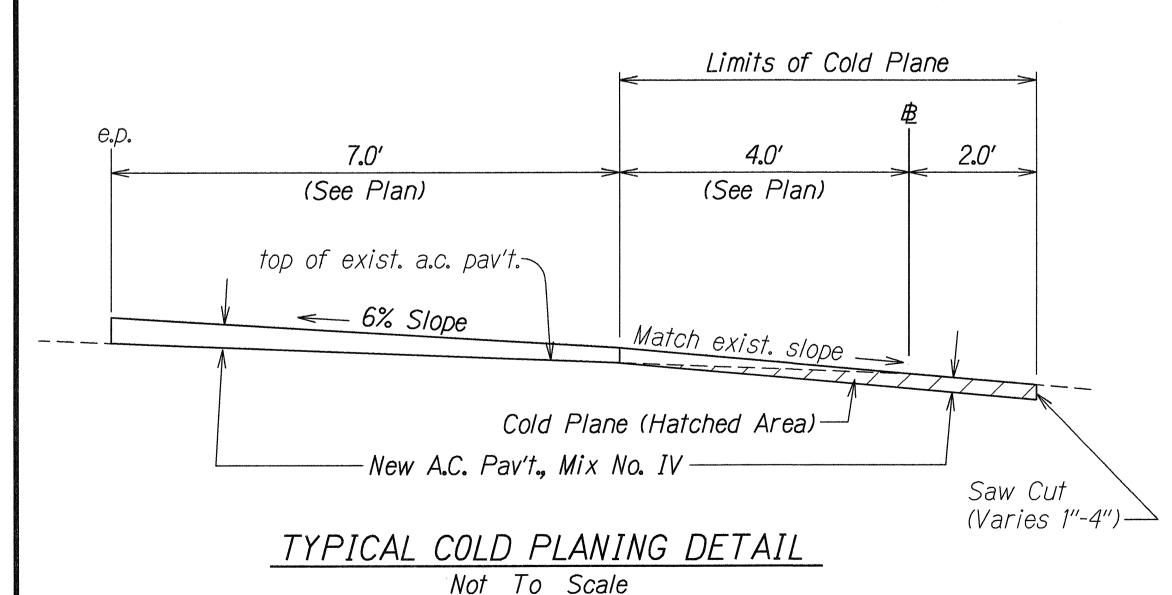

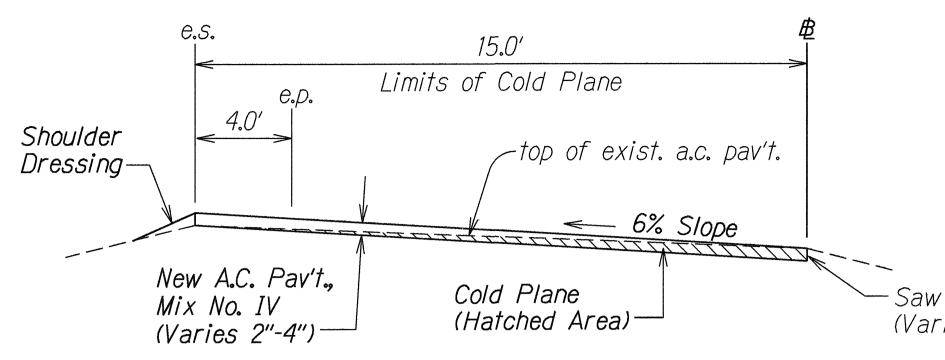

FED. ROAD DIST. NO. FISCAL SHEET TOTAL YEAR NO. SHEETS STATE PROJ. NO. 56D-01-99 2001 5 HAW. HAWAII


\* Note: 型 Sta. 2+00 to 型 Sta. 3+25-

Saw Cut 2"; 型 Sta. 15+25 to 型 Sta. 15+65 -Saw Cut 4"


Saw Cut (Varies 2"-4") \*

# COLD PLANING AT # STA. 2+00 TO # STA. 3+25 AND 也 STA. 15+25 TO 也 STA. 15+65


Not To Scale

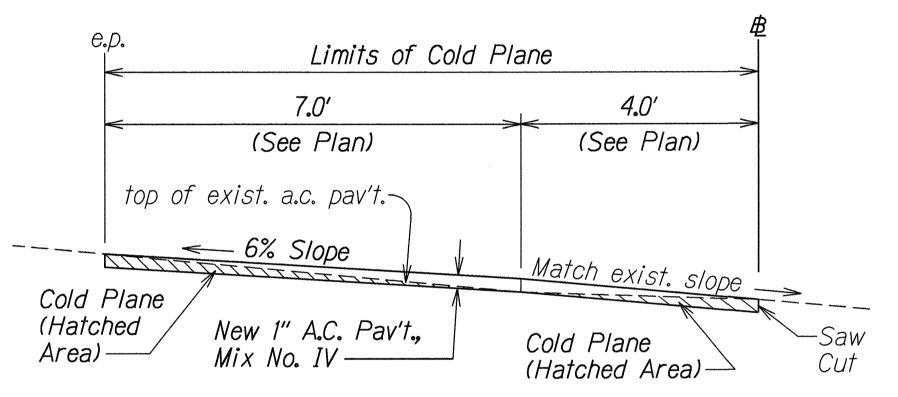

#### COLD PLANING AT & STA. 11+75 TO & STA. 12+75 AND & STA. 13+75 TO & STA. 14+25 Not To Scale

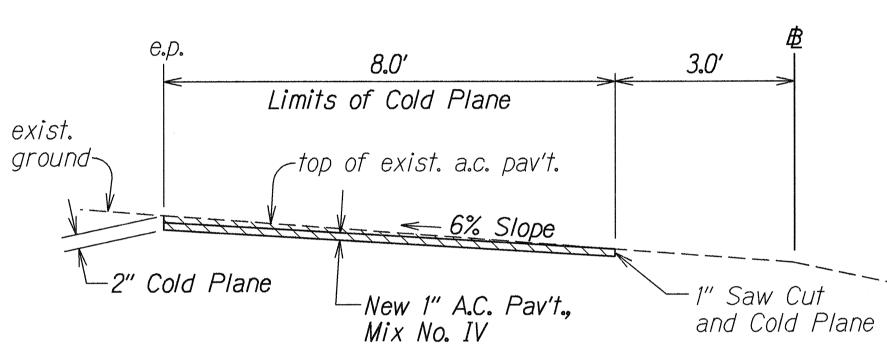

COLD PLANING AT <u> 趣 STA. 12+75 TO 趣 STA. 13+25</u>

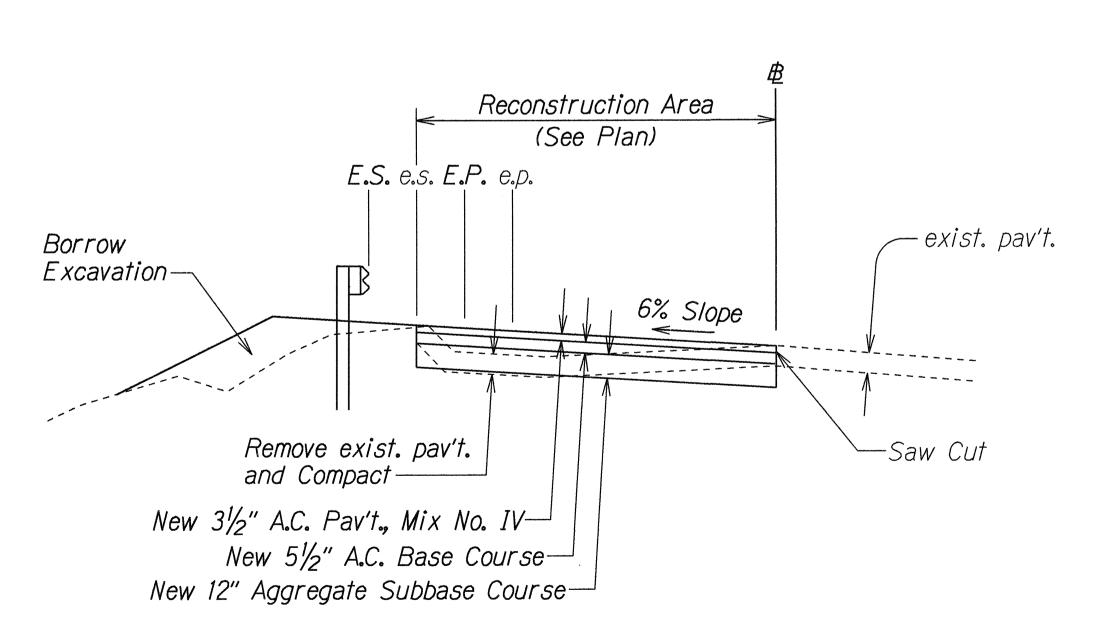

A.C. PAVEMENT RECONSTRUCTION AT 也 STA. 14+75 TO 也 STA. 15+25 Not To Scale

STATE OF HAWAII **DEPARTMENT OF TRANSPORTATION** HIGHWAYS DIVISION

# TYPICAL DETAILS

KUHIO HIGHWAY Intersection Improvements at Kalihiwai Rd.

Project No. 56D-01-99 Scale: As Noted Date: Aug. 2000

> SHEET No. 2 OF 2 SHEETS

