




FED. ROAD DIST. NO.	STATE	PROJ. NO.	FISCAL YEAR	SHEET NO.	TOTAL SHEETS
HAWAII	HAW.	HWY-K-03-00	2002	7	30

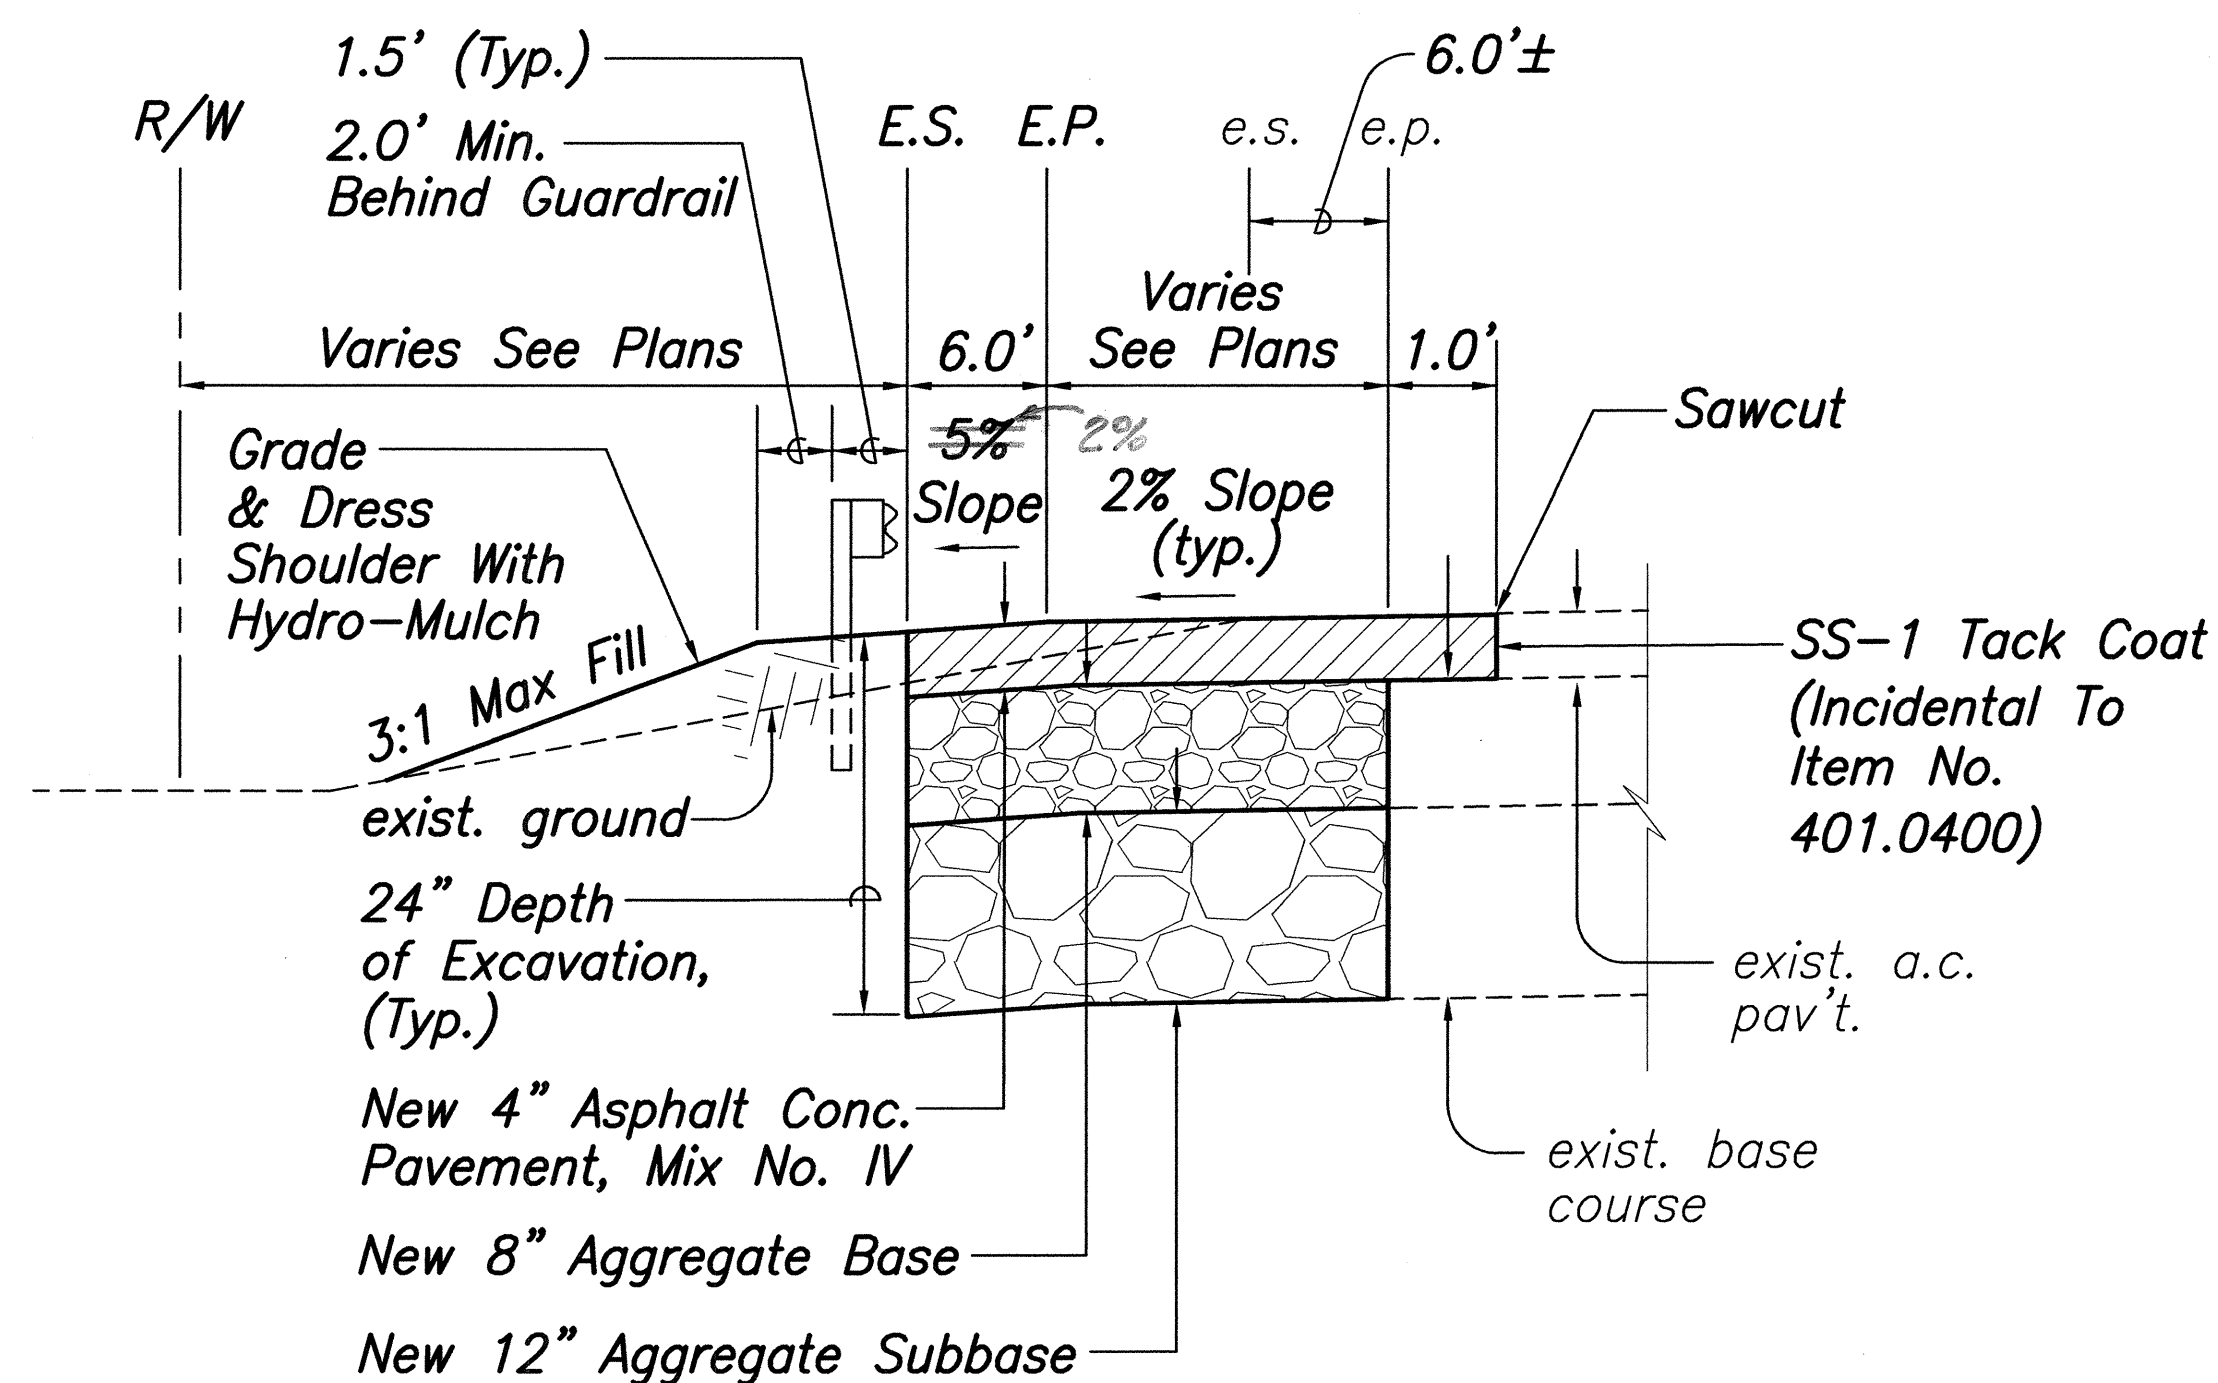


TYPICAL SECTION
AT B.L. STA. 351+14.7 TO B.L. STA. 353+13
 Not To Scale

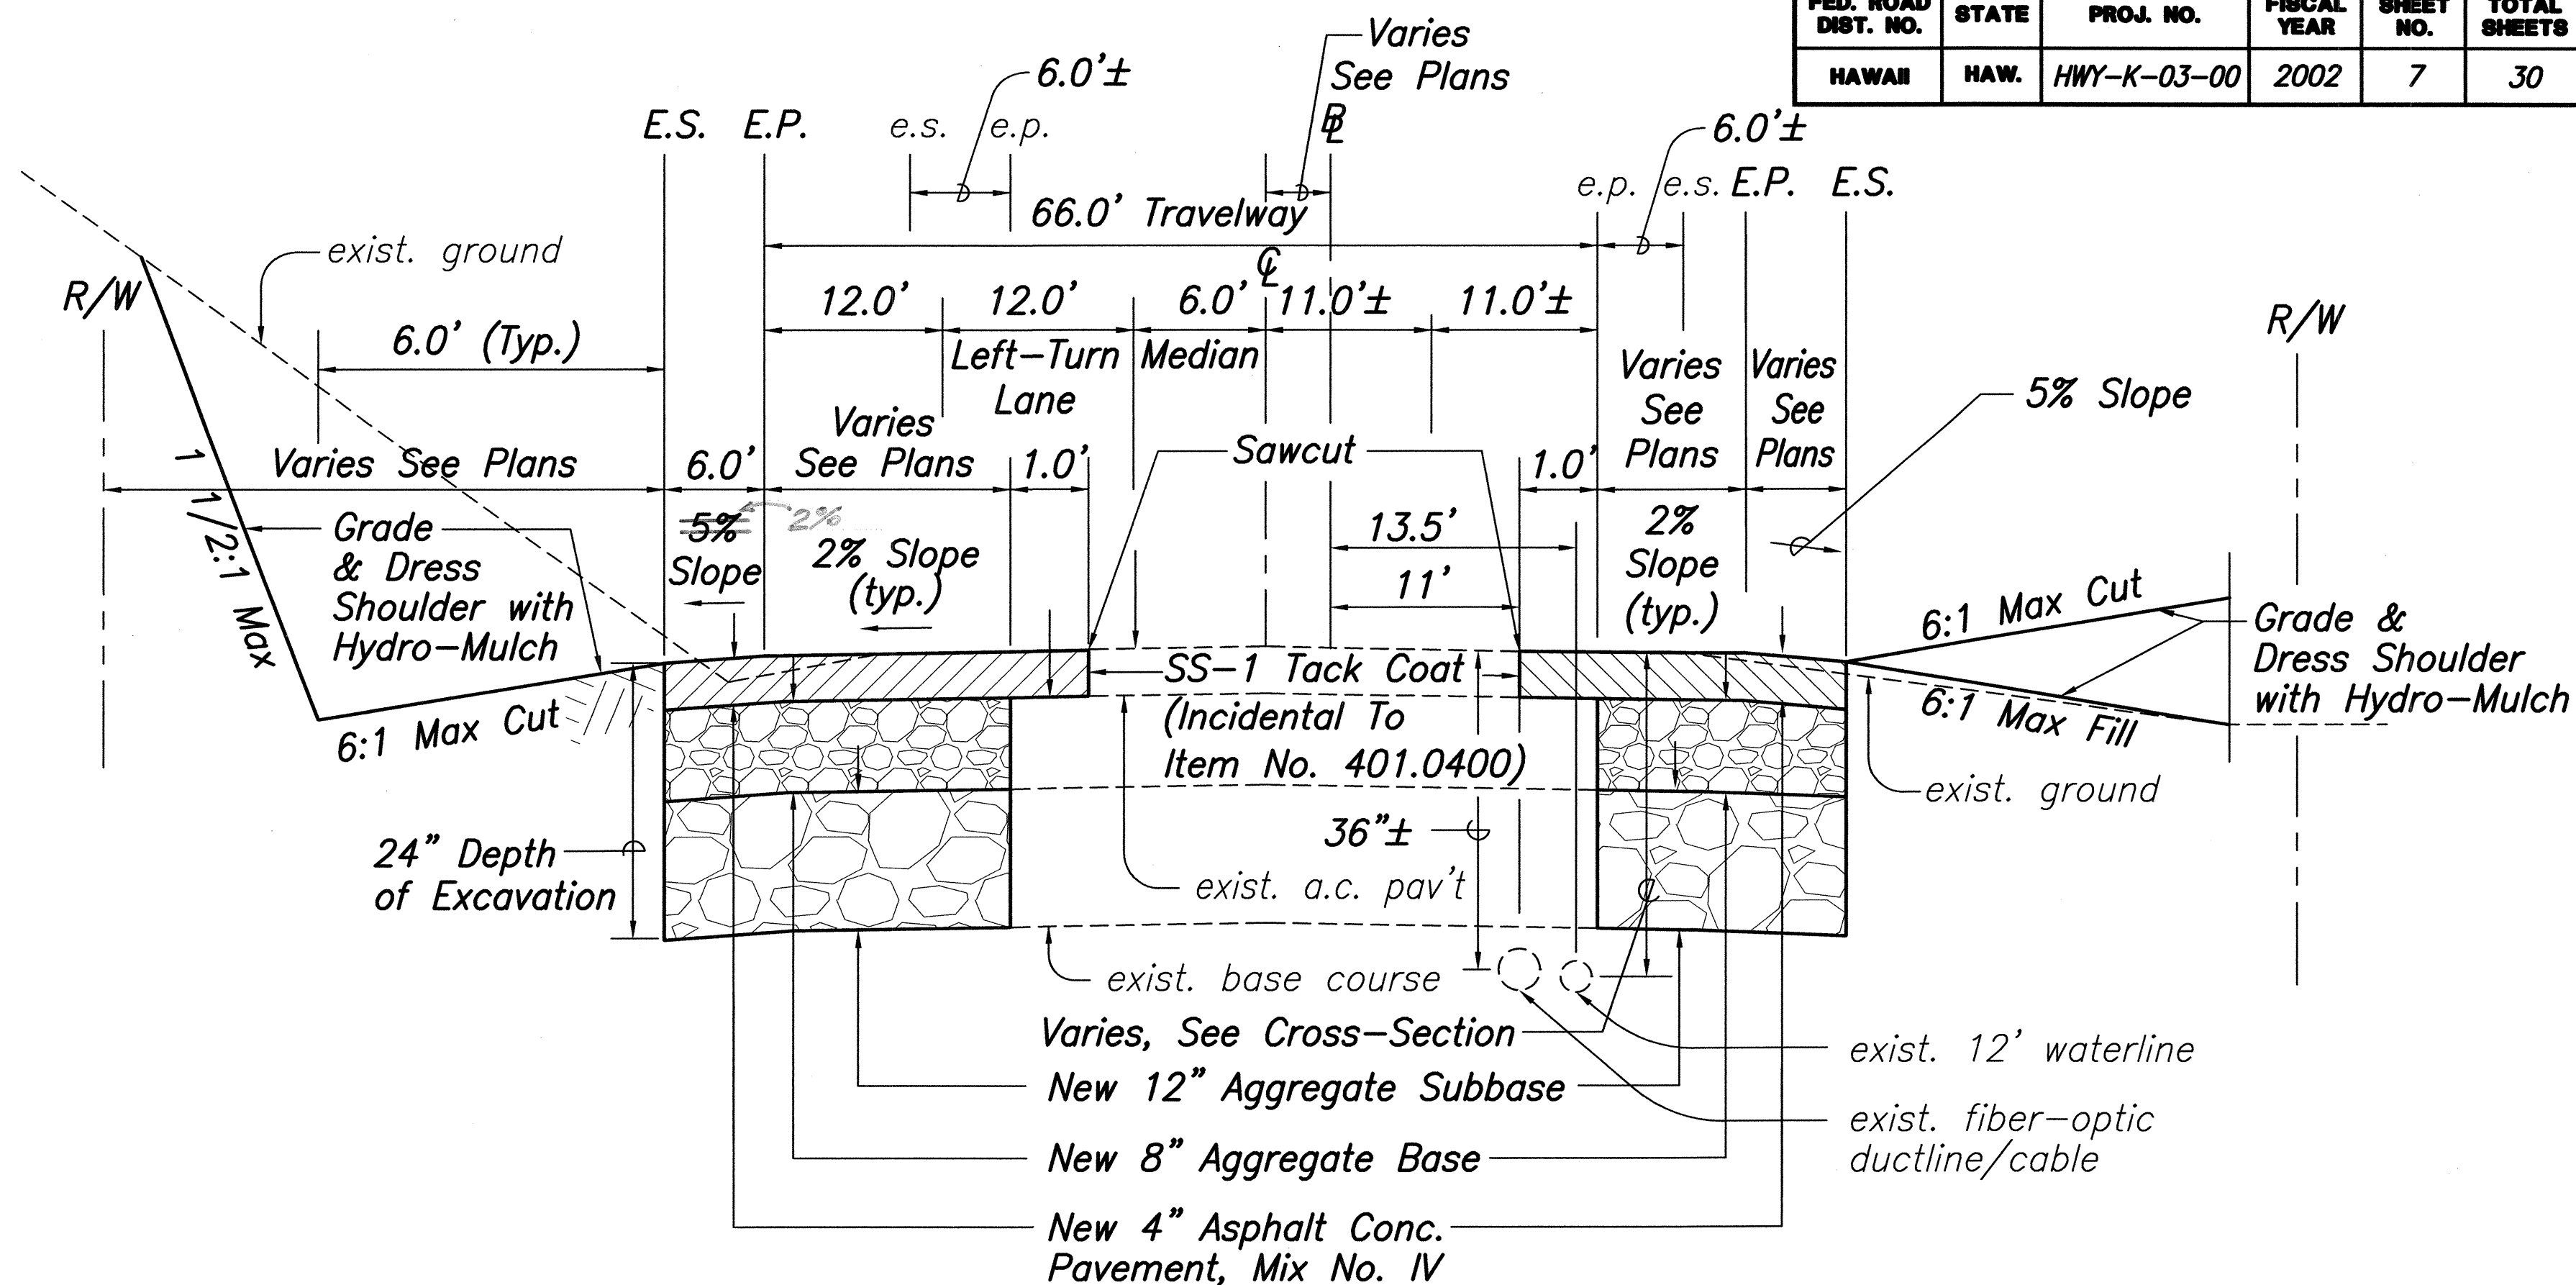

TYPICAL SECTION
AT B.L. STA. 359+35 TO B.L. STA. 360+80
 Not To Scale

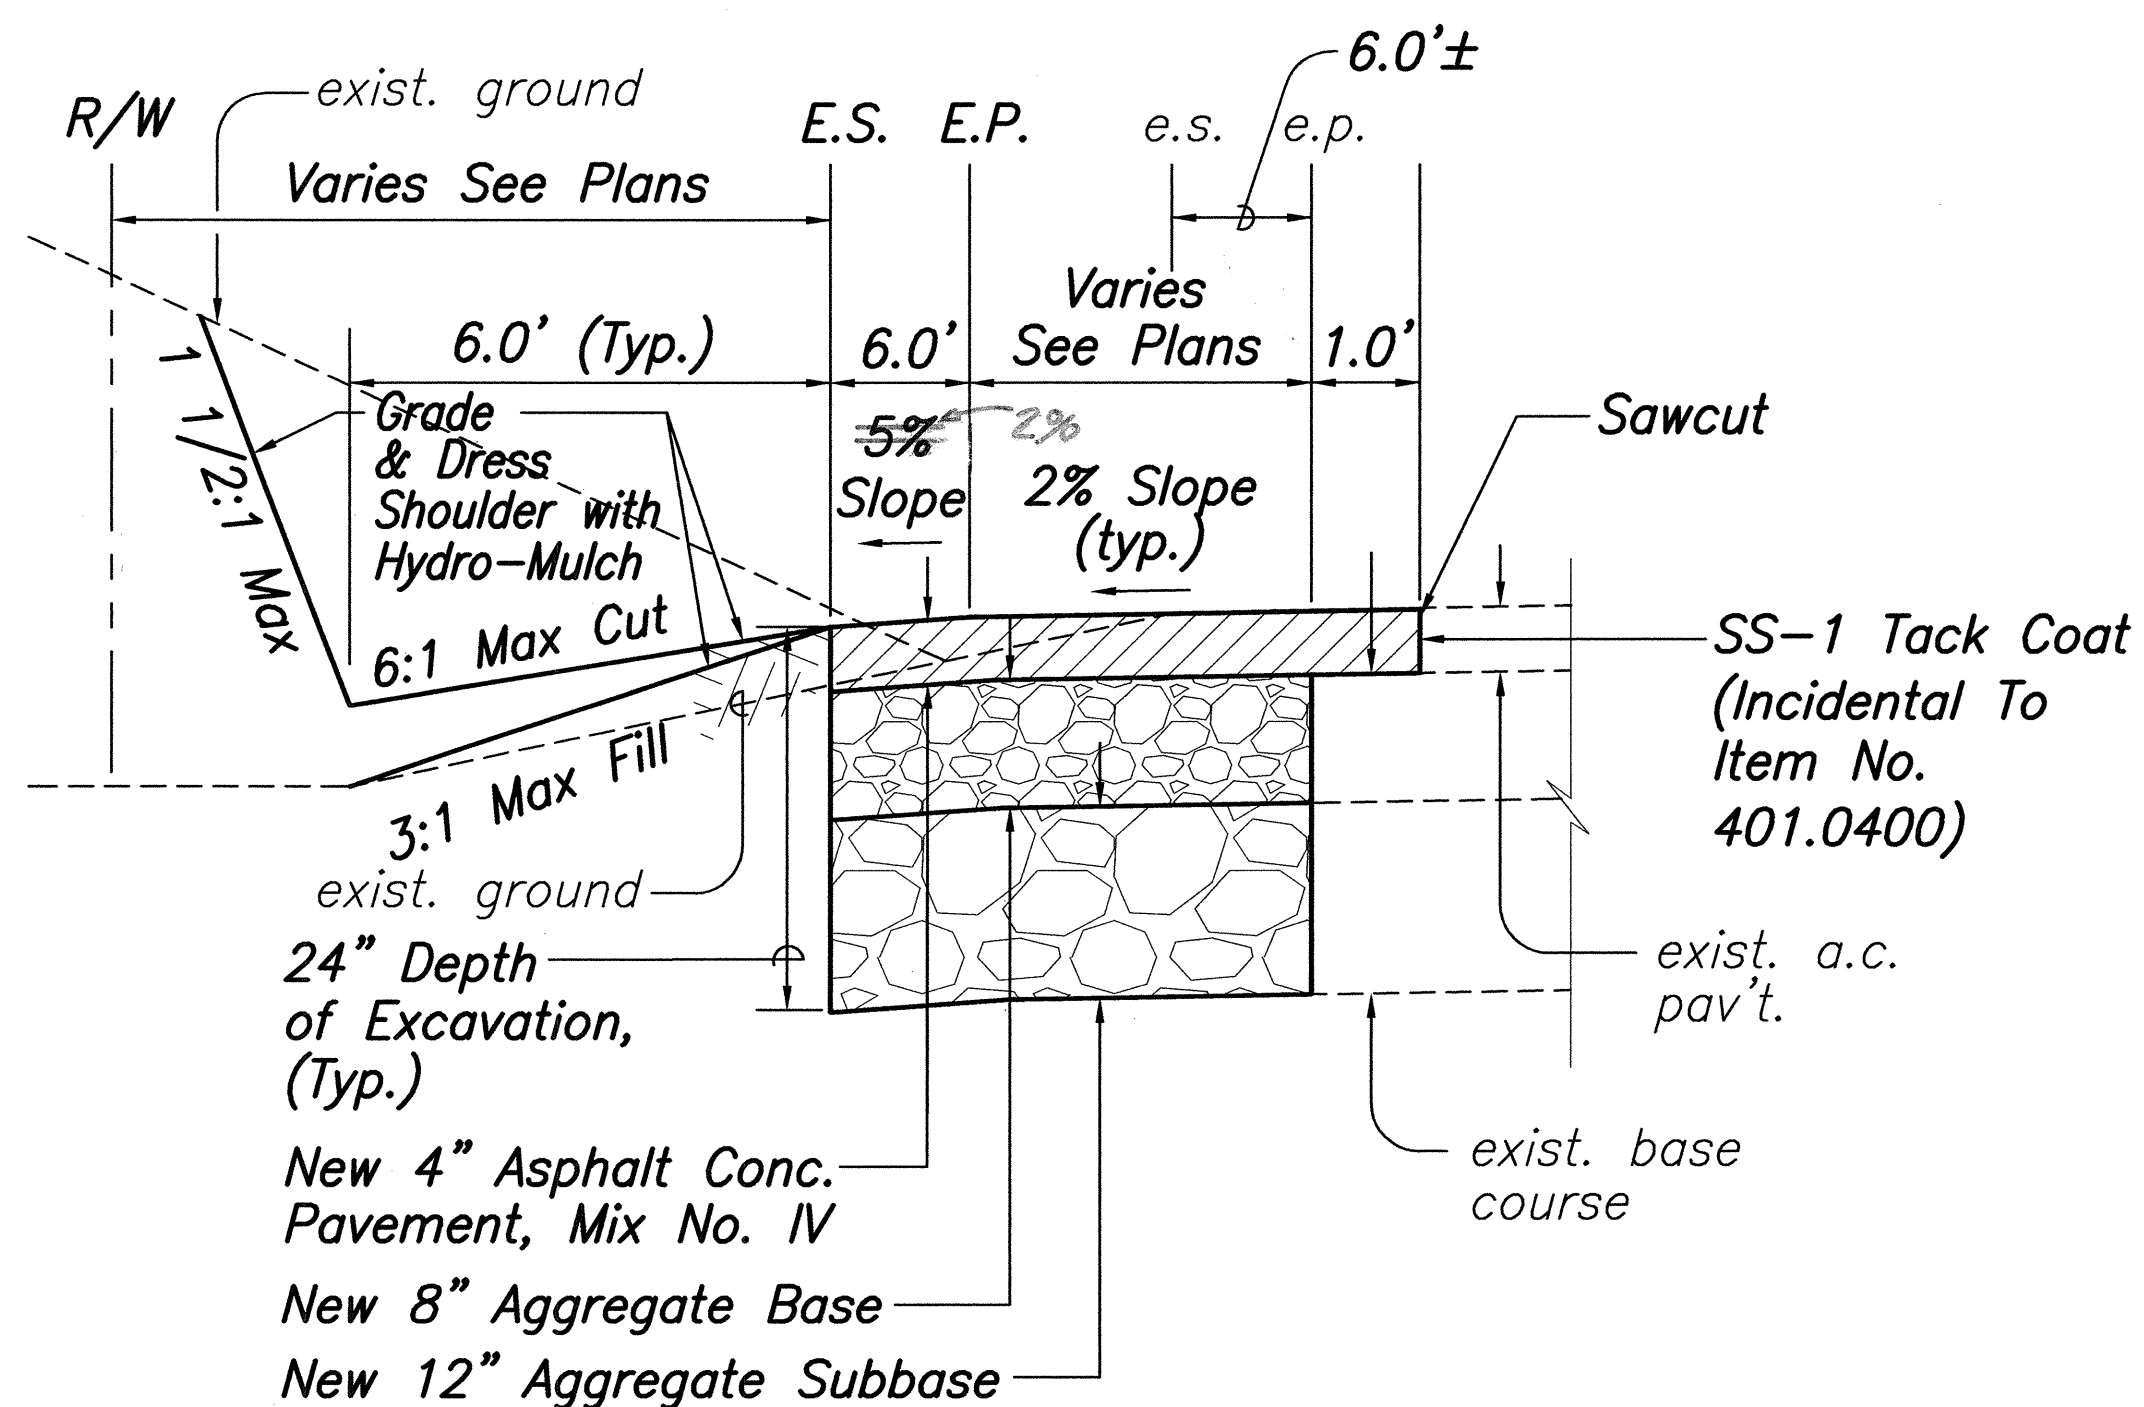

TYPICAL SECTION
AT B.L. STA. 353+13 TO B.L. STA. 356+17
AT B.L. STA. 359+00 TO B.L. STA. 359+35
AT B.L. STA. 360+80 TO B.L. STA. 363+50
AT B.L. STA. 365+50 TO B.L. STA. 368+60
 Not To Scale

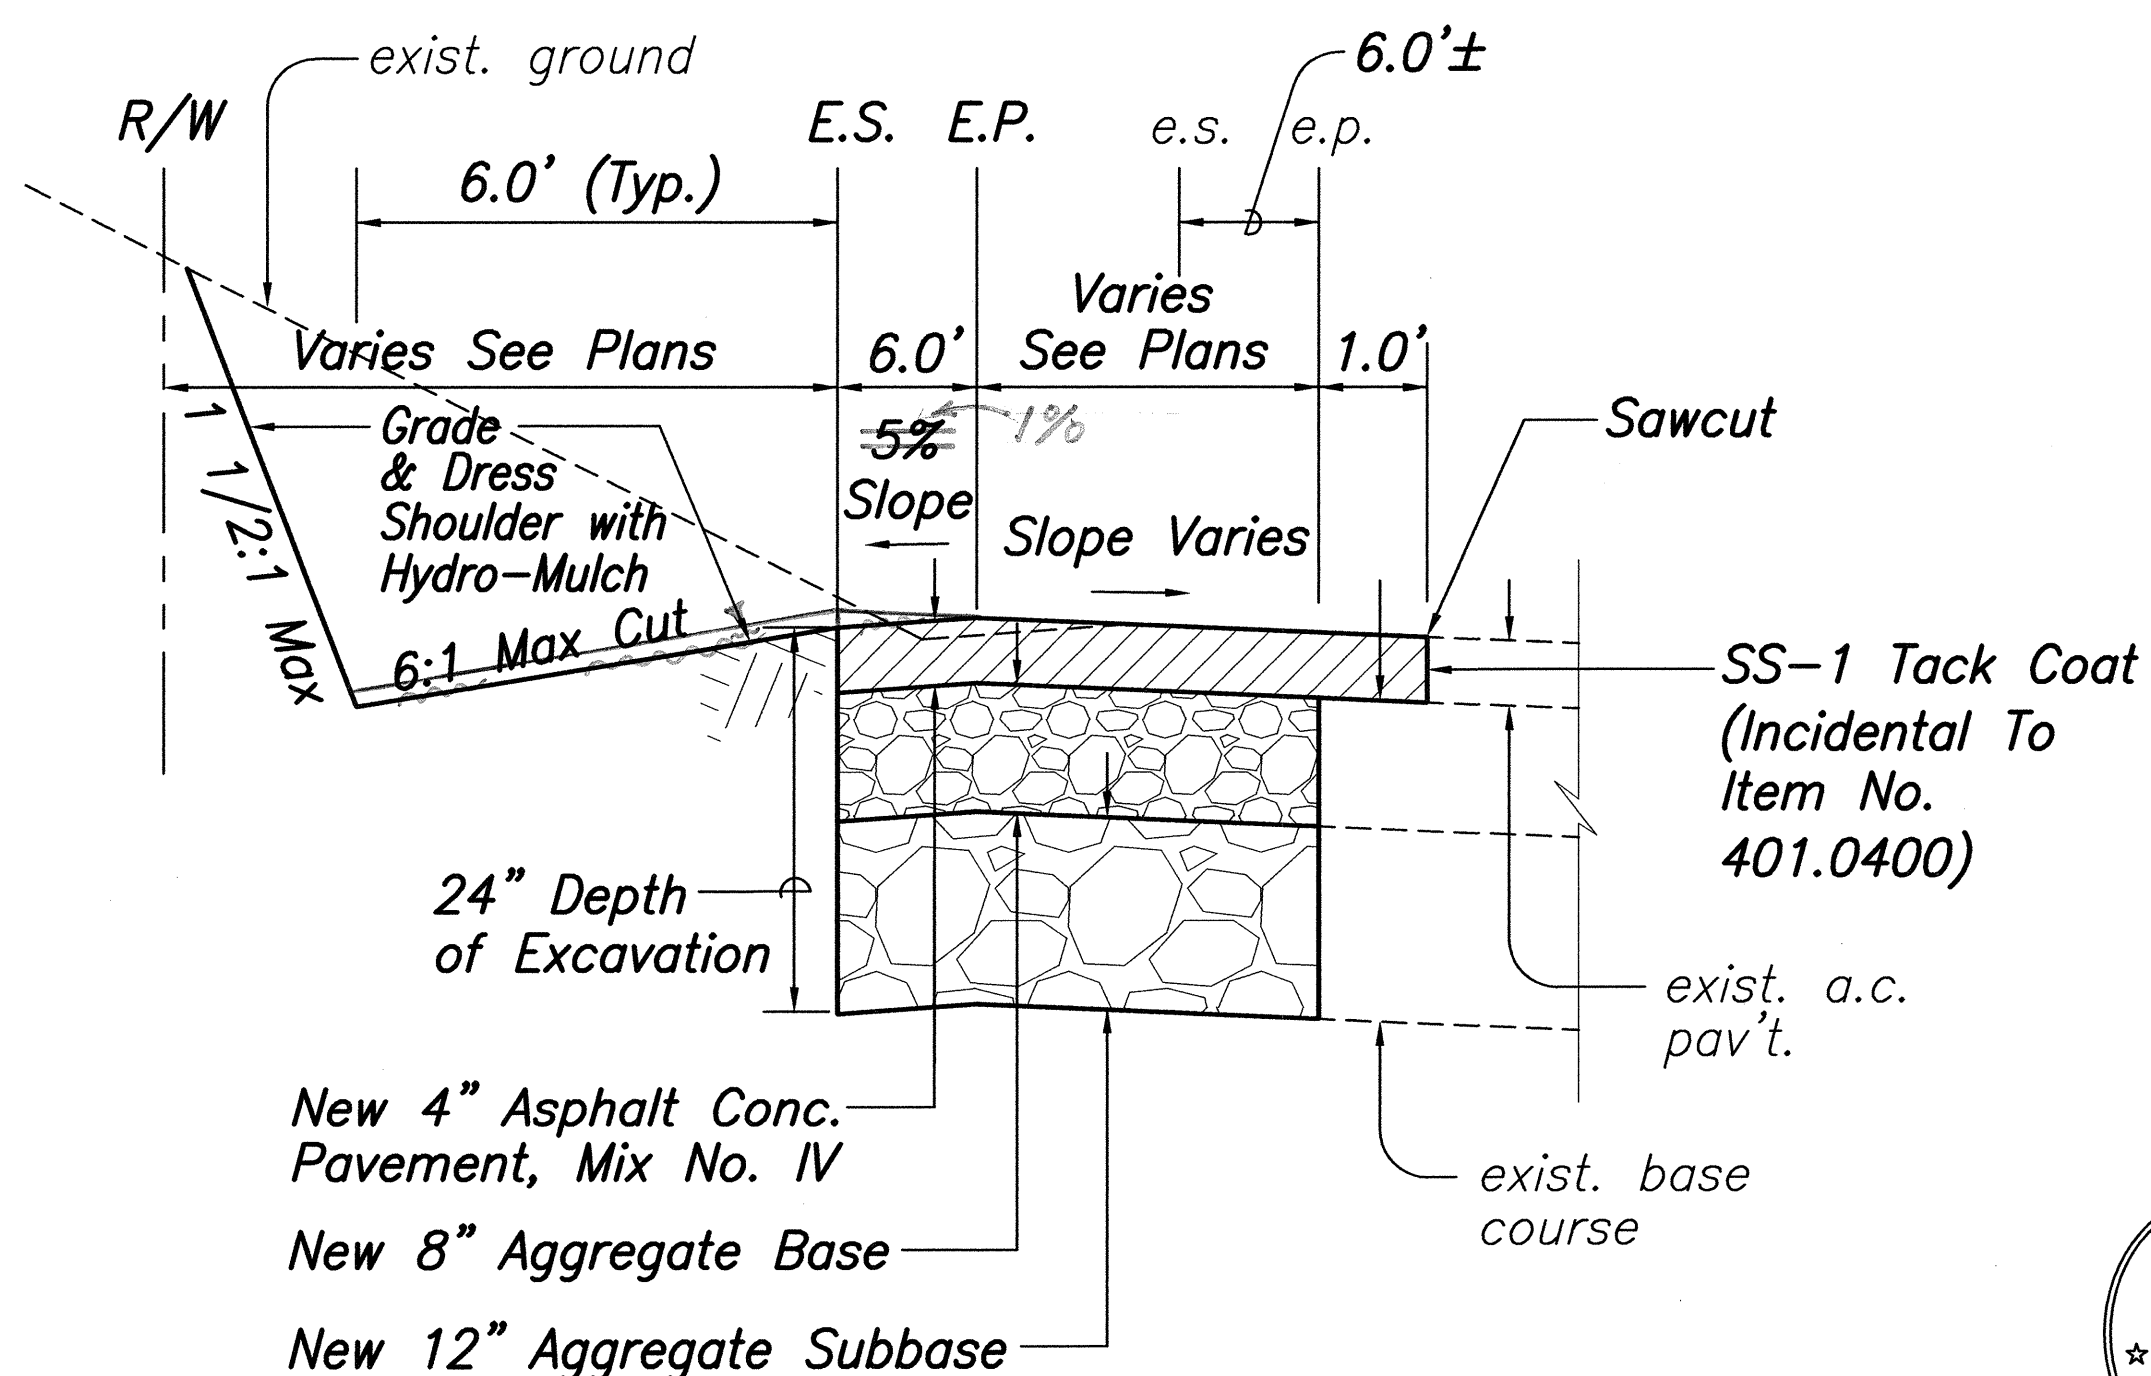

TYPICAL SECTION
AT B.L. STA. 363+50 TO B.L. STA. 365+50
 Not To Scale

Note:
 1. See Cross Section Plan
 Sheets Nos. 26-30 For
 Actual Cut And Fill Areas.

SURVEY PLOTTED BY	DATE 8/17/00
DRAWN BY	
TRACED BY	
DESIGNED BY	
QUANTITIES BY	
CHECKED BY	



THIS WORK WAS PREPARED BY ME
 OR UNDER MY SUPERVISION
 Signature: *Pete G. Pascua* 4/26/02
 Expiration Date of the License

STATE OF HAWAII
 DEPARTMENT OF TRANSPORTATION
 HIGHWAYS DIVISION

TYPICAL SECTIONS


KUHIO HIGHWAY
Intersection Improvements
at South Leho Drive
Project No. HWY-K-03-00

Scale: As Noted Date: Nov. 26, 2001

SHEET No. 1 OF 2 SHEETS


"AS-BUILT"

FED. ROAD DIST. NO.	STATE	PROJ. NO.	FISCAL YEAR	SHEET NO.	TOTAL SHEETS
HAWAII	HAW.	HWY-K-03-00	2002	8	30


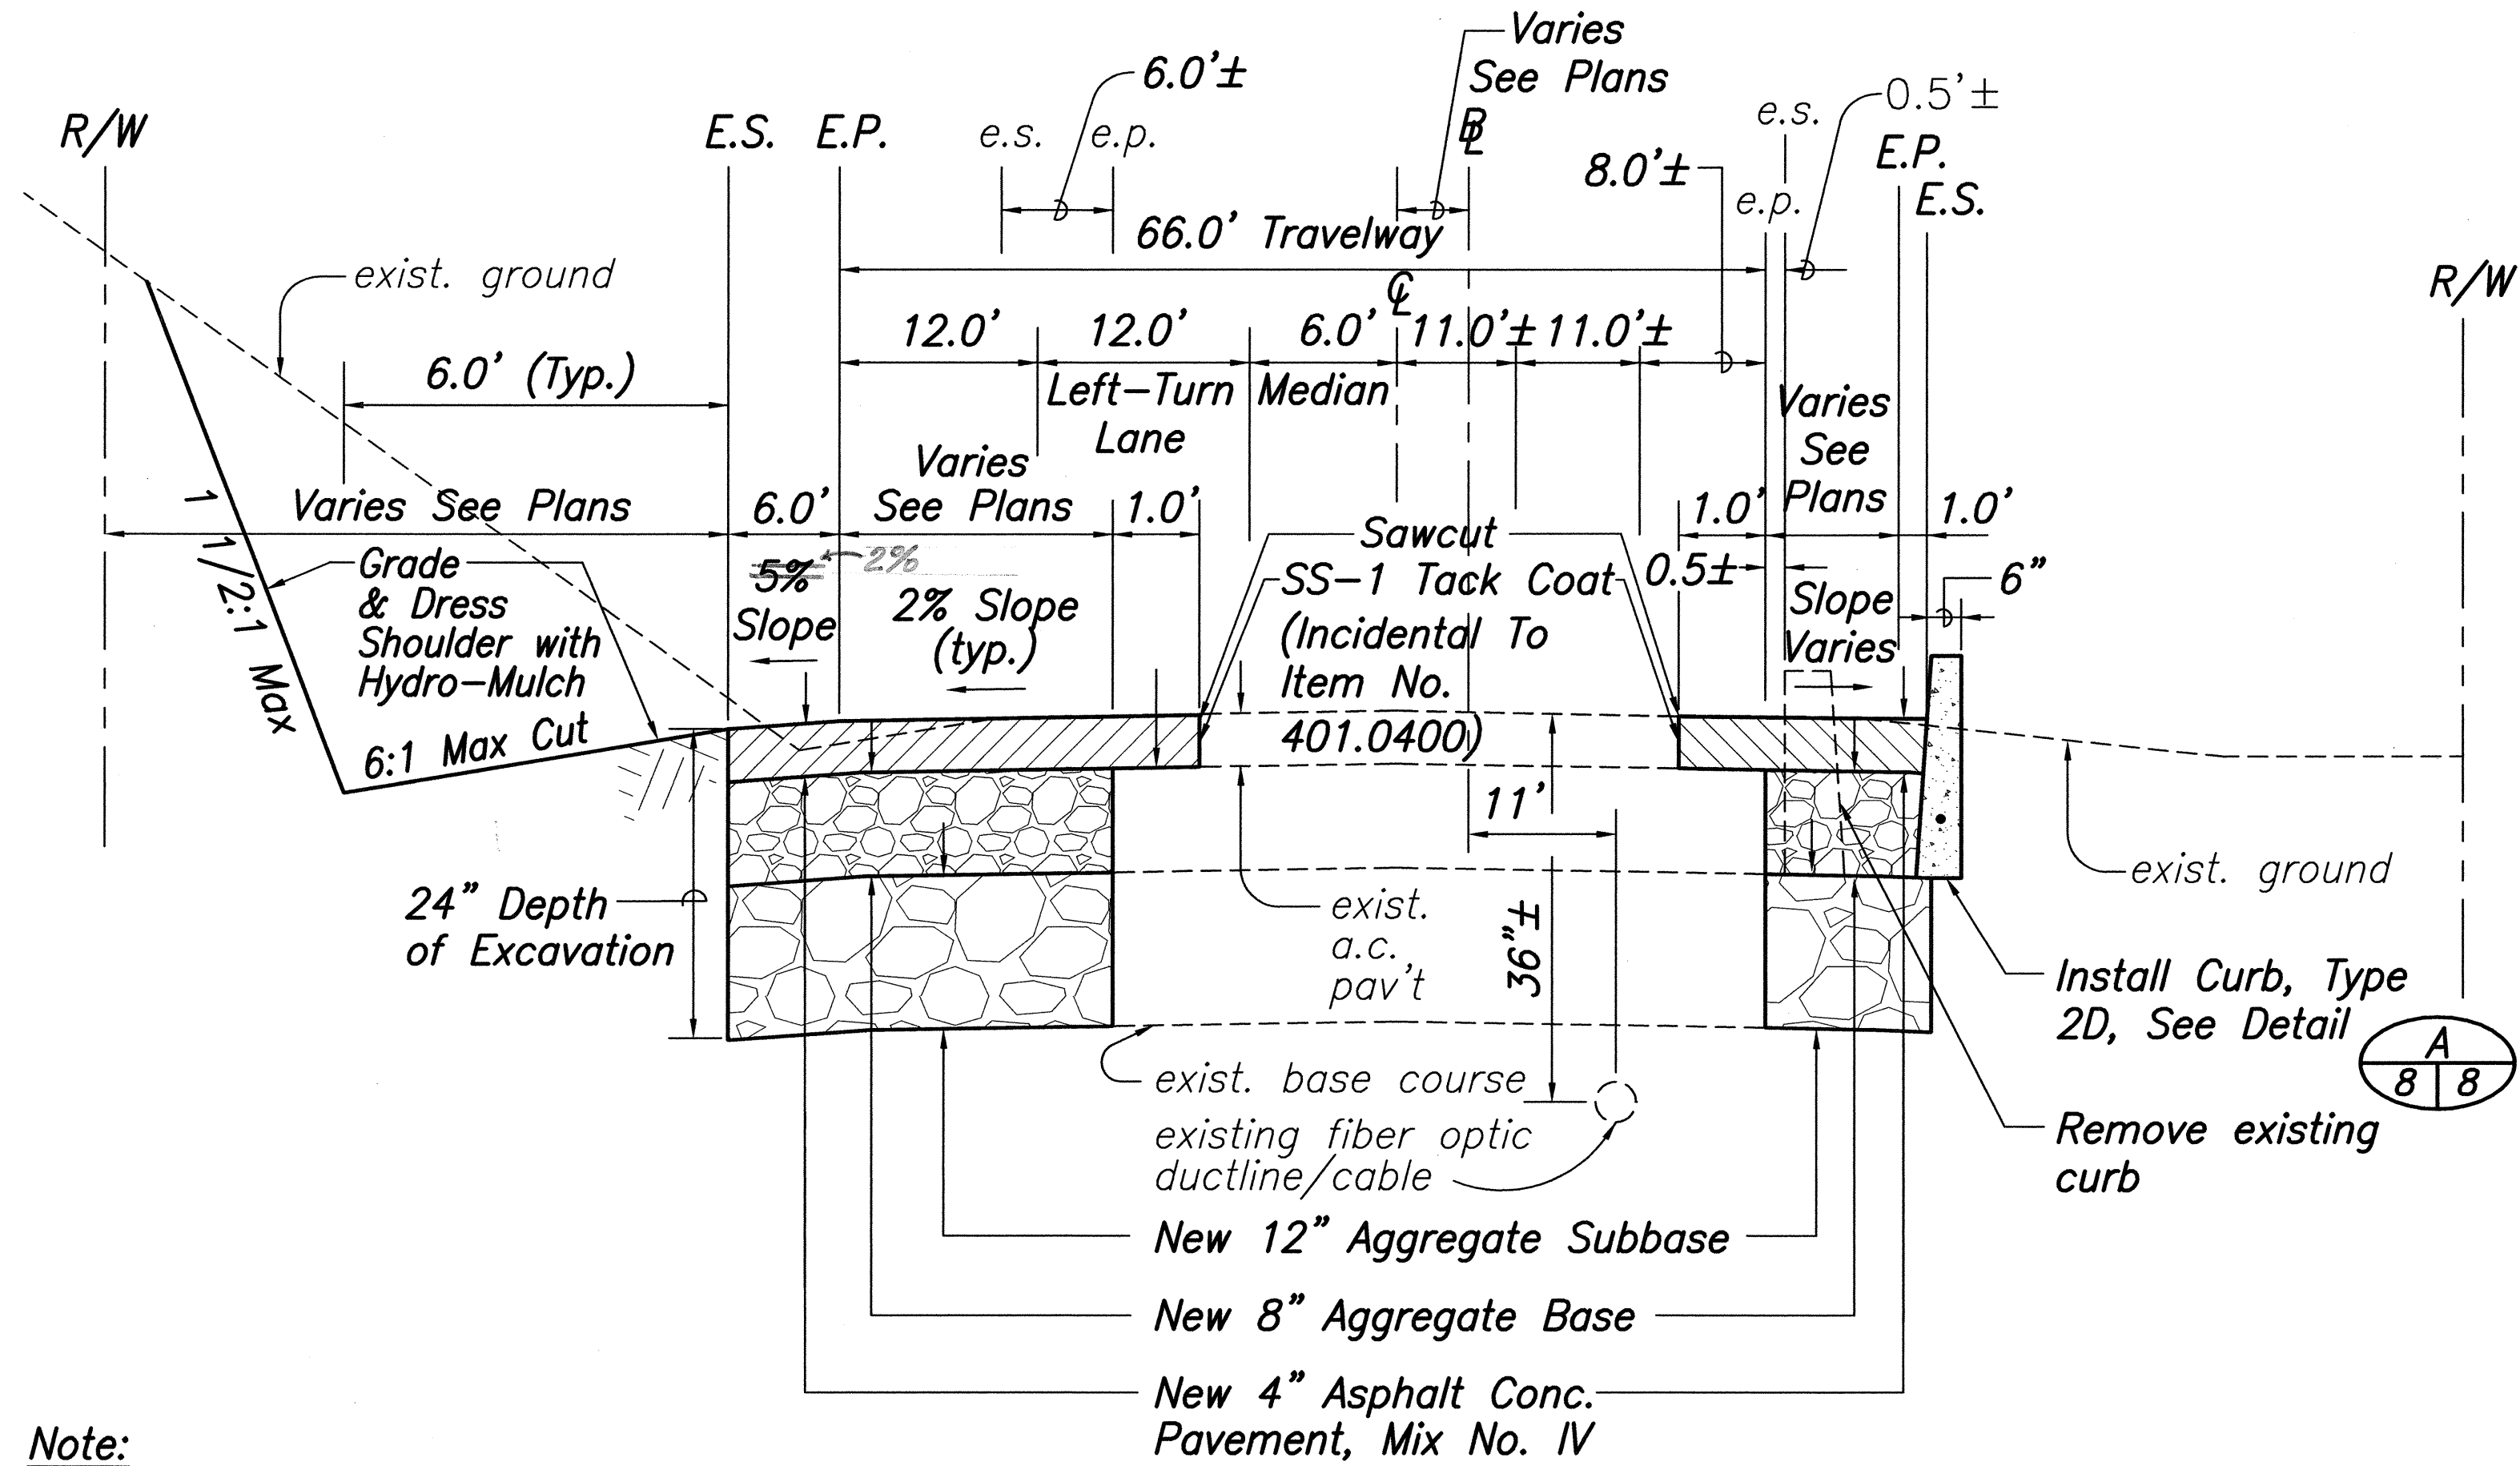


- Note:
- See Cross Section Plan Sheet Nos. 26-30 for actual cut and fill areas.


TYPICAL SECTION
AT B.L. STA. 356+17 TO B.L. STA. 359+00
Not To Scale

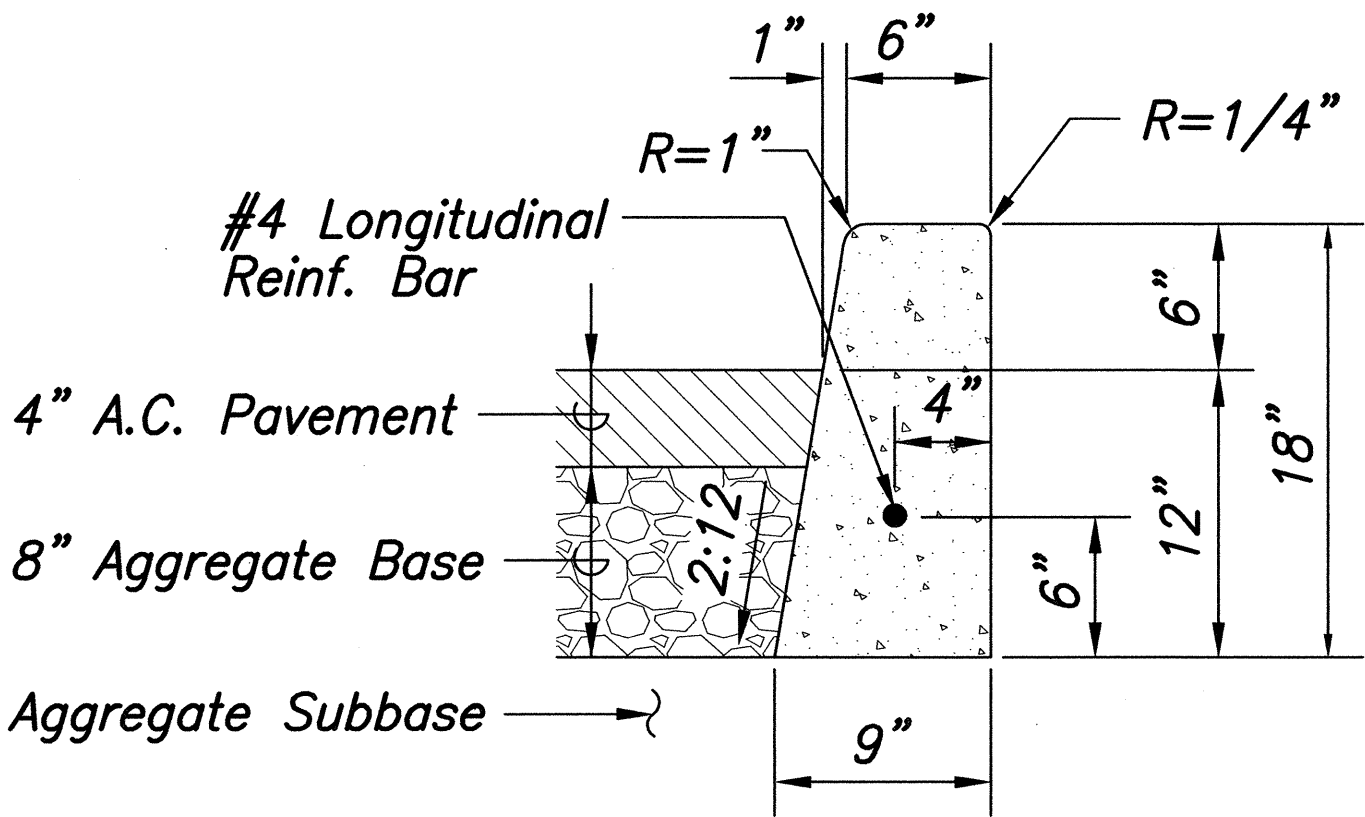

DETAIL - CURB, TYPE 2D
Not To Scale

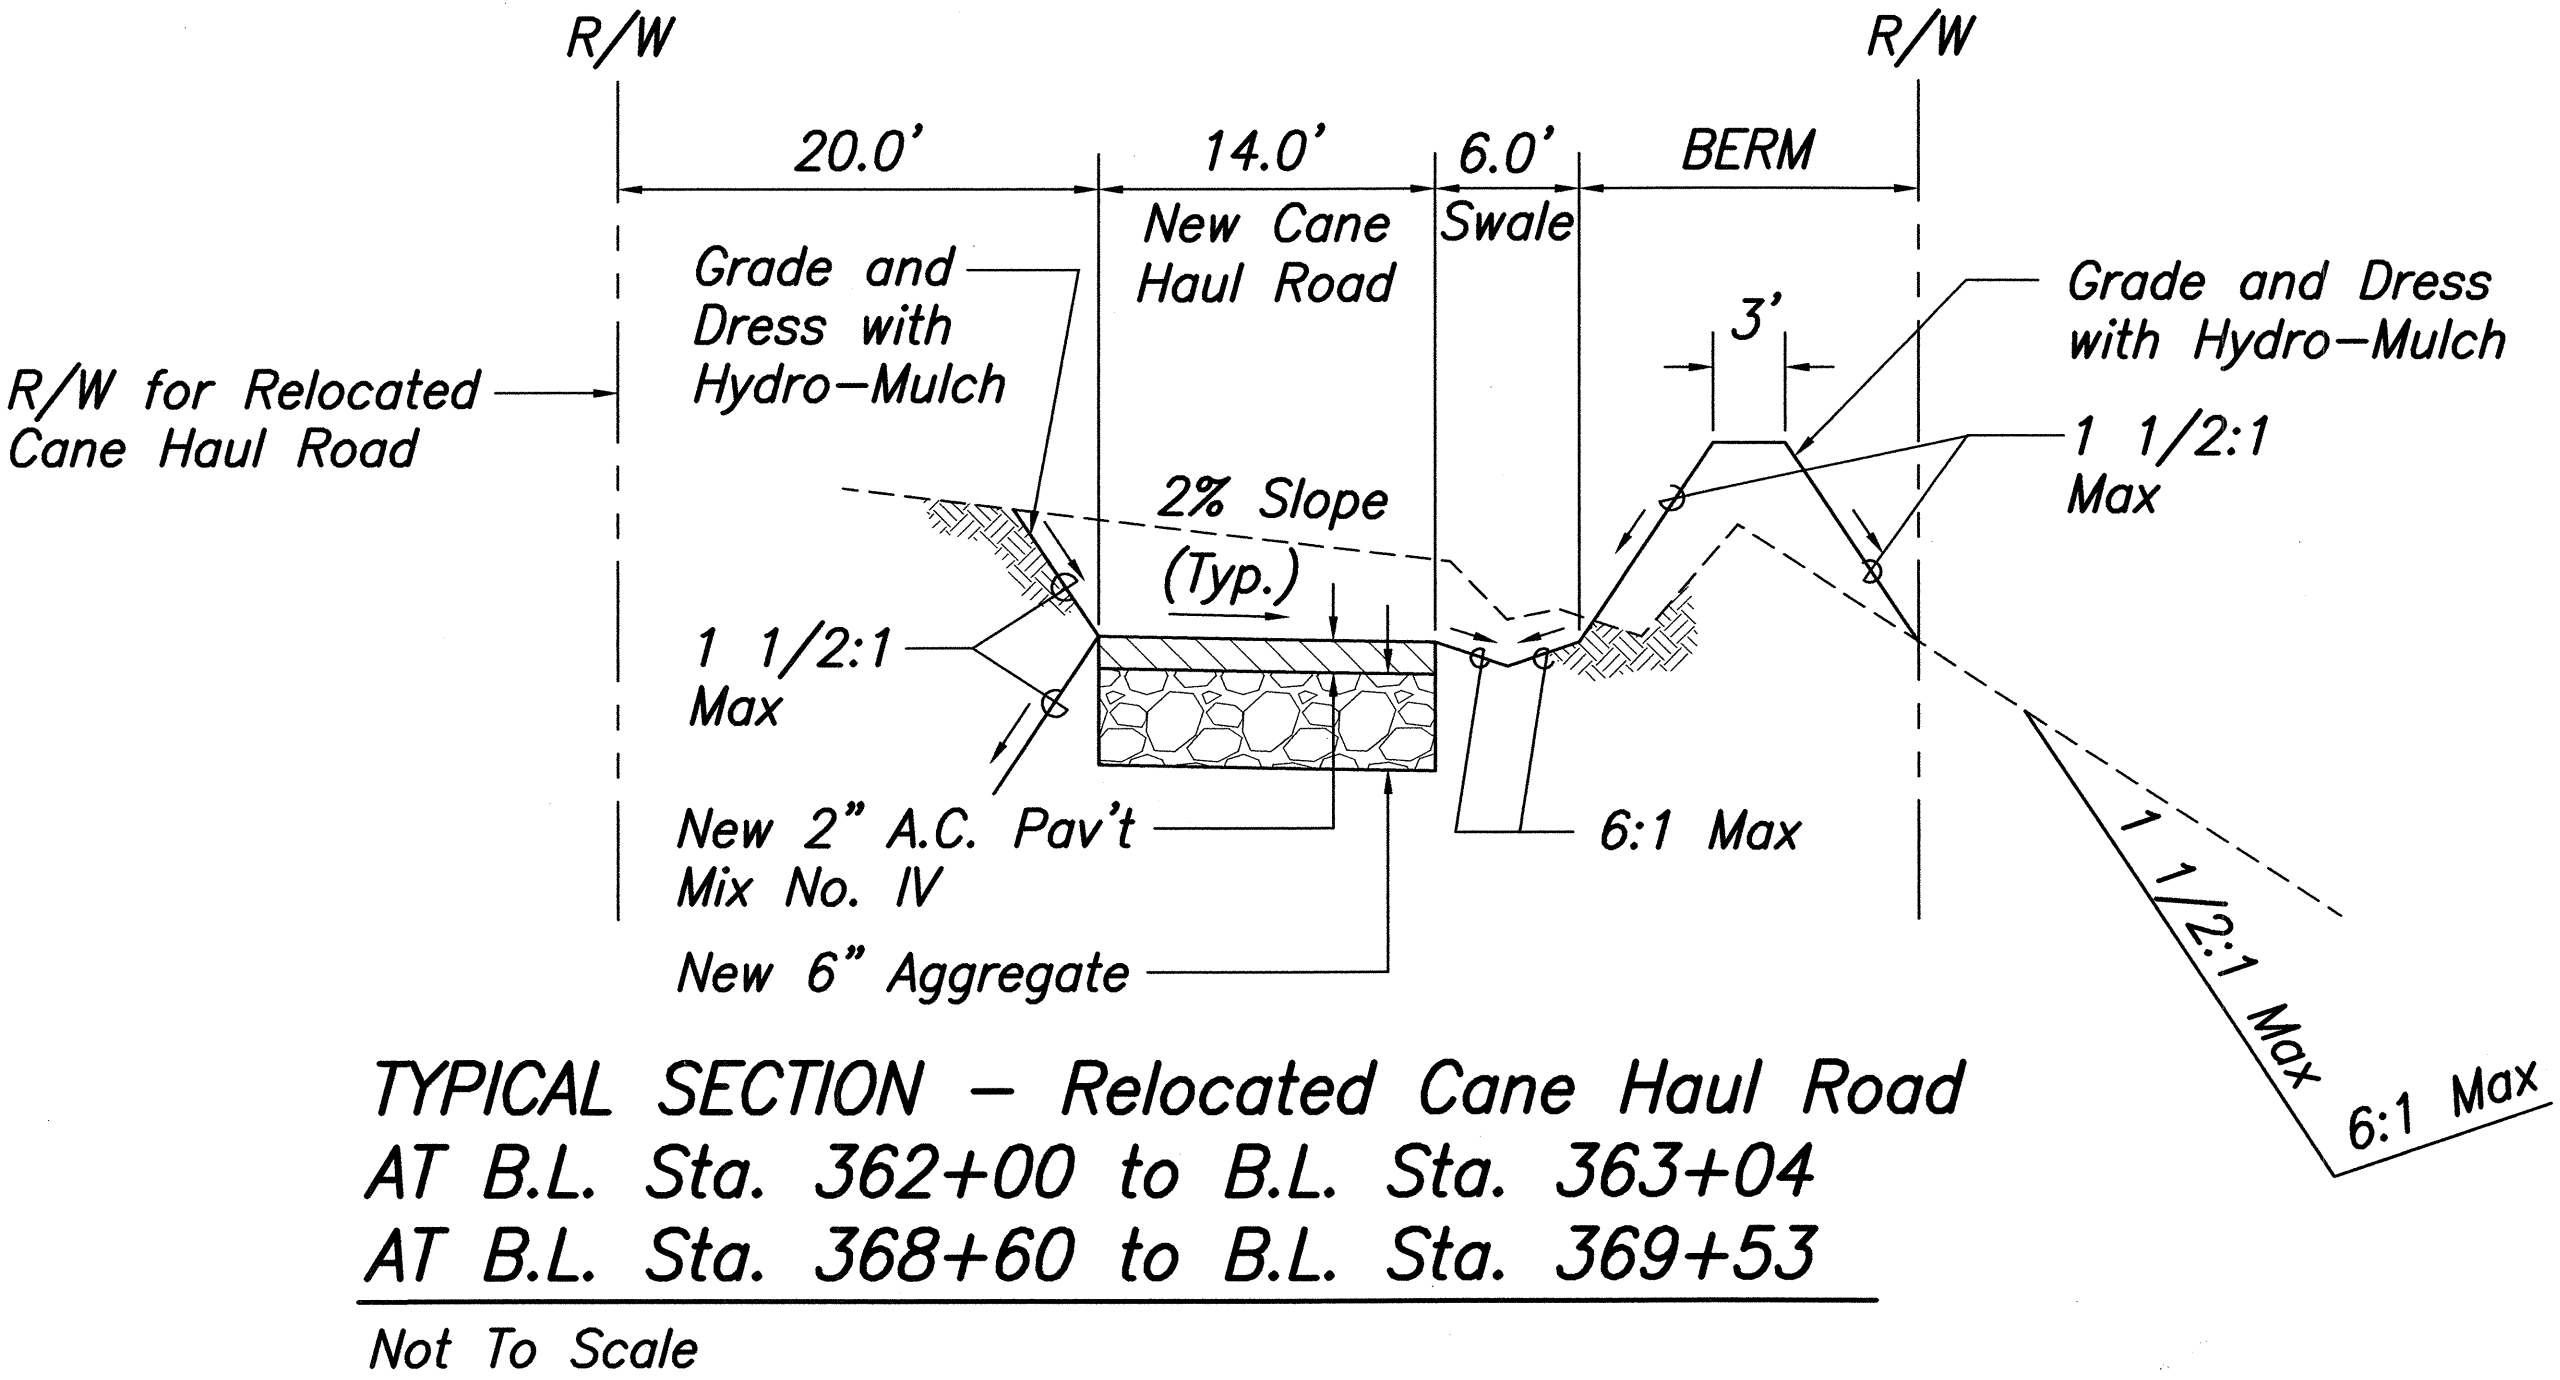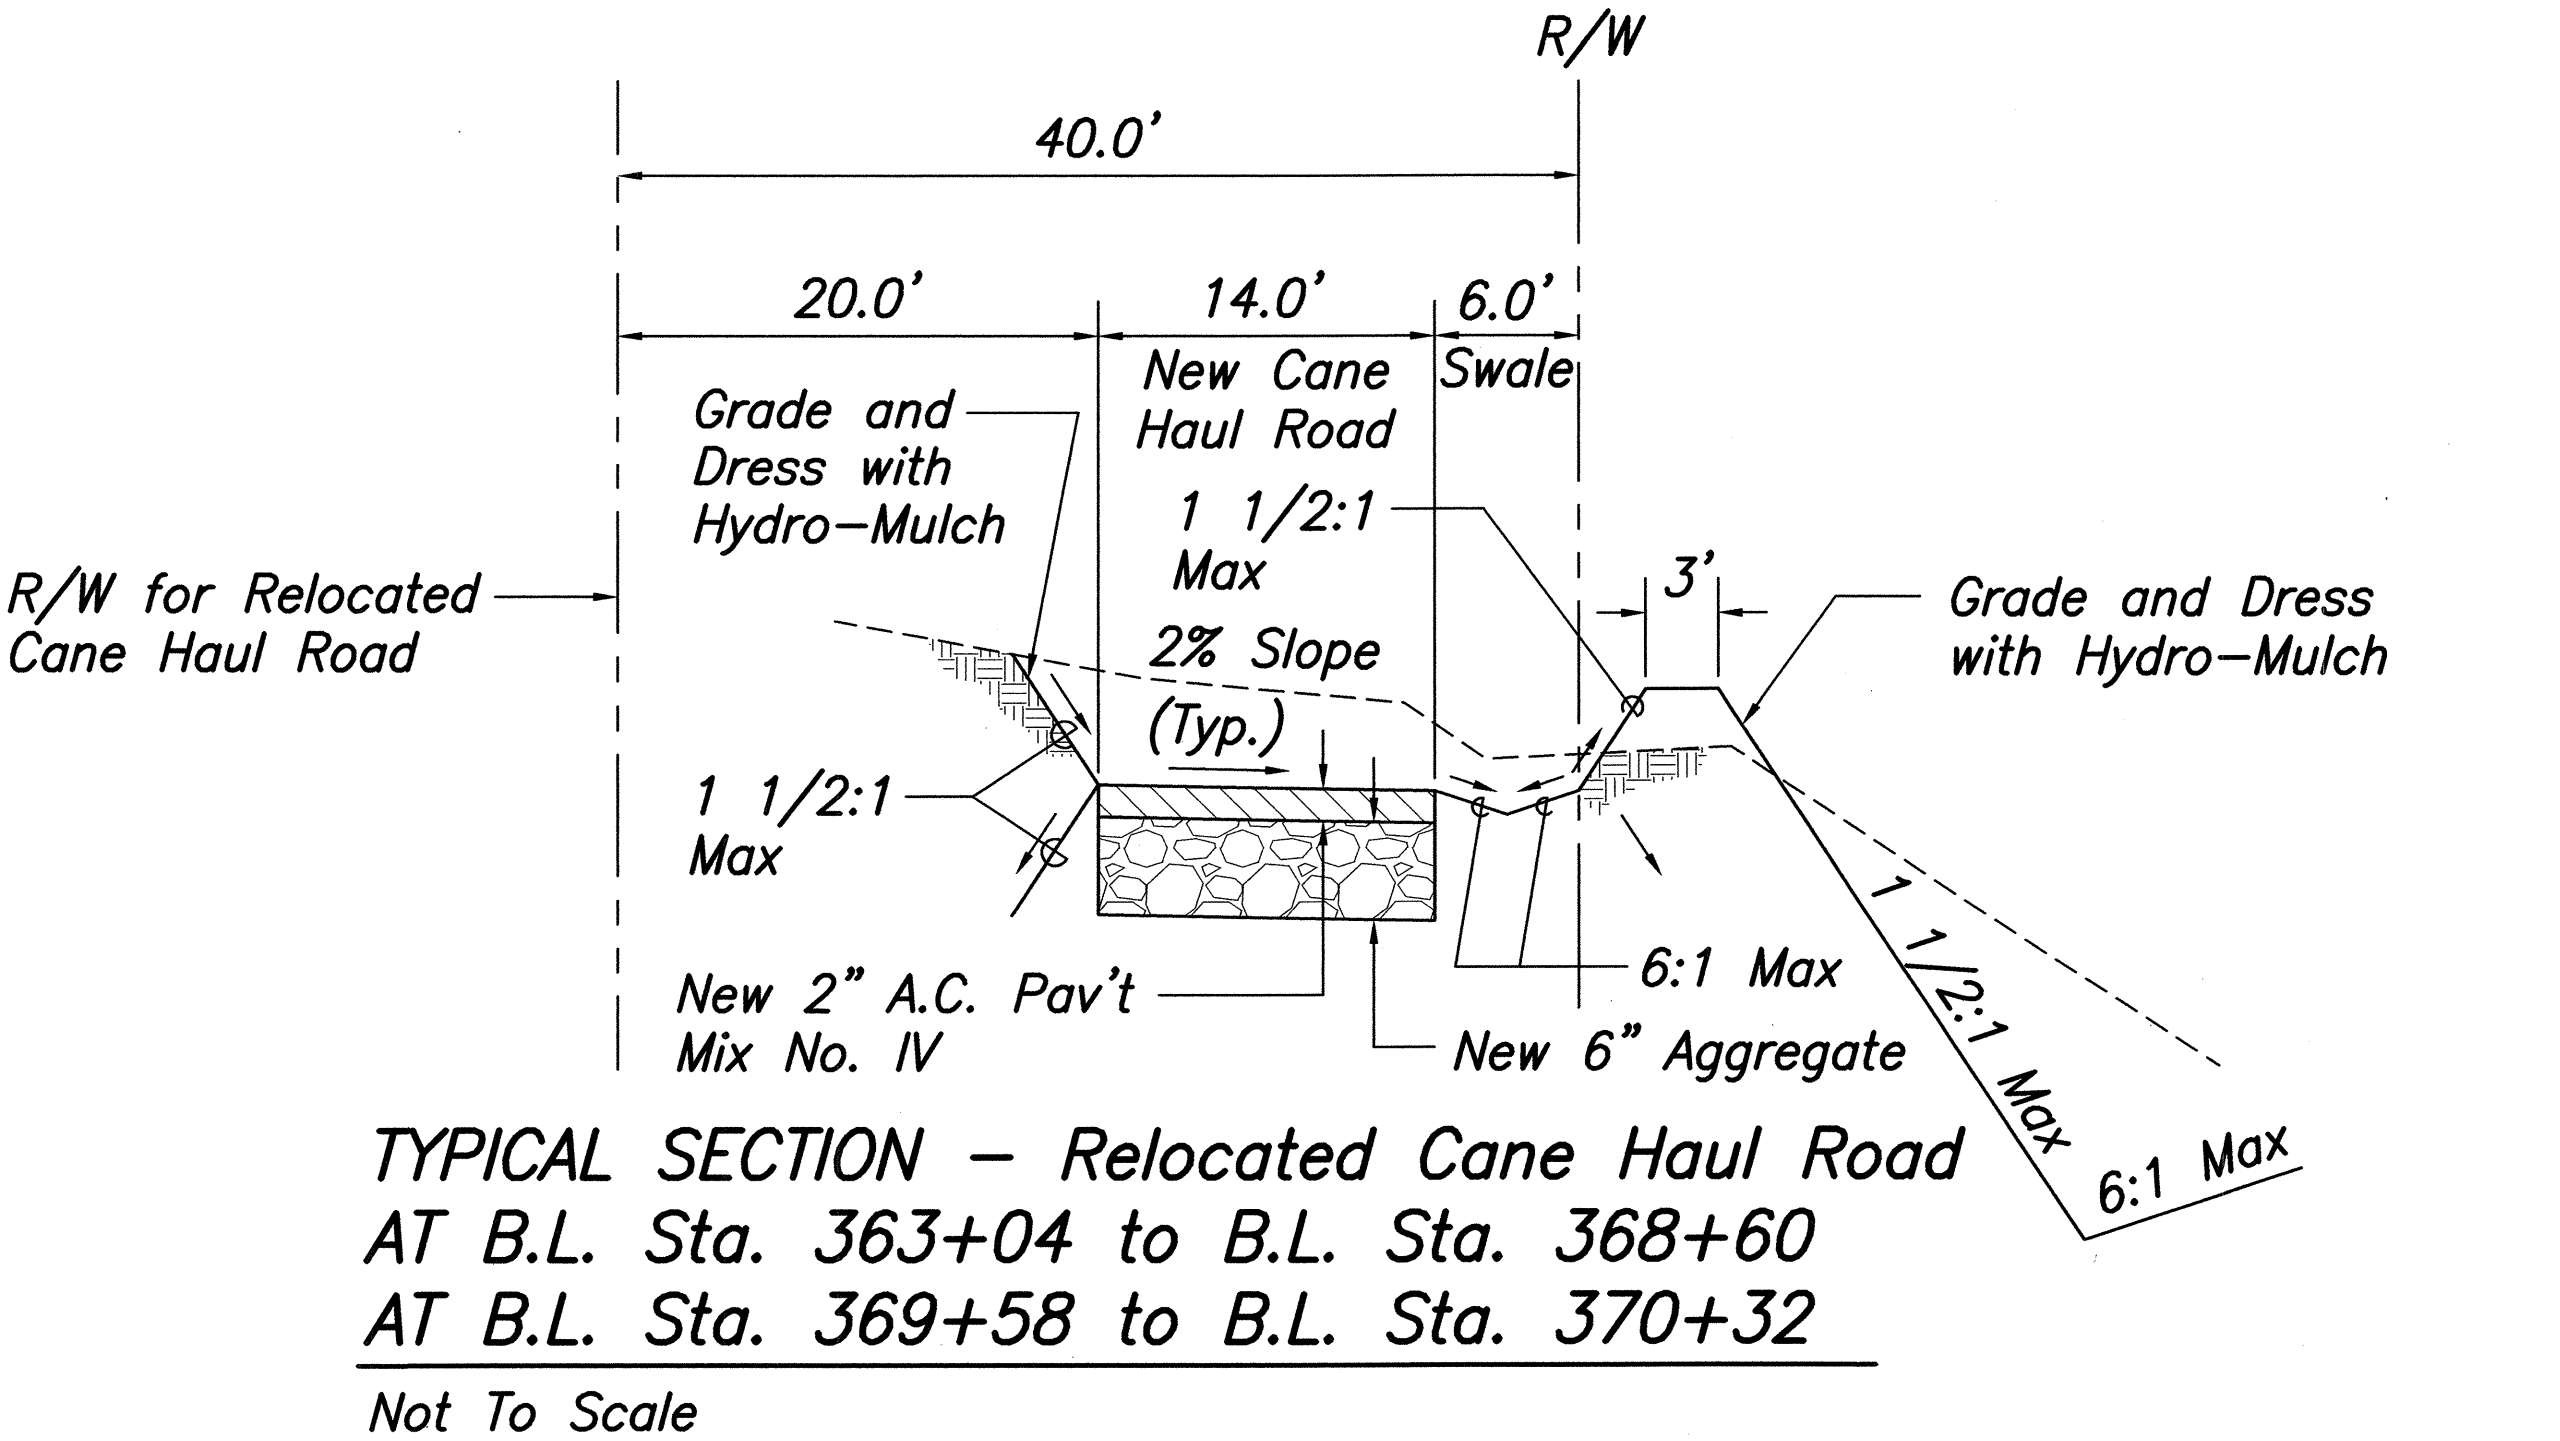

SURVEY PLOTTED BY	DATE 8/17/01
DRAWN BY	
DESIGNED BY	
QUANTITIES BY	
CHECKED BY	

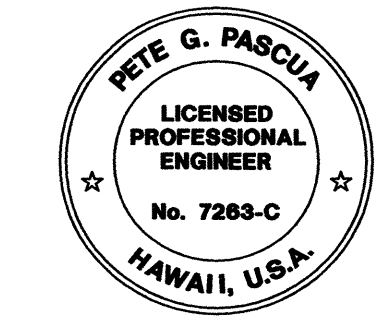

THIS WORK WAS PREPARED BY ME
OR UNDER MY SUPERVISION
Signature: *Pete G. Pasqua* 4/30/02
Expiration Date of the License

STATE OF HAWAII
DEPARTMENT OF TRANSPORTATION
HIGHWAYS DIVISION

TYPICAL SECTIONS

KUHIO HIGHWAY
Intersection Improvements
at South Leho Drive
Project No. HWY-K-03-00

Scale: As Noted Date: Nov. 26, 2001

SHEET No. 2 OF 2 SHEETS

"AS-BUILT"