


FED. ROAD DIST. NO.	STATE	PROJ. NO.	FISCAL YEAR	SHEET NO.	TOTAL SHEETS
HAWAII	HAW.	56A-01-00M	2003	9	42


CURVE	(1)	(2)
Δ	34°13'30"	6°34'30"
$\Delta/2$	17°06'45"	3°17'15"
R	500.00	3500.00
T	153.94	201.04
C	294.25	401.42
Lc	298.67	401.64

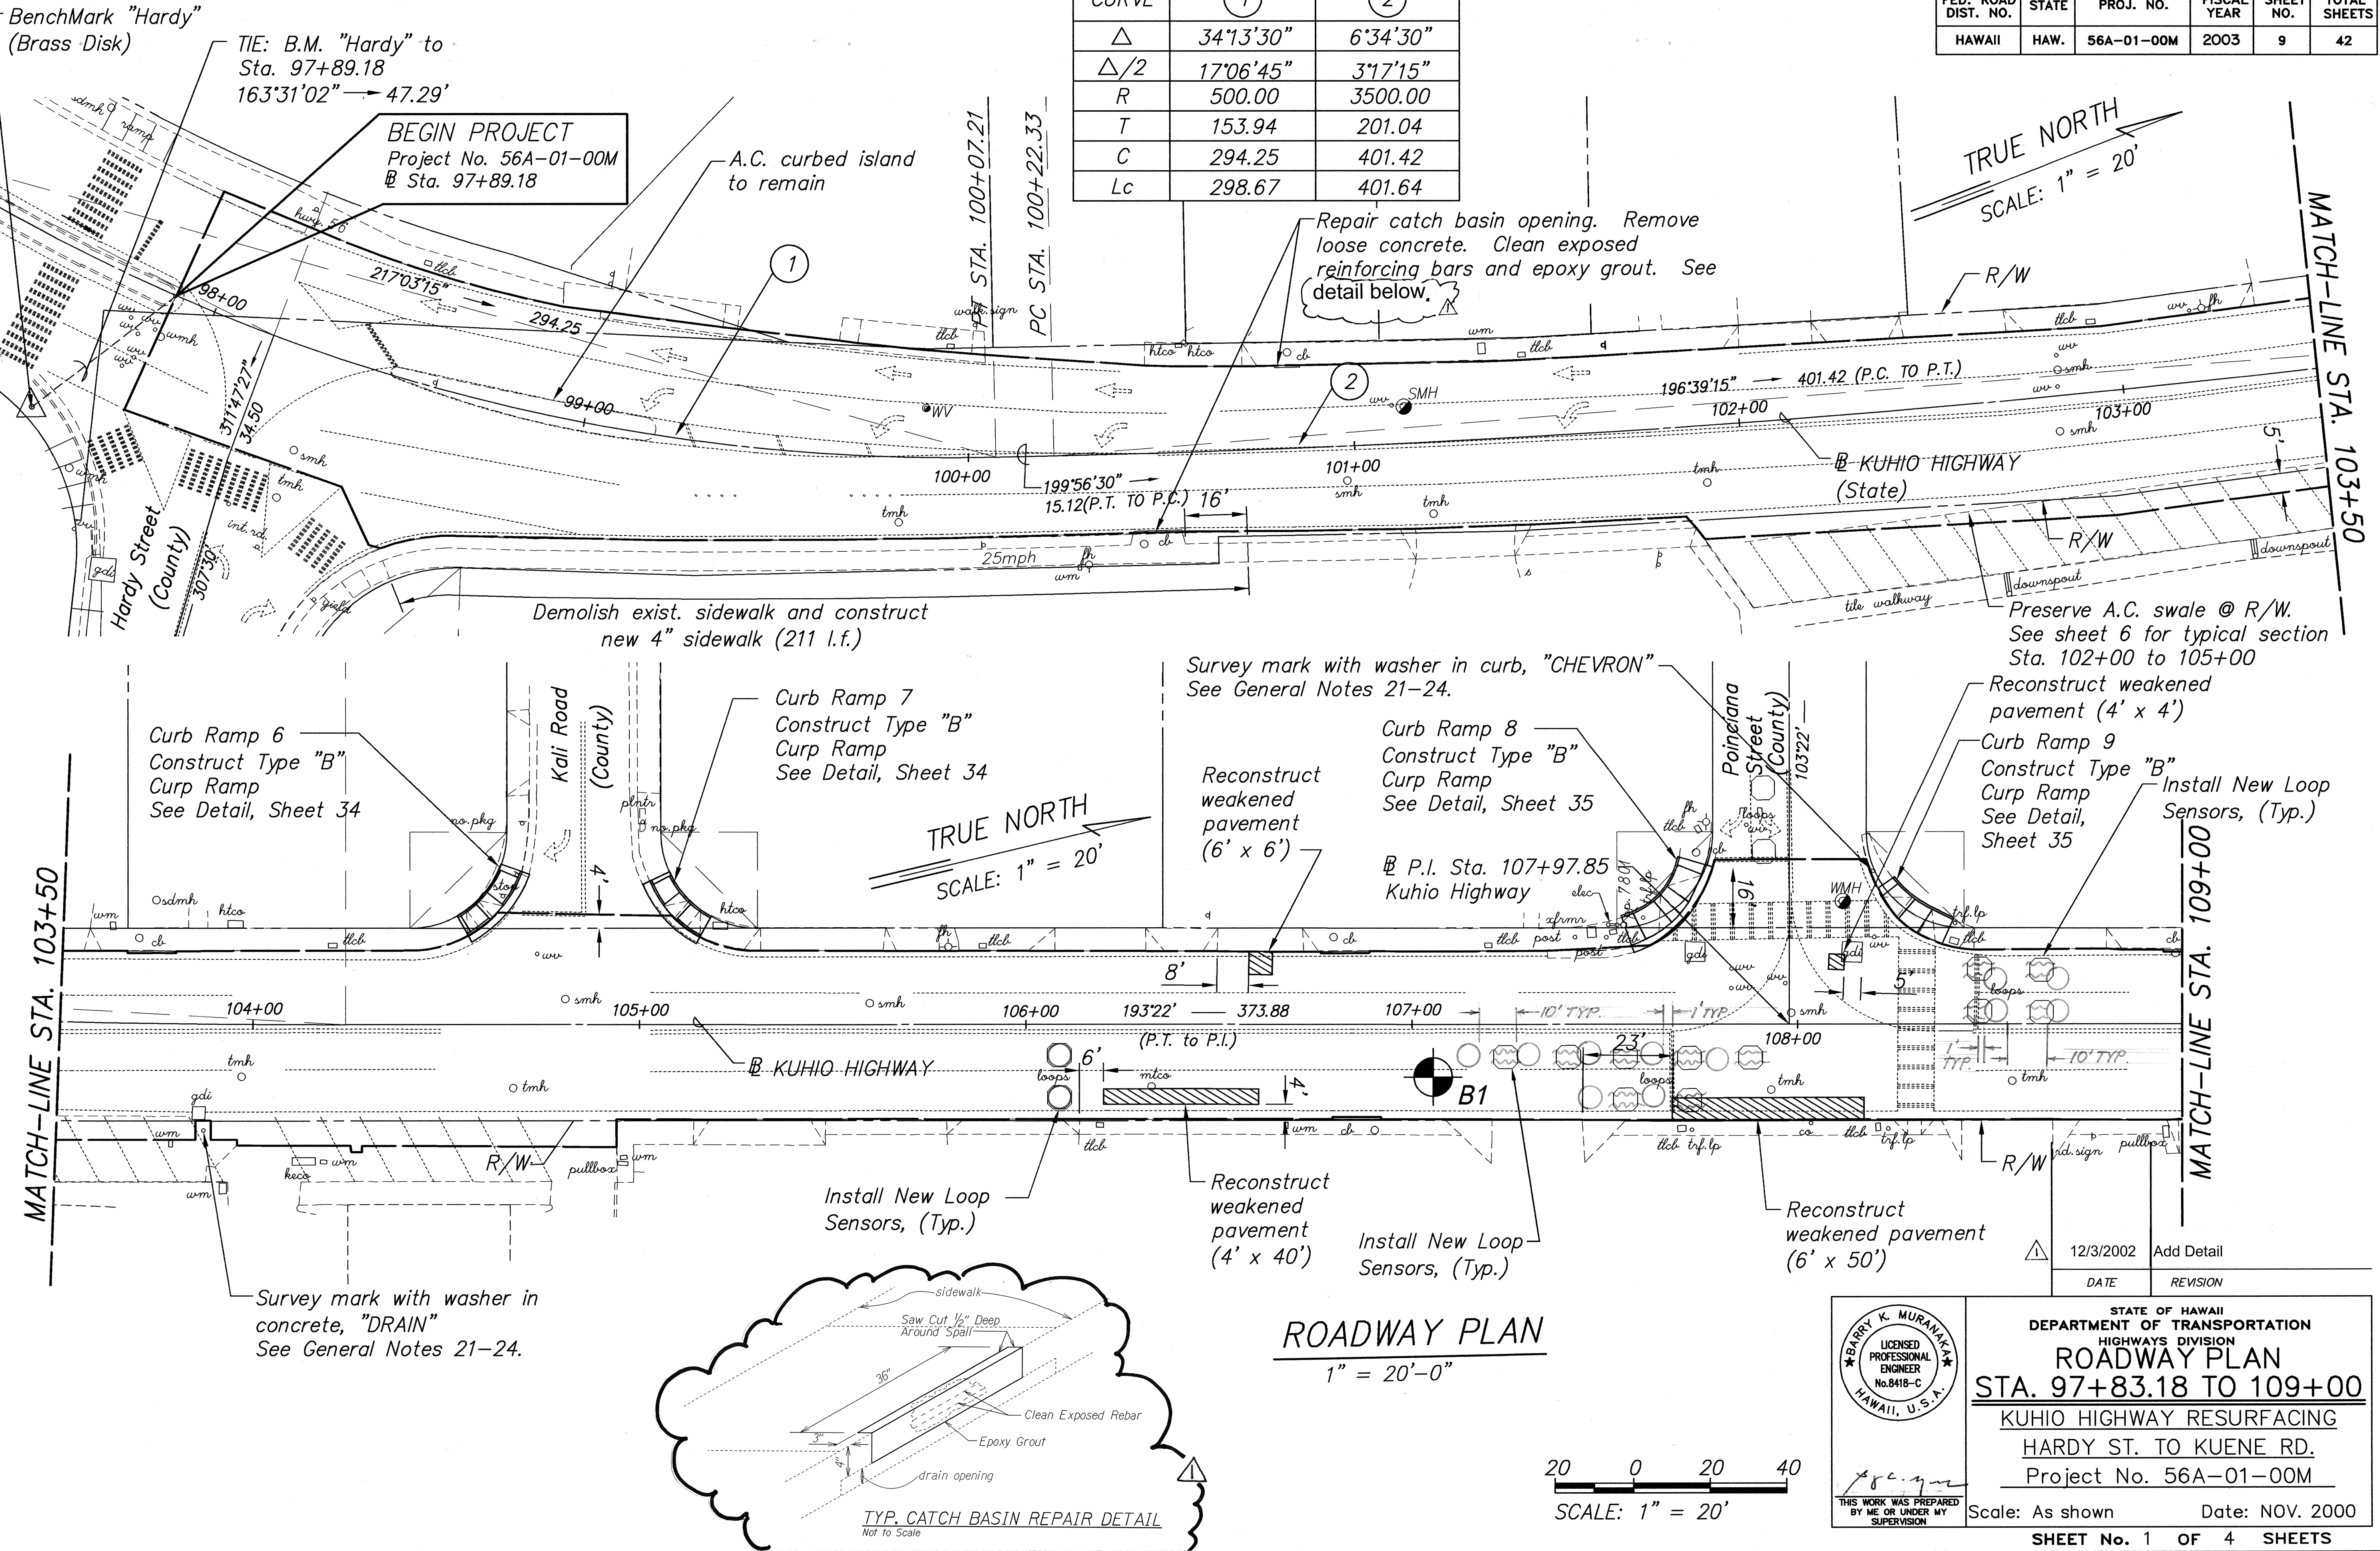

P.M.: BKM
CURRENT OPR: clj
PREV. OPR:
CURRENT TIME: Jul 05, 2002 - 9:20am
LAST SAVED BY: sai
LAST MODIFIED: Thu, 28 Mar 2002 - 11:33am

PREF: C:\Coe9901\Acad\
FILE: coe99105.dwg
BEGN: 3/31/2000
SCALE: 1"=1


ORIGINAL SURVEY PLOTTED BY	DATE
PLANNED BY	
DESIGNED BY	
QUANTITIES BY	
CHECKED BY	
NOTE BOOK	
NO.	

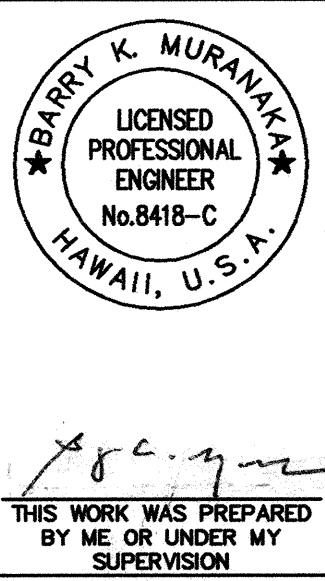

STATE OF HAWAII
DEPARTMENT OF TRANSPORTATION
HIGHWAYS DIVISION
ROADWAY PLAN
STA. 97+83.18 TO 109+00
KUHIO HIGHWAY RESURFACING
HARDY ST. TO KUENE RD.
Project No. 56A-01-00M
Scale: As shown Date: NOV. 2000
SHEET No. 1 OF 4 SHEETS

"AS-BUILT"

FED. ROAD DIST. NO.	STATE	PROJ. NO.	FISCAL YEAR	SHEET NO.	TOTAL SHEETS
HAWAII	HAW.	56A-01-00M	2003	11	42


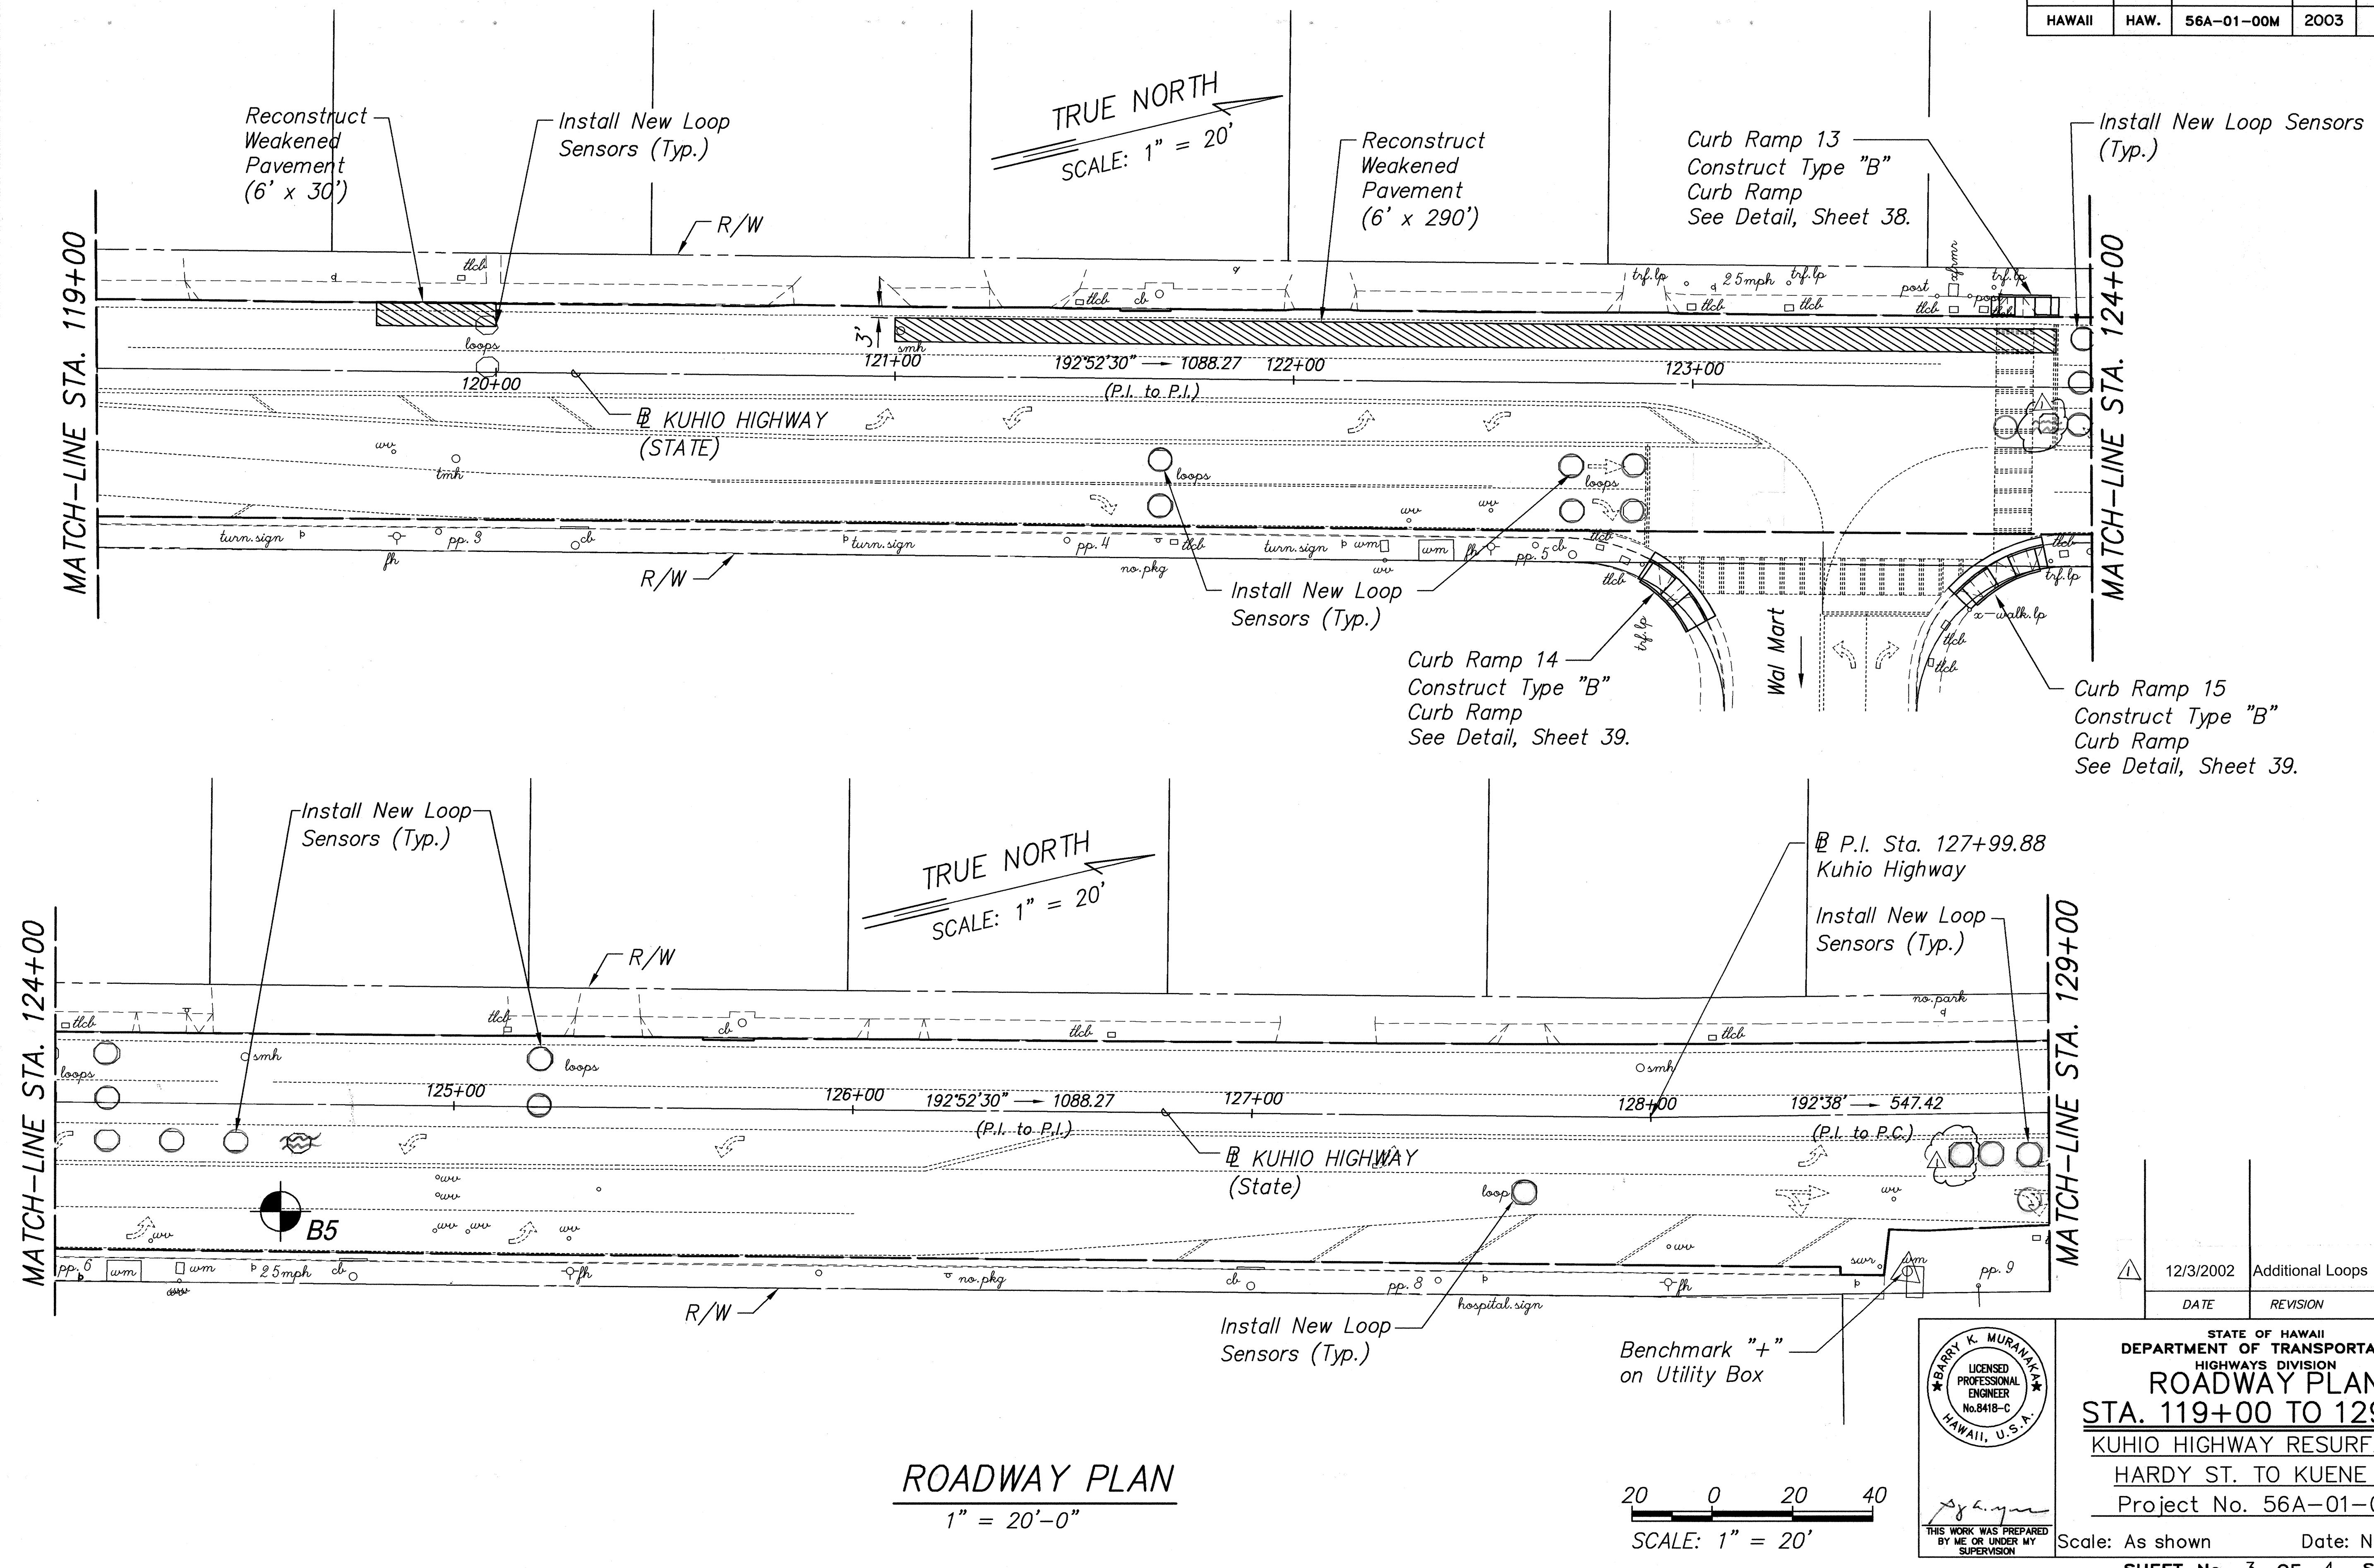


P.M.: BKM
CURRENT OPR: cjl
PREV. OPR:
CURRENT TIME: Jul 05, 2002 - 9:21am
LAST SAVED BY:
LAST MODIFIED: Thu, 28 Mar 2002 - 9:31am

PREF: C:\Coe9901\Acad\
FILE:coe99107.dwg
BEGIN: 3/31/2000
SCALE: 1"=1

ORIGINAL PLAN	SURVEY PLOTTED BY	DATE
NOTE BOOK	DESIGNED BY	
QUANTITIES BY	CHECKED BY	
N.A.		

ROADWAY PLAN
1" = 20'-0"

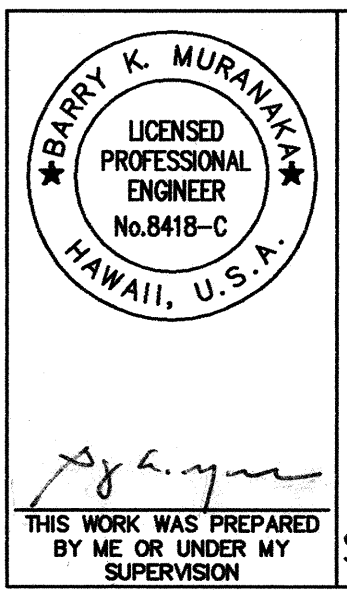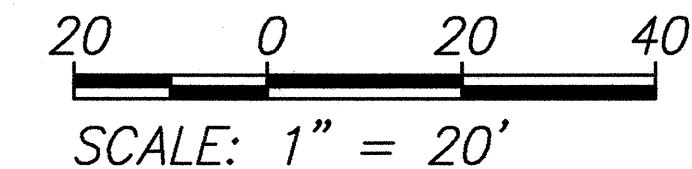


12/3/2002	Additional Loops
DATE	REVISION

STATE OF HAWAII
DEPARTMENT OF TRANSPORTATION
HIGHWAYS DIVISION
ROADWAY PLAN
STA. 119+00 TO 129+00
KUHIO HIGHWAY RESURFACING
HARDY ST. TO KUENE RD.
Project No. 56A-01-00M

Scale: As shown Date: NOV. 2000
SHEET No. 3 OF 4 SHEETS

"AS-BUILT"

FED. ROAD DIST. NO.	STATE	PROJ. NO.	FISCAL YEAR	SHEET NO.	TOTAL SHEETS
HAWAII	HAW.	56A-01-00M	2003	12	42

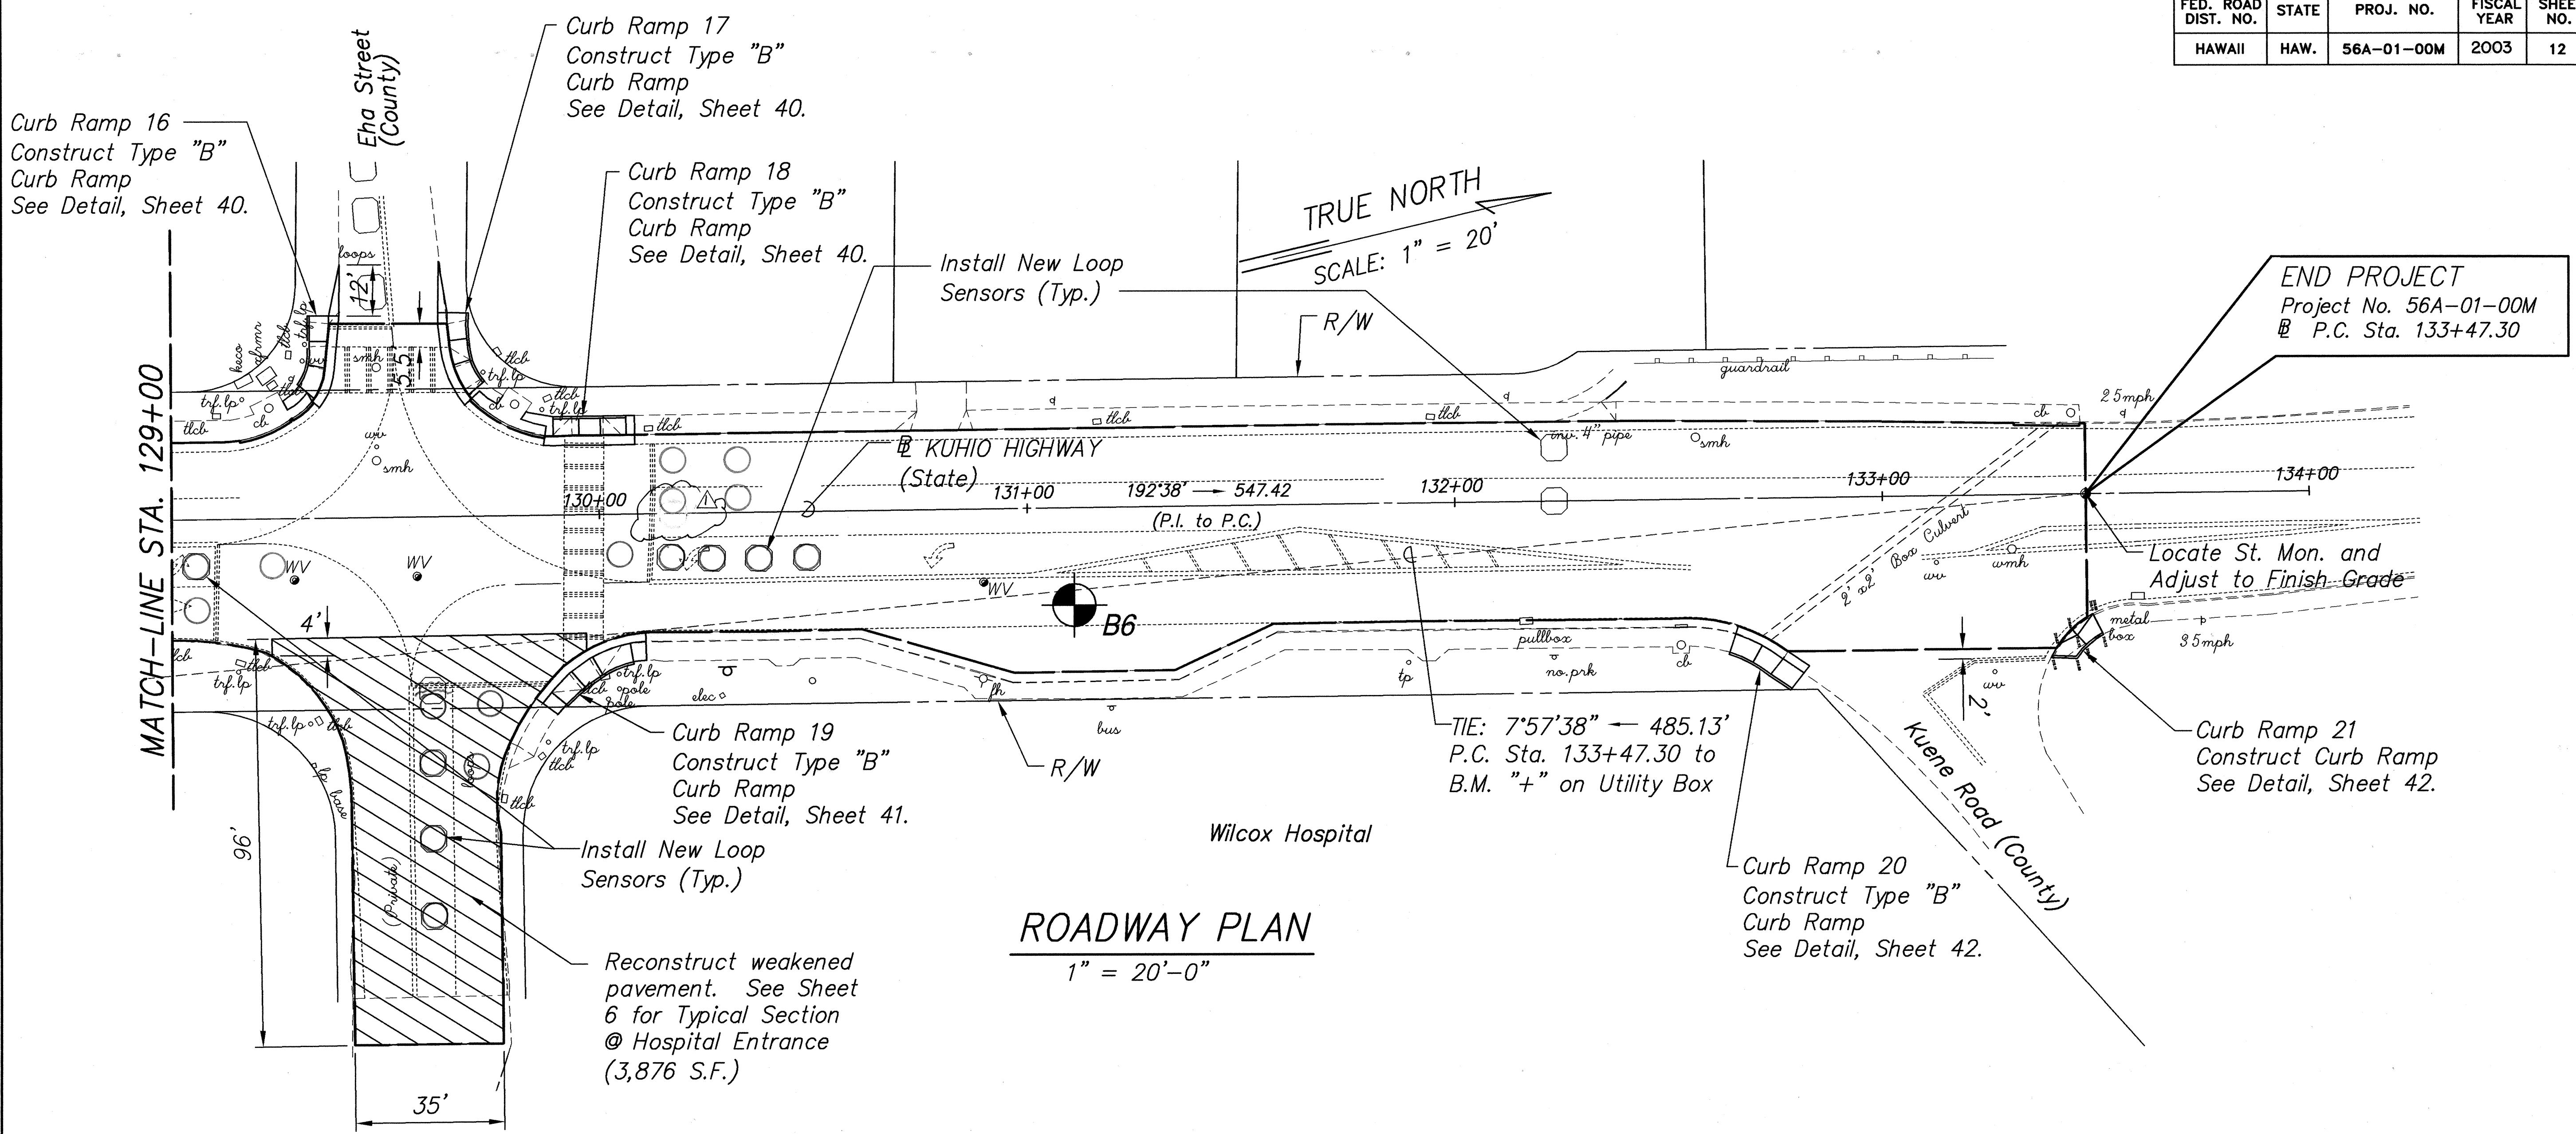


P.M.: BKM
 CURRENT OPR: dij
 PREVIOUS OPR: dij
 CURRENT TIME: Jul 05, 2002 - 10:32am
 LAST SAVED BY: dij
 LAST MODIFIED: Thu, 28 Mar 2002 - 9:53am


PREFIX: G:\Coe9901\Acad\
 FILE: coe99115.dwg
 BEGIN: 3/31/2000
 SCALE: 1"=1'

ORIGINAL SURVEY PLOTTED BY	DATE
DATE	
DRAWN BY	
CHECKED BY	
QUANTITIES BY	
CHECKED BY	
NO. BOOK	
NO.	

ROADWAY PLAN
 1" = 20'-0"

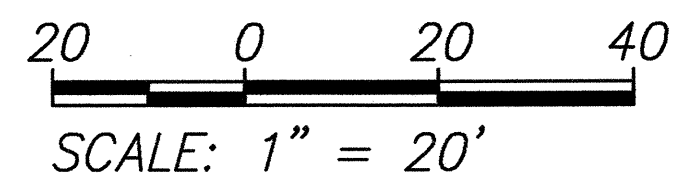

12/3/2002	Loop Deleted
DATE	REVISION

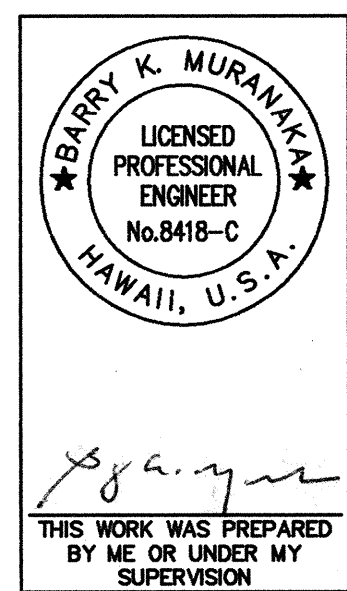

STATE OF HAWAII
 DEPARTMENT OF TRANSPORTATION
 HIGHWAYS DIVISION
ROADWAY PLAN
STA. 129+00 TO END
KUHIO HIGHWAY RESURFACING
HARDY ST. TO KUENE RD.
 Project No. 56A-01-00M

Scale: As shown Date: NOV. 2000
 SHEET No. 4 OF 4 SHEETS

"AS-BUILT"