

STATE OF HAWAII

DEPARTMENT OF TRANSPORTATION

HIGHWAYS DIVISION

HONOLULU, HAWAII

"AS-BUILT"

PLANS FOR

KUHIO HIGHWAY



PEDESTRIAN FACILITIES AND ADA COMPLIANCE

AT VARIOUS LOCATIONS

FEDERAL-AID PROJECT NO. CMAQ-056-1(47)

DISTRICT OF KAWAIIHAU


ISLAND OF KAUAI

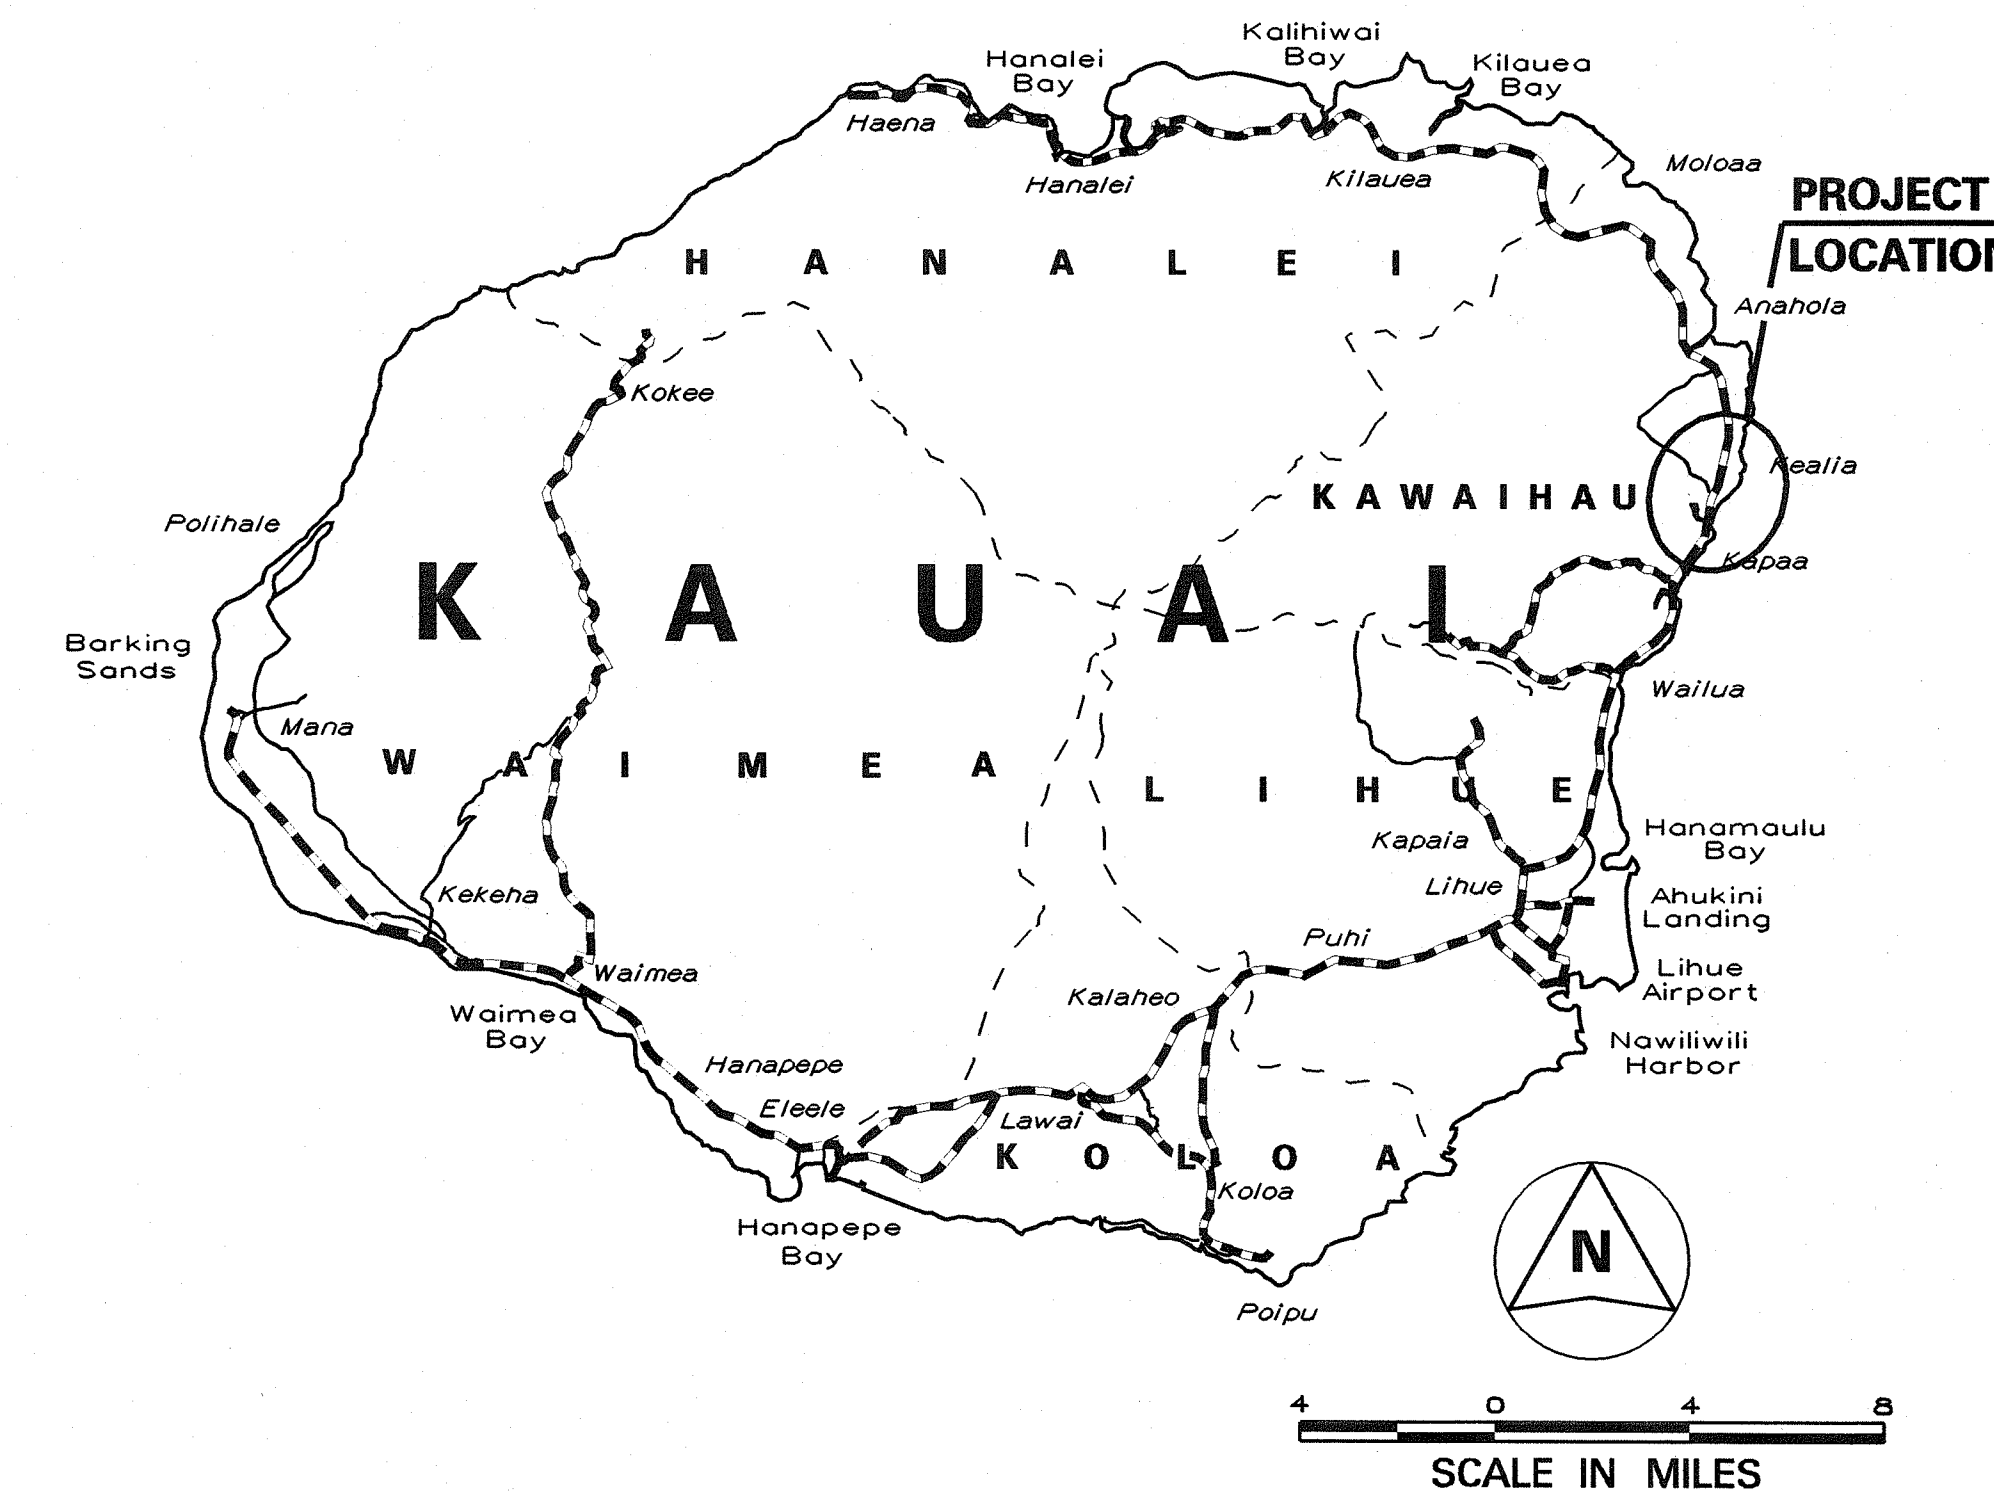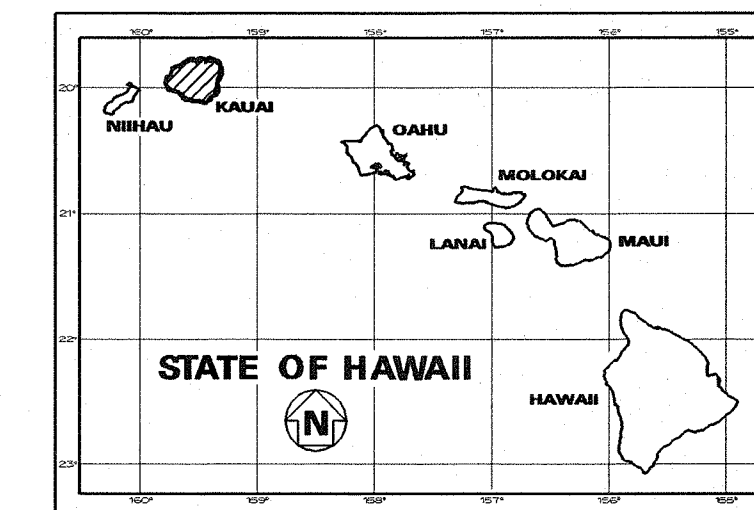

MILE POST 8.25 TO MILE POST 9.00

ADT (2003).....	19,400
ADT (2023).....	23,400
DHV	1,870
D	55/45
T	3.5 %
V	25 M.P.H.

GROSS LENGTH OF PROJECT.....0.76 MILE
NET LENGTH OF PROJECT.....0.76 MILE

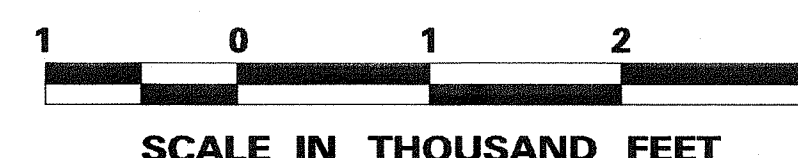

CHANGES MADE DURING CONSTRUCTION HAVE BEEN
INCORPORATED ON THESE PLANS EXCEPT CHANGES
IN THE ORIGINAL THEORETICAL QUANTITIES. FOR
ACTUAL QUANTITIES, REFER TO PROJECT LEDGER
AND/OR COMPUTATION BOOK.

Shahid H. Hani 8/30/10
REGISTERED ENGINEER PLATE

DEPARTMENT OF TRANSPORTATION STATE OF HAWAII	
APPROVED:  for DIR. OF TRANSPORTATION	5/13/03 DATE