


FED. ROAD DIST. NO.	STATE	PROJ. NO.	FISCAL YEAR	SHEET NO.	TOTAL SHEETS
HAWAII	HAW.	56B-01-01M	2003	33	34

20 30 40

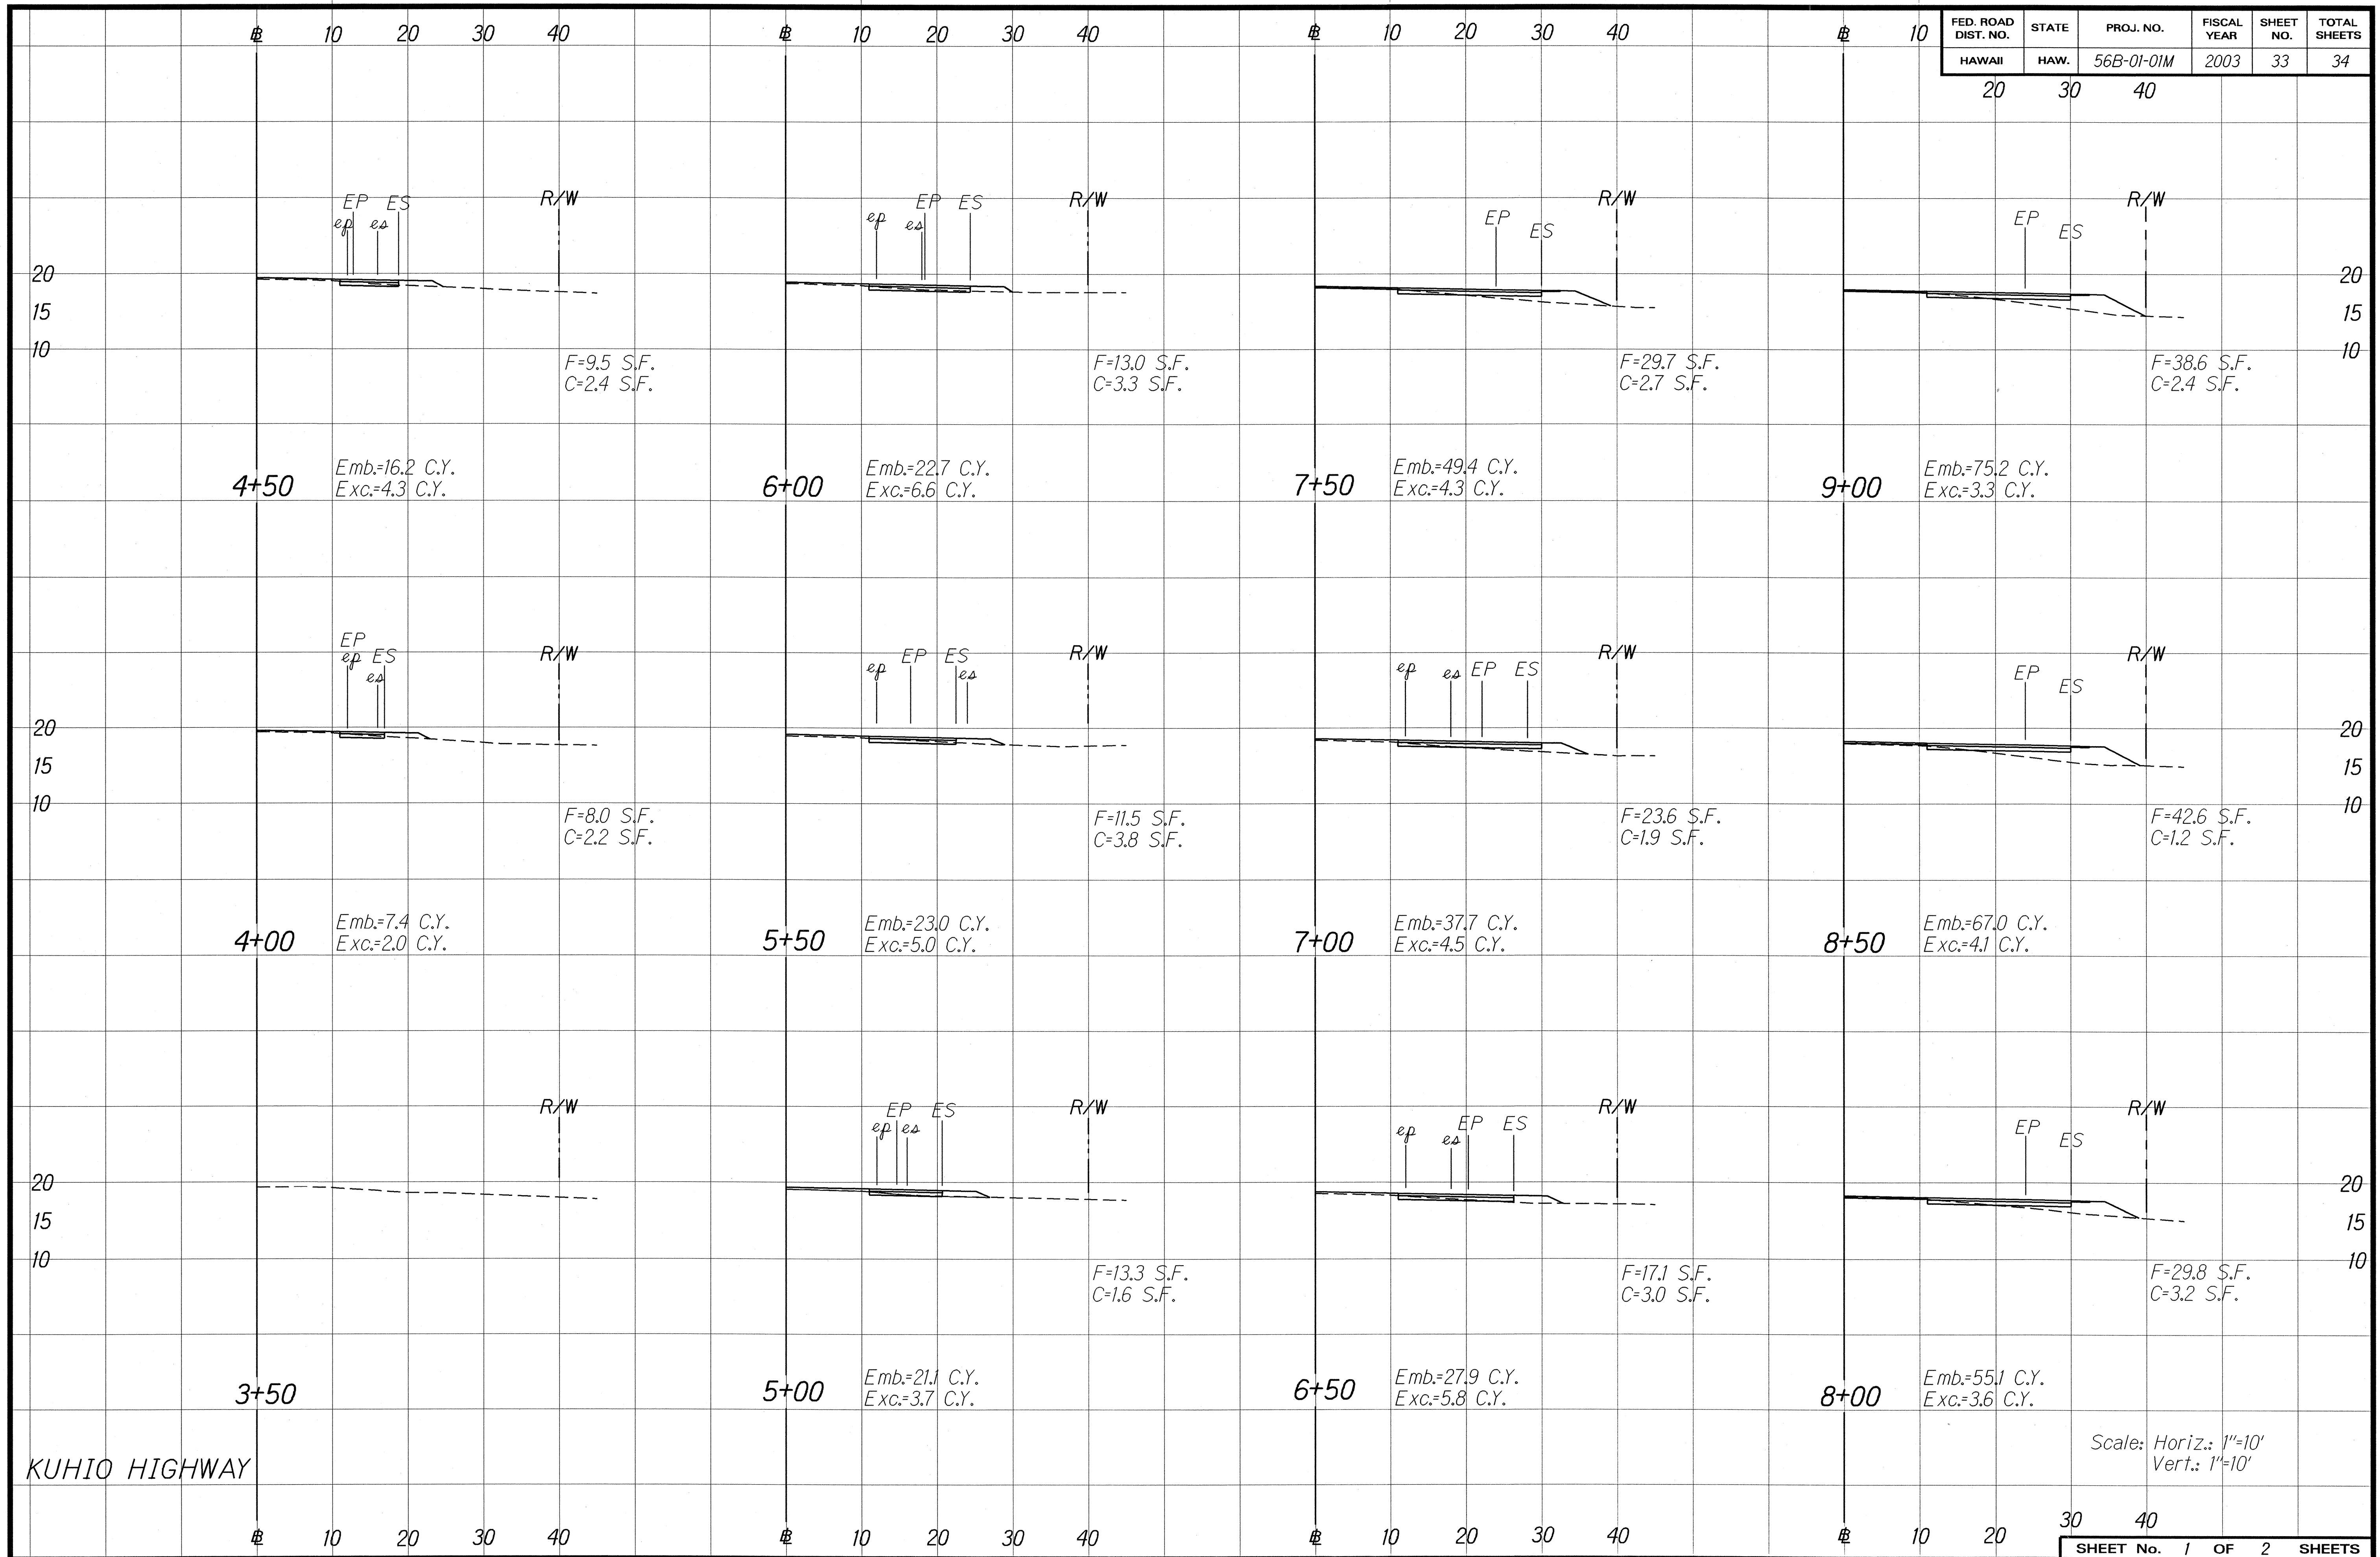


KUHIO HIGHWAY

Scale: Horiz.: 1"=10'
Vert.: 1"=10'

SURVEY PLOTTED BY: DATE: 3/17/03
DRAWN BY: SL
CHECKED BY: BHL/BS
NOTE BOOK: 00339w
ORIGINAL PLAN: 1/1/03

FED. ROAD DIST. NO.	STATE	PROJ. NO.	FISCAL YEAR	SHEET NO.	TOTAL SHEETS
HAWAII	HAW.	56B-01-01M	2003	34	34

20 30 40

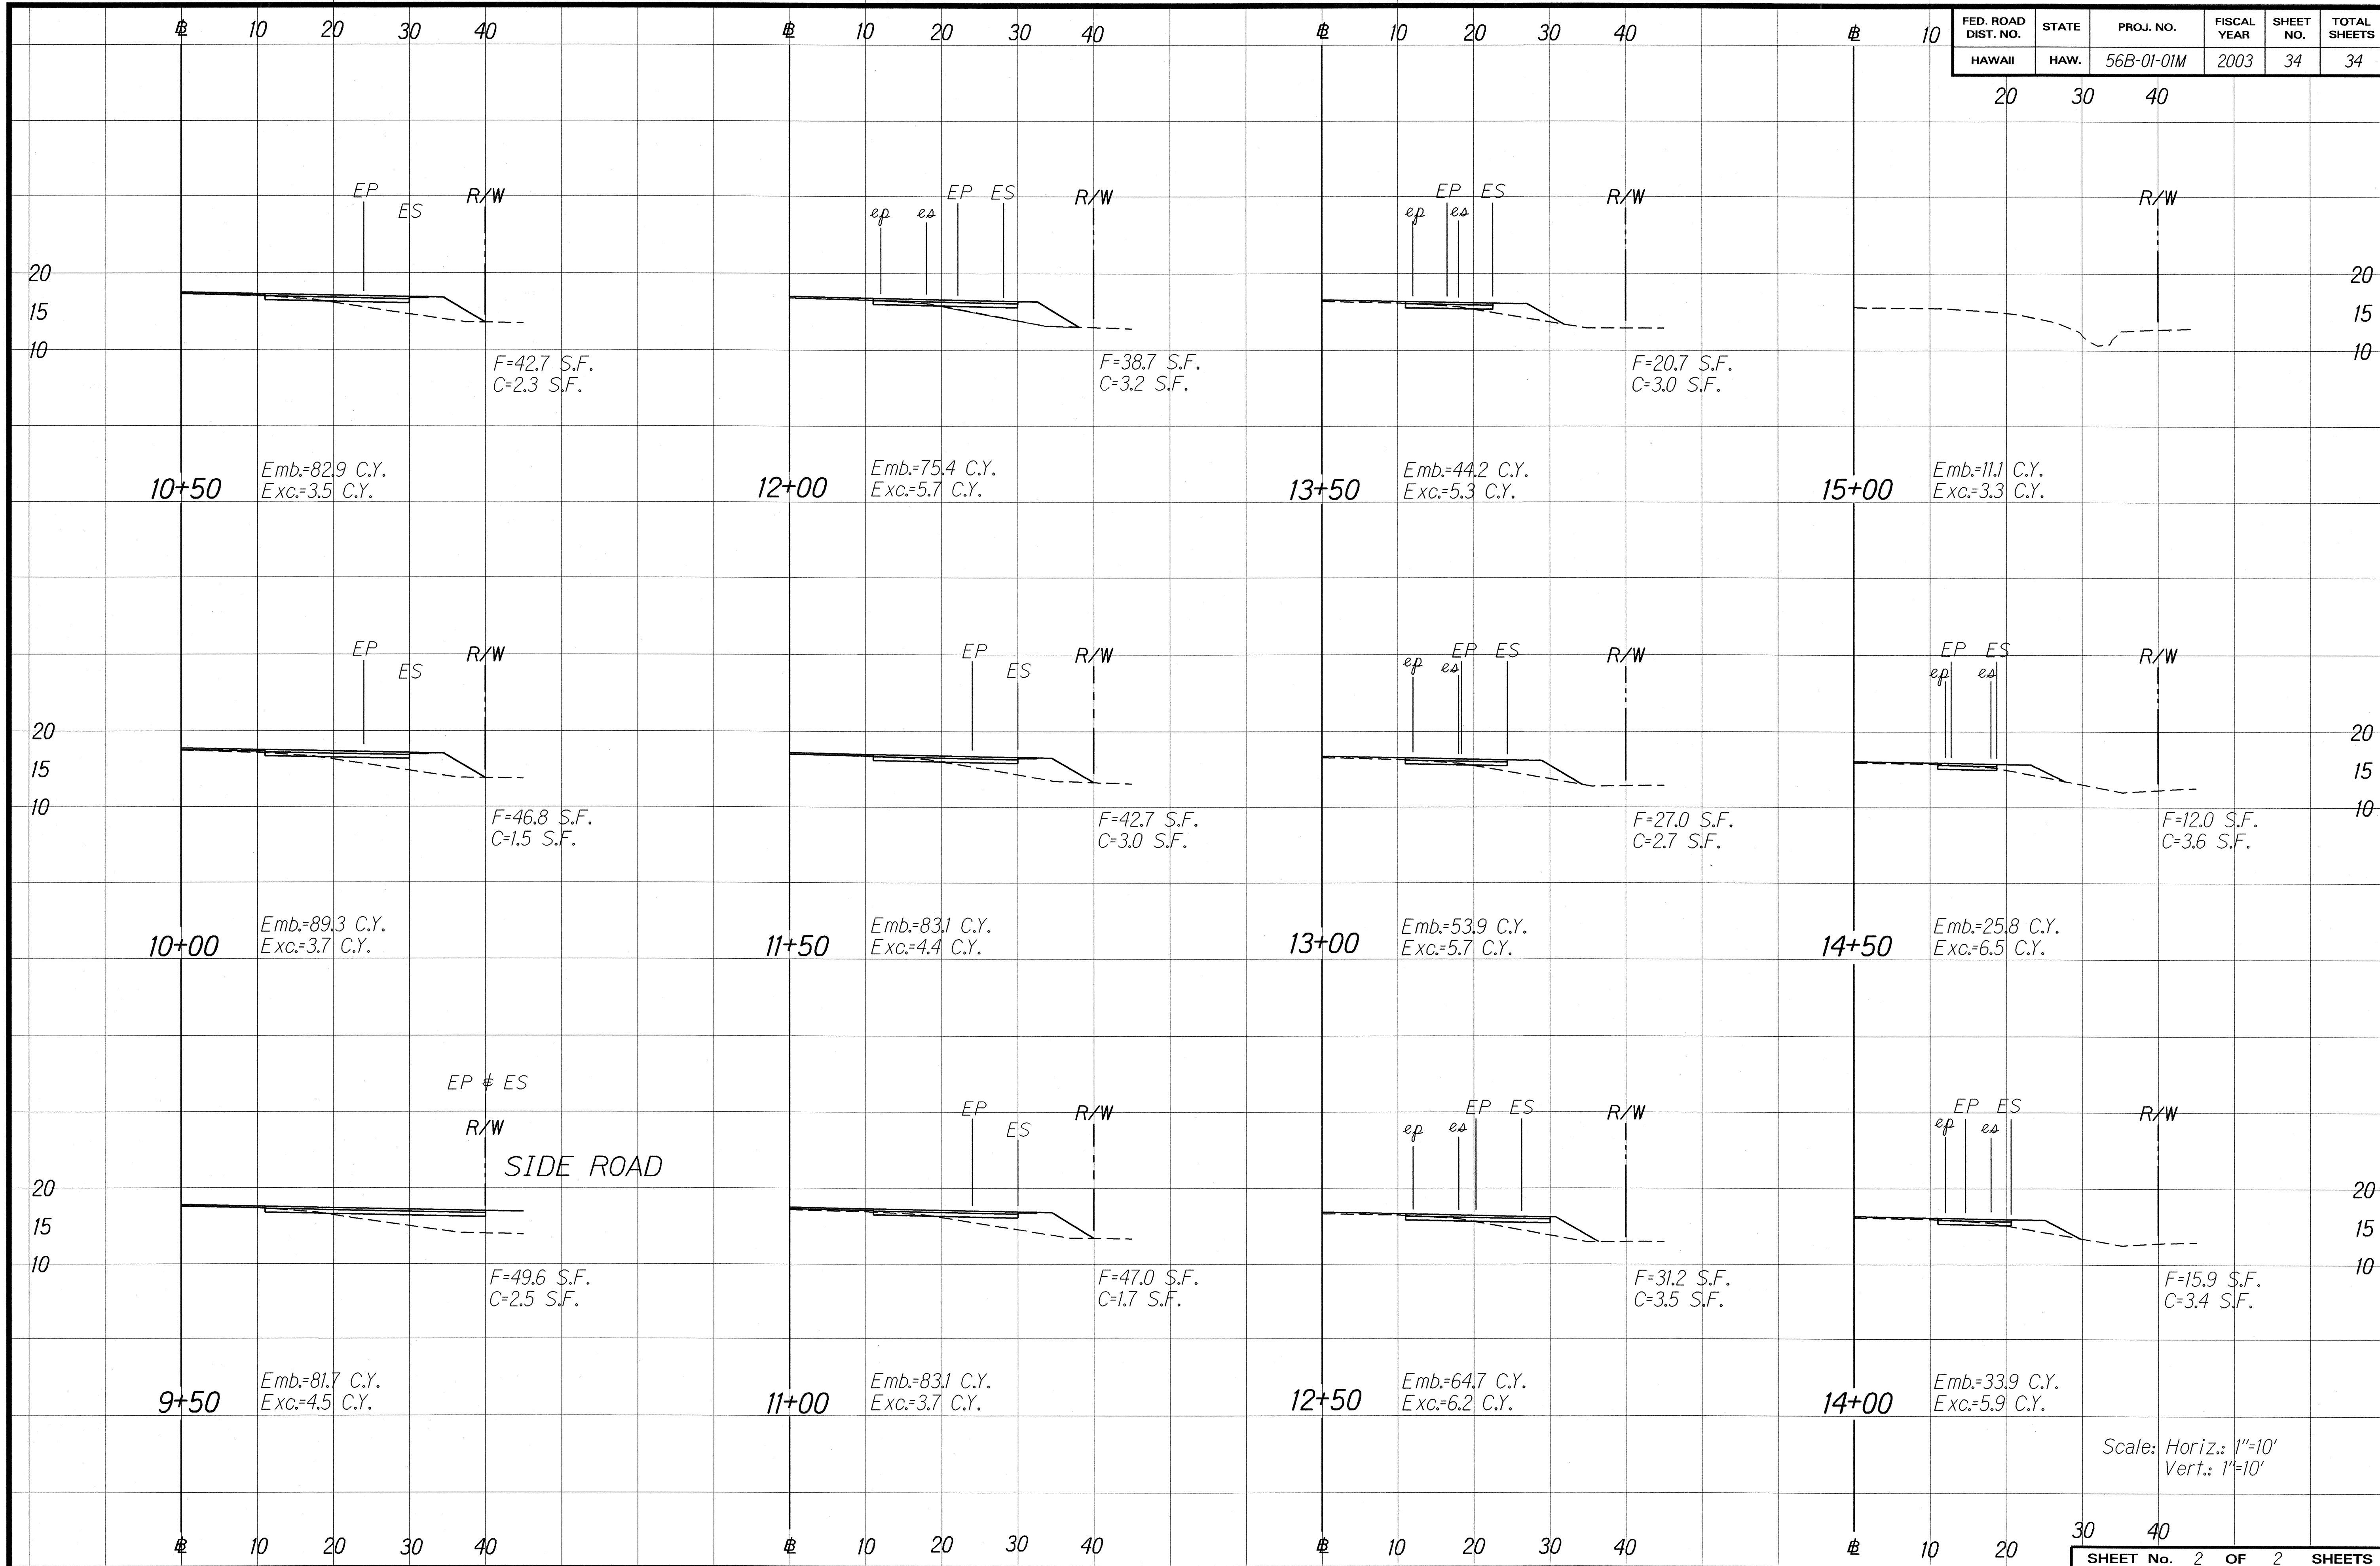

SURVEY PLOTTED BY: DATE: 11/28/02
 DRAWN BY: ST
 CHECKED BY: B.H. B.S.
 NOTE BOOK: 01315
 QUANTITIES BY: 11/28/02
 CHECKED BY: 11/28/02

EP & ES
 R/W
 SIDE ROAD

Scale: Horiz.: 1"=10'
 Vert.: 1"=10'