


FED. ROAD DIST. NO.	STATE	PROJ. NO.	FISCAL YEAR	SHEET NO.	TOTAL SHEETS
HAWAII	HAW.	56B-01-01M	2003	ADD. 17	34

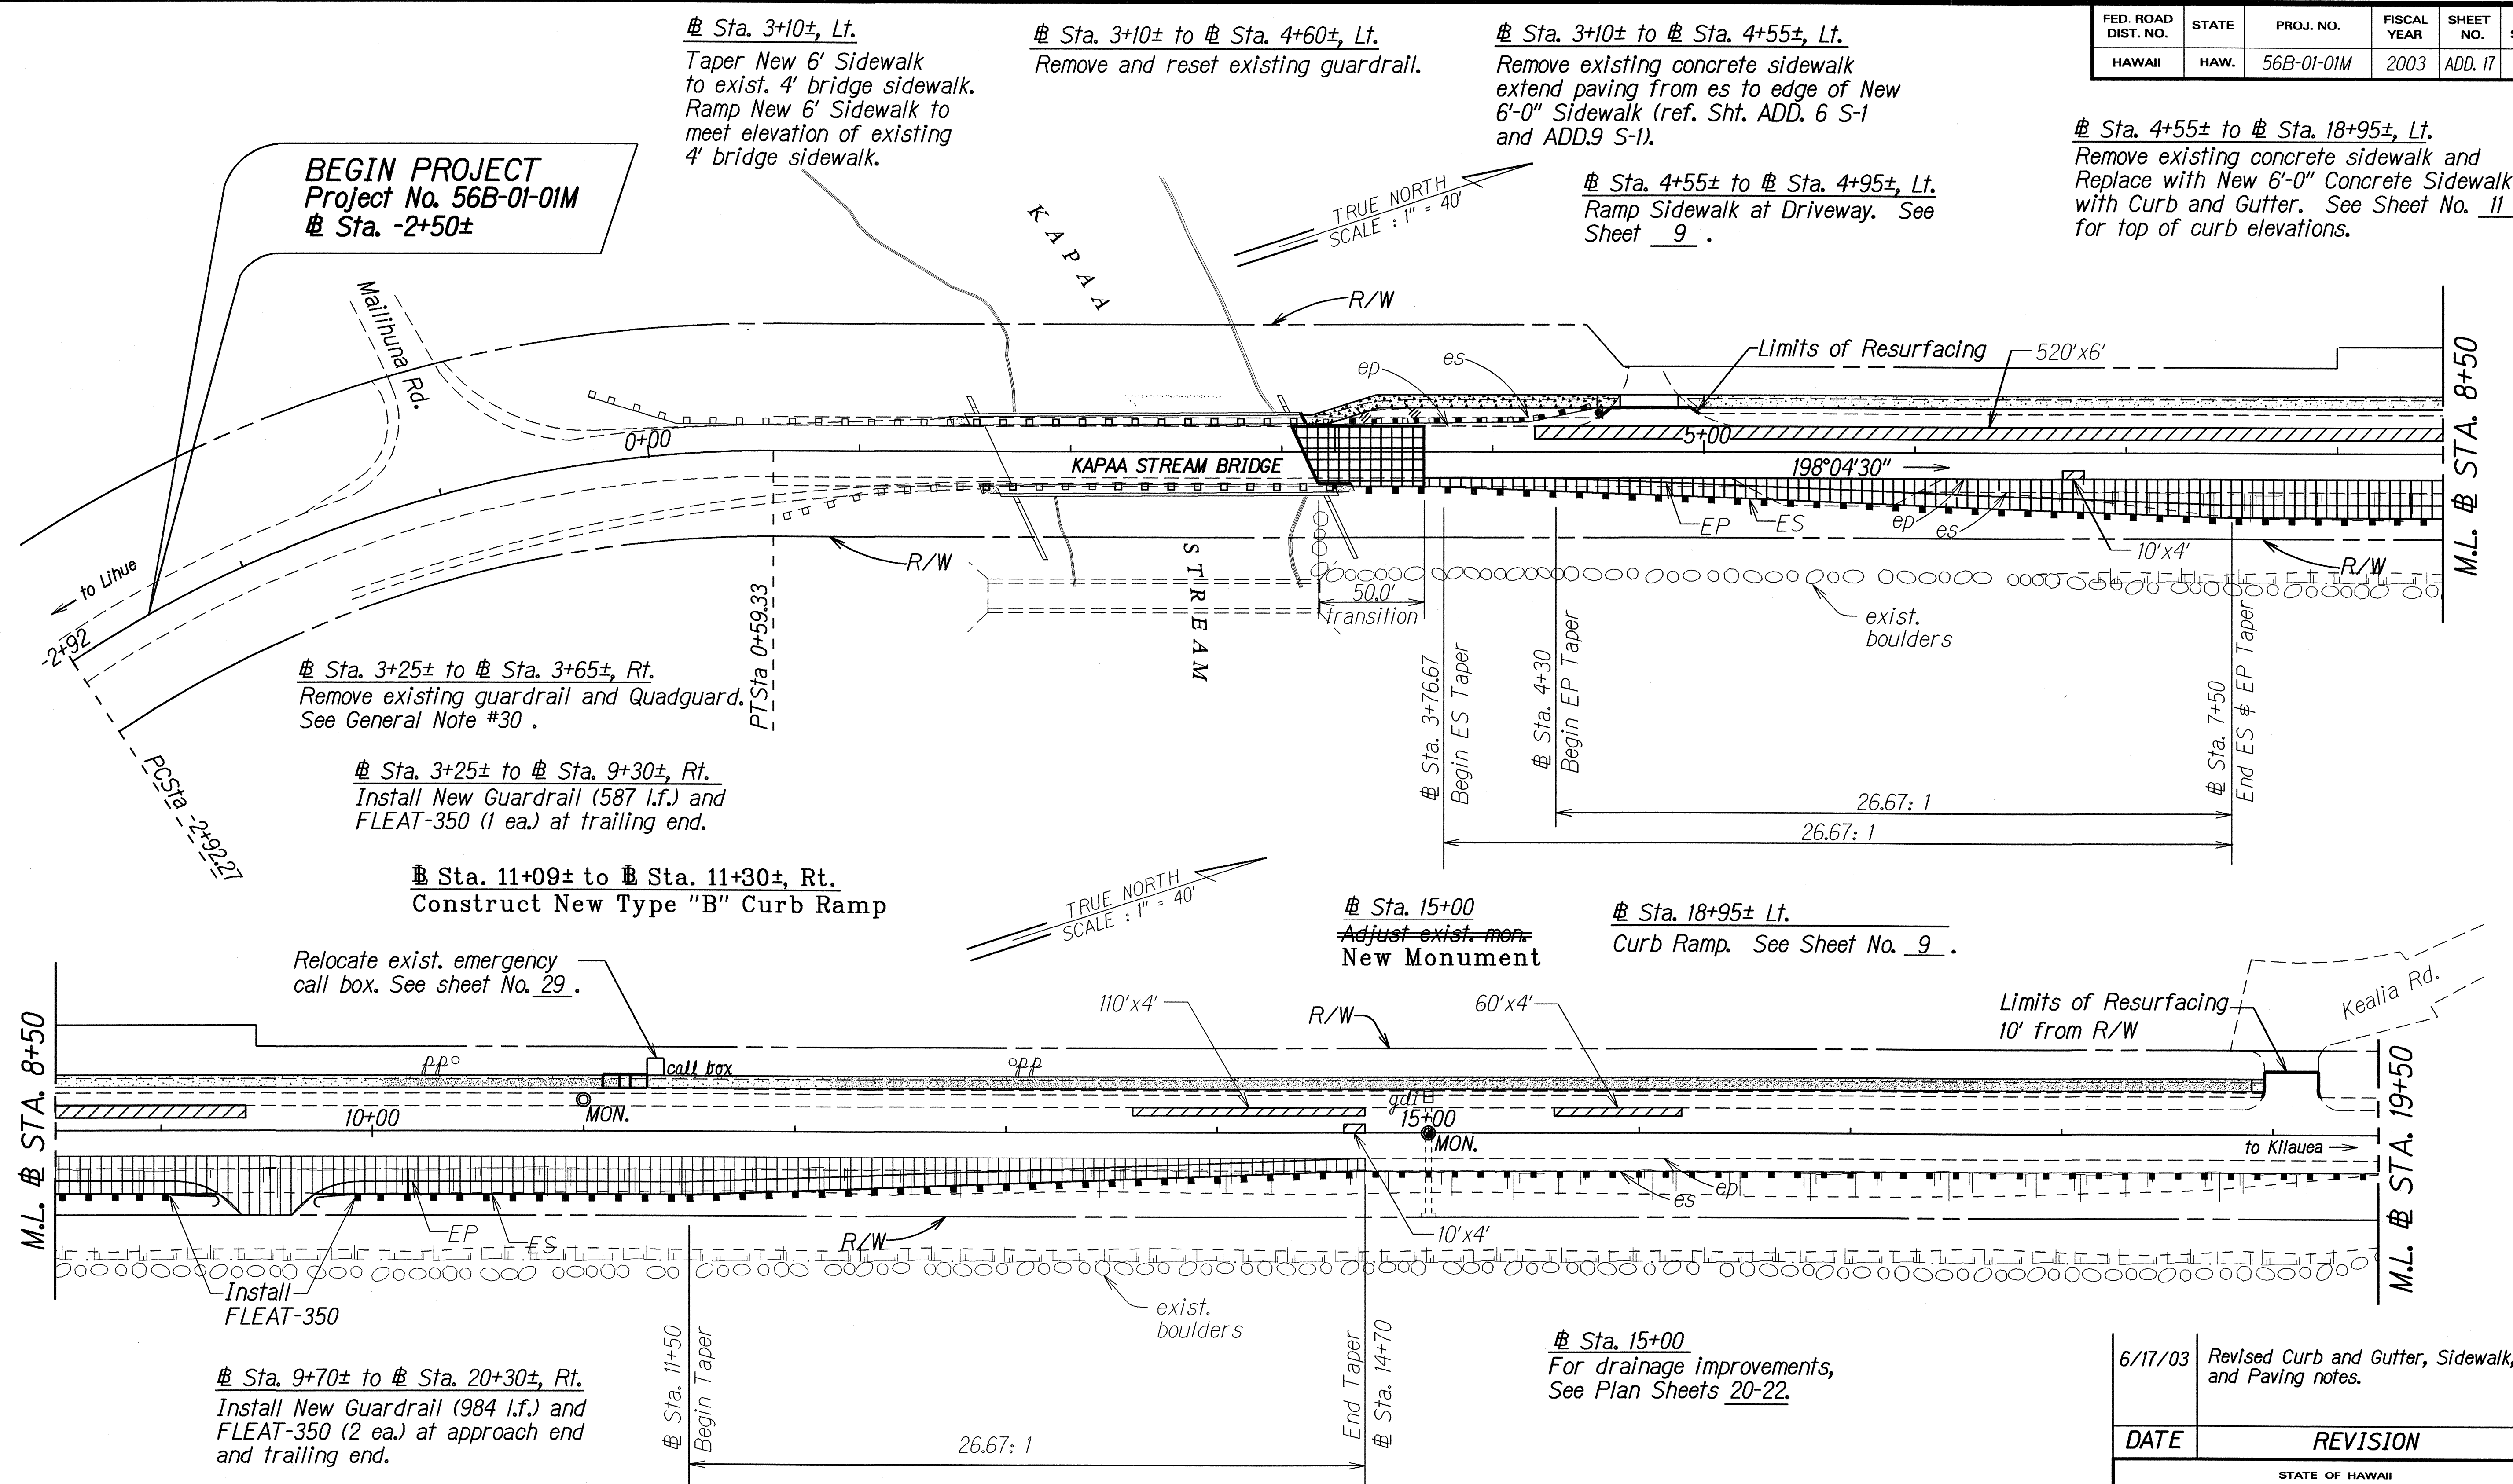

SURVEY PLOTTED BY	DATE
DESIGNED BY	12/12/02
QUANTITIES BY	
CHECKED BY	



LEGEND FOR AS-BUILT POSTINGS	
	Squiggly line for as-built deletion
	Double line for as-built deletion
Roadway	Text for as-built posting



6/17/03	Revised Curb and Gutter, Sidewalk, and Paving notes.
DATE	REVISION
STATE OF HAWAII DEPARTMENT OF TRANSPORTATION HIGHWAYS DIVISION ROADWAY PLAN KUHIO HIGHWAY RESURFACING Vicinity of Kealia Project No. 56B-01-01M Scale: 1"=40' Date: April, 2003 SHEET No. 1 OF 3 SHEETS	

"AS-BUILT"

ADD. 17

FED. ROAD DIST. NO.	STATE	PROJ. NO.	FISCAL YEAR	SHEET NO.	TOTAL SHEETS
HAWAII	HAW.	56B-01-01M	2003	19	34

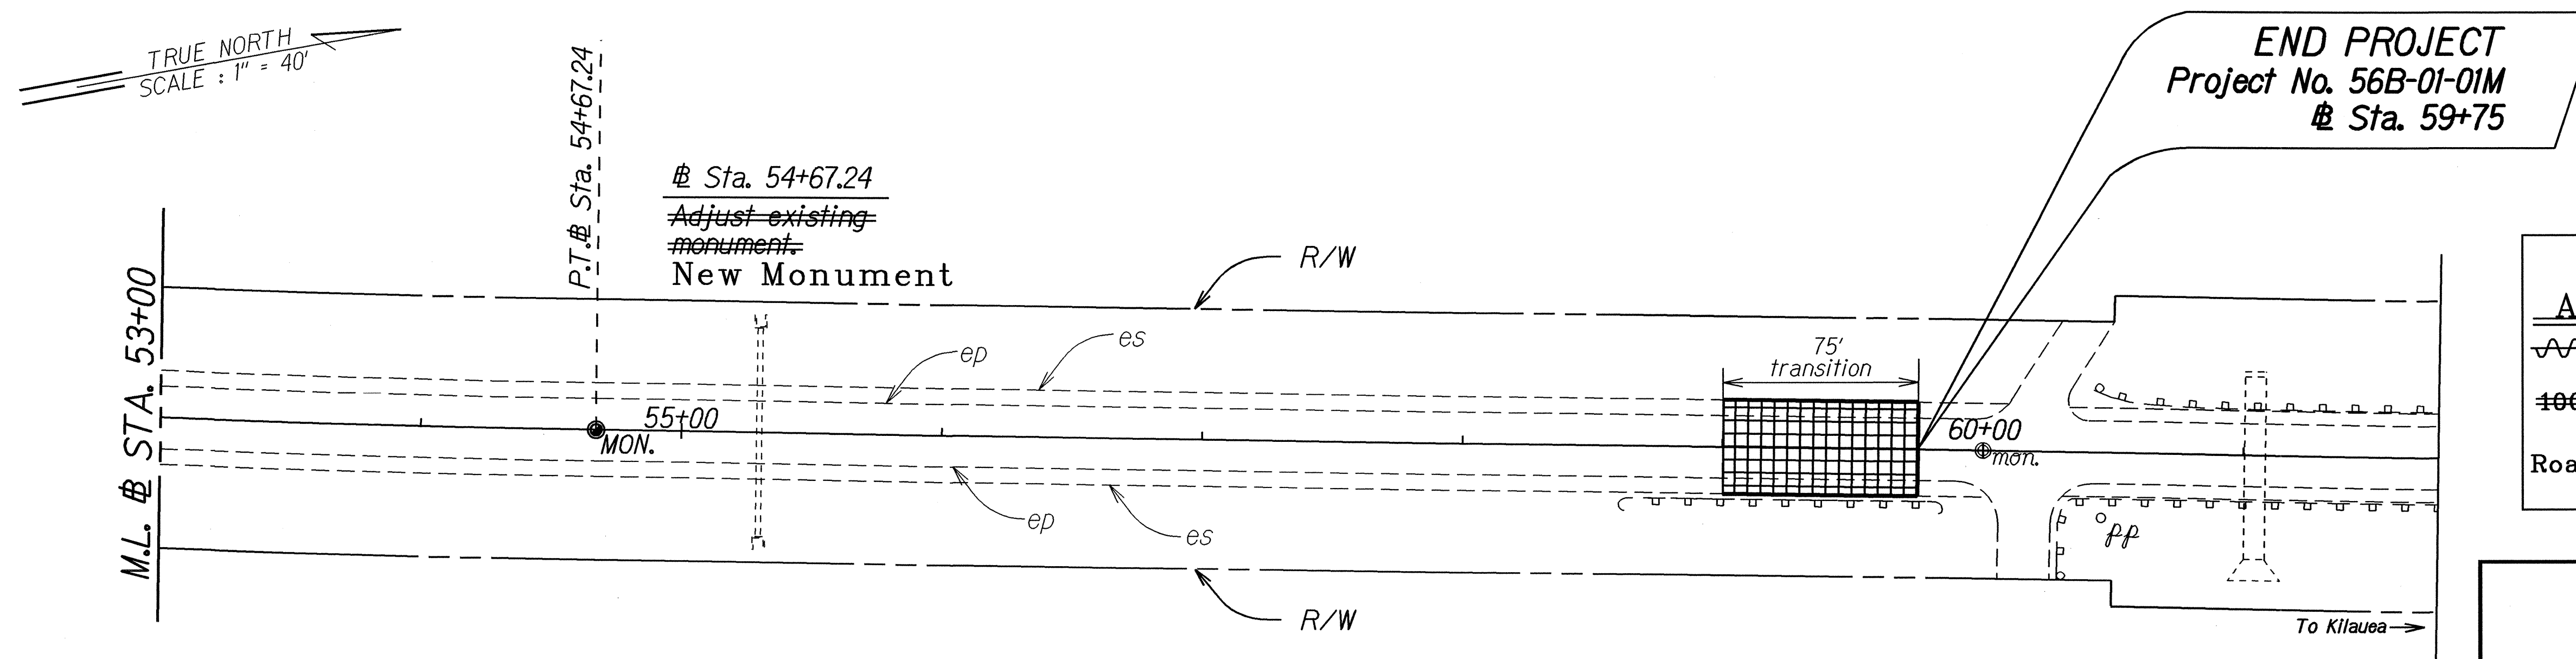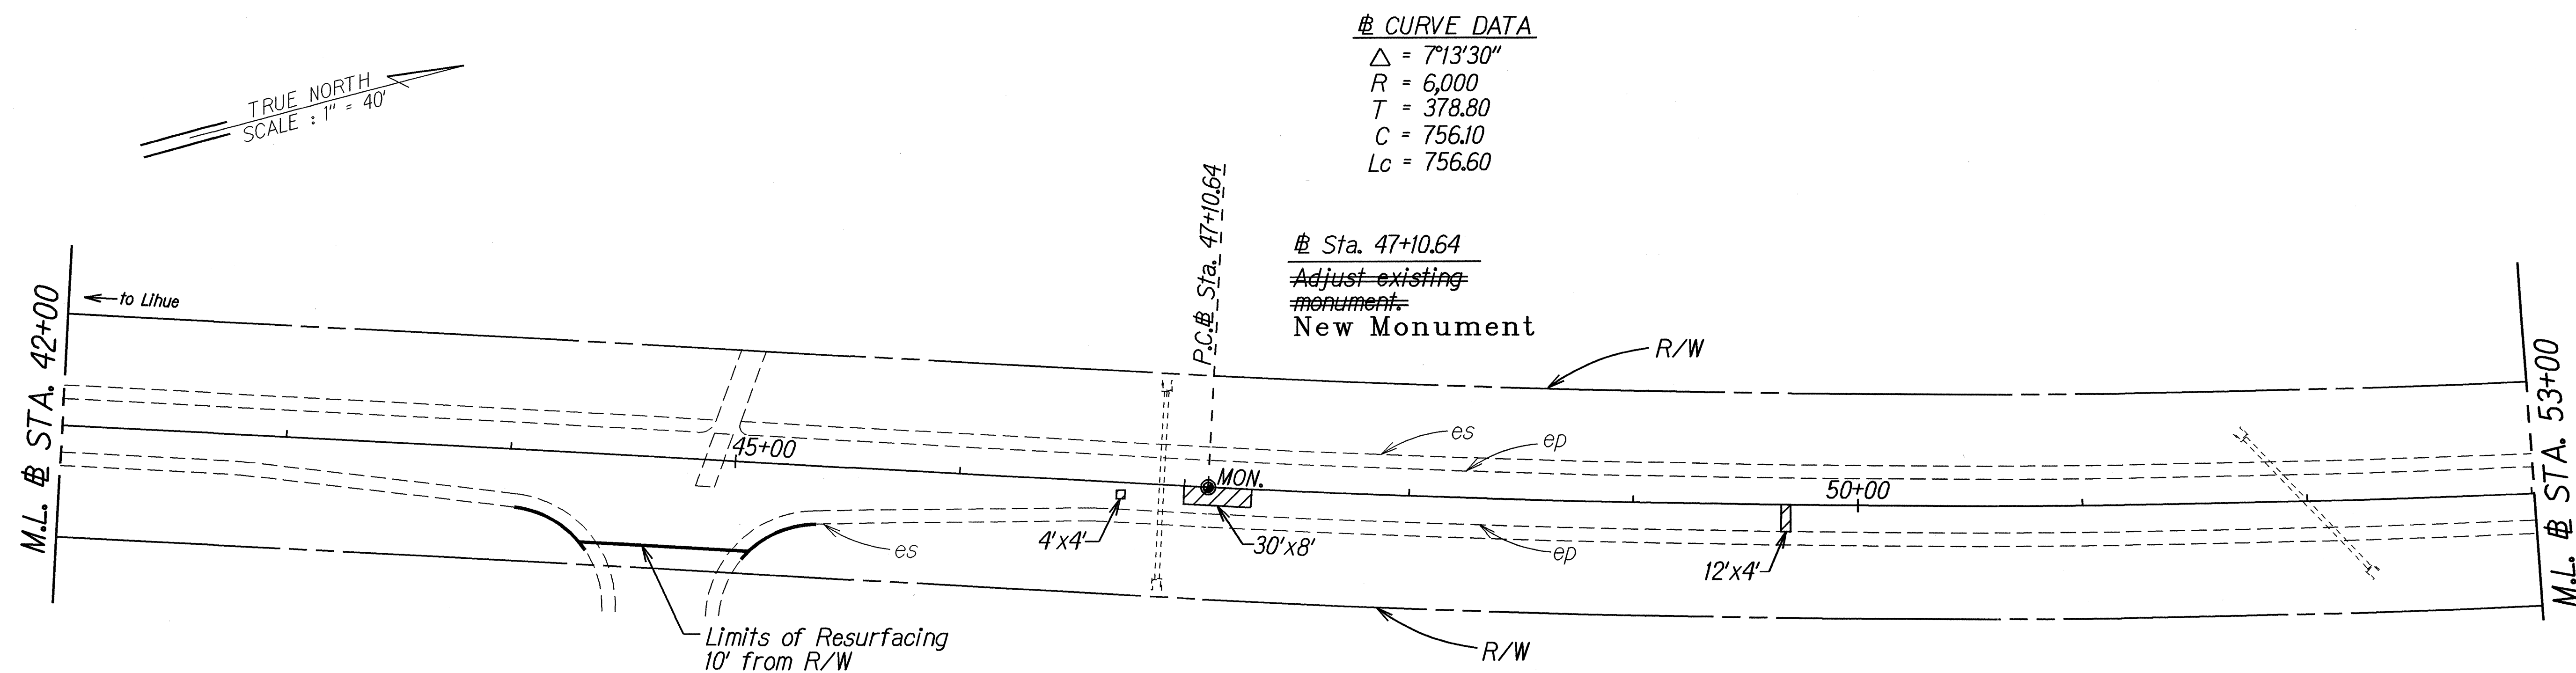

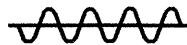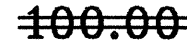LEGEND FOR AS-BUILT POSTINGS	
	Squiggly line for as-built deletion
	Double line for as-built deletion
Roadway	Text for as-built posting

STATE OF HAWAII
DEPARTMENT OF TRANSPORTATION
HIGHWAYS DIVISION

ROADWAY PLAN

KUHIO HIGHWAY RESURFACING
Vicinity of Kealia
Project No. 56B-01-01M

Scale: 1"=40' Date: April, 2003

SHEET No. 3 OF 3 SHEETS

- NOTE:
- Reference Sheet 8 for A.C. resurfacing connection at paved side road.

"AS-BUILT"

ORIGINAL PLAN	DATE: 12/02/02
SURVEY PLOTTED BY	
DESIGNED BY	
QUANTITIES BY	
CHECKED BY	
NOTE BOOK	
NO. 24/000330	