


PLAN VIEW 12'-0" SECTIONAL PLATE CULVERT

Scale: 1" = 10'-0"

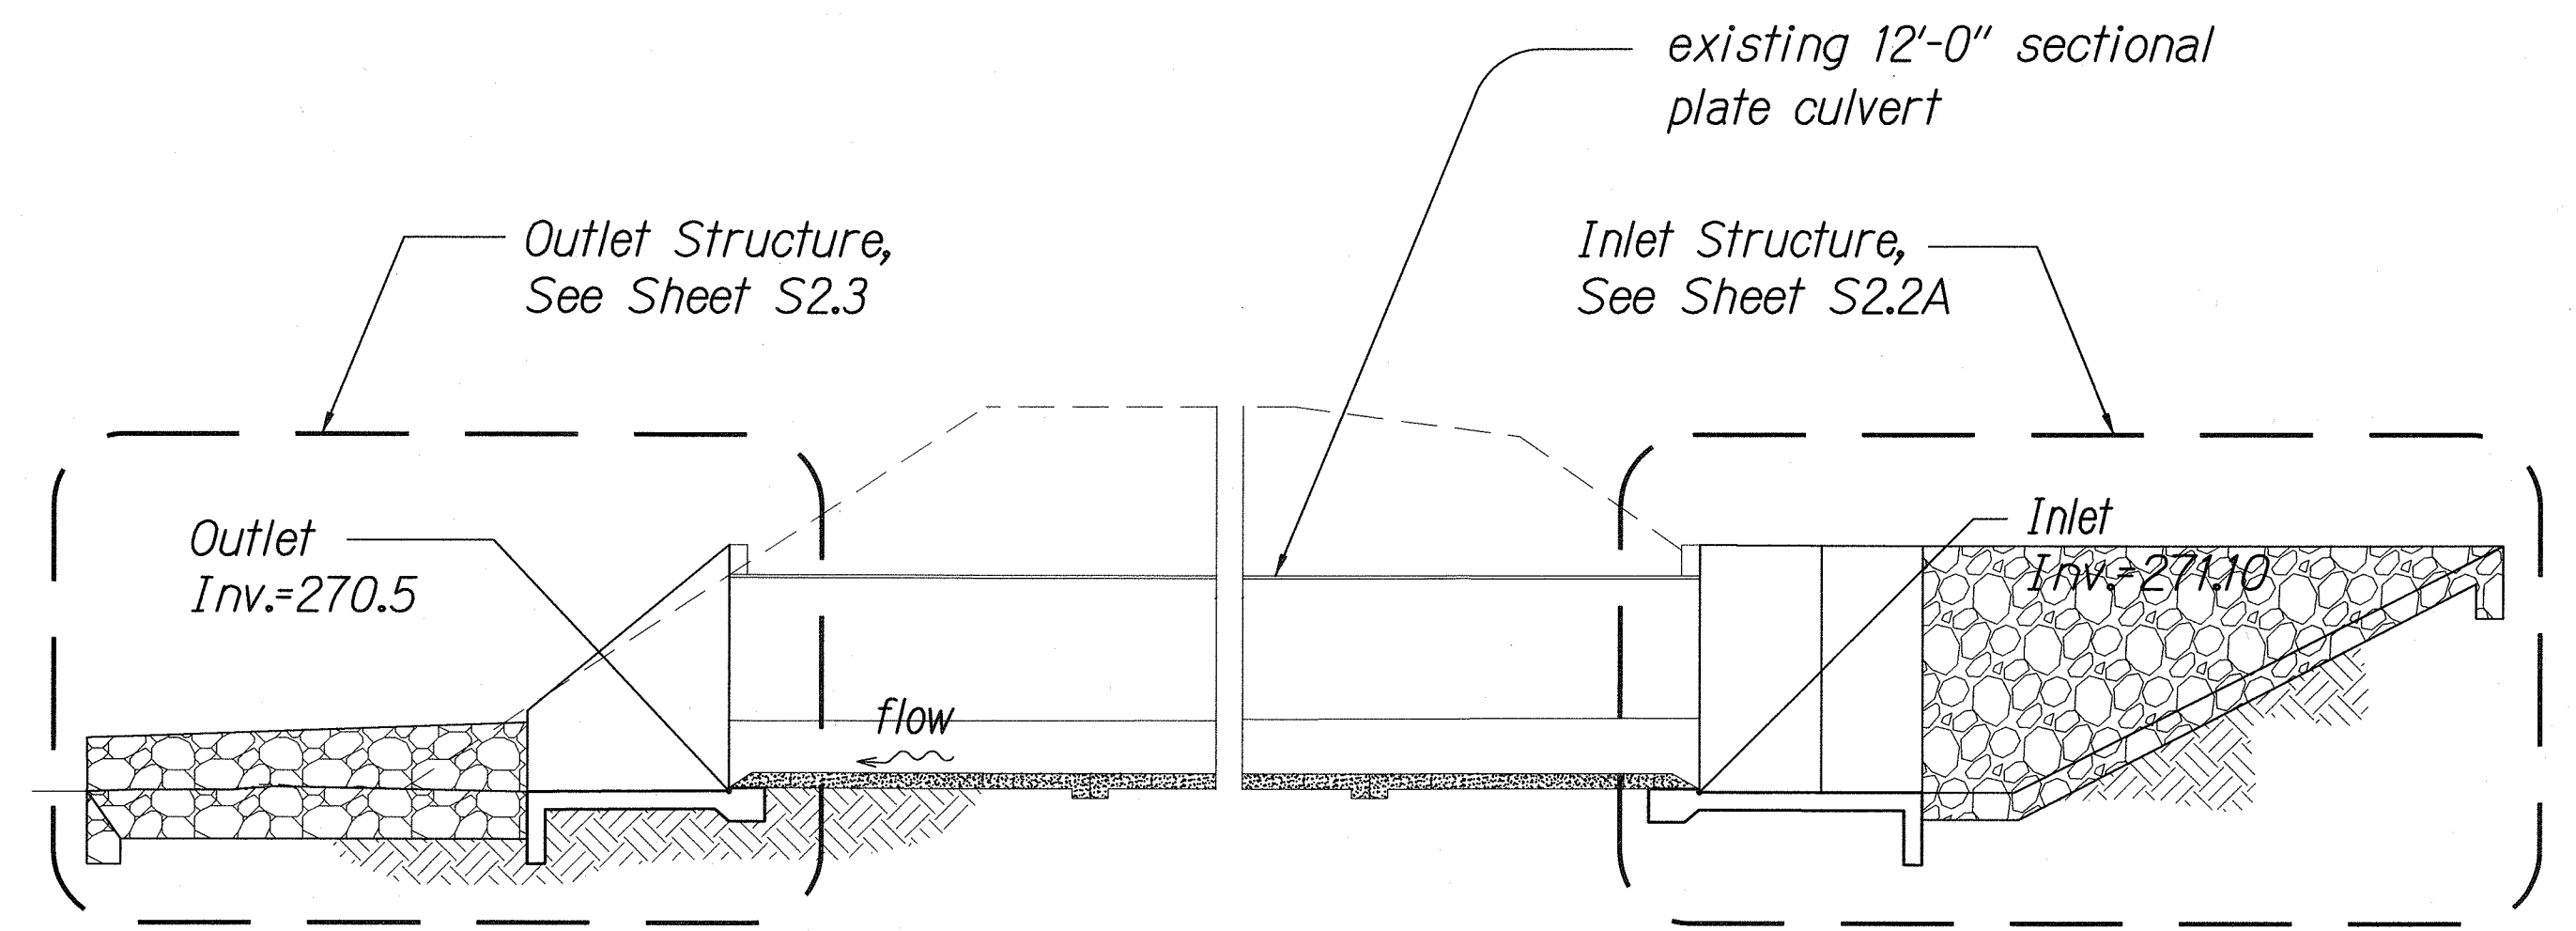

PROFILE - 12'-0" SECTIONAL PLATE CULVERT AT STA. 27+40 (M.P. 21.7)

Scale: 1" = 10'-0"

LEGEND FOR AS-BUILT POSTINGS	
	Squiggly line for as-built deletion
	Double line for as-built deletion
Roadway	Text for as-built posting

4/26/06	Revised Inlet Structure
Date	Revision
STATE OF HAWAII DEPARTMENT OF TRANSPORTATION HIGHWAYS DIVISION	
CULVERT PLAN AND PROFILE	
Kuhio Highway Emergency Repairs Vicinity of MP 21.7 (Wailapa Stream) FEDERAL AID PROJECT NO. ER-14(1)	
Scale: As shown	Date: April 2006
SHEET No. S2.1 OF 34 SHEETS	