



FED. ROAD DIST. NO.	STATE	FEDERAL AID PROJ. NO.	FISCAL YEAR	SHEET NO.	TOTAL SHEETS
HAWAII	HAWAII	ER-14(1)	2006	12	34

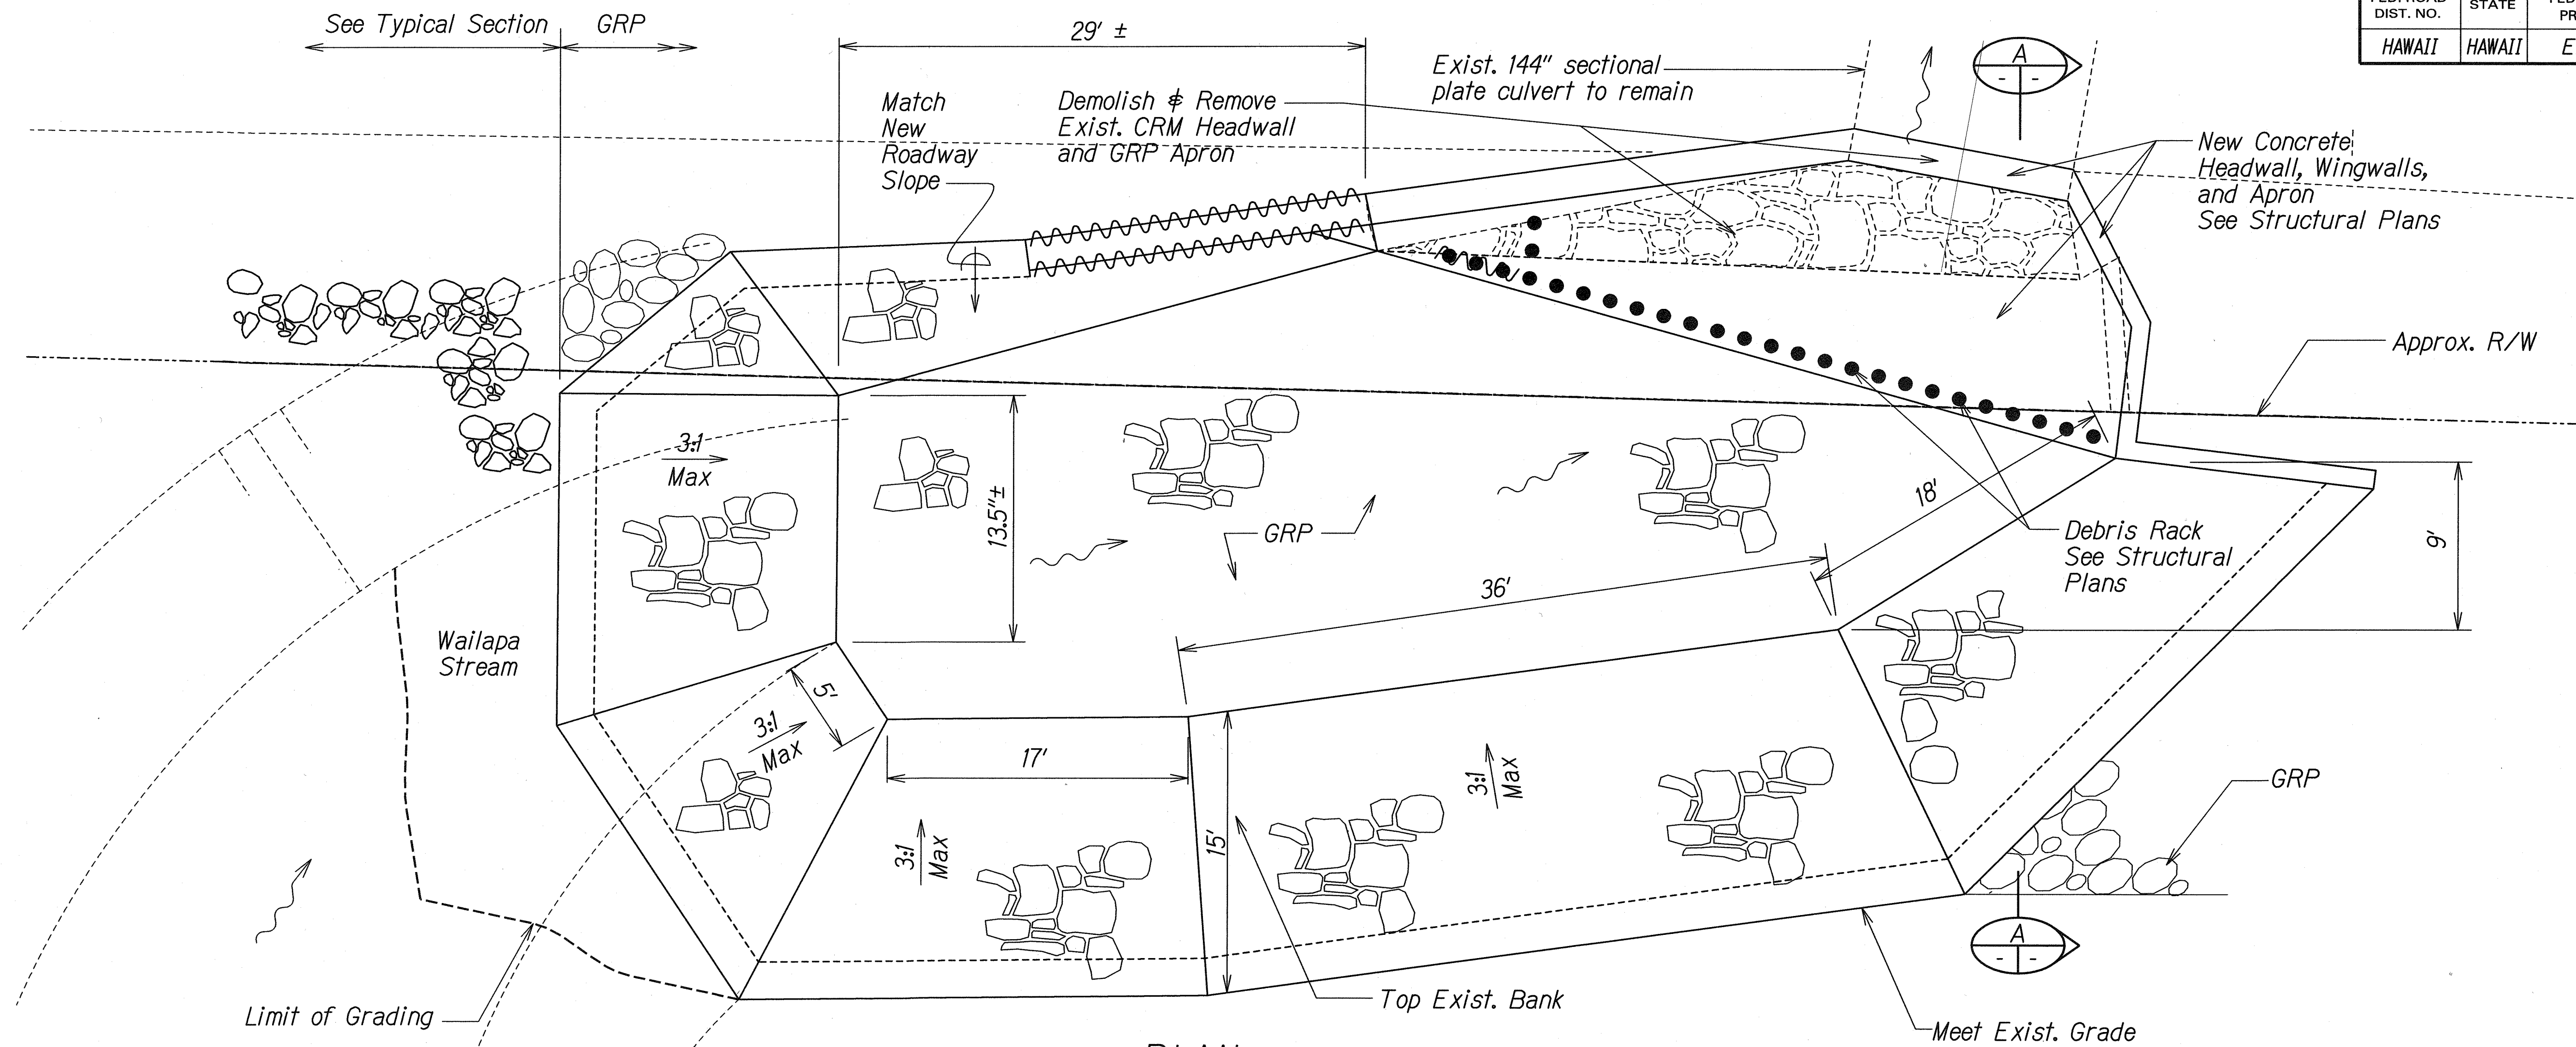

PLAN

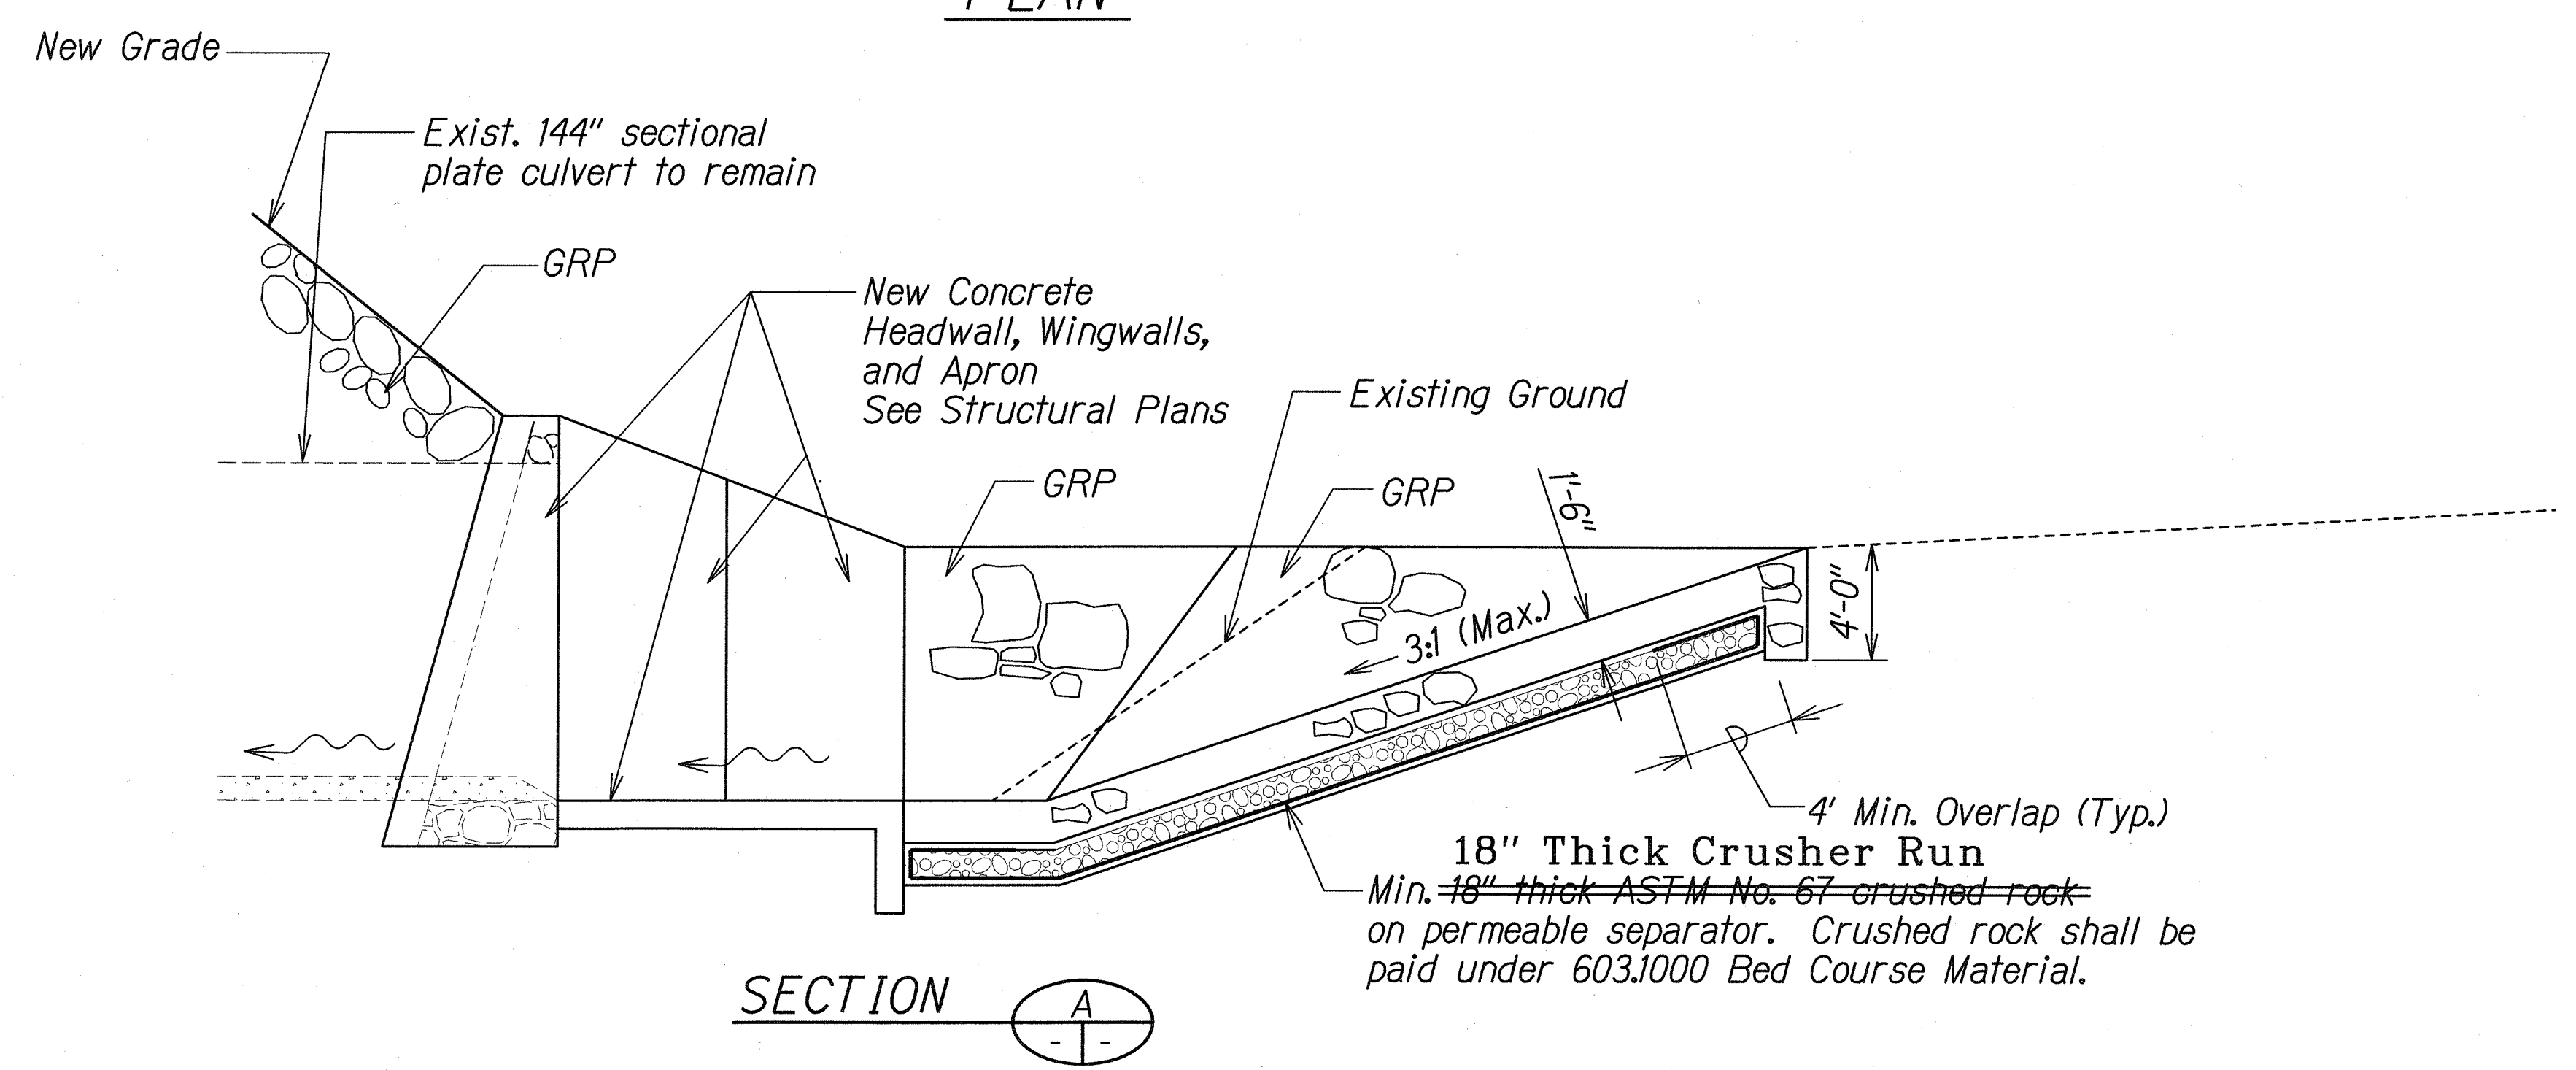

SECTION A

GRP AT INLET STRUCTURE (@ STA. 27+40± (MP 21.7))

LEGEND FOR AS-BUILT POSTINGS	
	Squiggly line for as-built deletion
	Double line for as-built deletion
Roadway	Text for as-built posting

4/26/06	Revised GRP Apron and Headwall
Date	Revision
STATE OF HAWAII DEPARTMENT OF TRANSPORTATION HIGHWAYS DIVISION GRP AT INLET STRUCTURE <i>Kuhio Highway Emergency Repairs Vicinity of MP 21.7 (Wailapa Stream)</i> FEDERAL AID PROJECT NO. ER-14(1) Scale: 1" = 5'-0" Date: April 2006	
SHEET No. C6 OF 17 SHEETS	

SURVEY PLOTTED BY	DATE
DRAWN BY	
DESIGNED BY	
QUANTITIES BY	
CHECKED BY	
ORIGINAL PLAN	
NOTE BOOK	